




434+50
END PROJECT

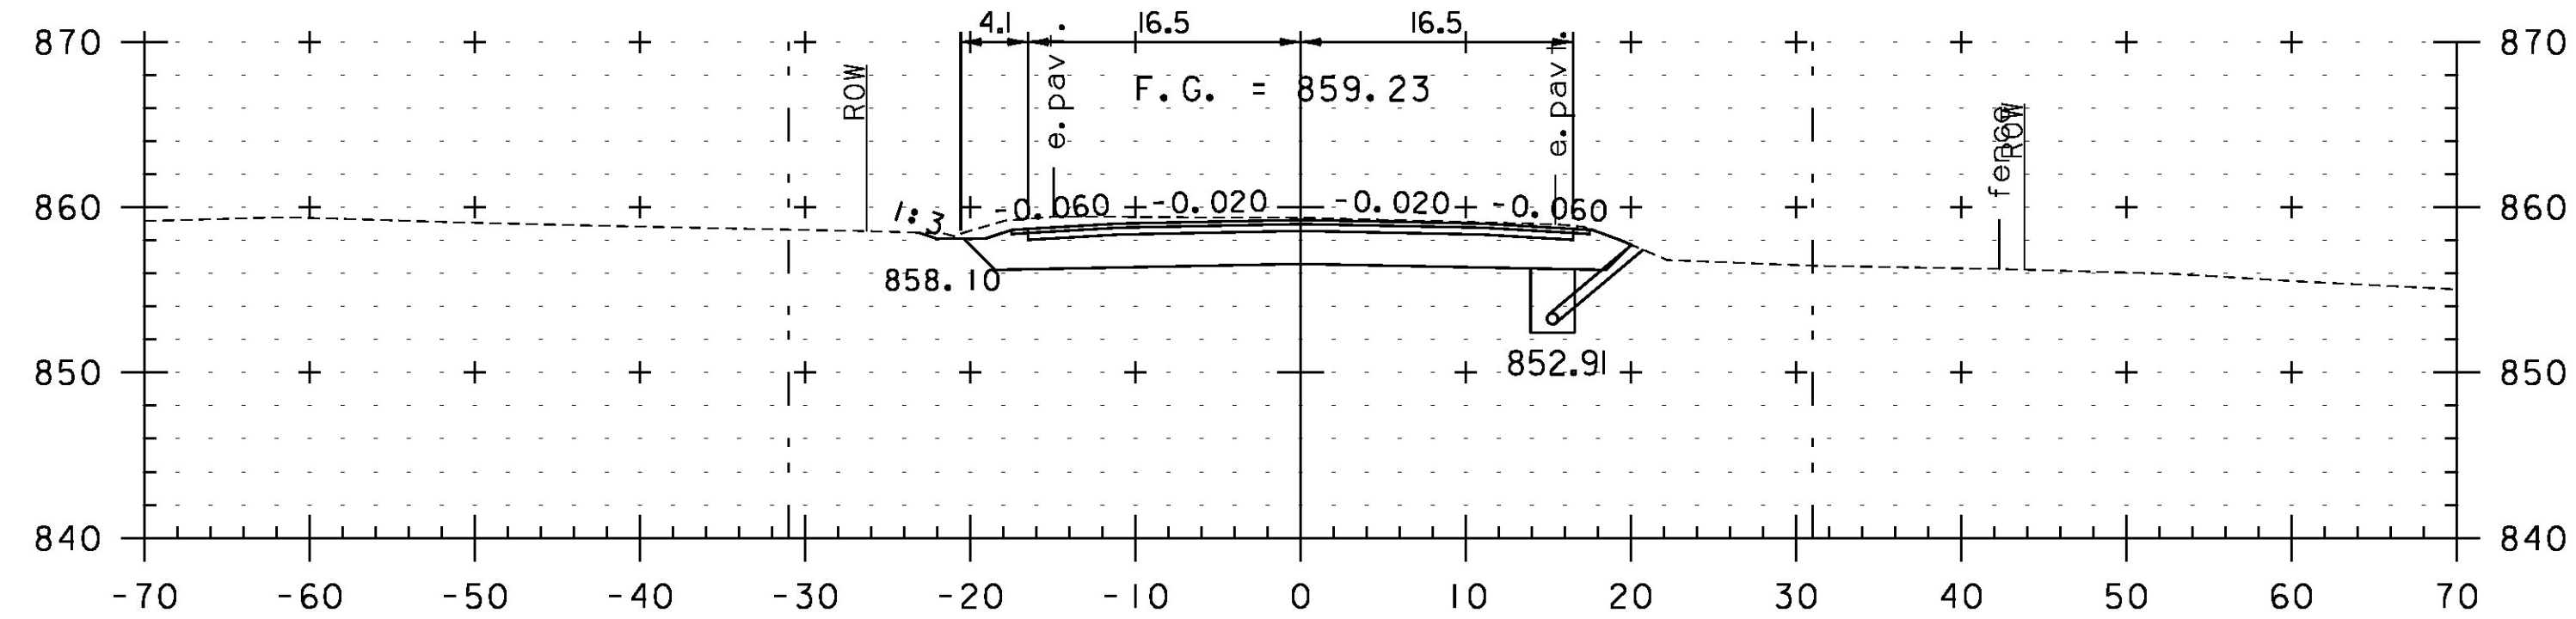

434+00

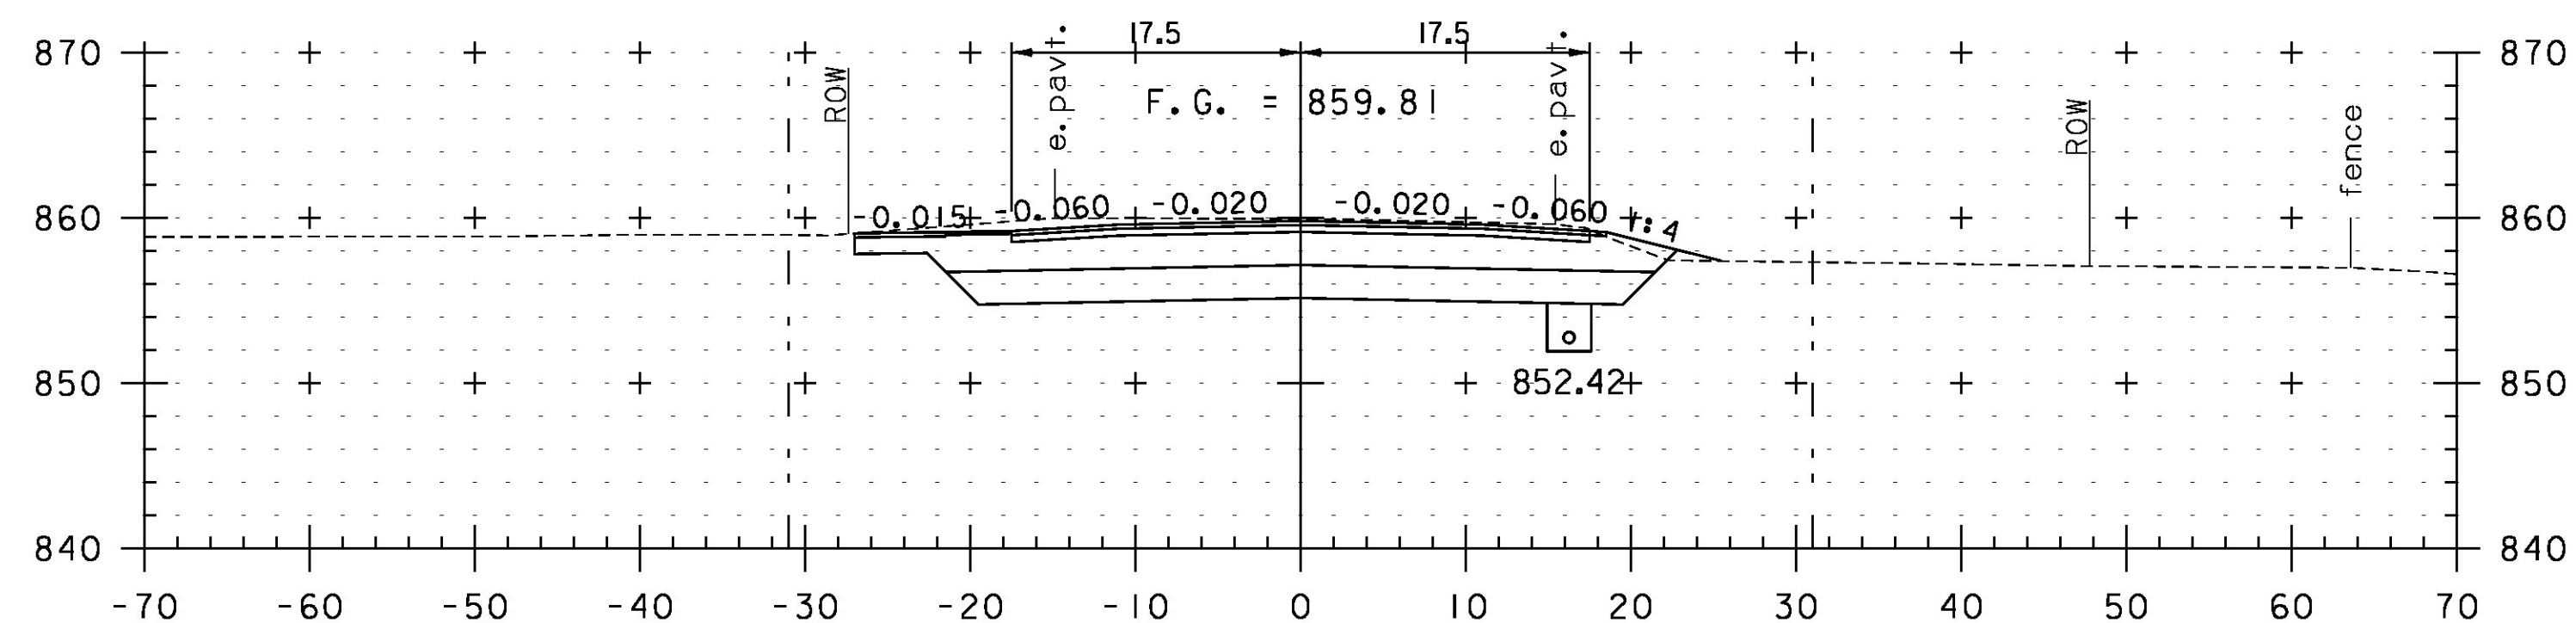

433+50
DRIVE LT

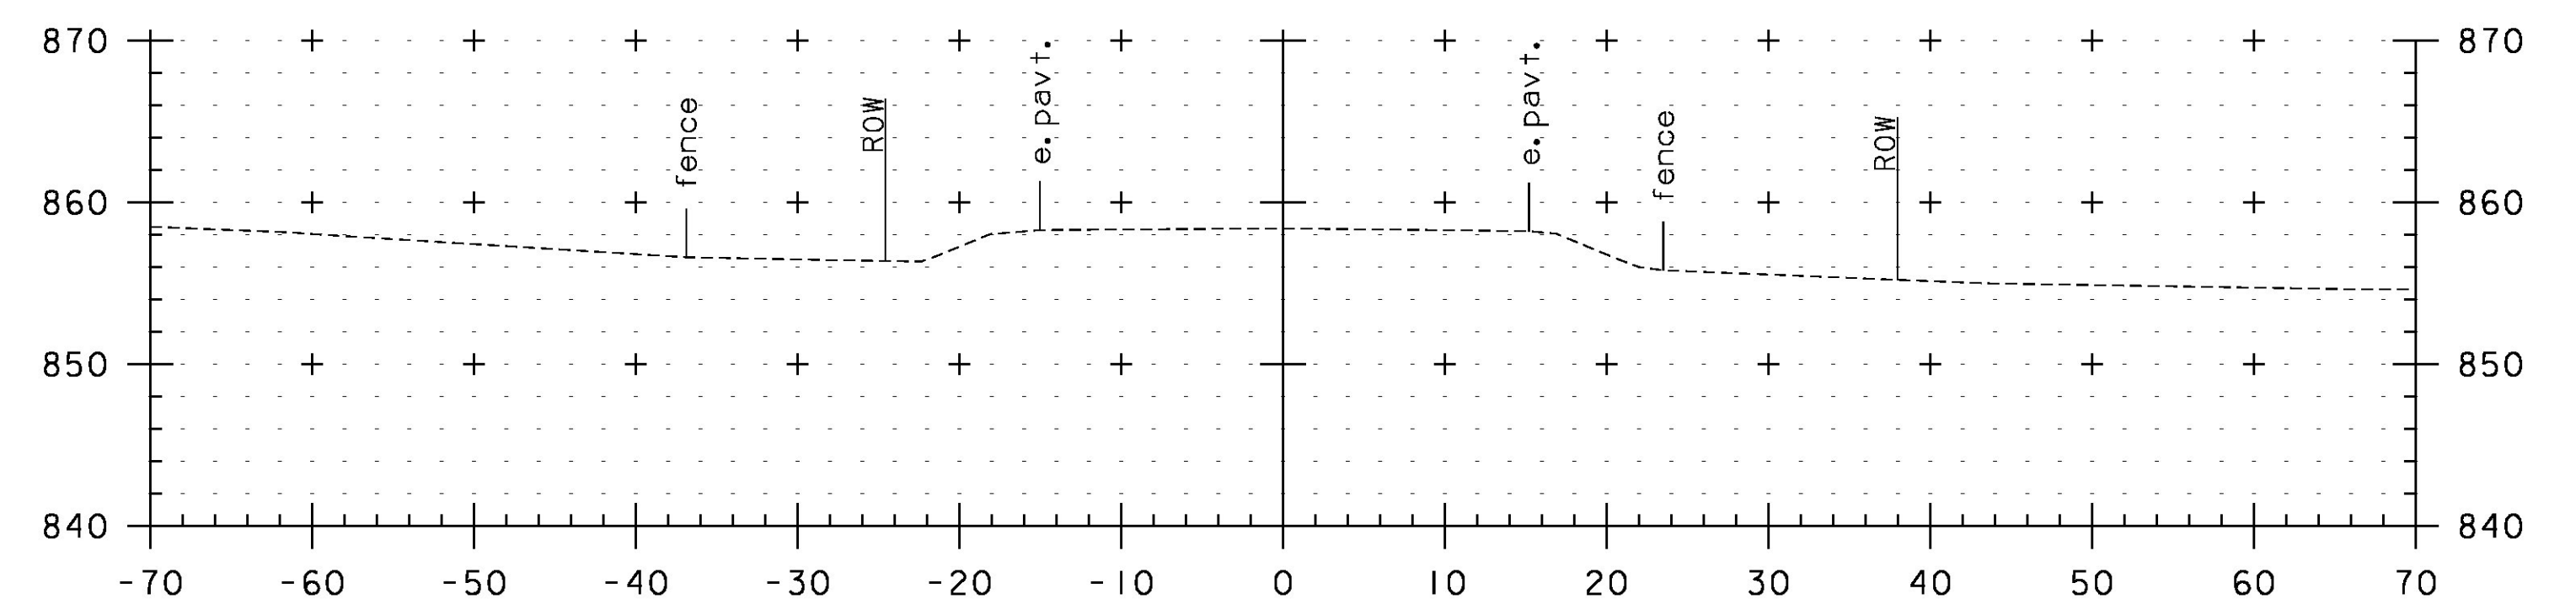

434+75
END APPROACH

STA. 433+50 TO STA. 434+75

PROJECT NAME: LUNENBURG
PROJECT NUMBER: NH CULV(27)

FILE NAME: IIB294/cos/zlib294xsl.dgn
PROJECT LEADER: J. BYATT
DESIGNED BY: M. HALEY
ROADWAY CROSS SECTIONS 5

PLOT DATE: 8/6/2015
DRAWN BY: M. HALEY
CHECKED BY: P. SHEDD
SHEET 54 OF 74

