




101+00

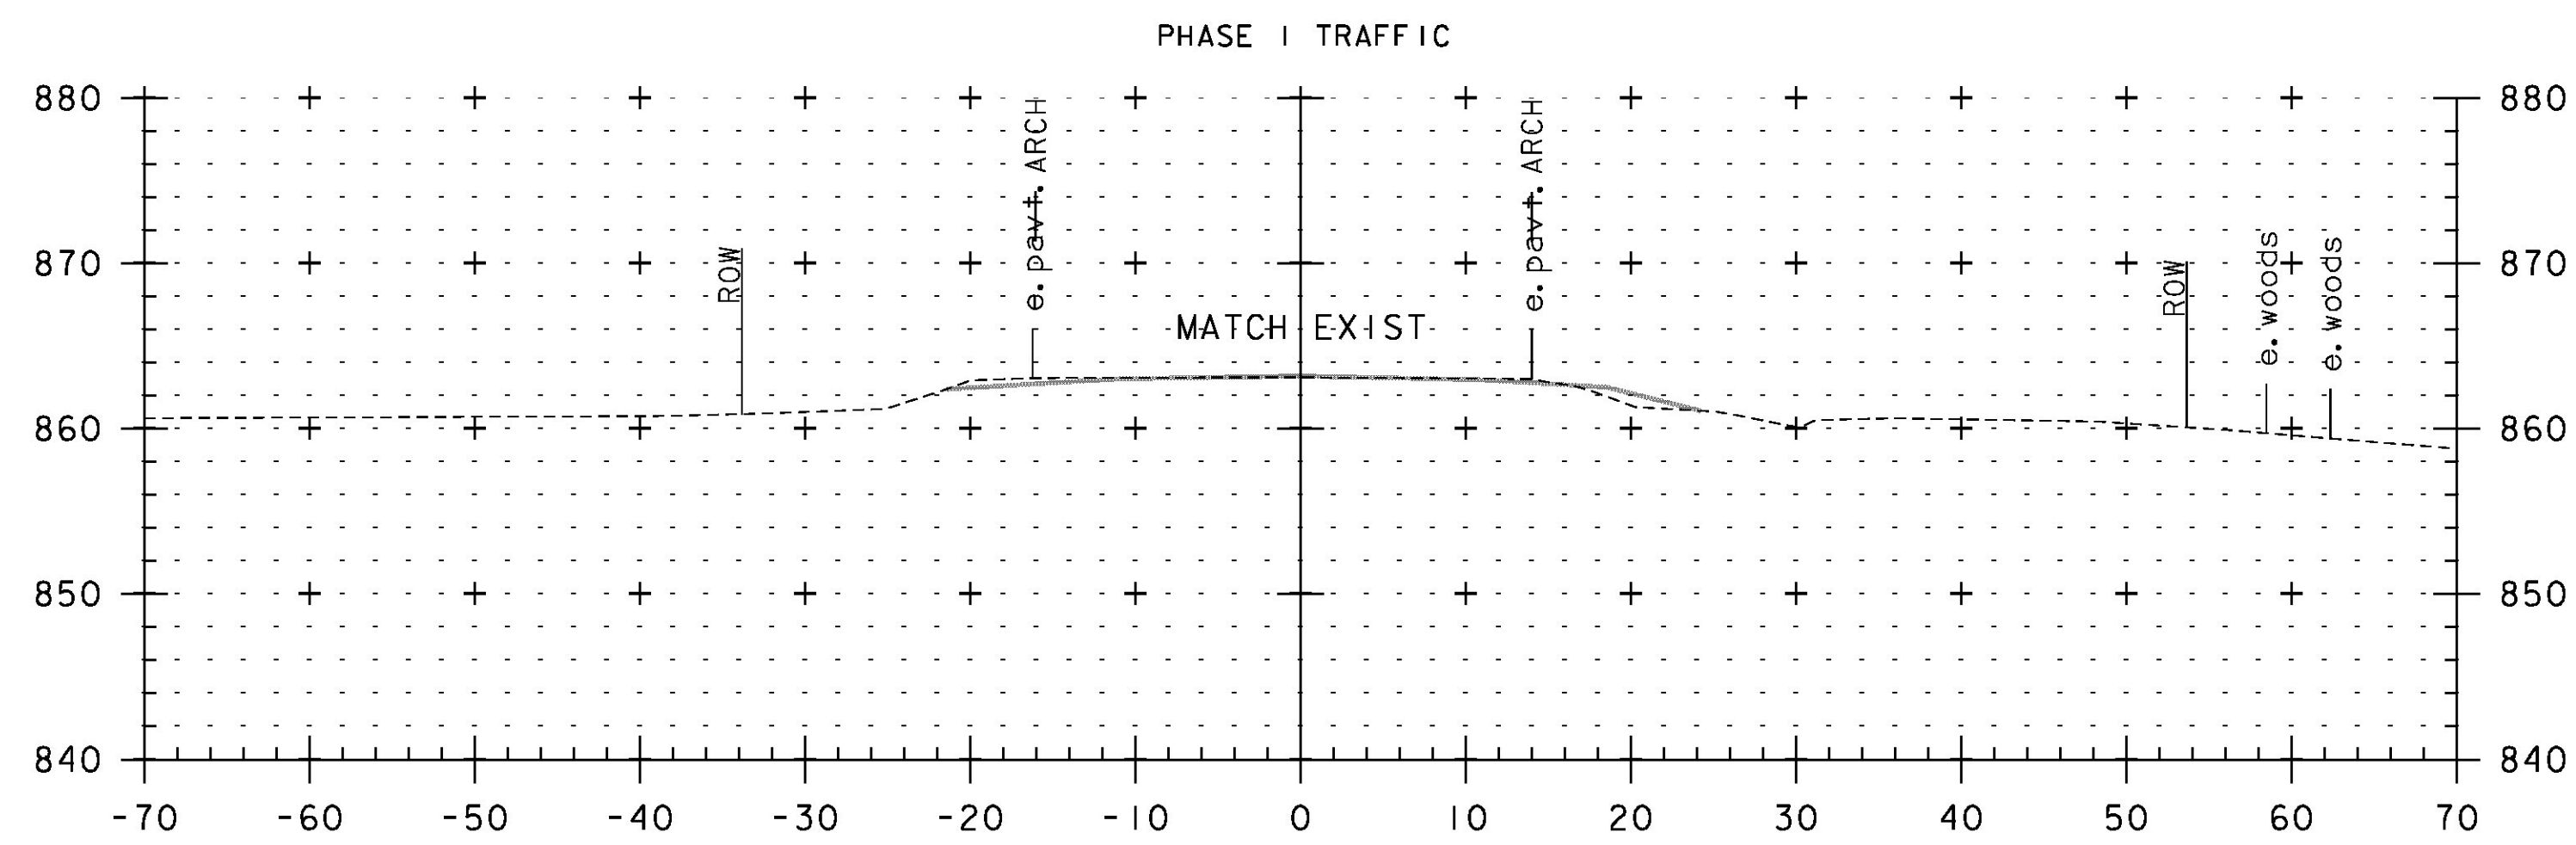


100+50
BEGIN DETOUR

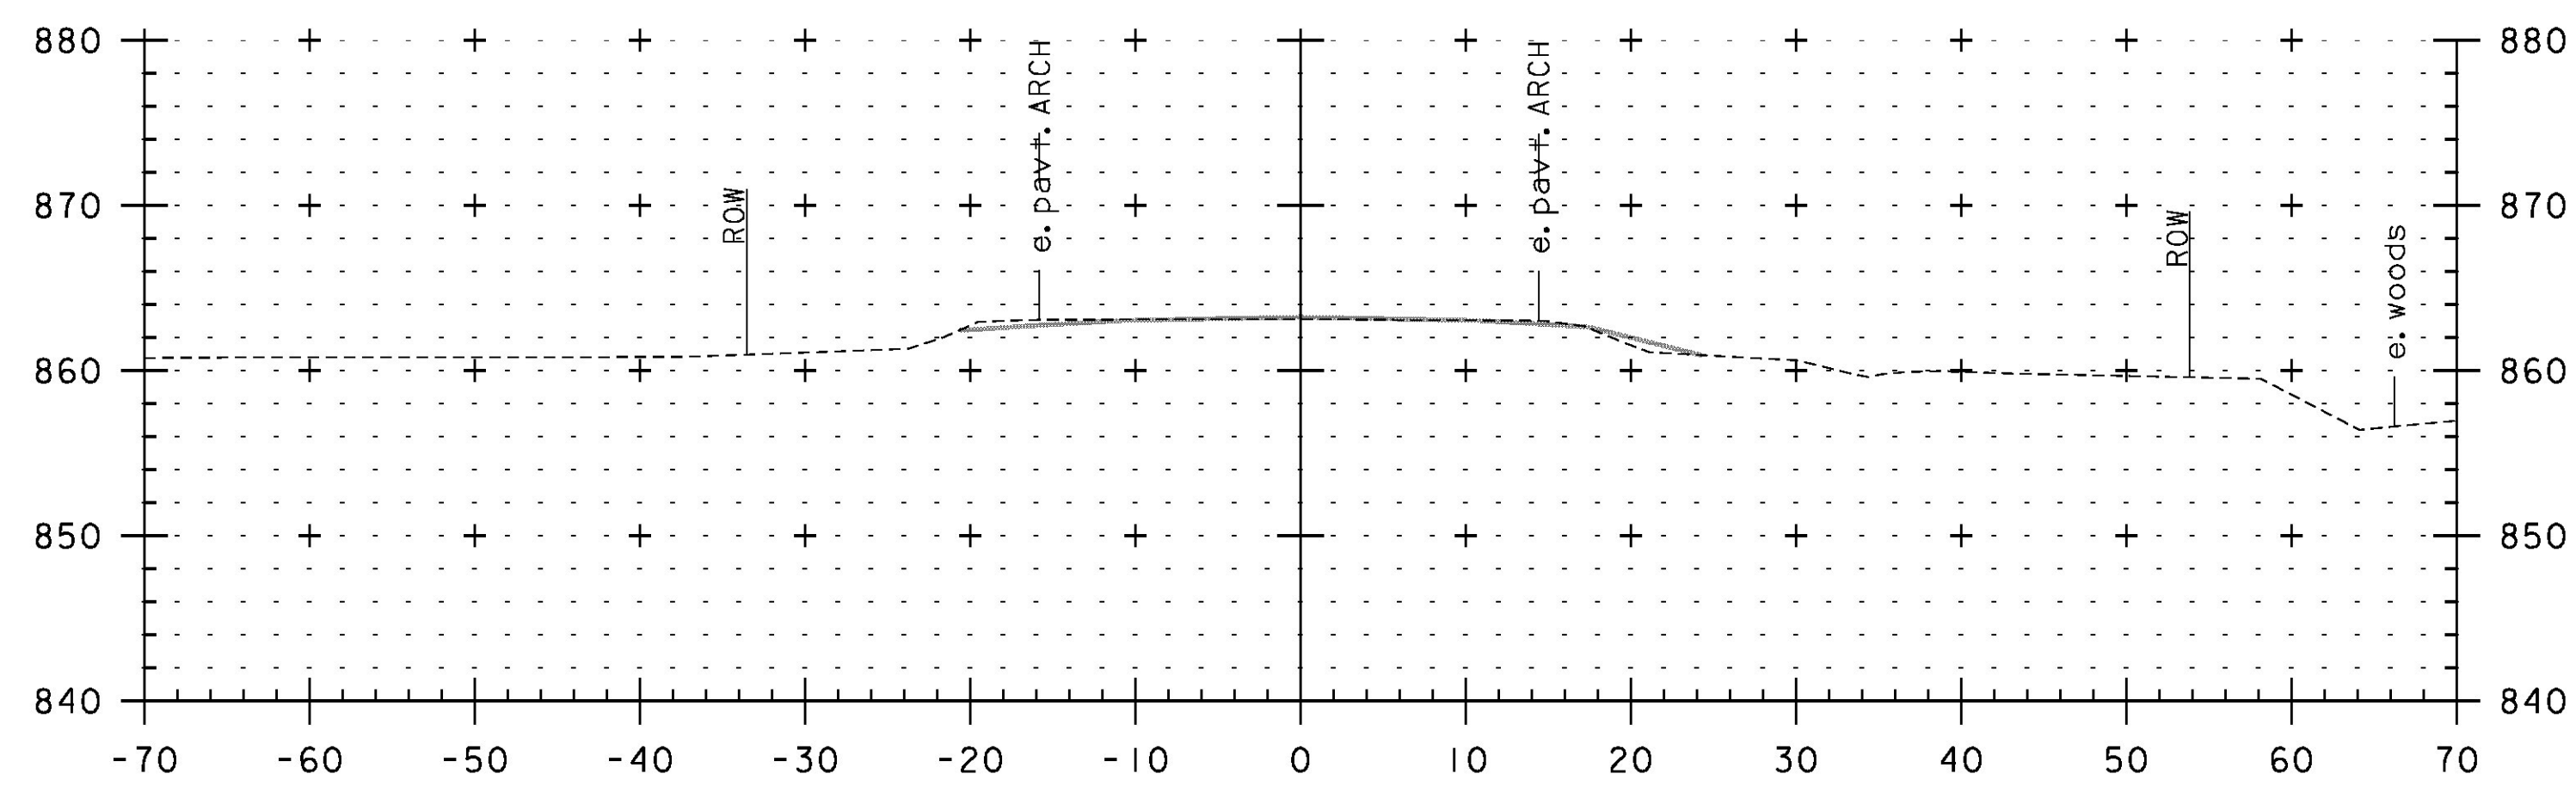


100+00

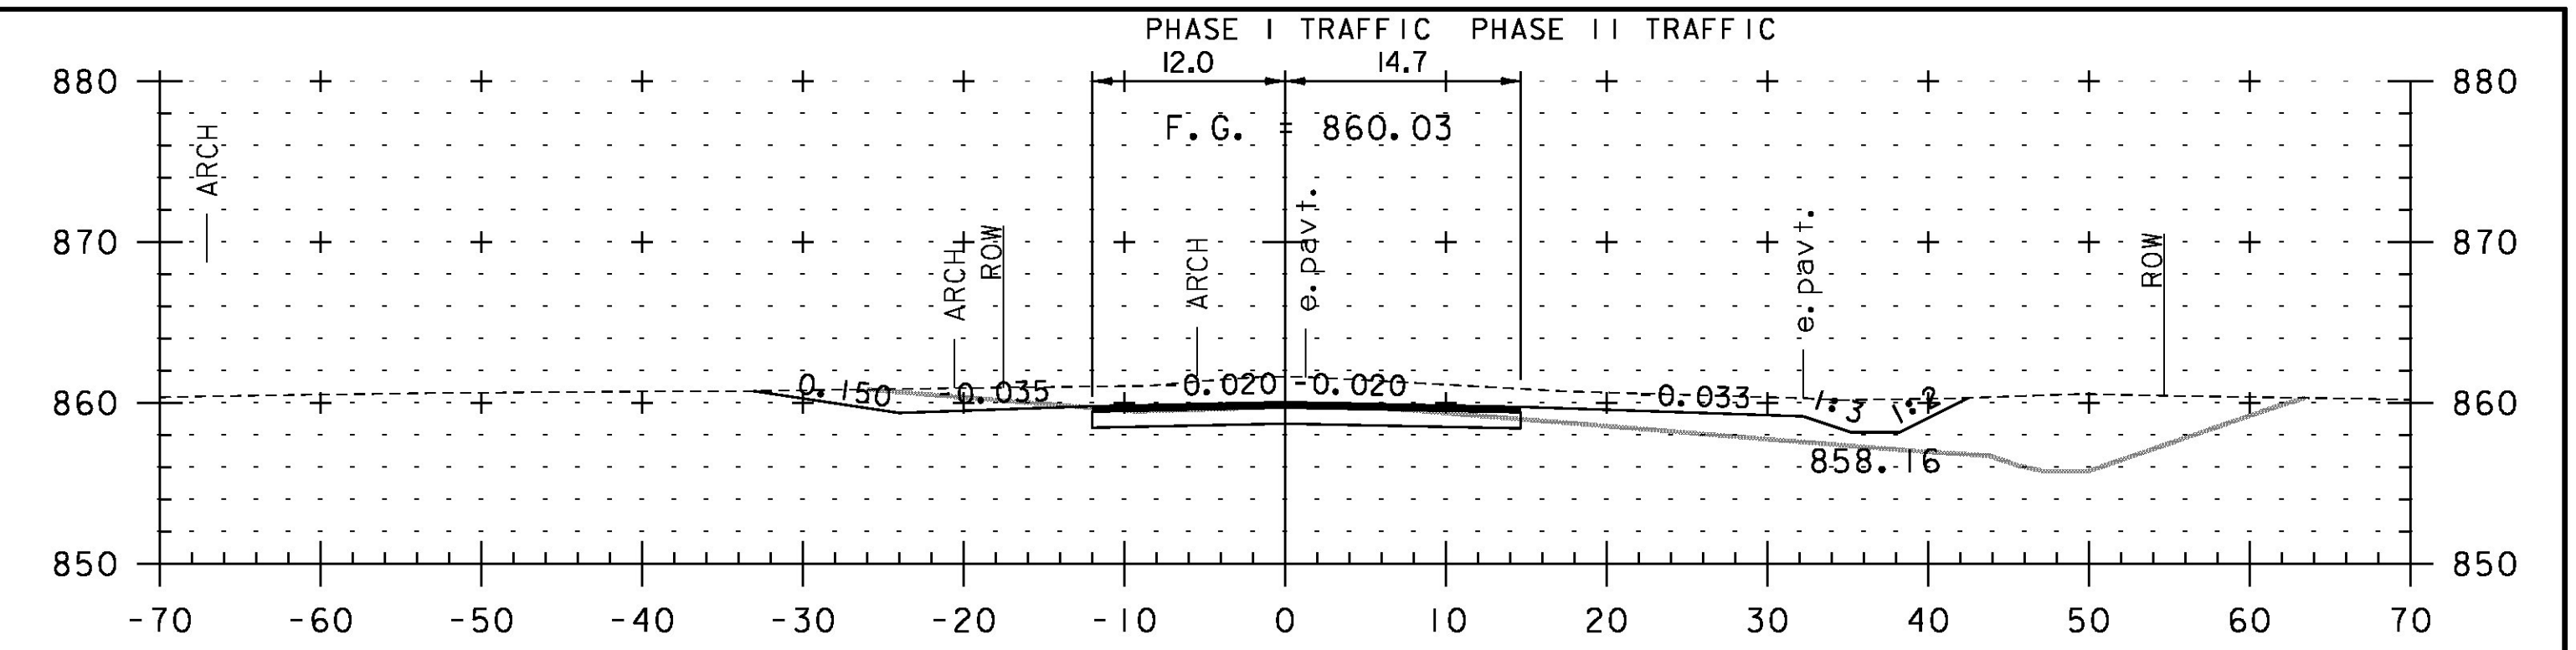


102+50

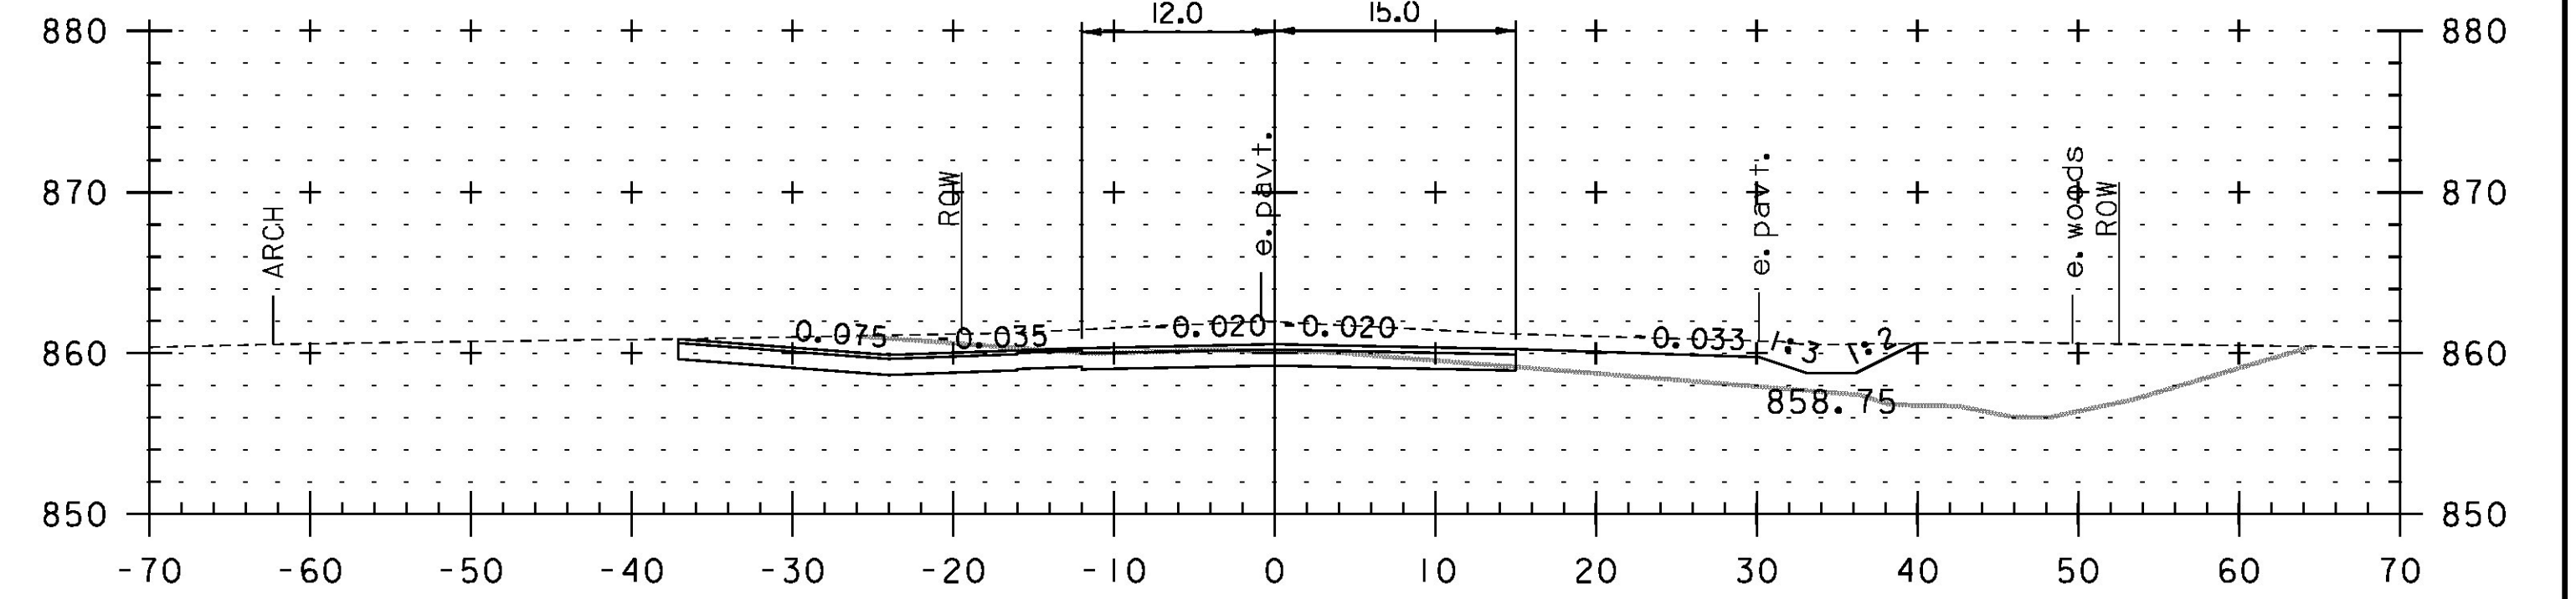

102+38
DRIVE LT

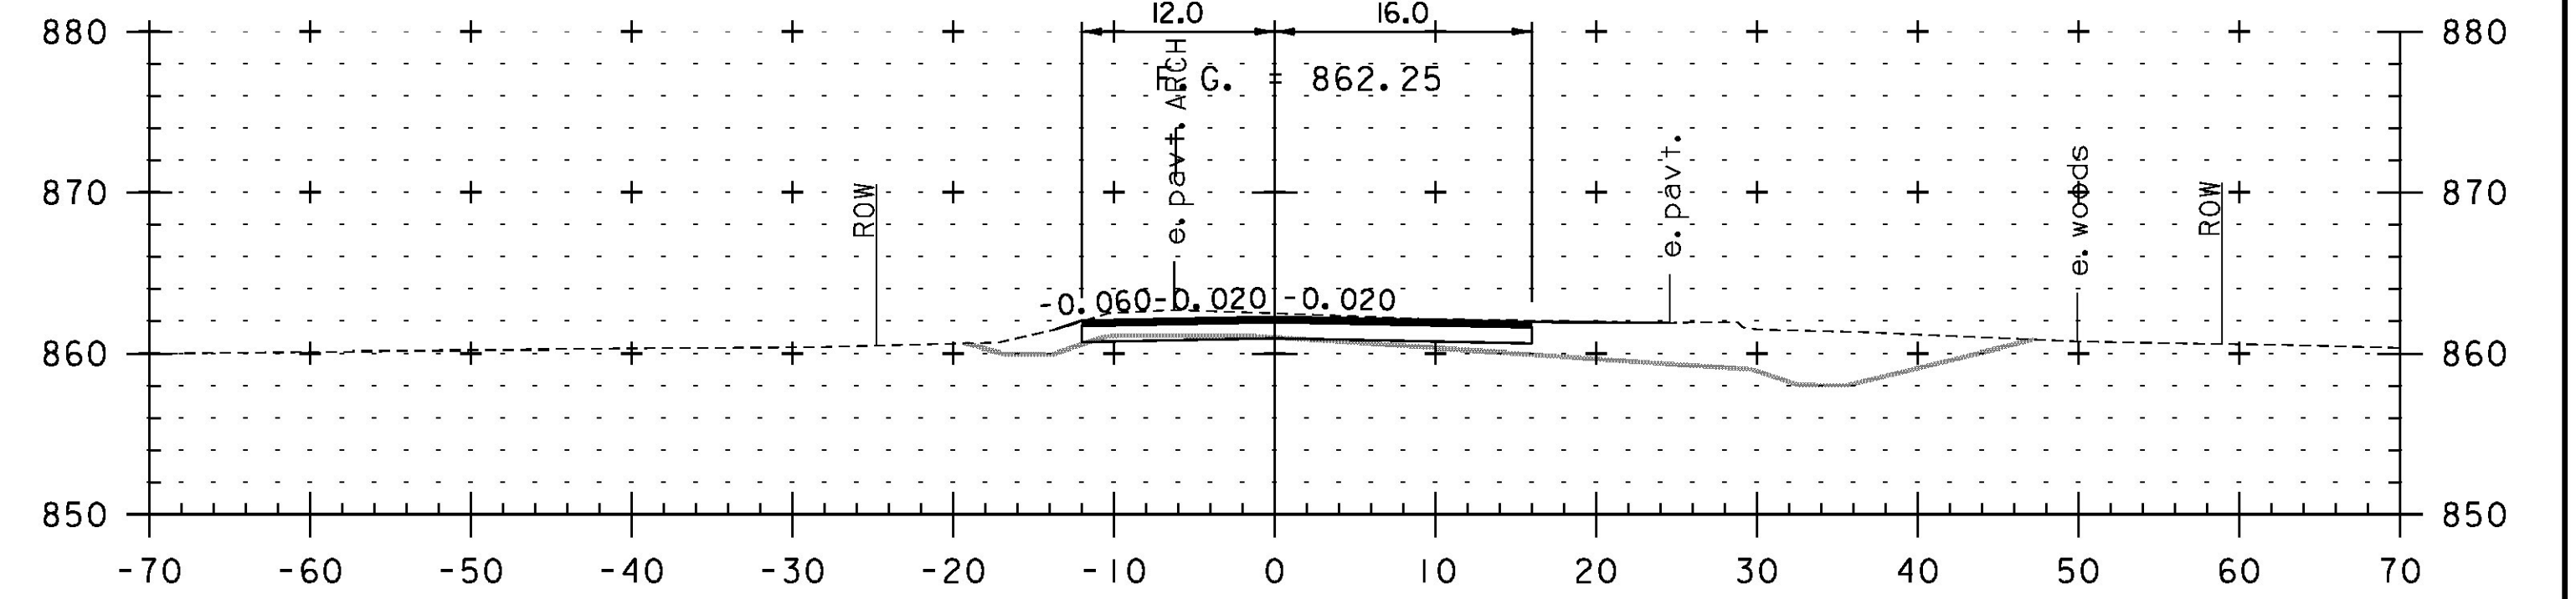


102+00

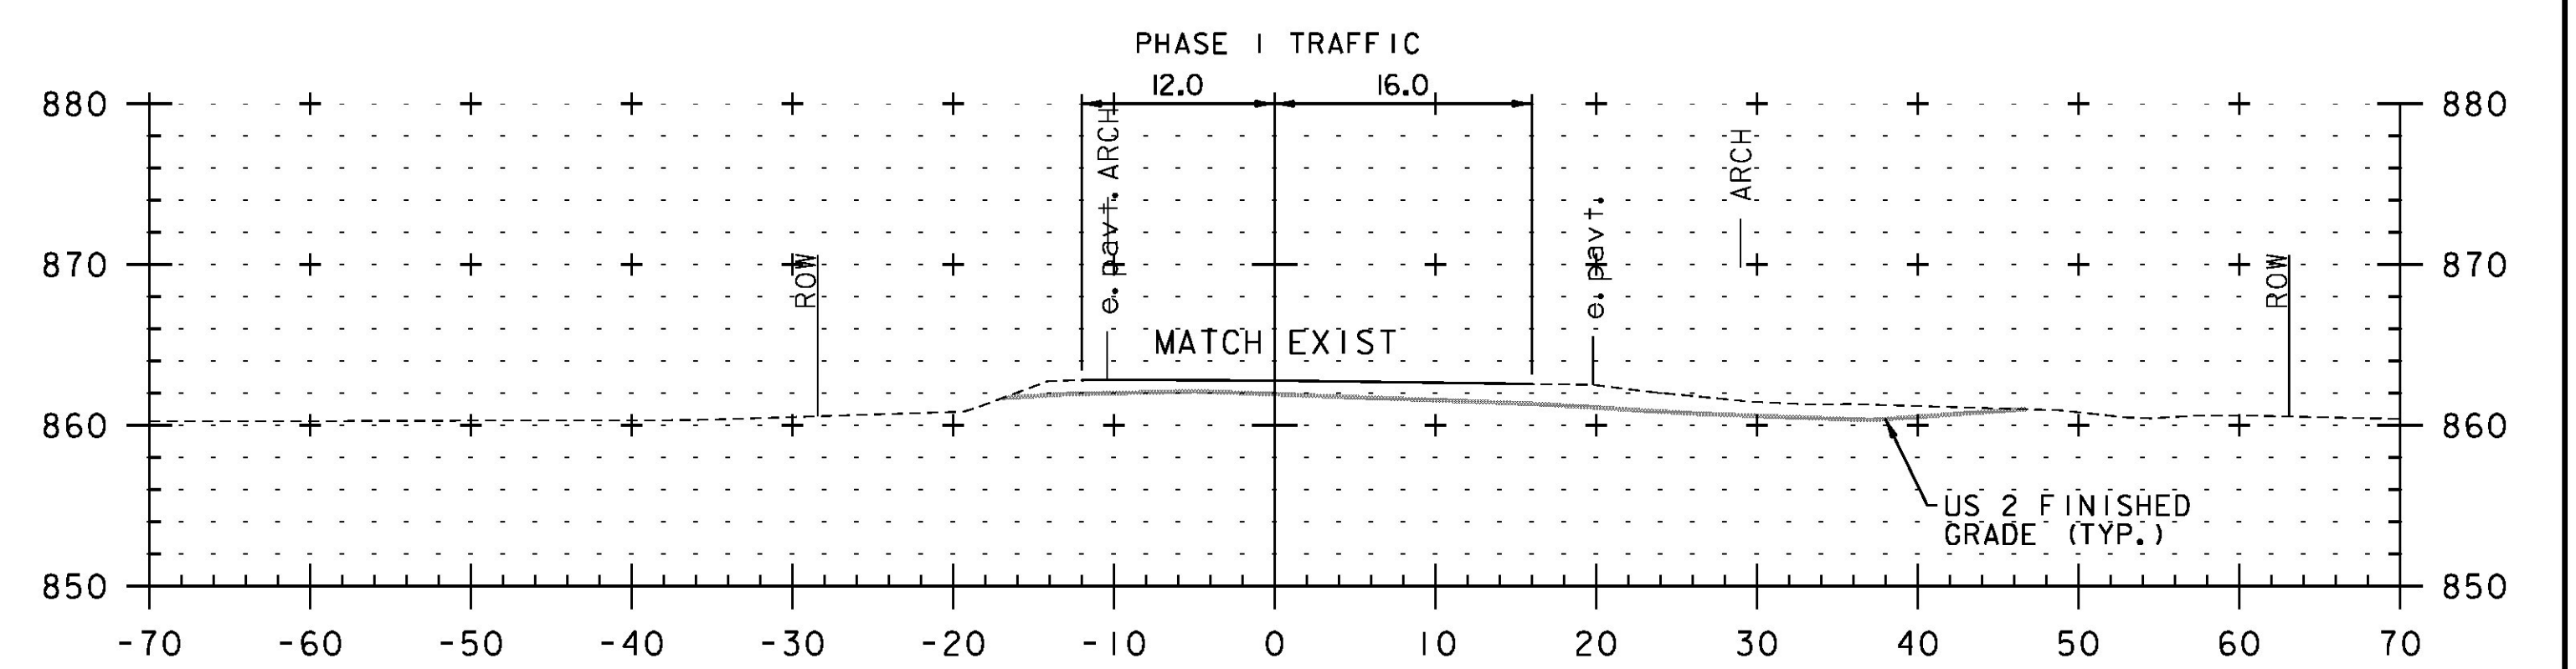

101+50

STA. 100+00 TO STA. 102+50

PROJECT NAME:	LUNENBURG
PROJECT NUMBER:	NH CULV(27)
FILE NAME:	IIB294/cos/zlib294xslid+tr.dgn
PROJECT LEADER:	J. BYATT
DESIGNED BY:	M. HALEY
TEMPORARY DETOUR CROSS SECTIONS I	
PLOT DATE:	8/6/2015
DRAWN BY:	M. HALEY
CHECKED BY:	P. SHEDD
SHEET	55 OF 74

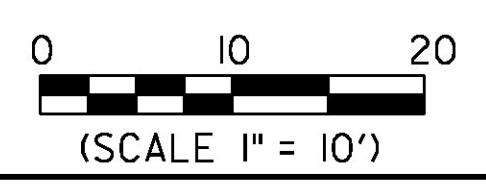

CLD_12-0106_MODEL1.XSOI

