




CLD\_12-0106 MODEL: XS02

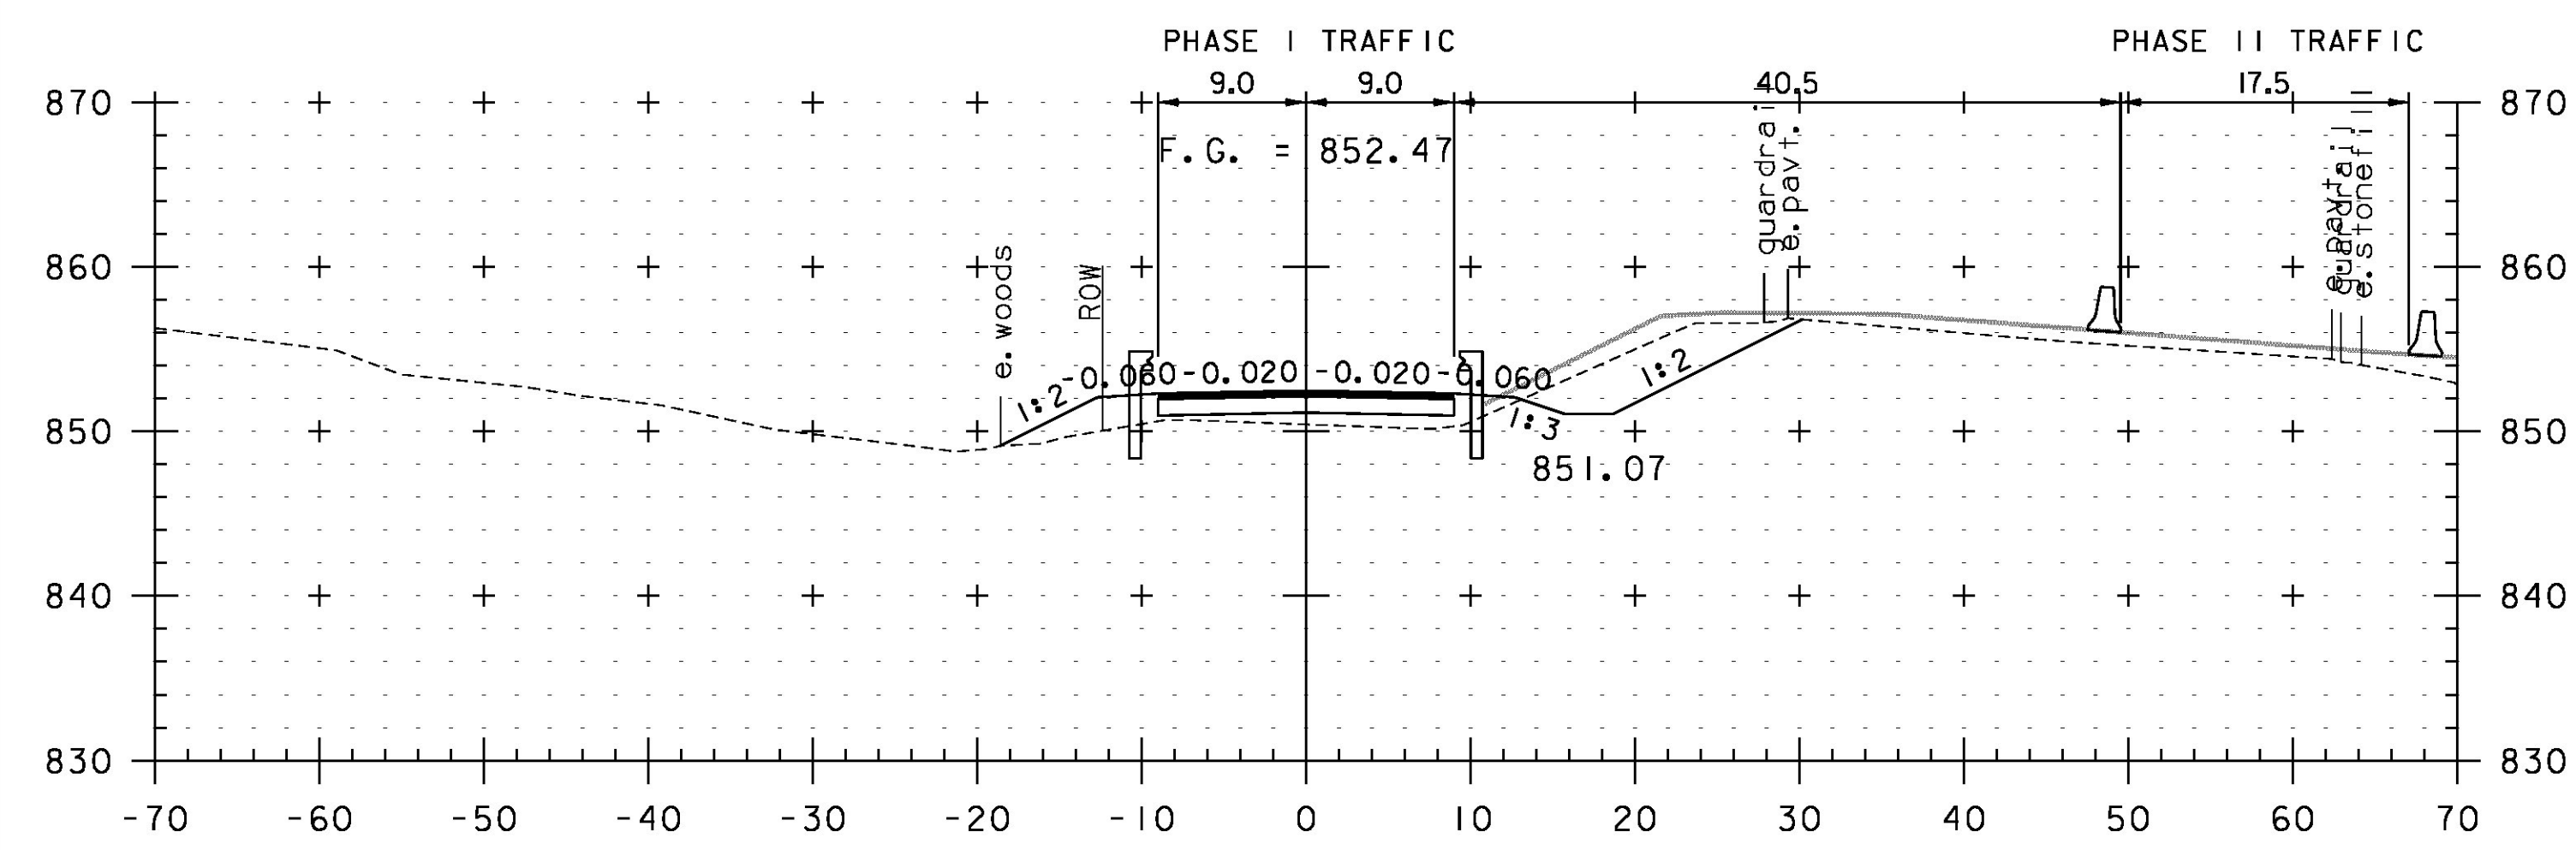


104+00

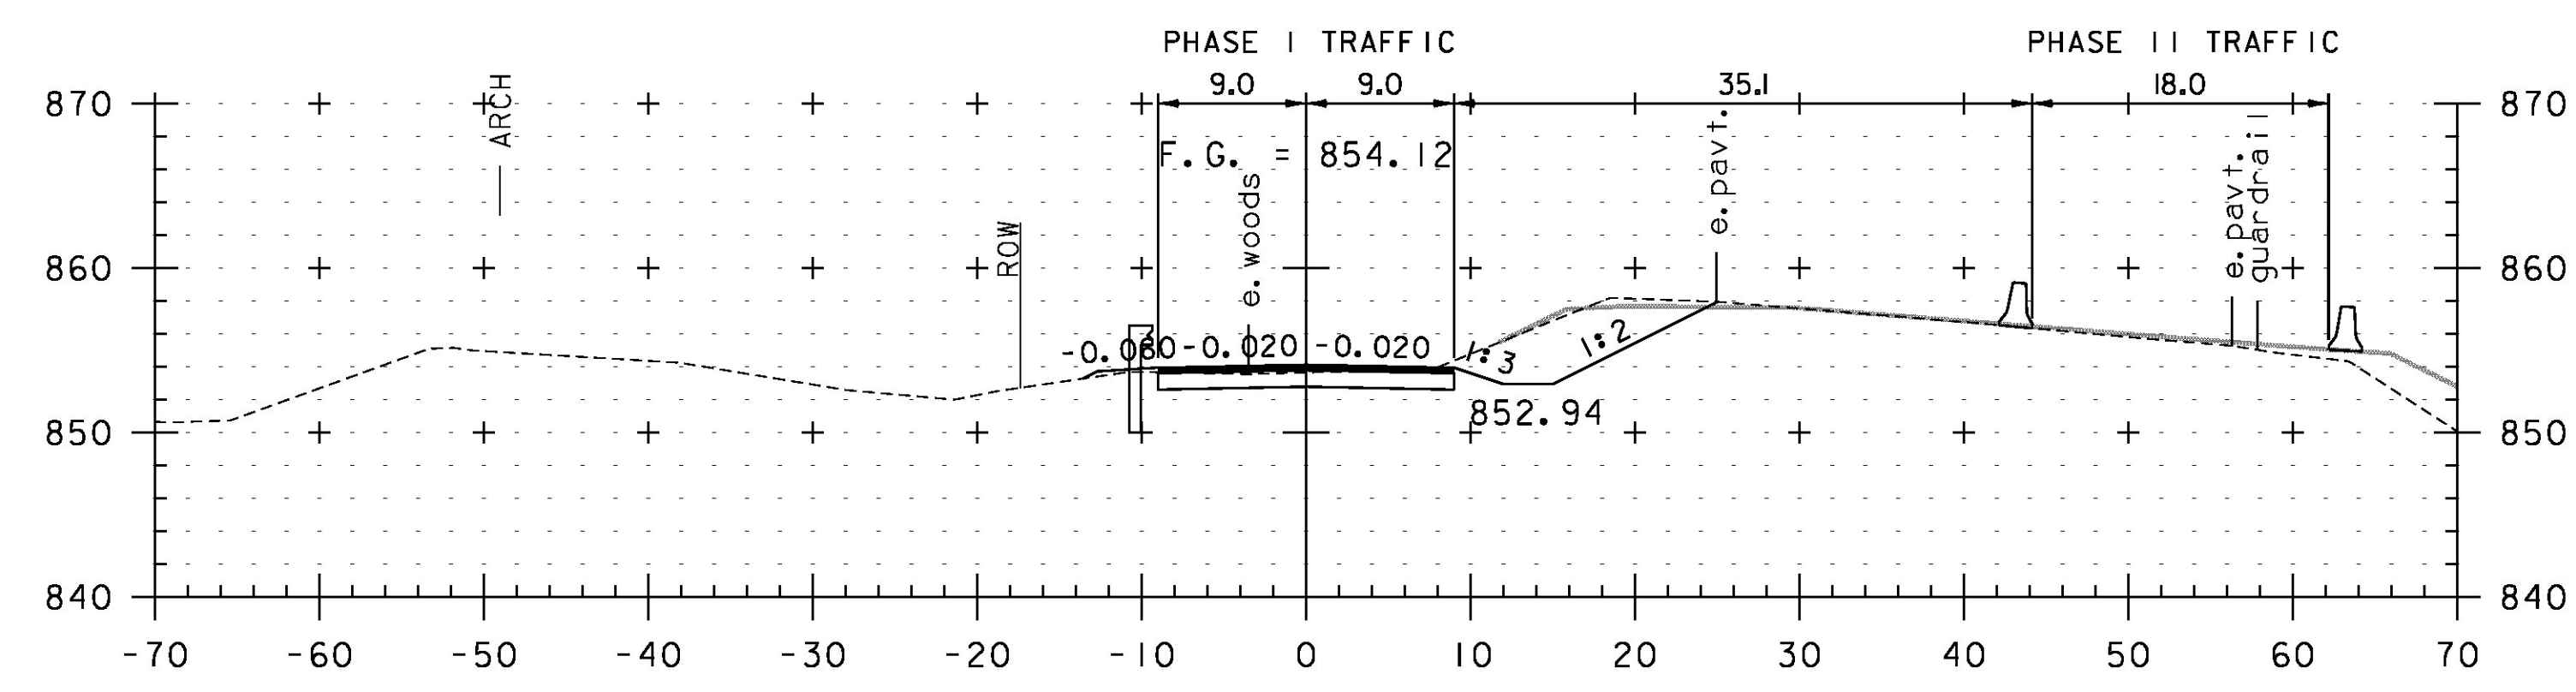


103+50

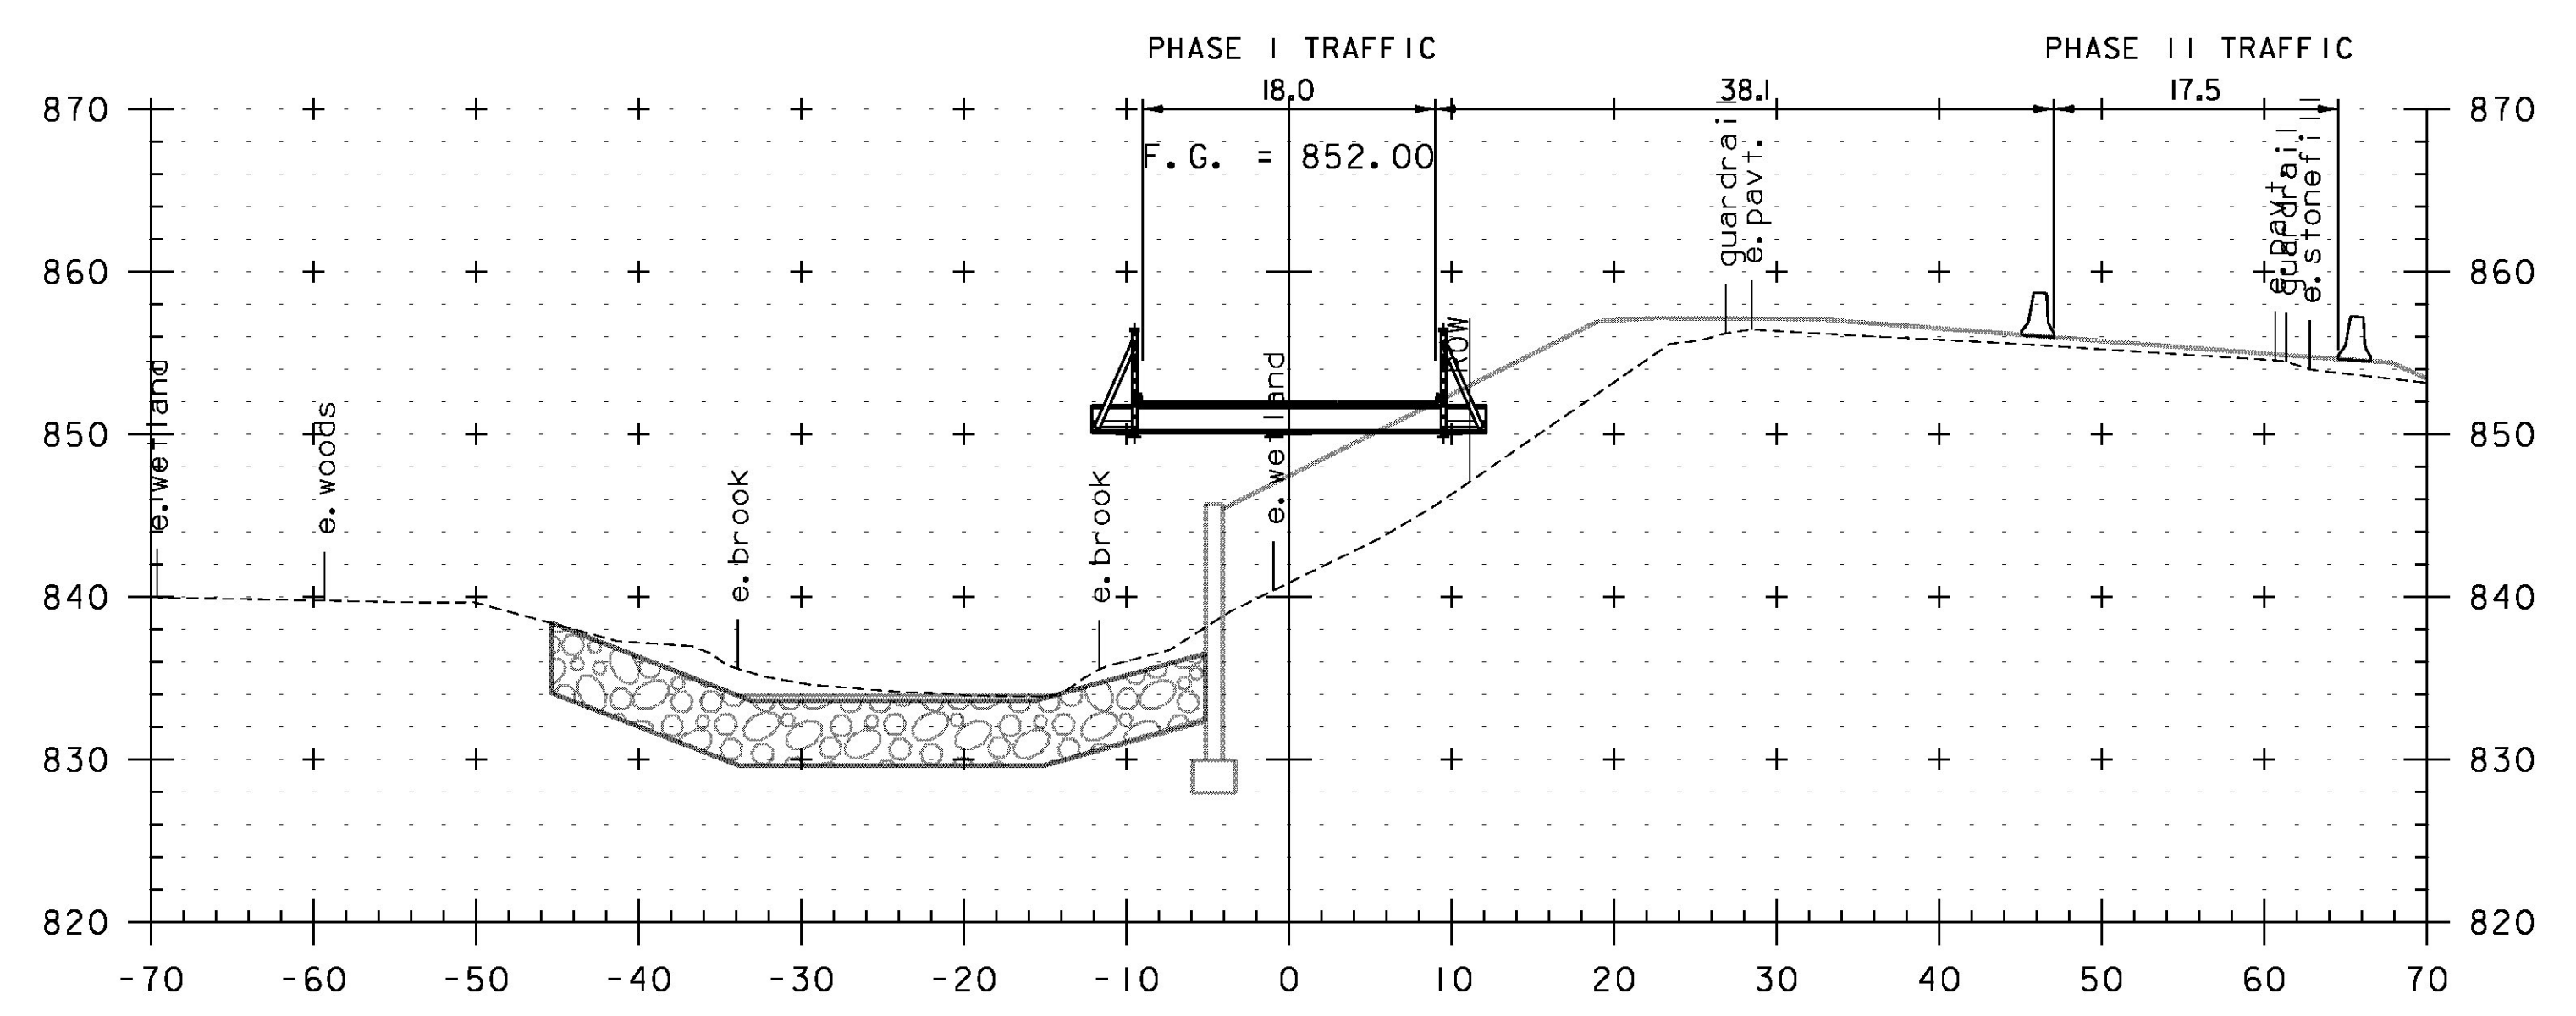

105+00

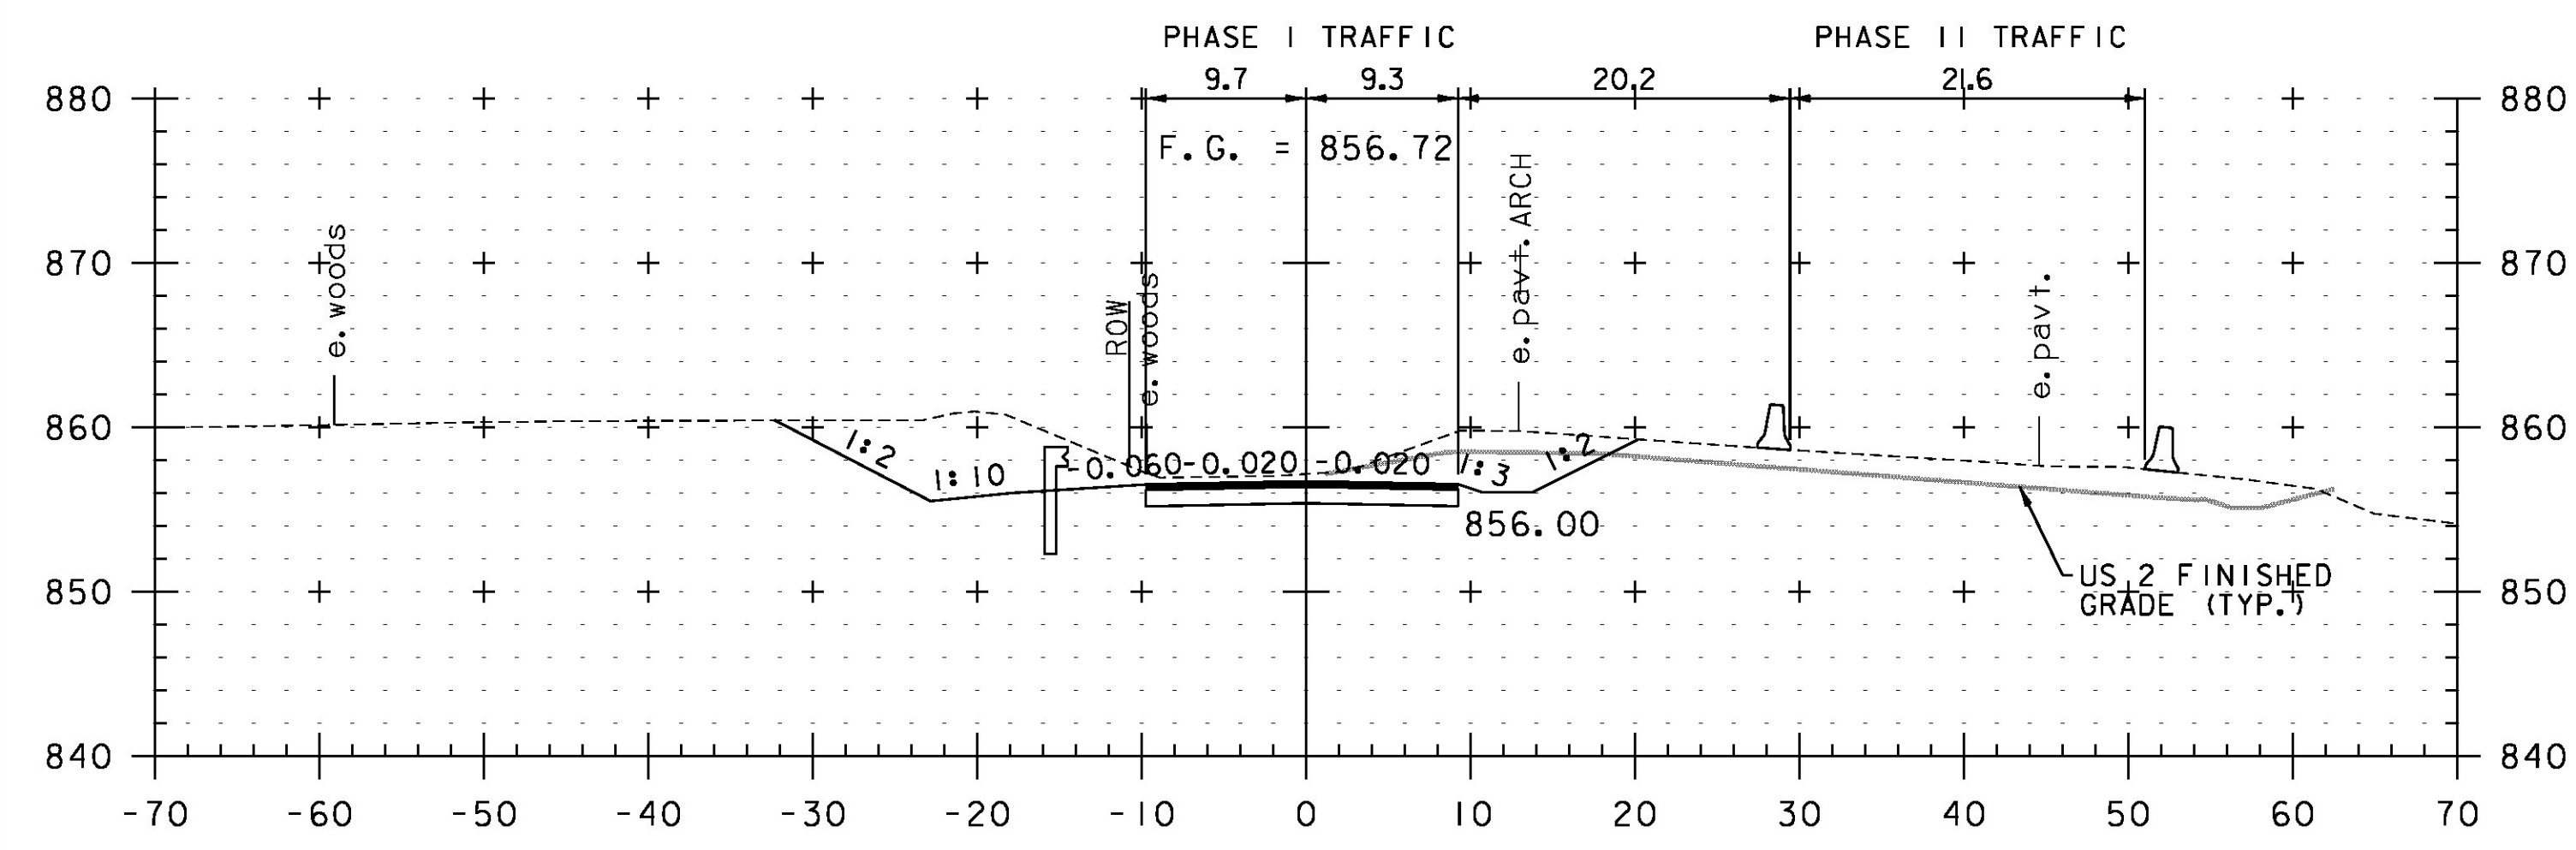


103+00

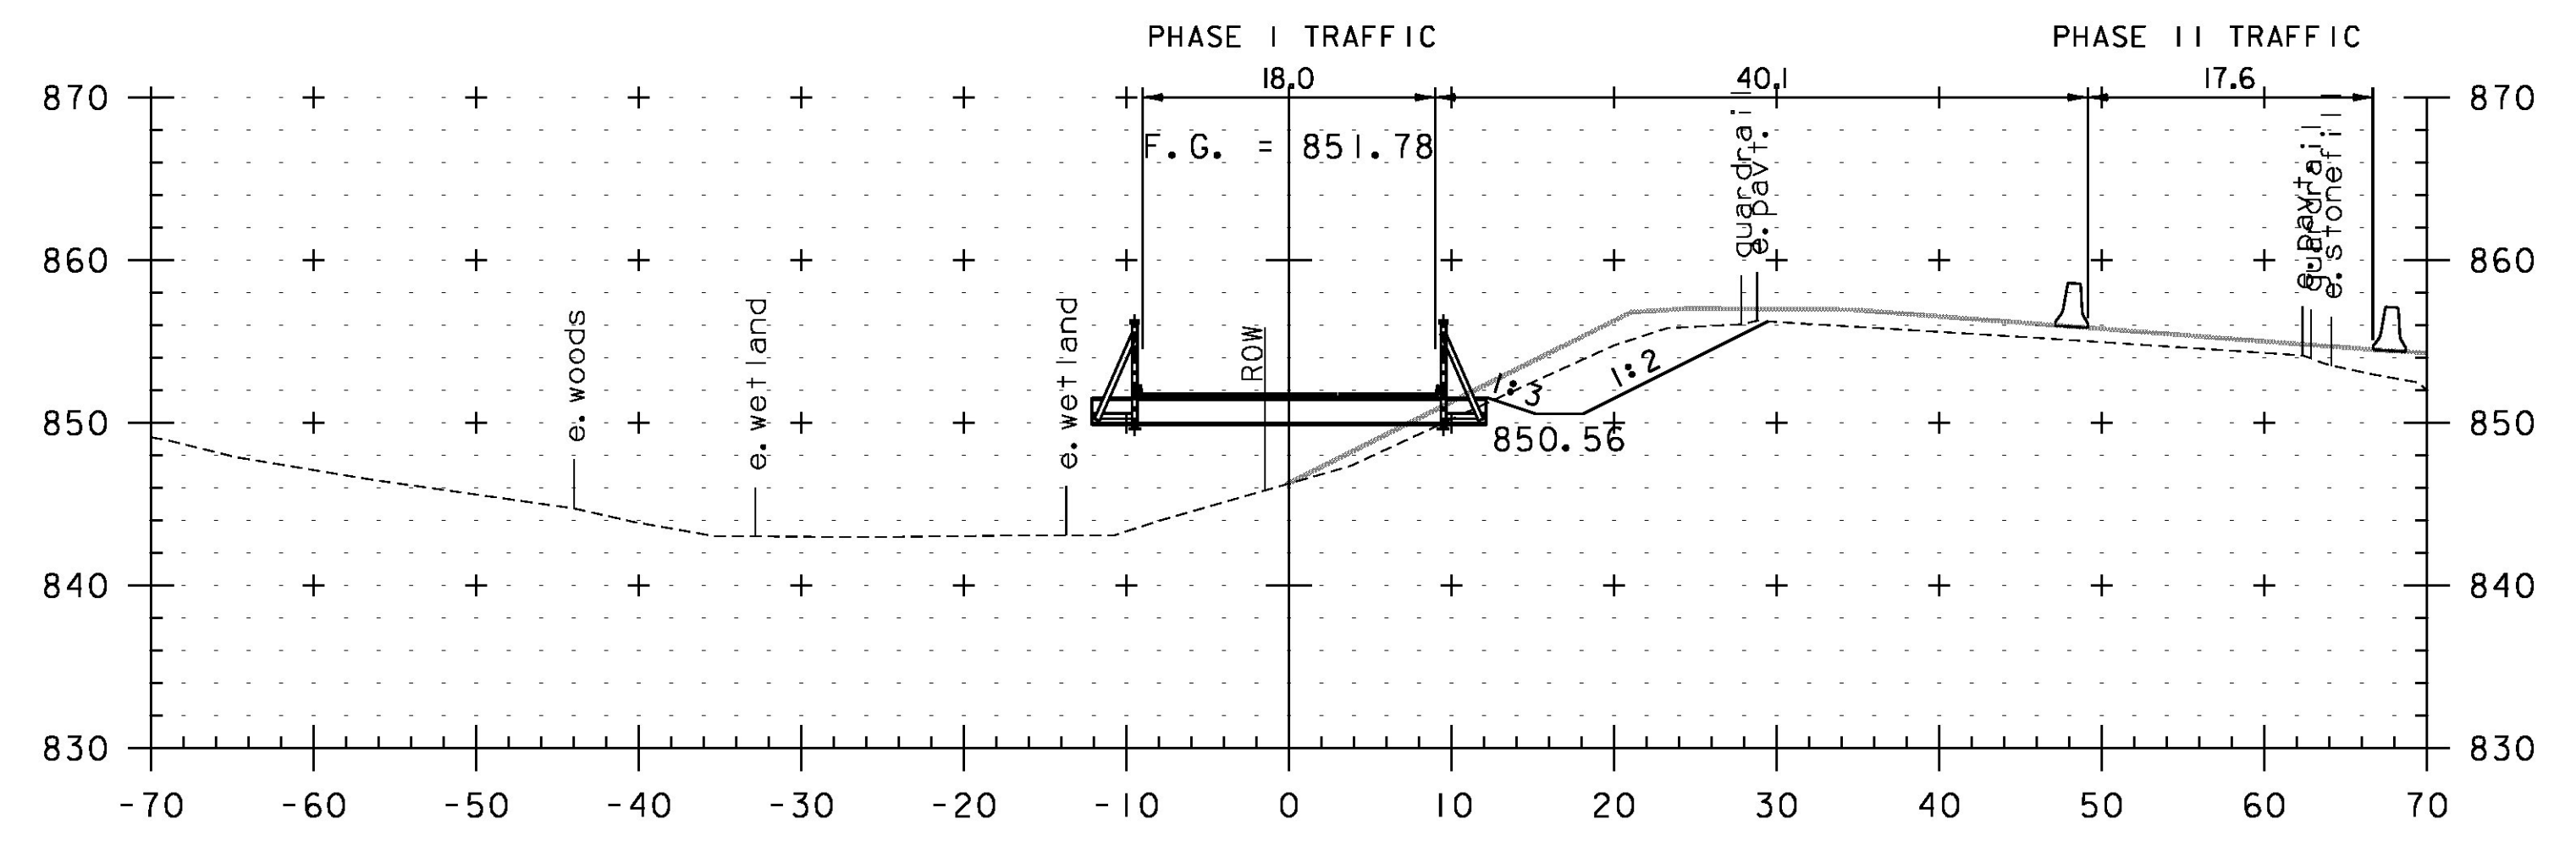

104+50

STA. 103+00 TO STA. 105+00

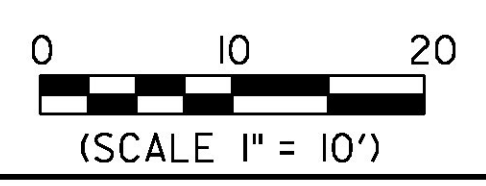

PROJECT NAME:	LUNENBURG	FILE NAME:	IIB294/cos/zlib294xslidtr.dgn	PLOT DATE:	8/6/2015
PROJECT NUMBER:	NH CULV(27)	PROJECT LEADER:	J. BYATT	DRAWN BY:	M. HALEY
		DESIGNED BY:	M. HALEY	CHECKED BY:	P. SHEDD
		TEMPORARY DETOUR CROSS SECTIONS 2			SHEET 56 OF 74