




106+50

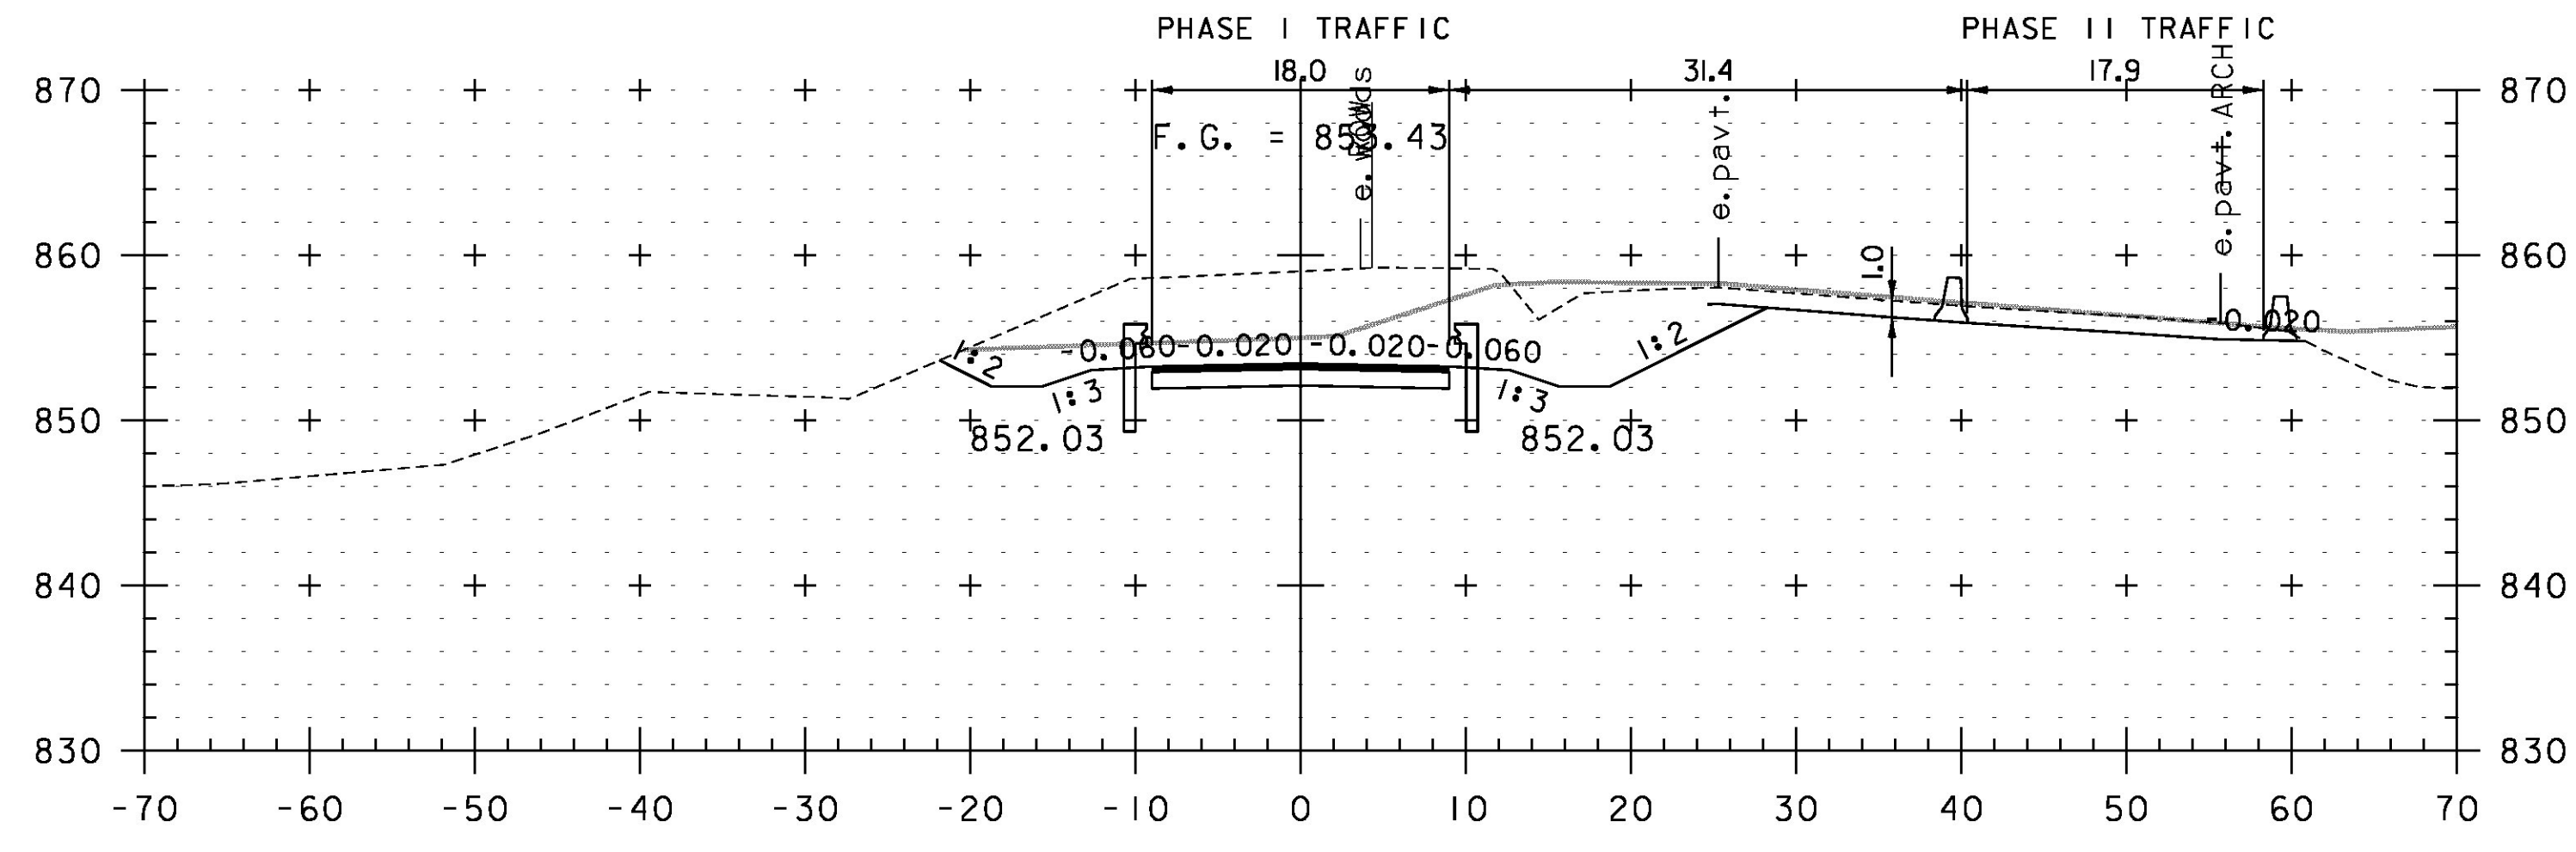


106+00

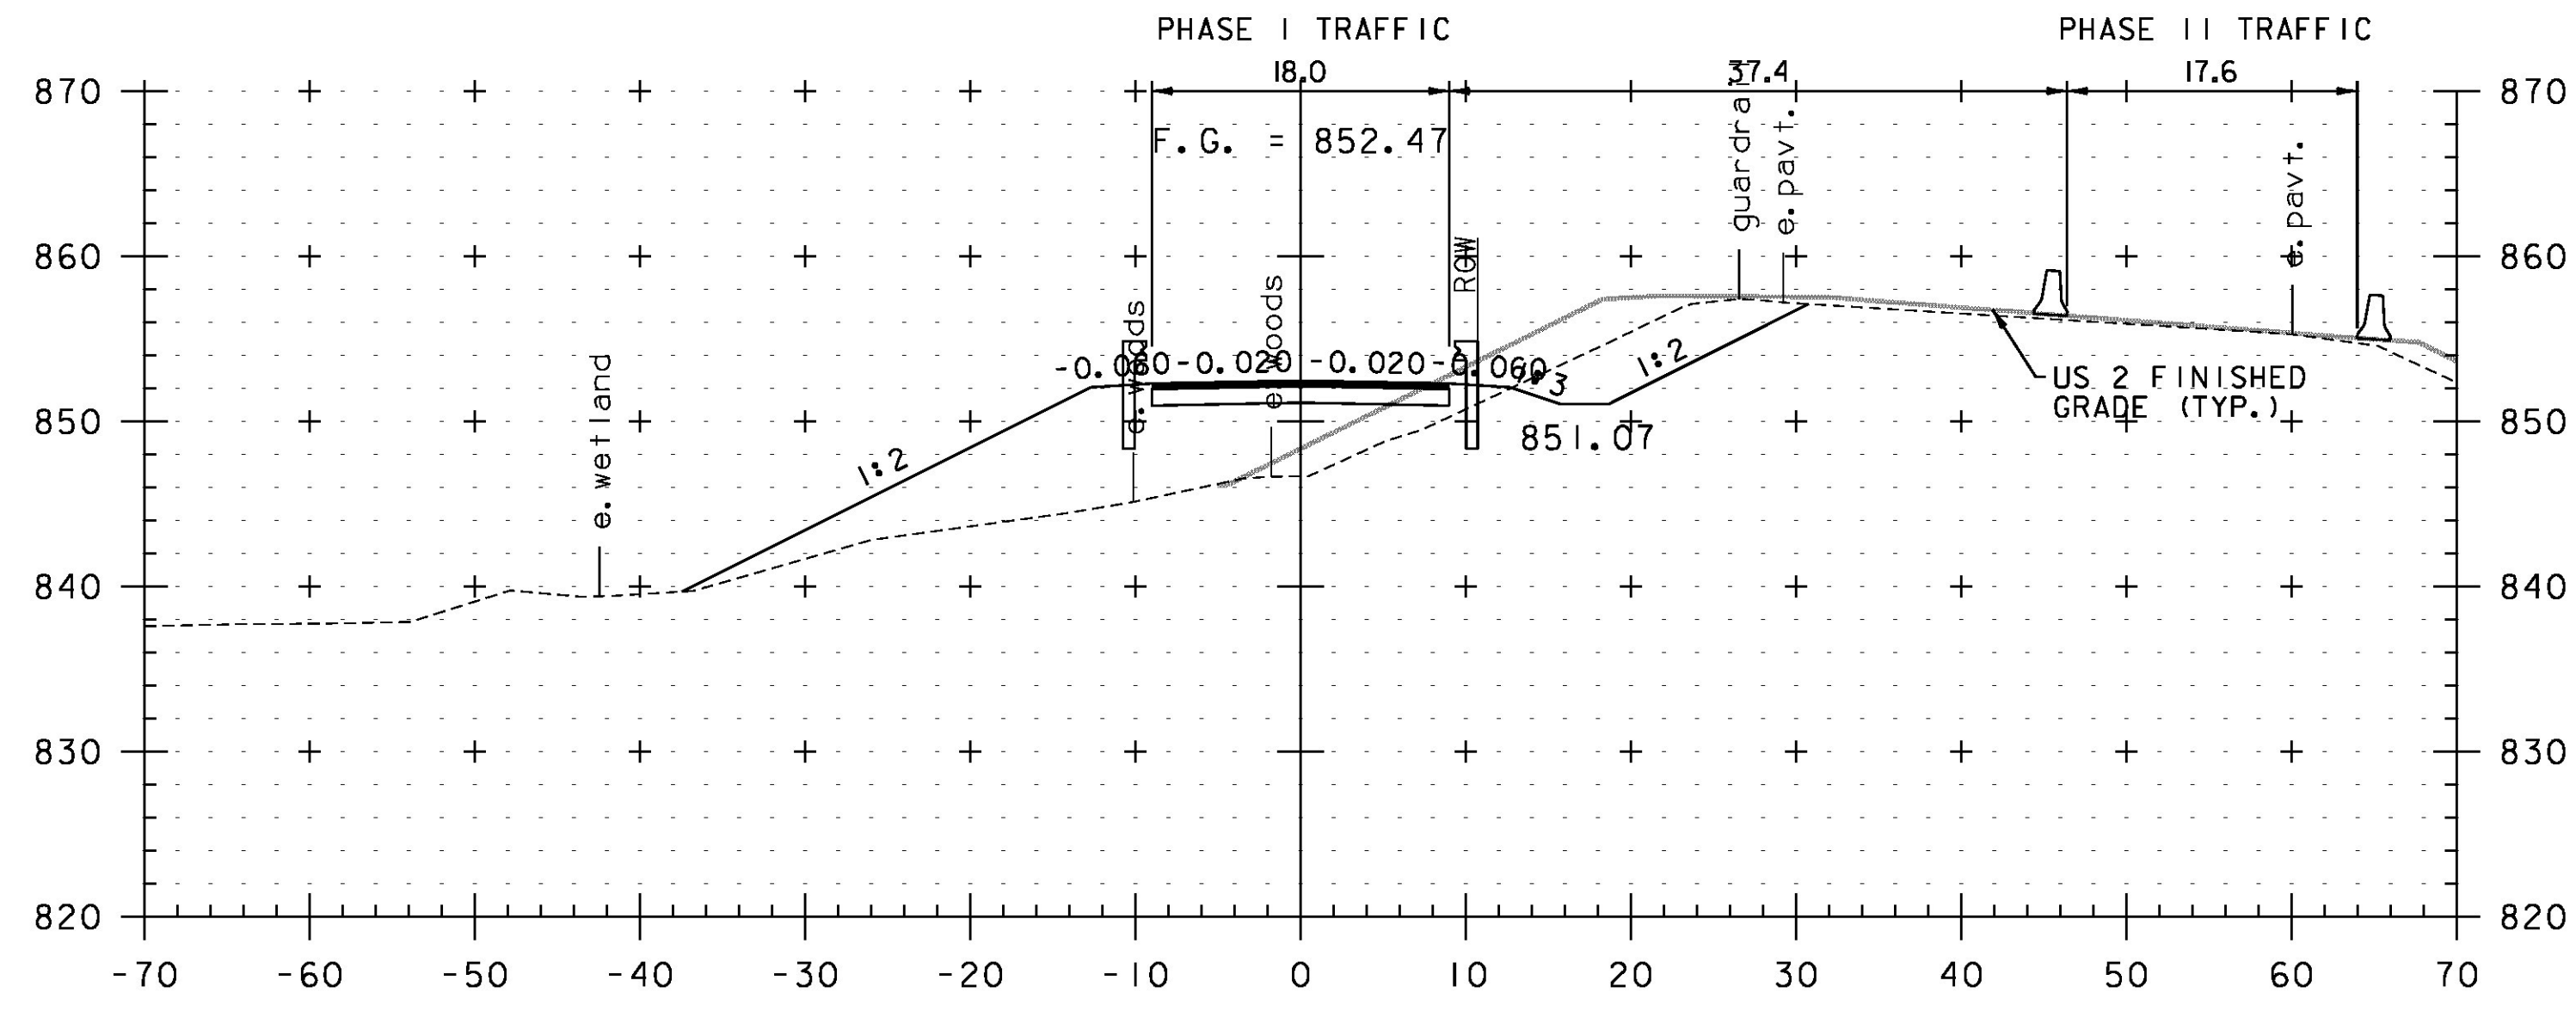


105+50

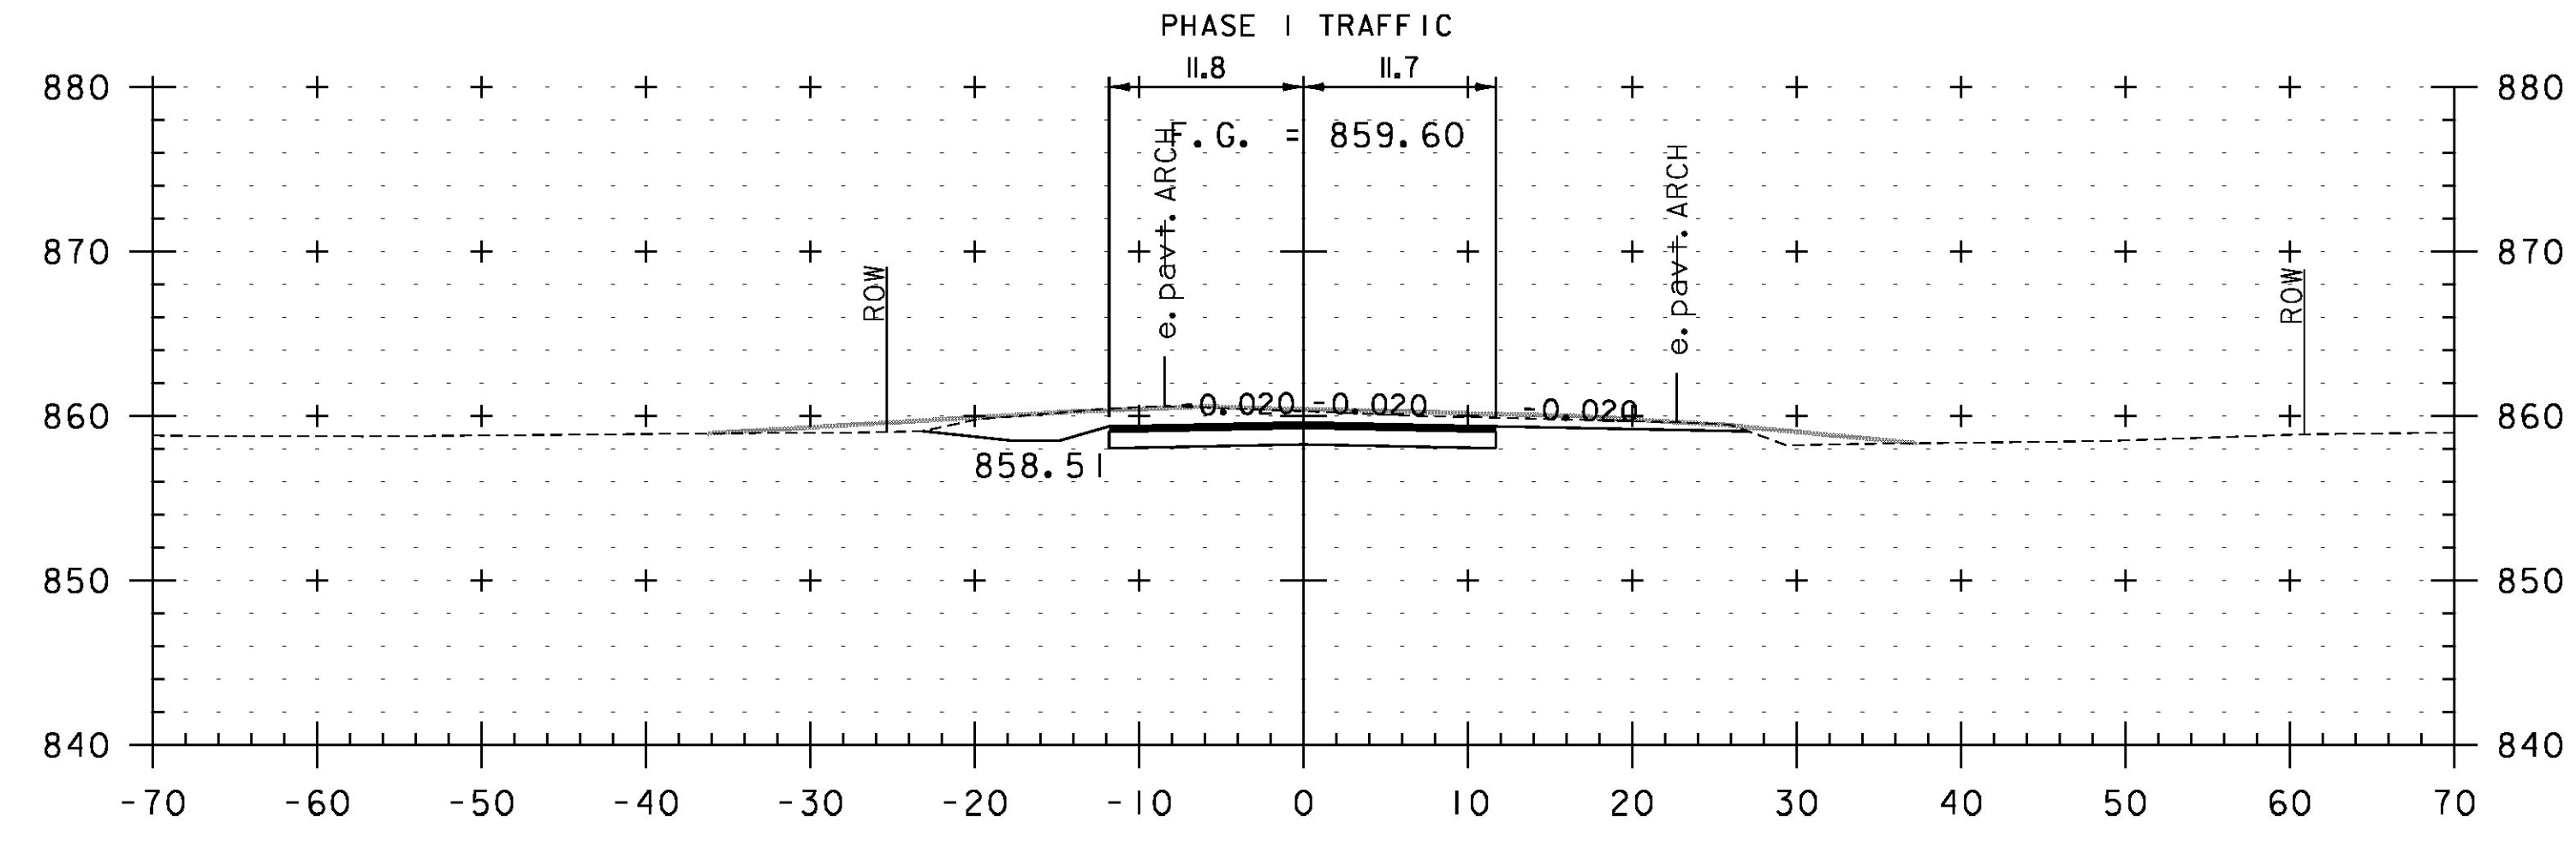

107+50

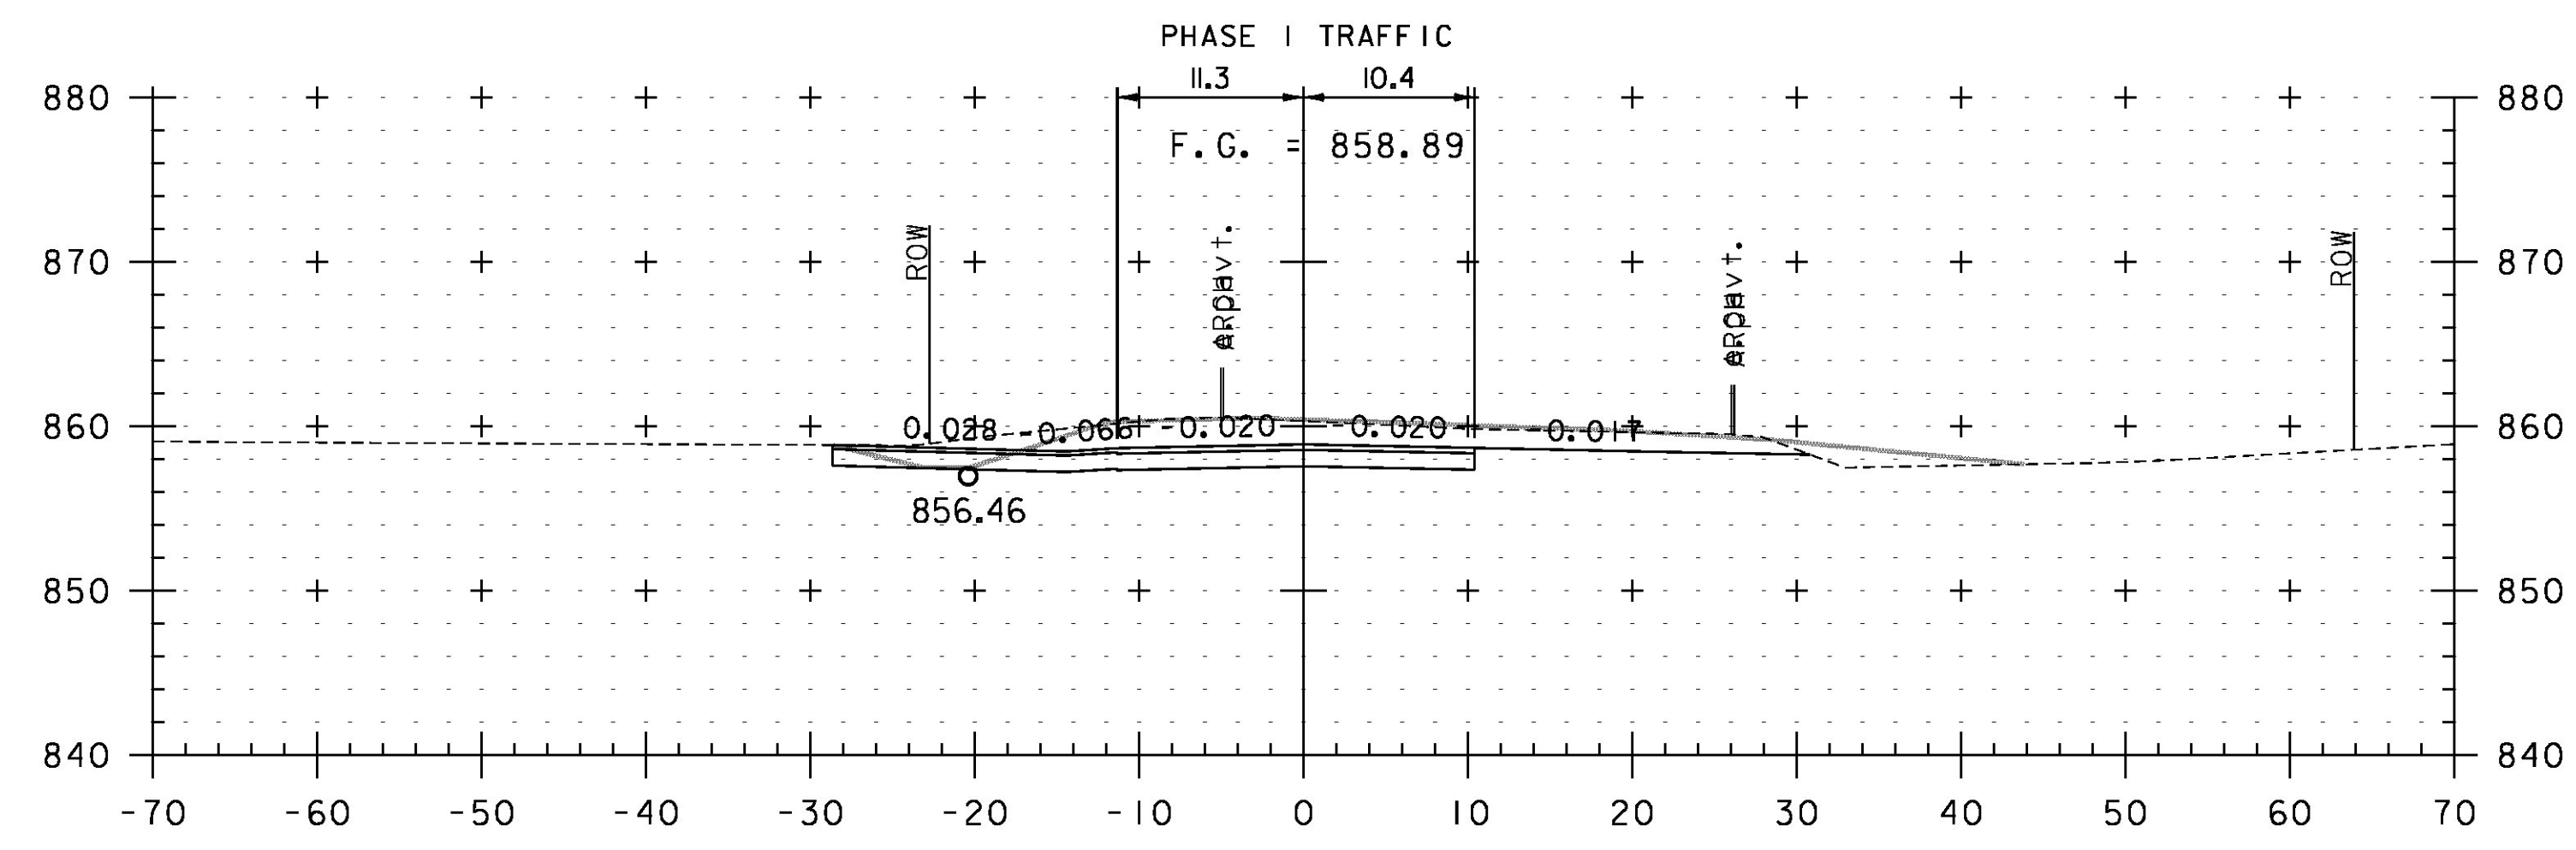


107+33  
DRIVE LT

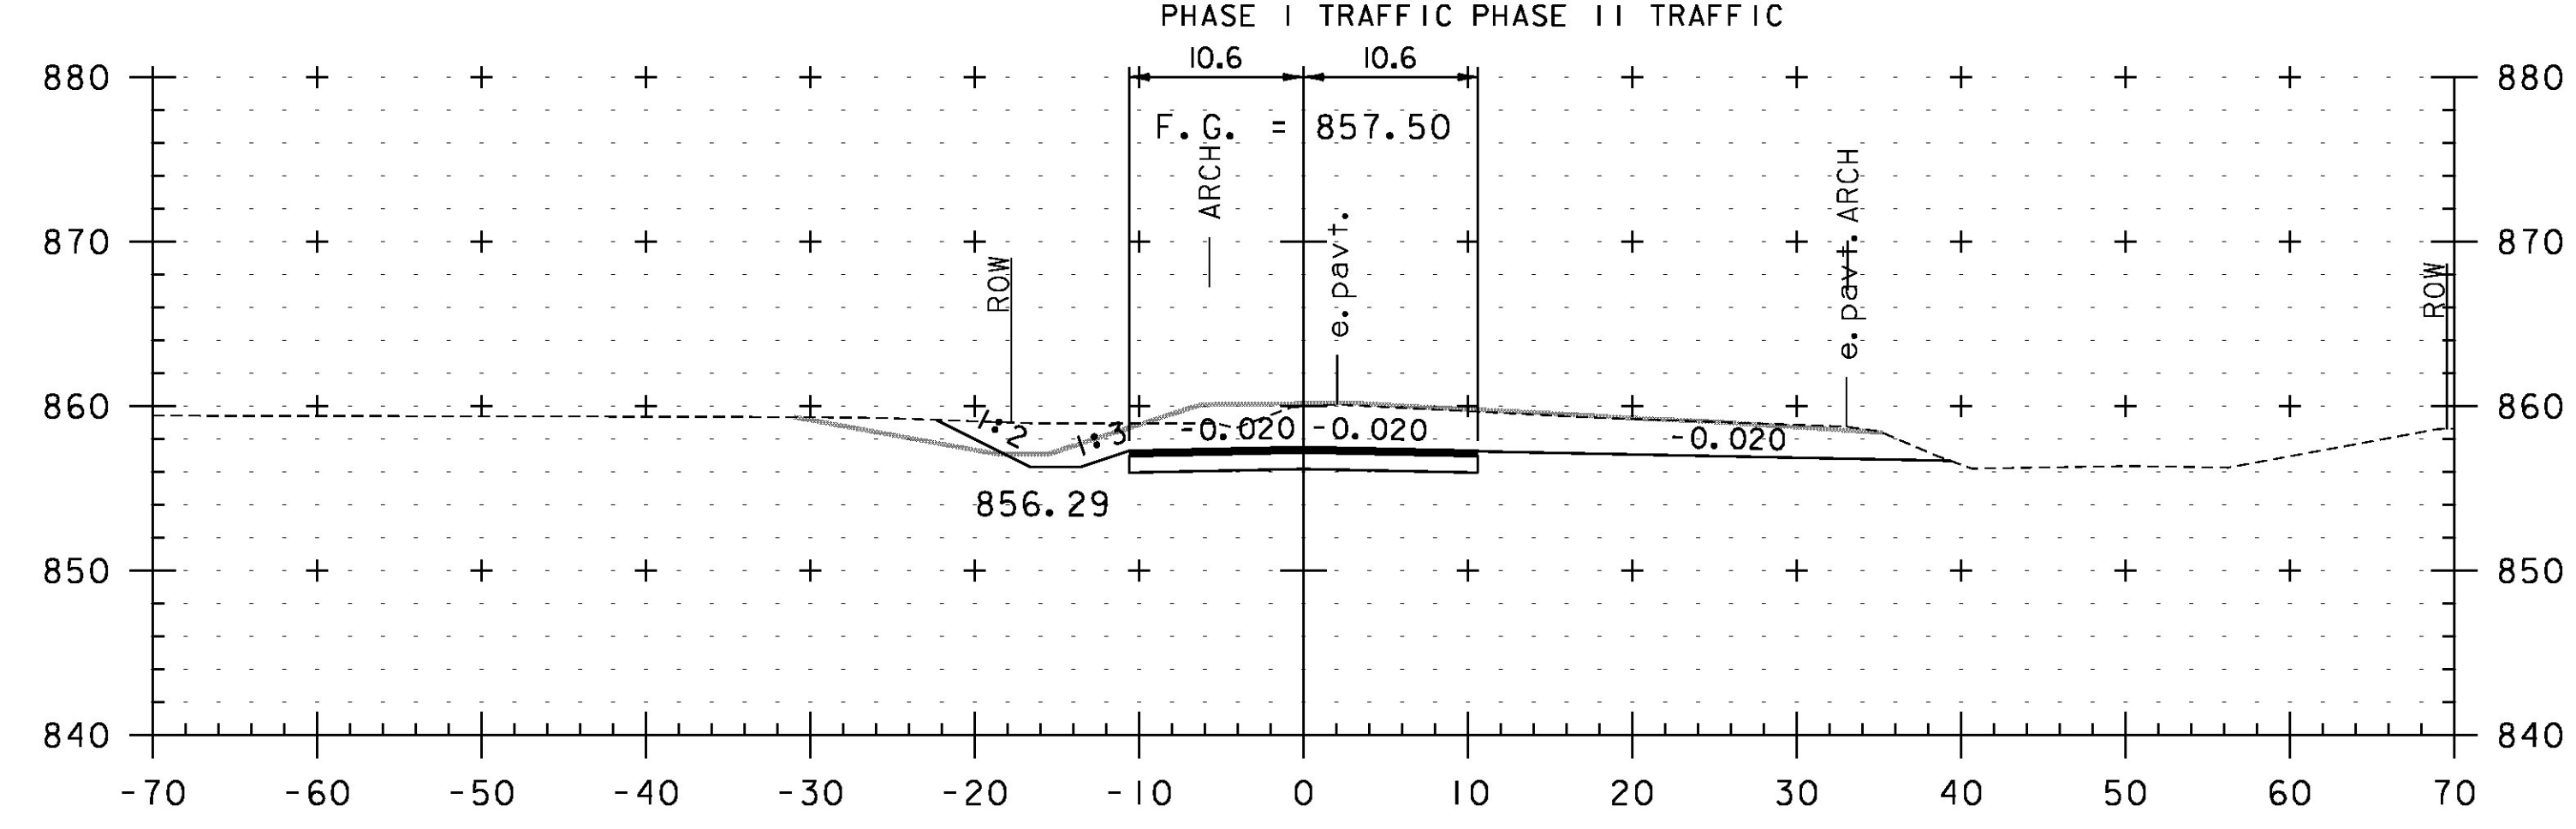

107+00

STA. 105+50 TO STA. 107+50

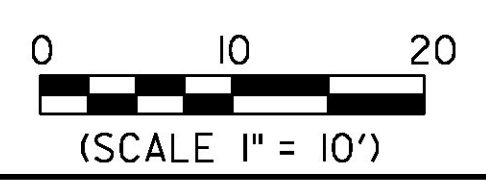

PROJECT NAME:	LUNENBURG	PLOT DATE:	8/6/2015
PROJECT NUMBER:	NH CULV(27)	DRAWN BY:	M. HALEY
FILE NAME:	IIB294/cos/zlib294xslidtr.dgn	CHECKED BY:	P. SHEDD
DESIGNED BY:	M. HALEY	TEMPORARY DETOUR CROSS SECTIONS	3
		SHEET	57 OF 74

CLD\_12-0106 MODEL: XS03