




108+50

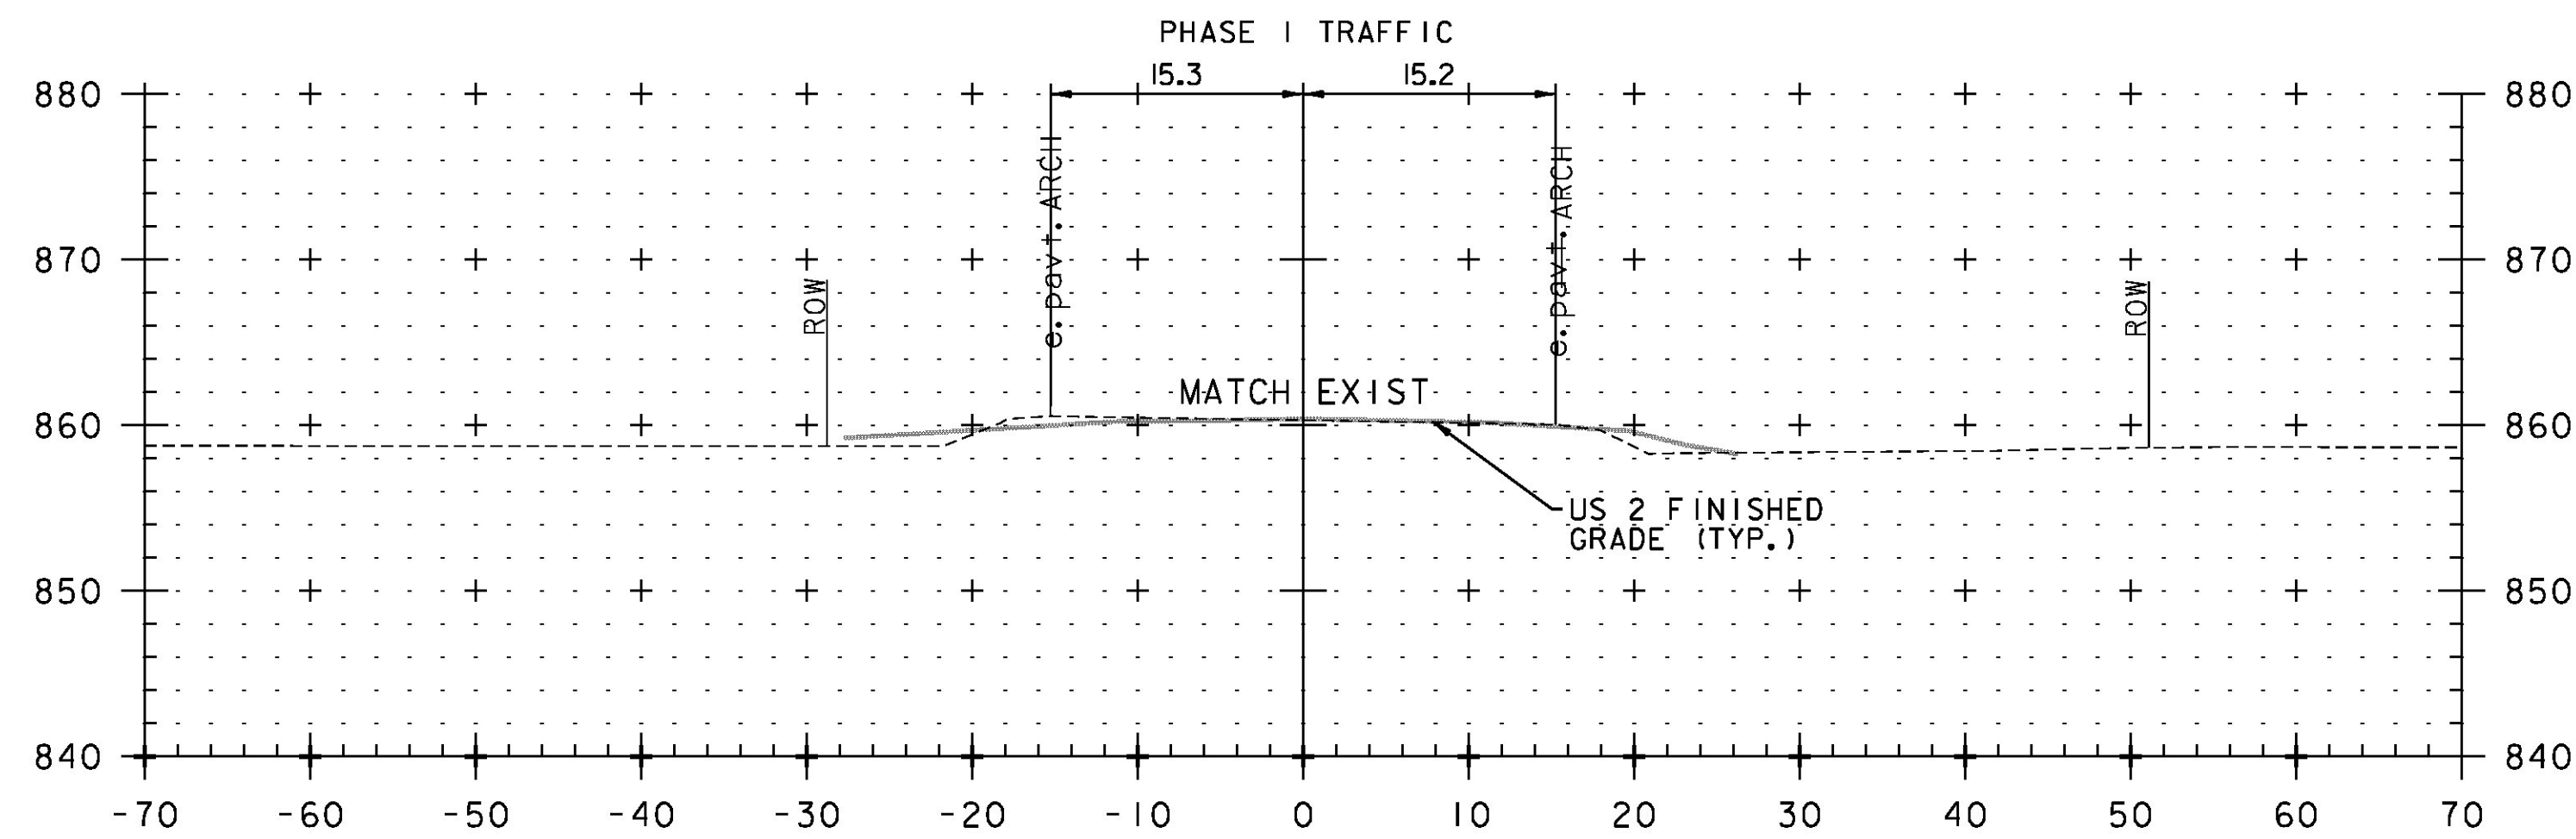

108+25
END DETOUR

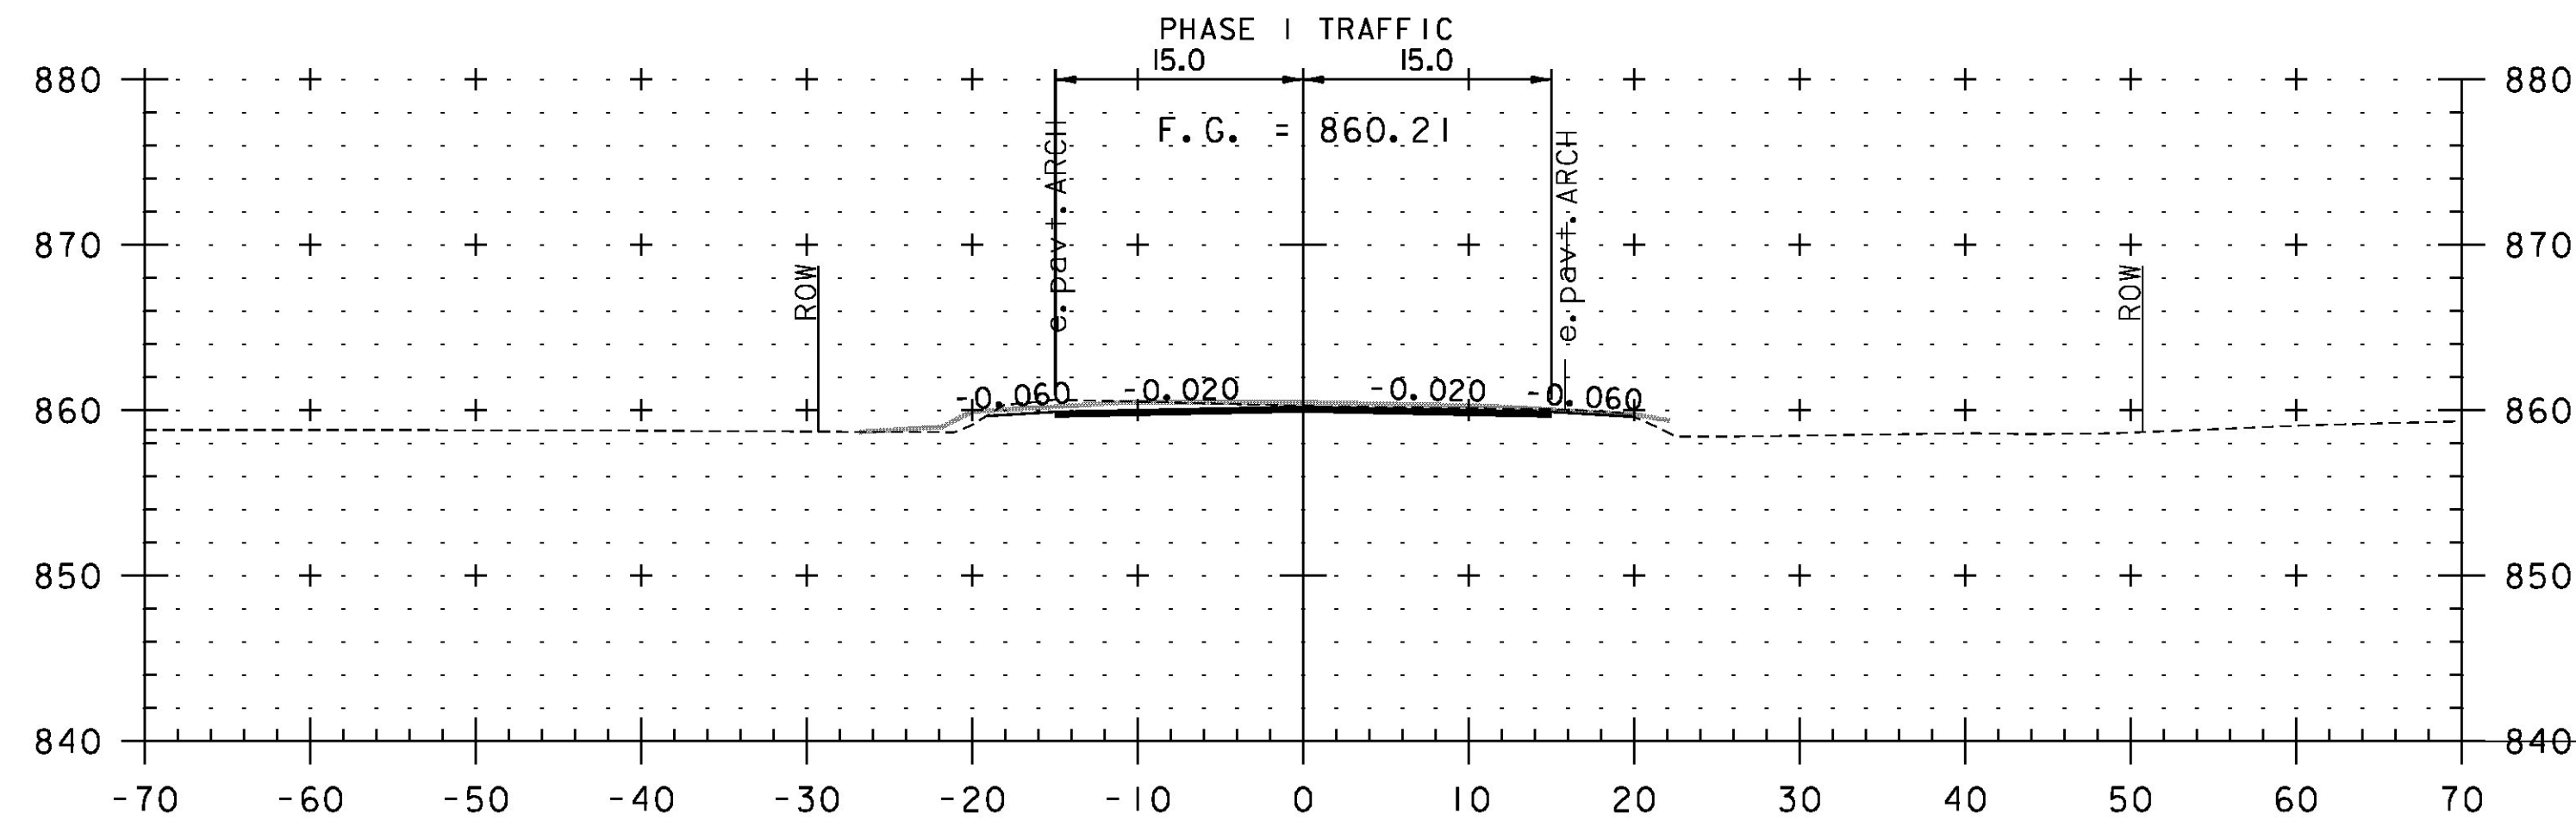

108+00

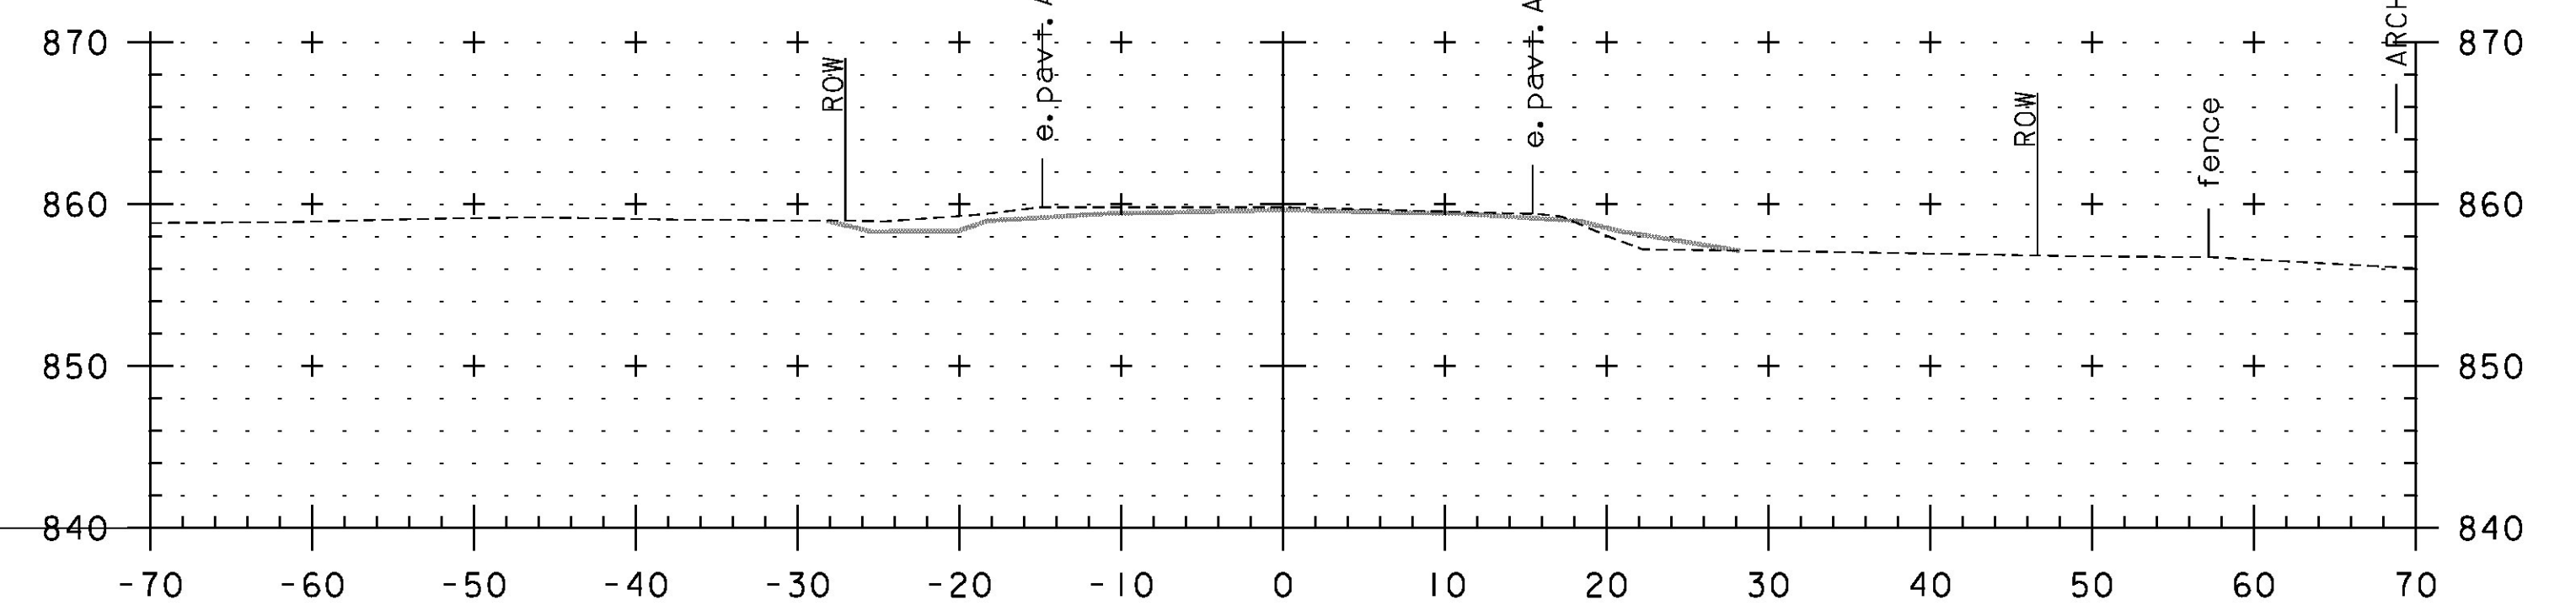

109+00

STA. 108+00 TO STA. 109+00

PROJECT NAME: LUNENBURG
PROJECT NUMBER: NH CULV(27)

FILE NAME: IIB294/cos/zlib294xslidtr.dgn PLOT DATE: 8/6/2015
PROJECT LEADER: J. BYATT DRAWN BY: M. HALEY
DESIGNED BY: M. HALEY CHECKED BY: P. SHEDD
TEMPORARY DETOUR CROSS SECTIONS 4 SHEET 58 OF 74

