



0+50

STA. 0+27 RT  
 BEGIN UNCLASSIFIED CHANNEL EXCAVATION  
 SPECIAL PROVISION (STONE FILL, STREAM BED MATERIAL)  
 GEOTEXTILE UNDER STONE FILL  
 GRUBBING MATERIAL

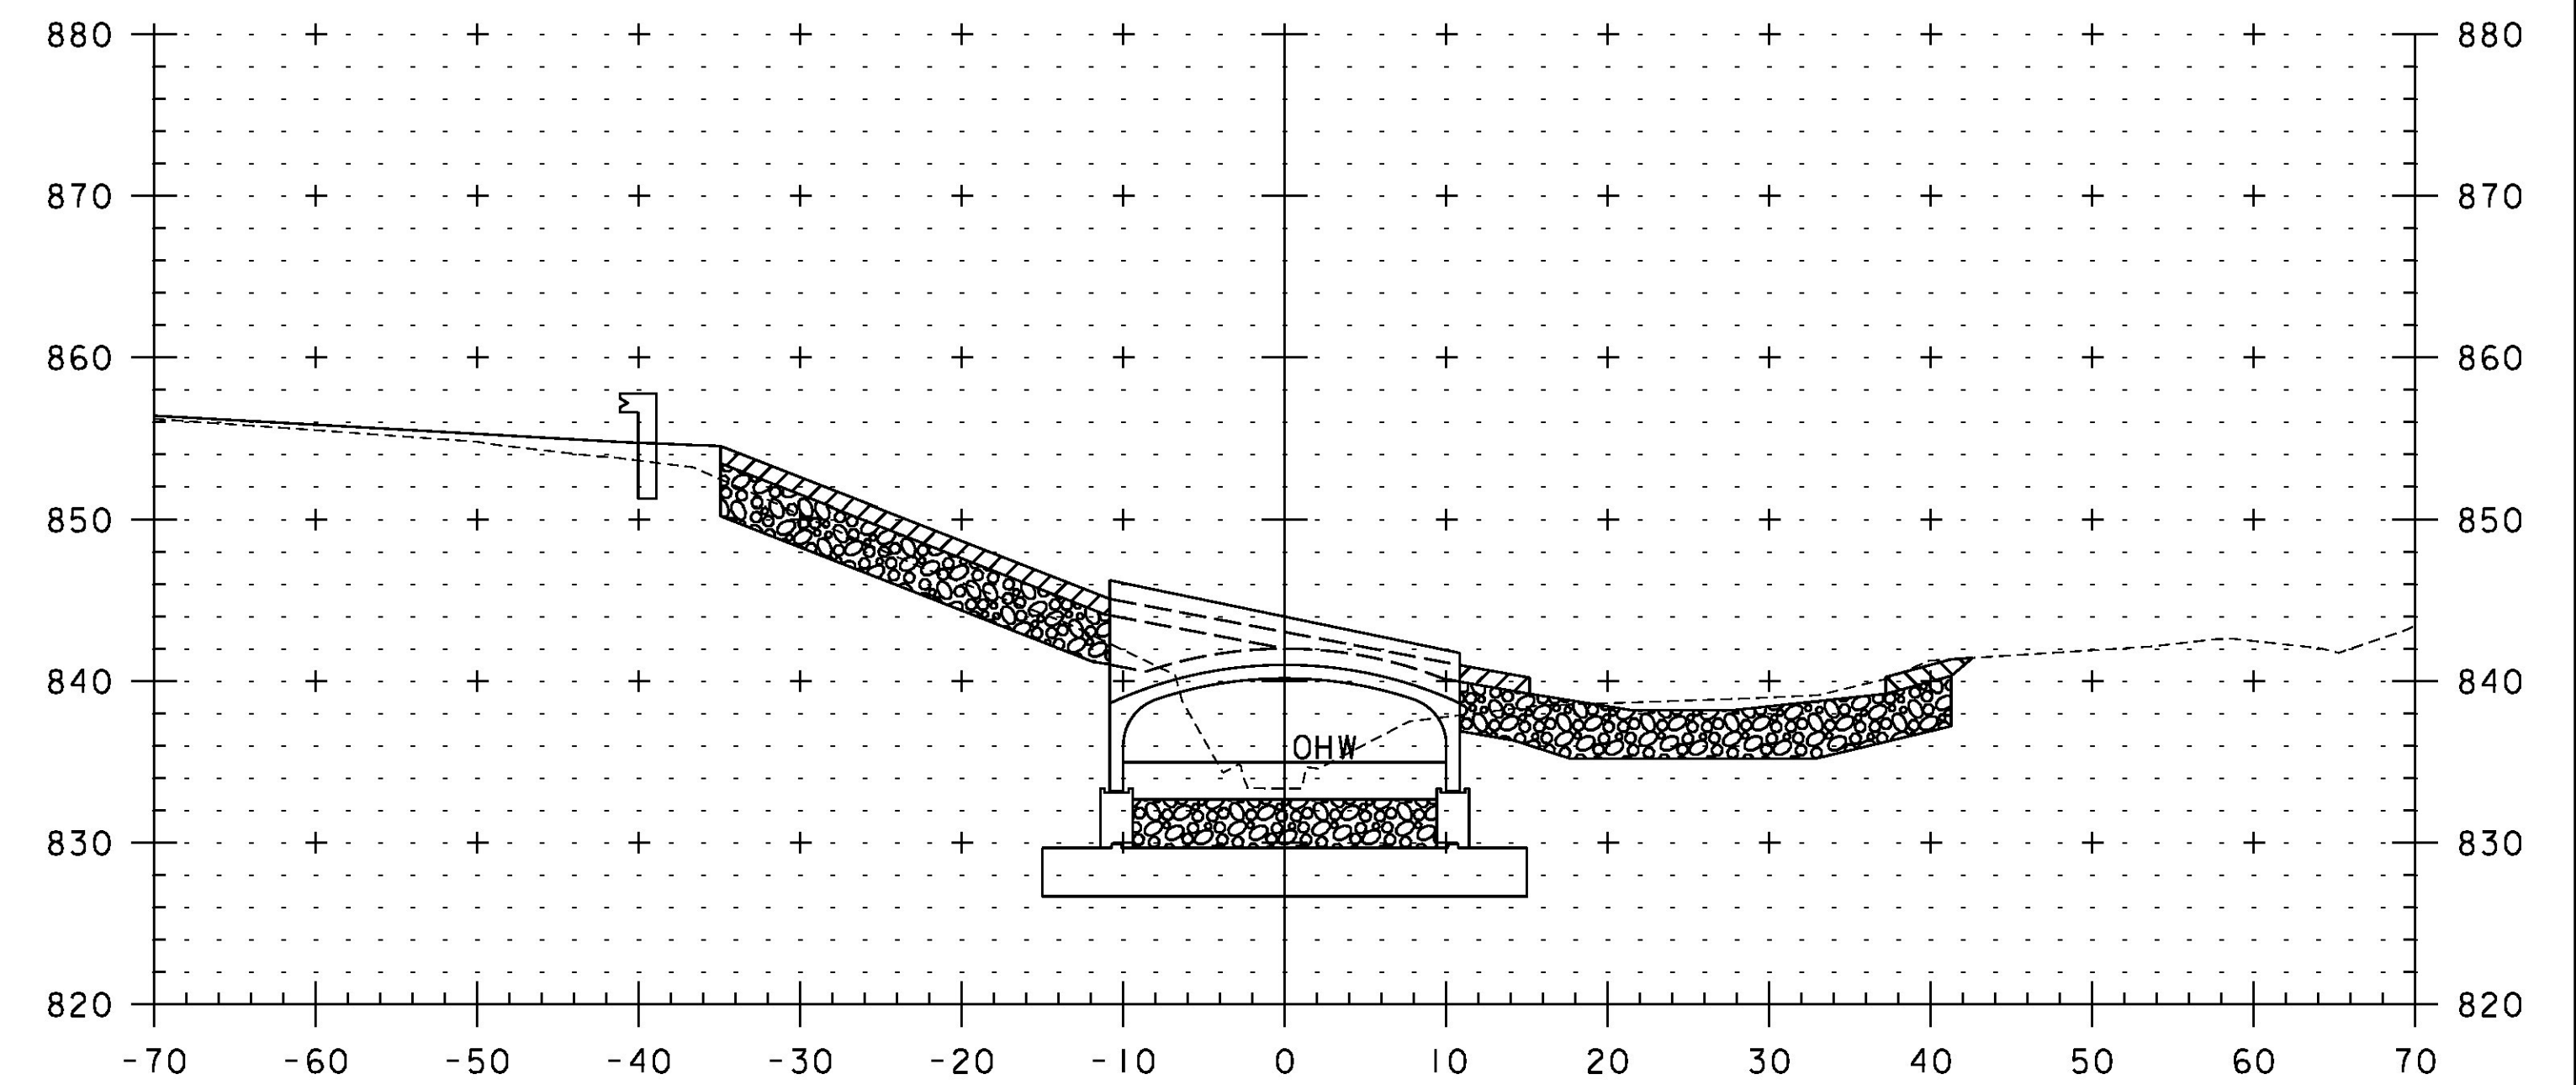


0+98 END ARCH

STA. 0+86 LT AND RT  
 STOP UNCLASSIFIED CHANNEL EXCAVATION  
 SPECIAL PROVISION STONE  
 FILL, STREAM BED MATERIAL  
 GEOTEXTILE UNDER STONE FILL  
 GRUBBING MATERIAL

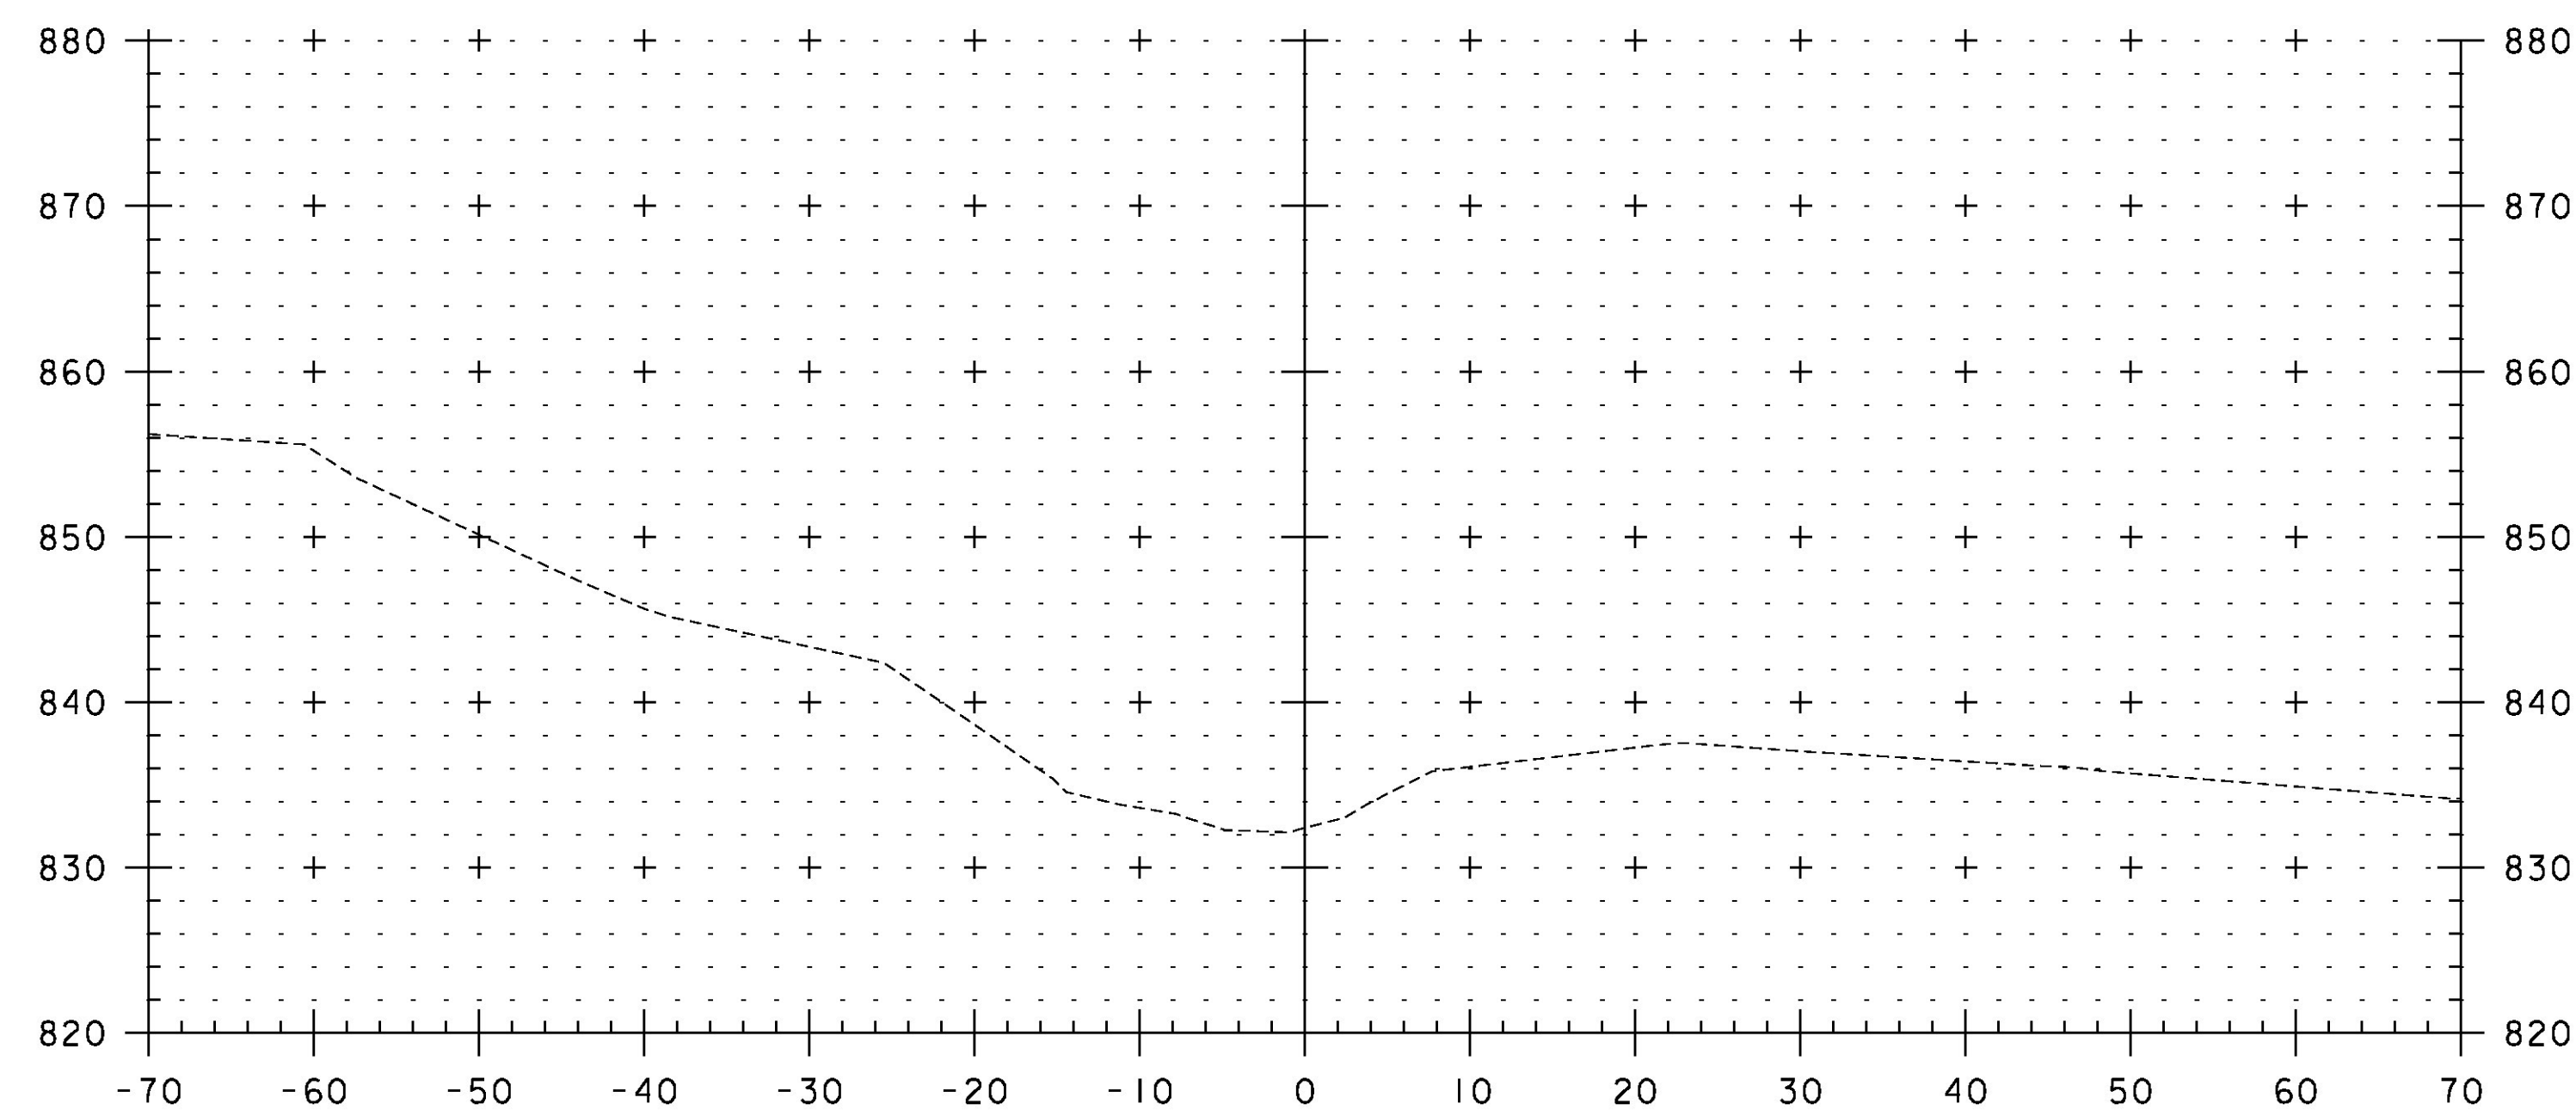

0+25 LIMIT OF WORK


STA. 0+25 LT  
 BEGIN UNCLASSIFIED CHANNEL EXCAVATION  
 SPECIAL PROVISION (STONE FILL, STREAM BED MATERIAL)  
 GEOTEXTILE UNDER STONE FILL  
 GRUBBING MATERIAL

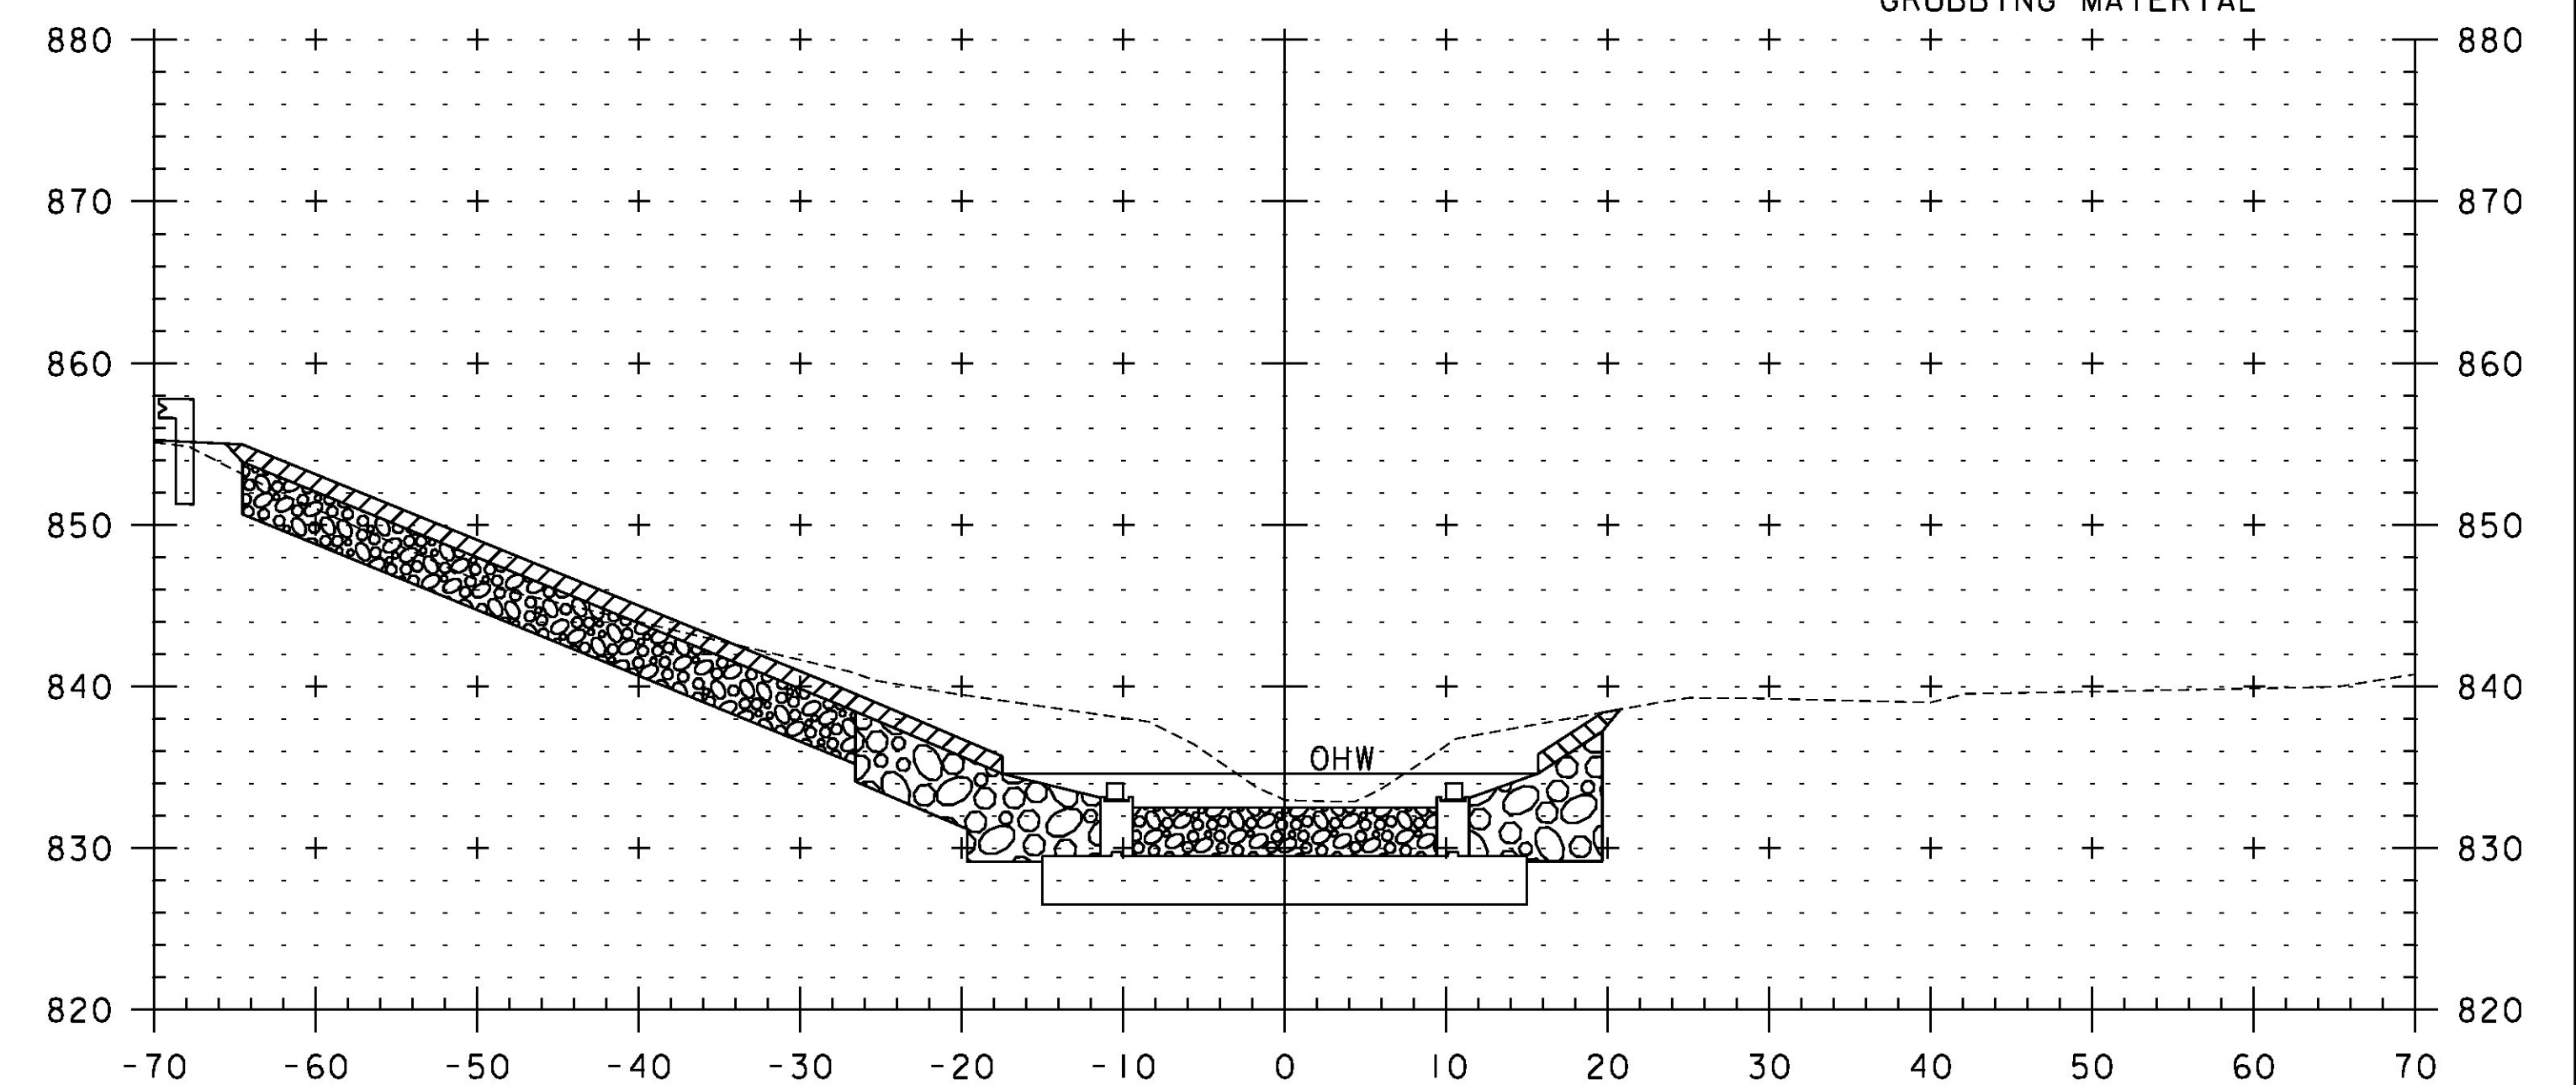

0+76 INVERT OUT

STA. 0+76 LT AND RT  
 BEGIN SPECIAL PROVISION (STONE  
 FILL, CULVERT LINING)

STA. 0+25 TO STA. 0+92

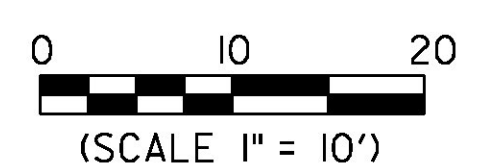

PROJECT NAME:	LUNENBURG
PROJECT NUMBER:	NH CULV(27)
FILE NAME:	IIB294/cos/zlib294xsichan.dgn
PROJECT LEADER:	J. BYATT
DESIGNED BY:	S. BEAUMONT
CHANNEL CROSS SECTIONS:	1
PLOT DATE:	8/6/2015
DRAWN BY:	M. SMITH
CHECKED BY:	J. BYATT
SHEET:	59 OF 74

CLD\_12-0106 MODEL: XSOI