



2+08 INVERT IN

STA. 2+08 LT AND RT  
 END SPECIAL PROVISION (STONE FILL, CULVERT LINING)  
 BEGIN UNCLASSIFIED CHANNEL EXCAVATION  
 SPECIAL PROVISION (STONE FILL, STREAM BED MATERIAL)  
 GEOTEXTILE UNDER STONE FILL  
 GRUBBING MATERIAL

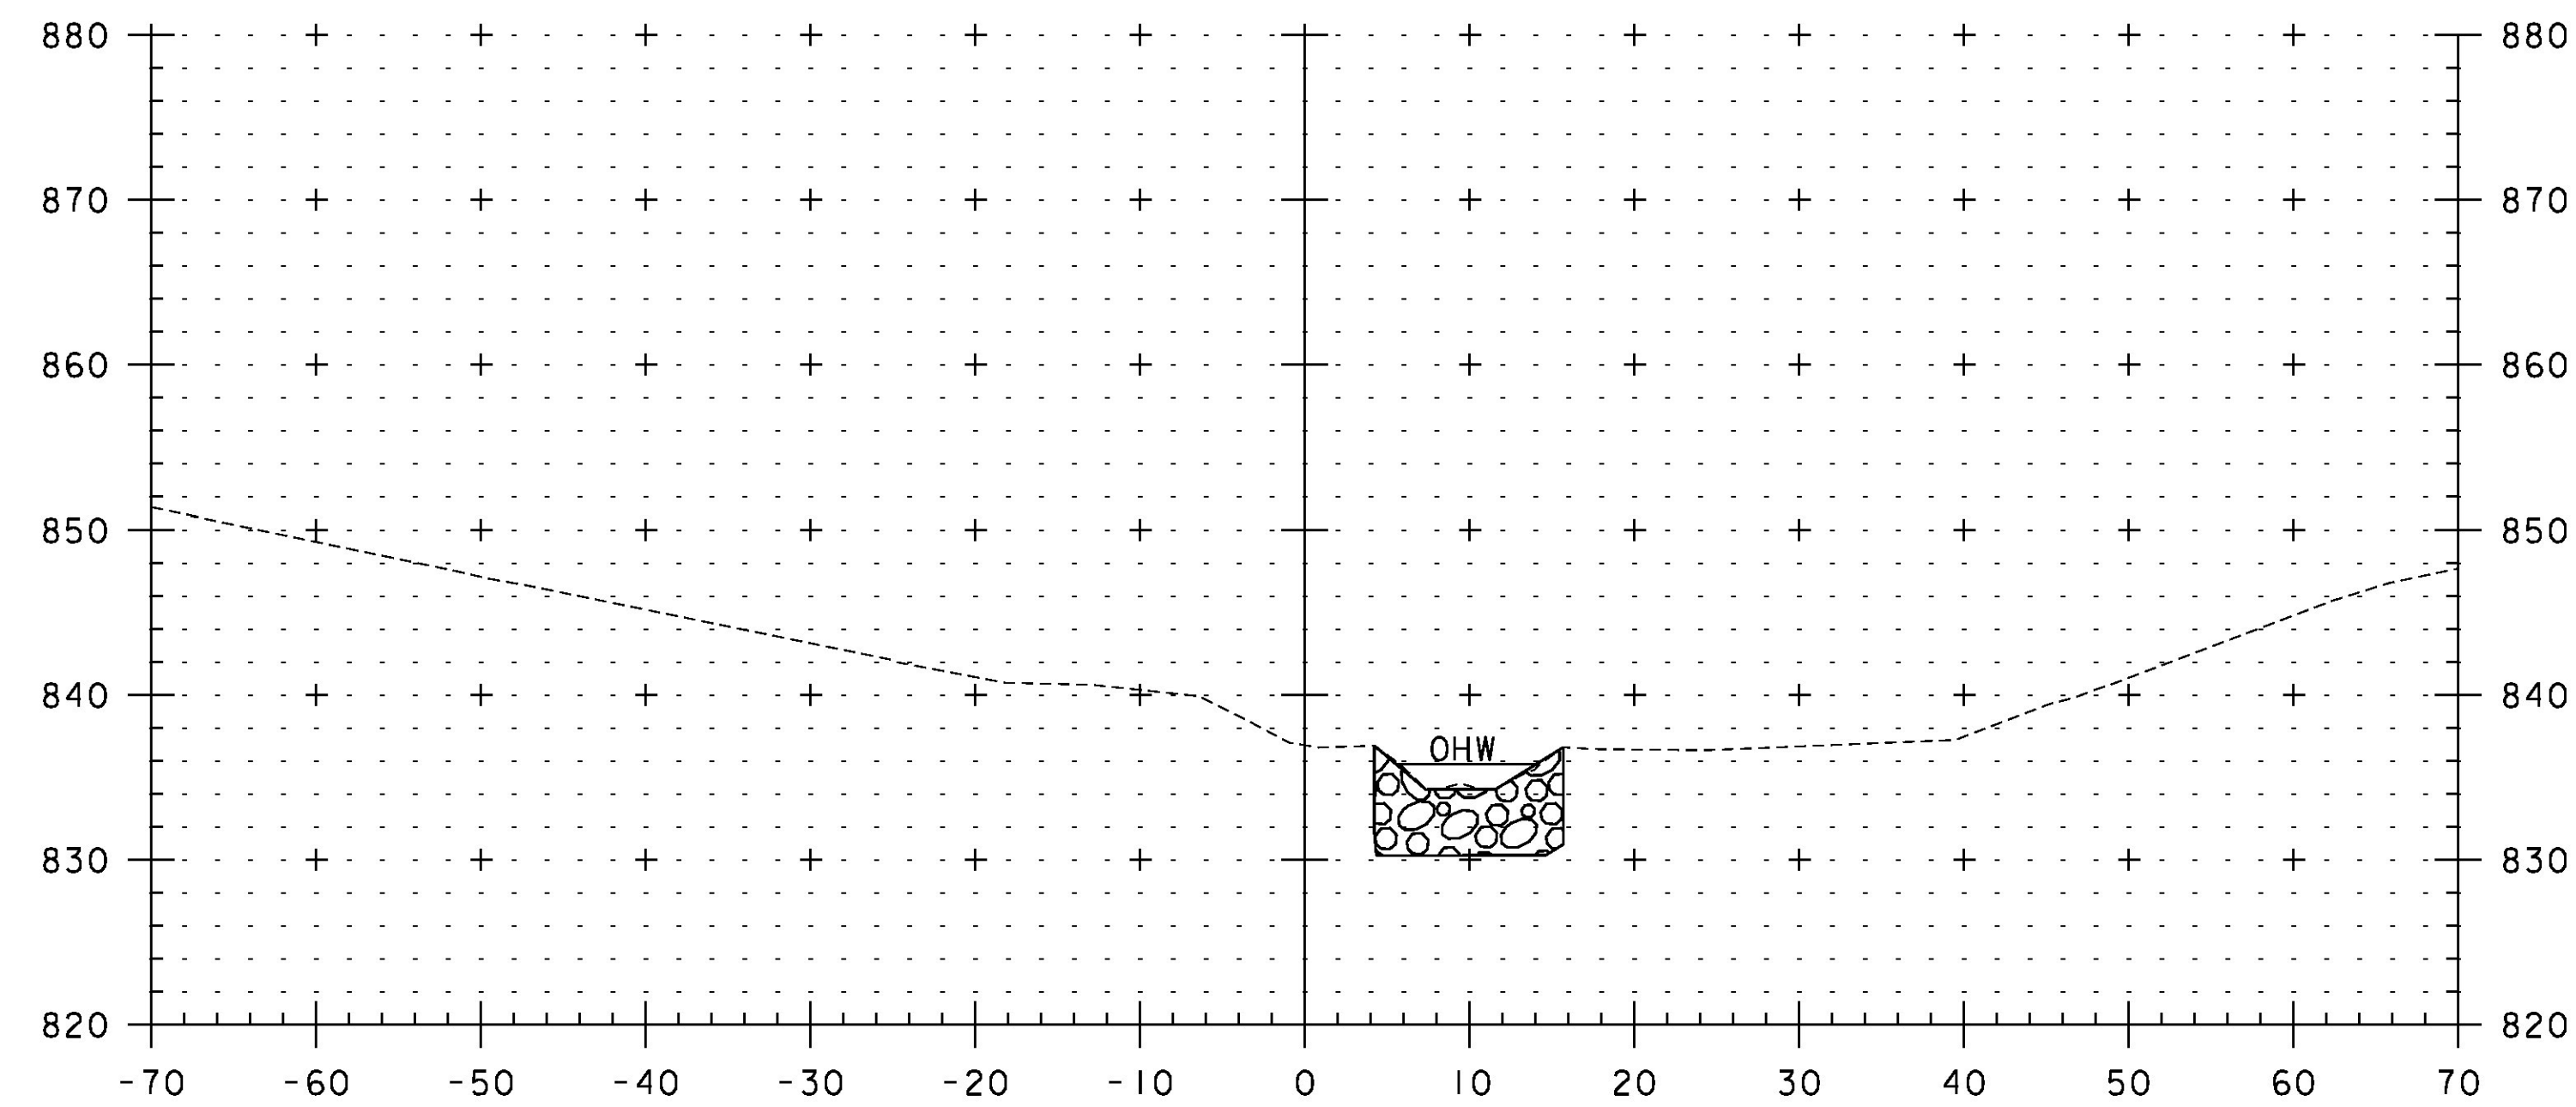


2+50 LIMIT OF WORK

STA. 2+50 LT AND RT  
 END UNCLASSIFIED CHANNEL EXCAVATION  
 SPECIAL PROVISION (STONE FILL,  
 STREAM BED MATERIAL)  
 GEOTEXTILE UNDER STONE FILL  
 GRUBBING MATERIAL

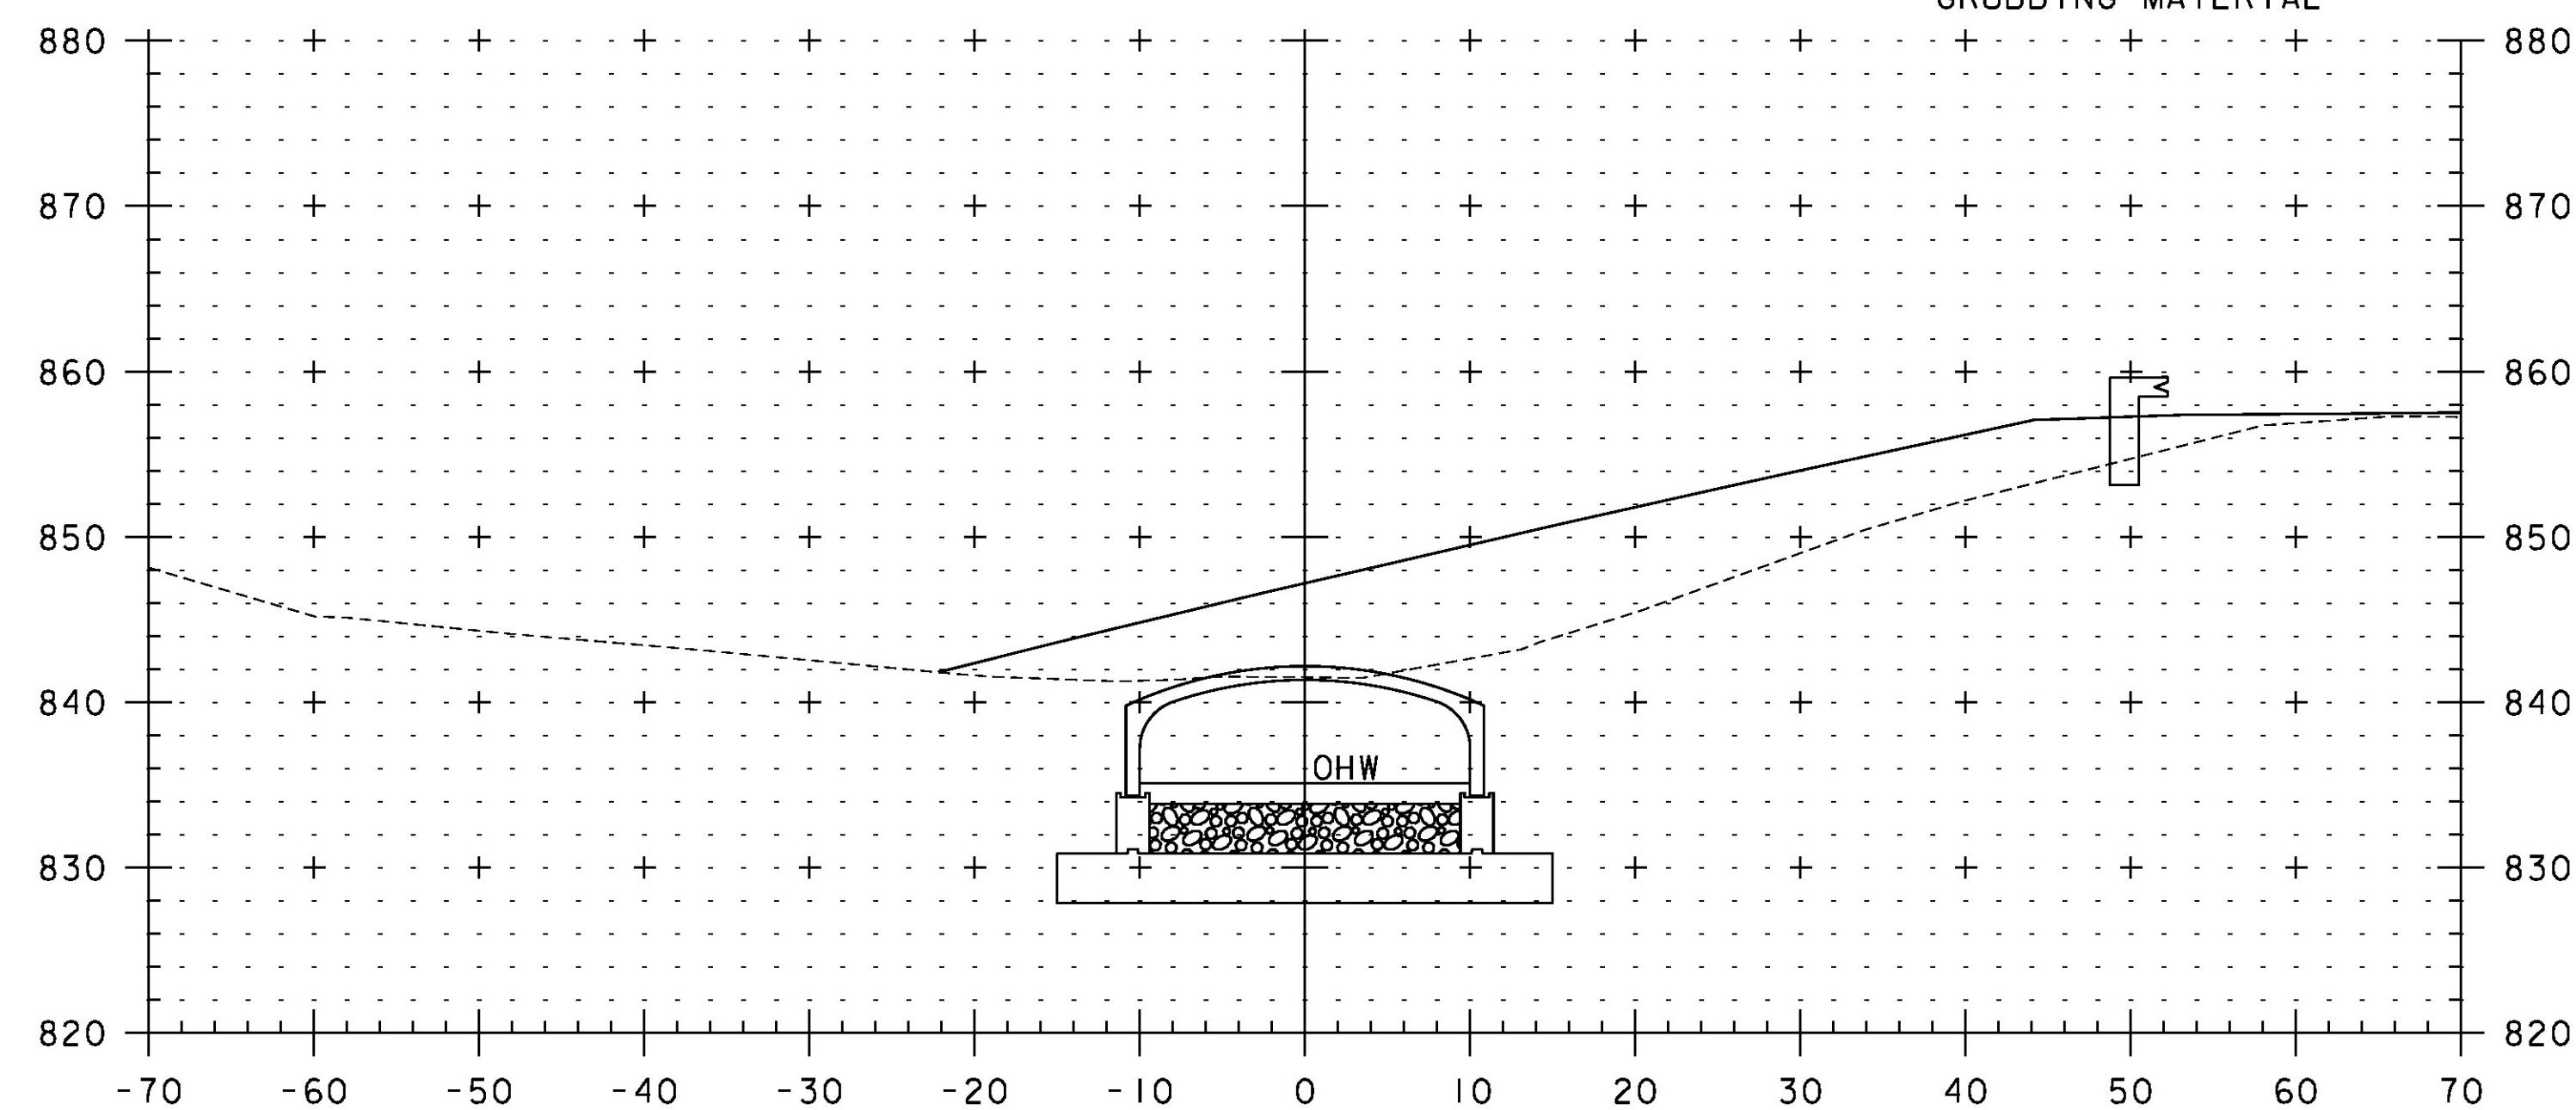


2+00

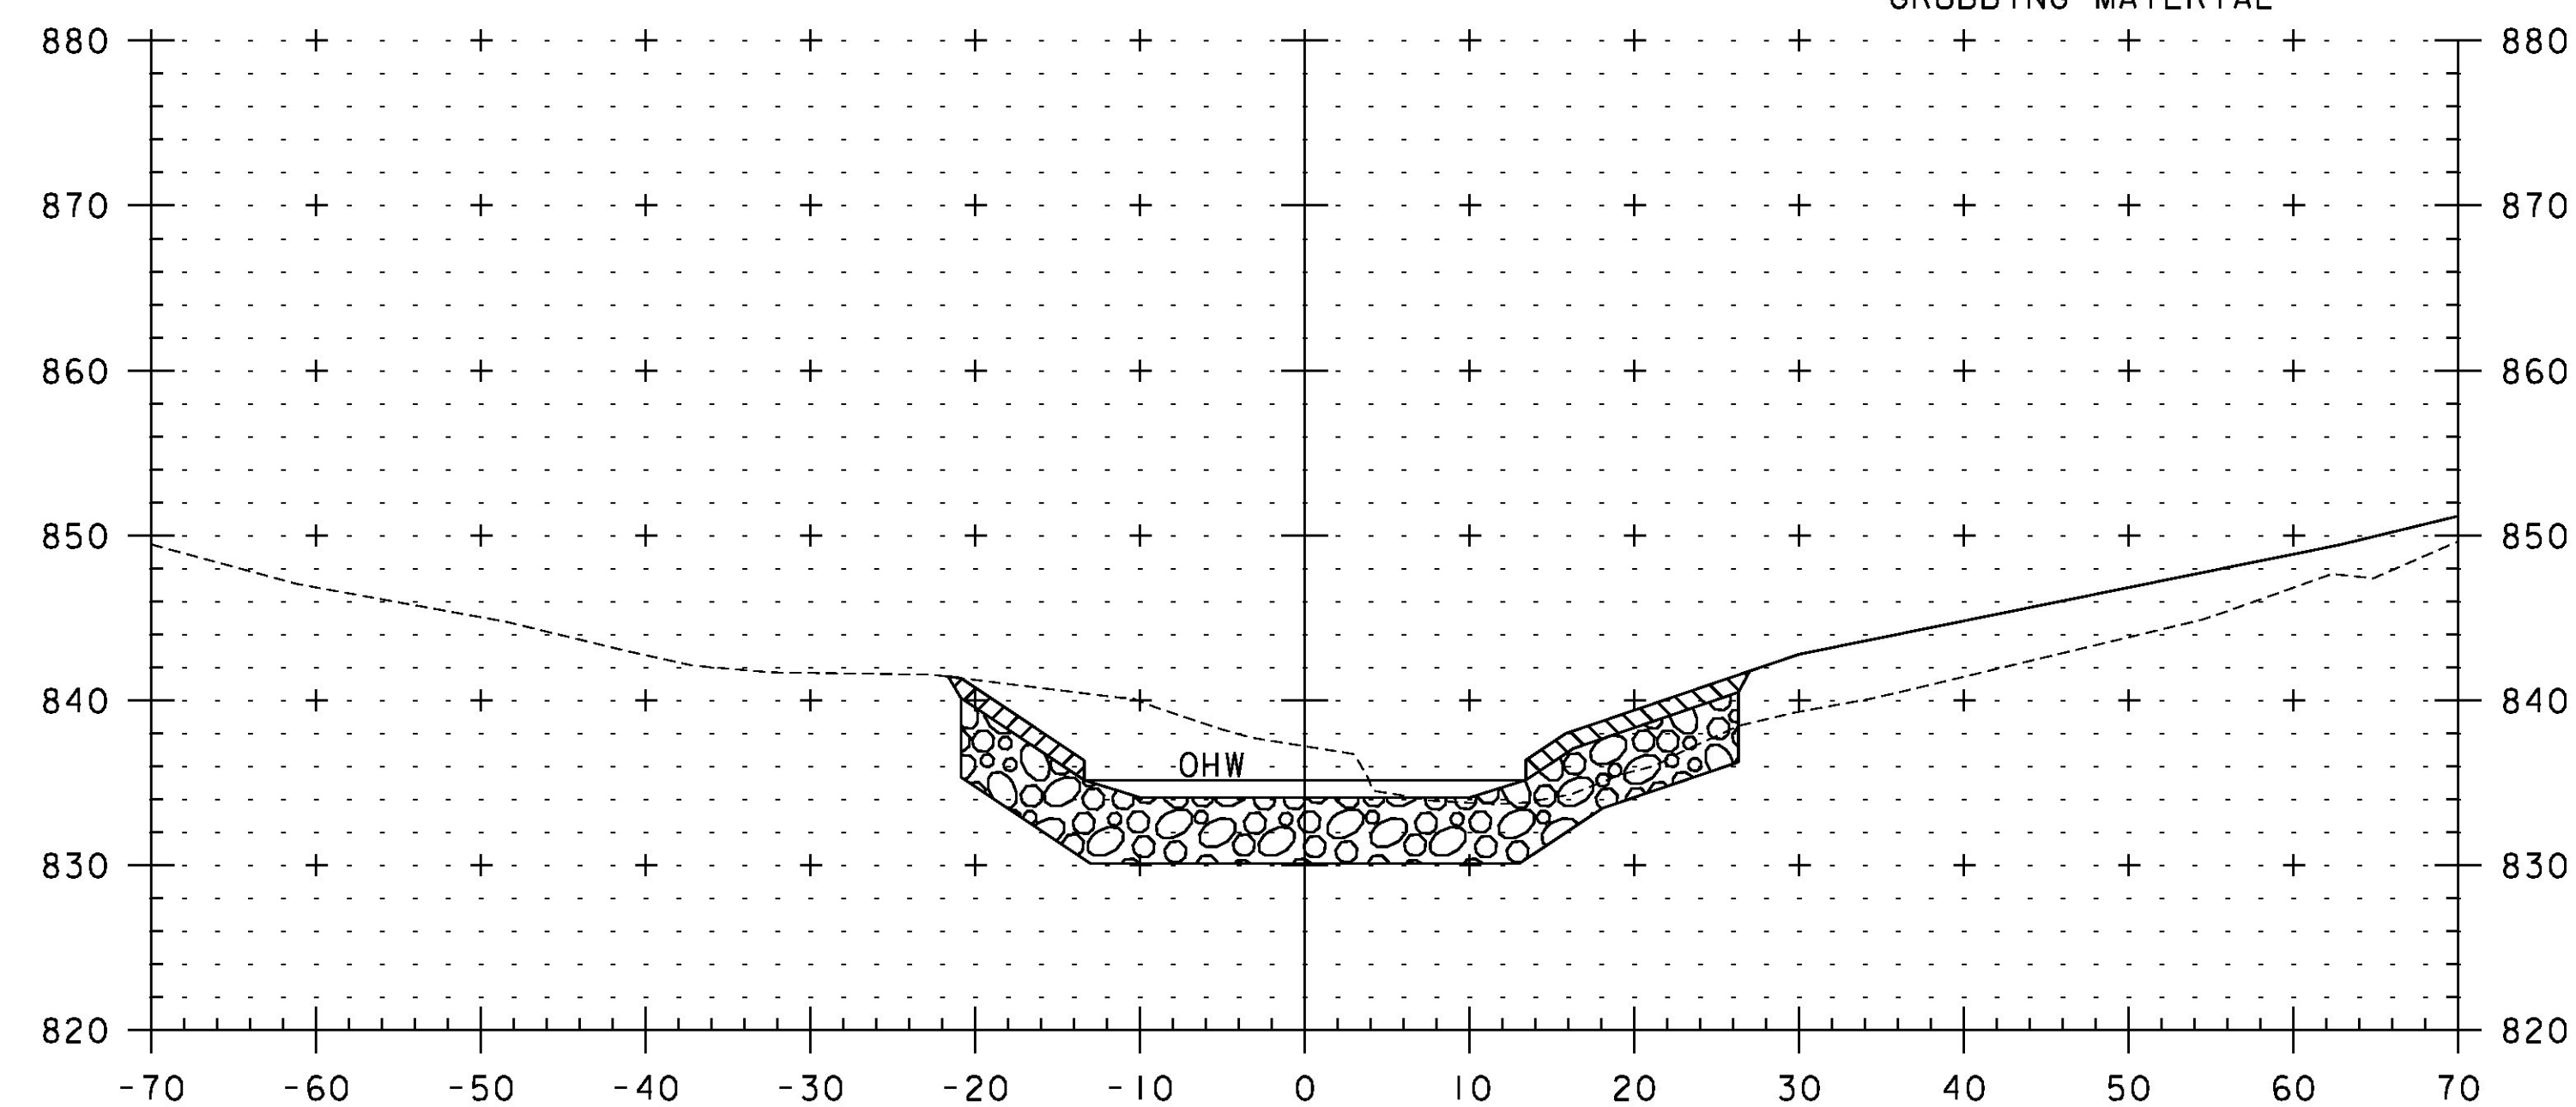

2+25

STA. 2+00 TO STA. 2+50

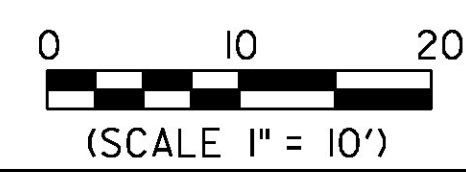

PROJECT NAME:	LUNENBURG	FILE NAME:	IIB294/cos/zlib294xsichan.dgn	PLOT DATE:	8/6/2015
PROJECT NUMBER:	NH CULV(27)	PROJECT LEADER:	J. BYATT	DRAWN BY:	M. SMITH
		DESIGNED BY:	S. BEAUMONT	CHECKED BY:	J. BYATT
		CHANNEL CROSS SECTIONS	3	SHEET	61 OF 74

CLD\_12-0106 MODEL: XS03