


SOIL INFORMATION: KINSMAN SAND  
K = 0.17, NOT HIGHLY ERODIBLE  
HYDROLOGIC SOIL GROUP: C

SOIL INFORMATION: KINSMAN SAND  
K = 0.17, NOT HIGHLY ERODIBLE  
HYDROLOGIC SOIL GROUP: C

MATCH LINE SEE PREVIOUS SHEET

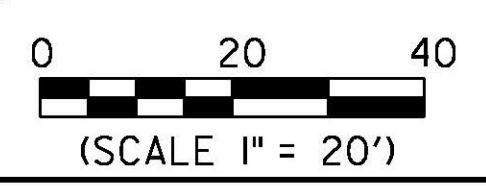

PROJECT NAME:	LUNENBURG	PLOT DATE:	8/6/2015
PROJECT NUMBER:	NH CULV(27)	DRAWN BY:	S. GOODWIN
FILE NAME:	11b294/cos/21b294bdreroex.dgn	DESIGNED BY:	M. HALEY
PROJECT LEADER:	J. BYATT	CHECKED BY:	P. SHEDD
EPSC EXISTING PLAN SHEET 2		SHEET	64 OF 74

CLD\_12-0106 MODEL: L02

