

MATCH LINE SEE PREVIOUS SHEET

STA 434+50.00
END PROJECT
BEGIN APPROACH

STA 434+75.00
END APPROACH

GEOTEXTILE FOR SILT FENCE
432+50 TO 434+50 RT

TEMPORARY EROSION MATTING
105+12 TO 106+00 LT


BARRIER FENCE
429+75 TO 429+90 LT
429+75 TO 430+20 RT
429+97 TO 431+26 LT

**GEOTEXTILE FOR SILT FENCE,
WOVEN WIRE REINFORCED**
105+20 TO 105+37 LT
105+39 TO 105+55 LT
105+62 TO 105+65 LT
105+75 TO 105+78 LT

**TEMPORARY STONE
CHECK DAM, TYPE I**
431+00 TO 432+00 LT
105+12 TO 106+00 RT

PROJECT DEMARCATION FENCE
430+20 TO 432+21 RT
431+26 TO 431+91 LT
432+09 TO 434+75 LT
432+50 TO 434+75 RT
433+75 TO 434+75 LT

CLD 12-0106 MODEL: L02

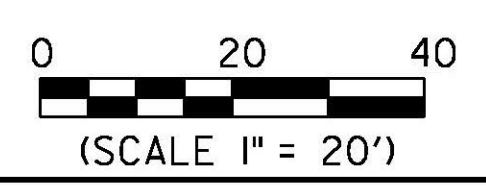

PROJECT NAME: LUNENBURG	
PROJECT NUMBER: NH CULV(27)	
FILE NAME: llb294/cos/2llb294bdrerocn.dgn	PLOT DATE: 8/6/2015
PROJECT LEADER: J. BYATT	DRAWN BY: S. GOODWIN
DESIGNED BY: M. HALEY	CHECKED BY: P. SHEDD
EPSC CONSTRUCTION PLAN SHEET 2	SHEET 66 OF 74