
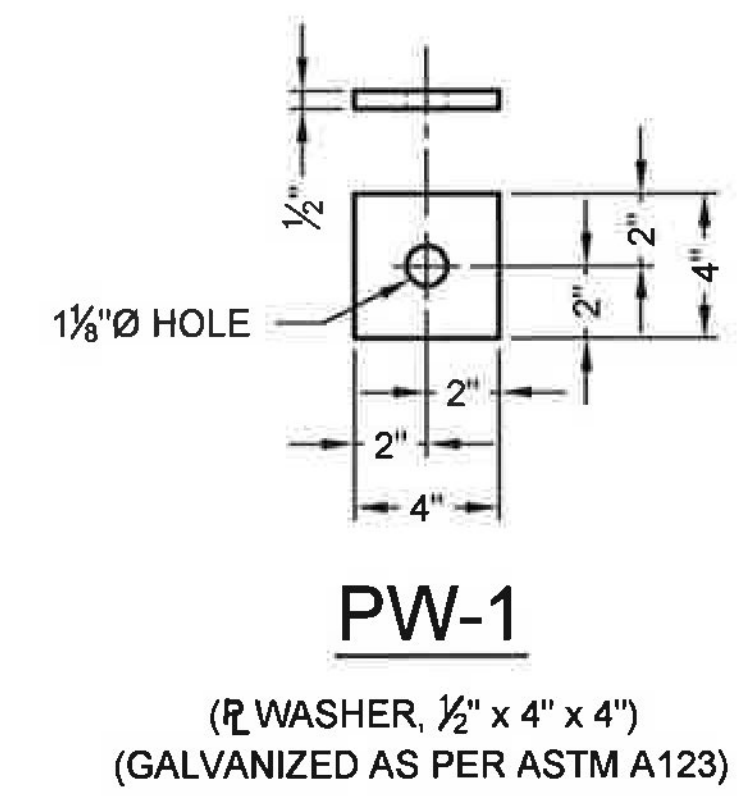
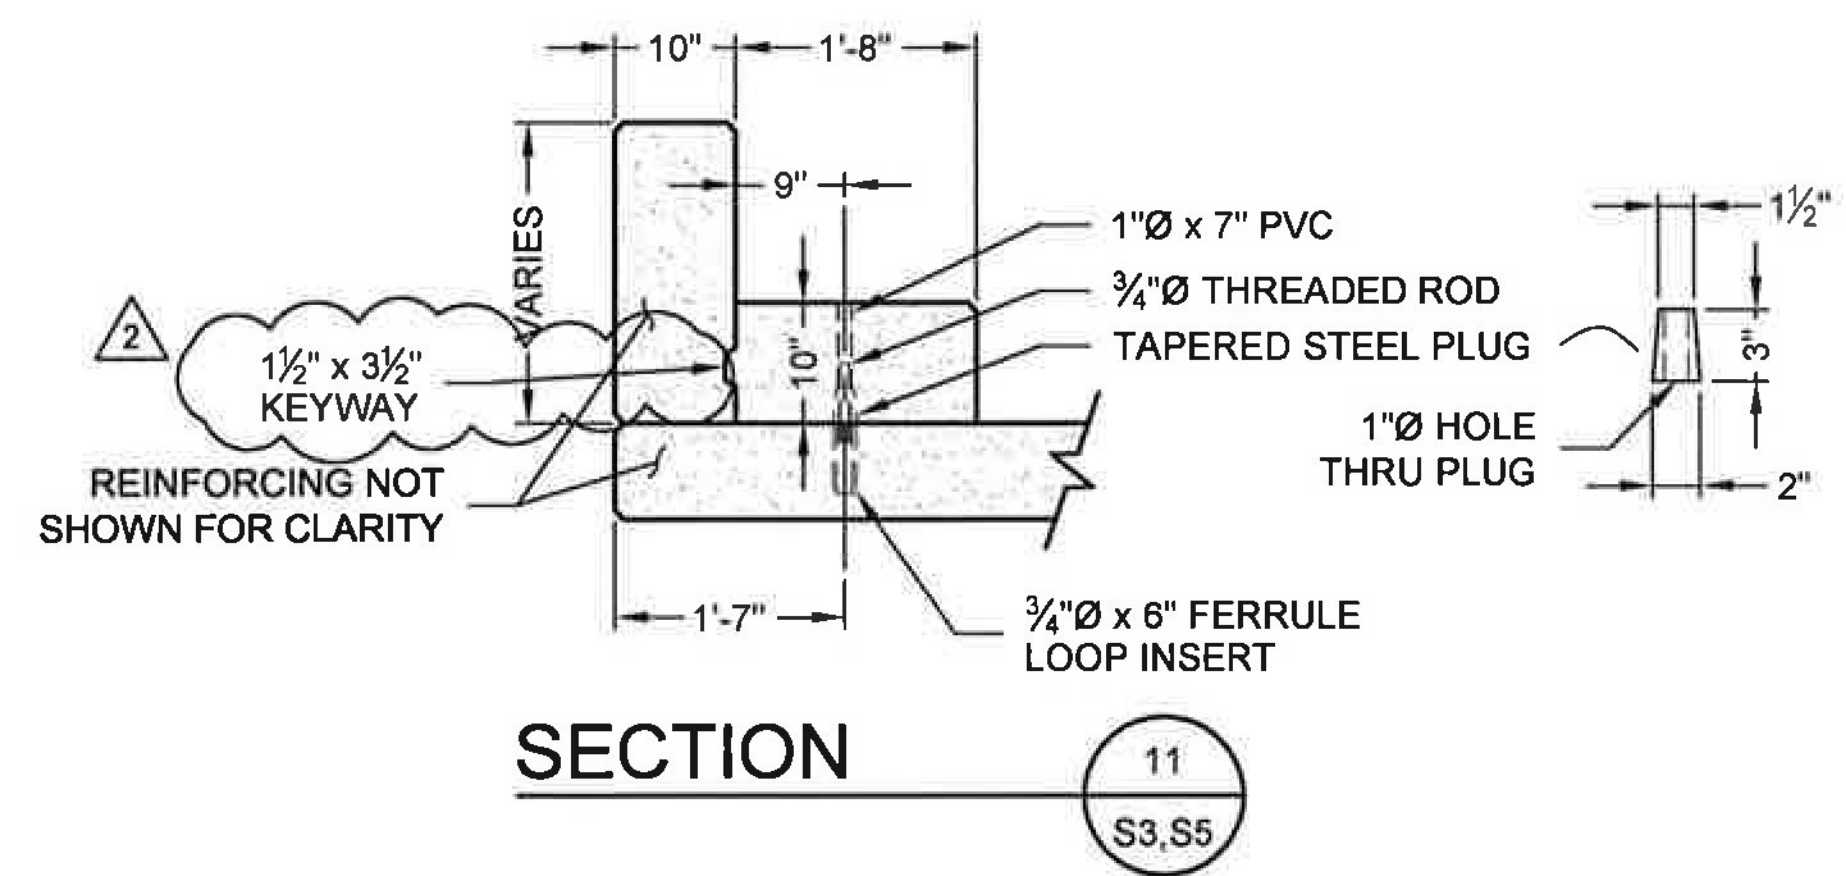
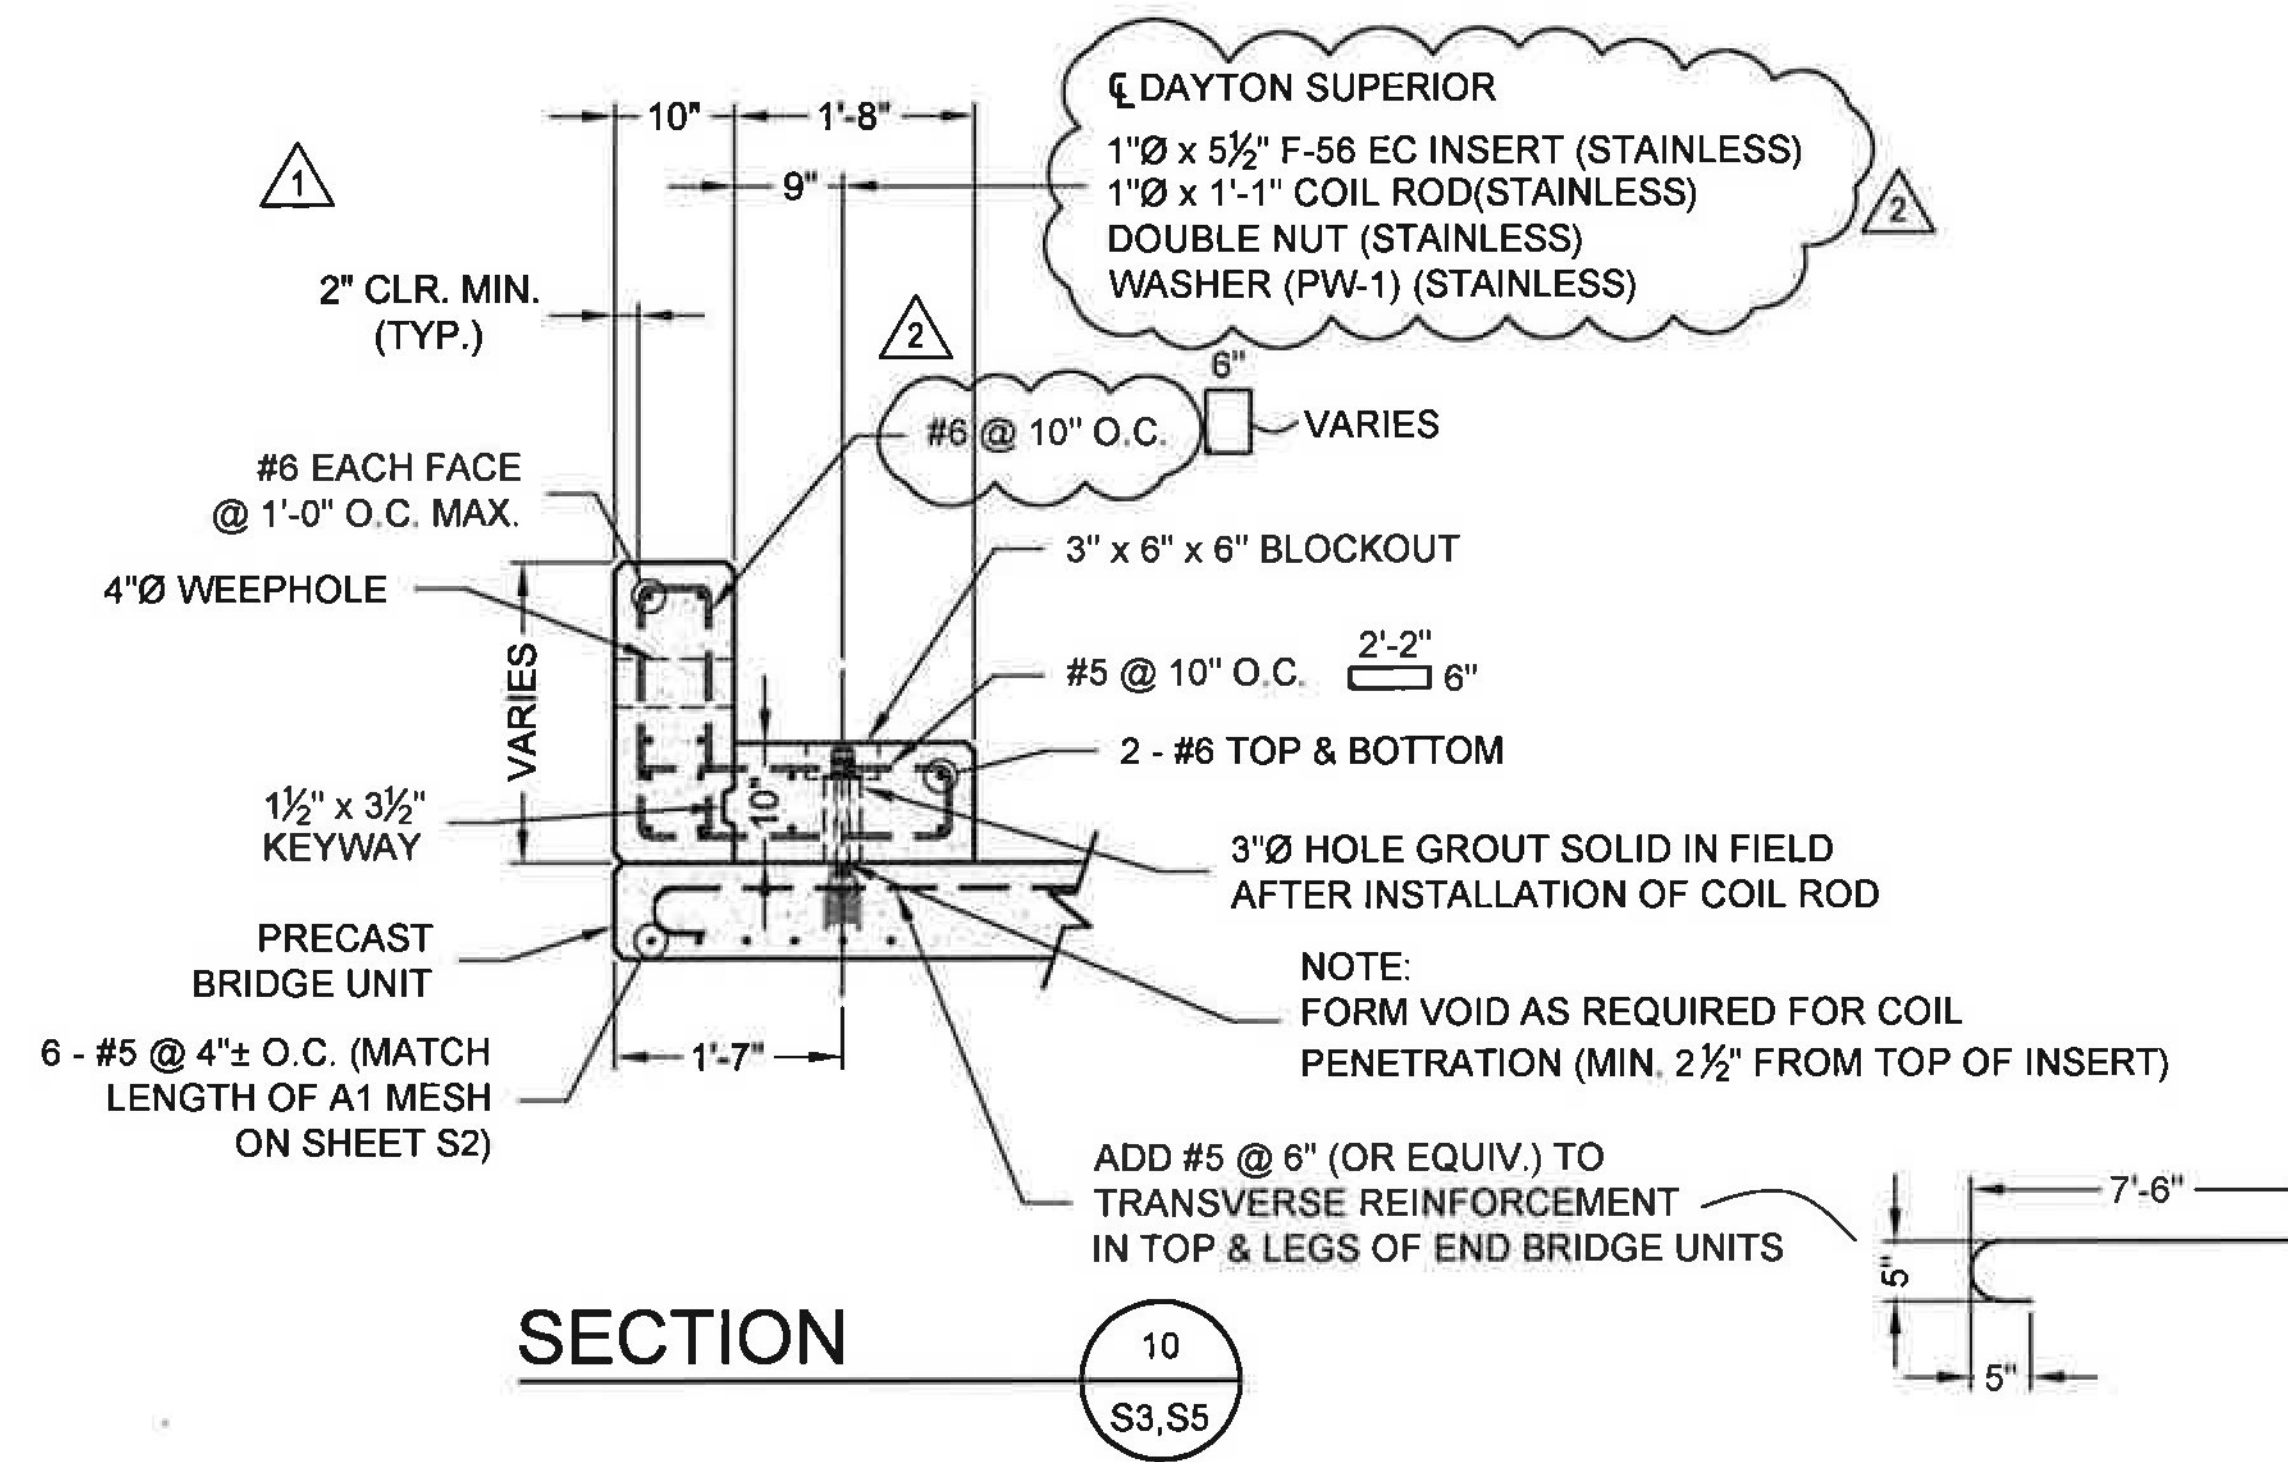


NOTES:
 - ALL EDGES OF PRECAST TO HAVE A 3/4" CHAMFER
 - HEADWALL TO BE CAST AGAINST BRIDGE UNIT
 - BRIDGE UNITS MUST BE GROUTED OR BRACED WHEN SETTING PRECAST HEADWALLS

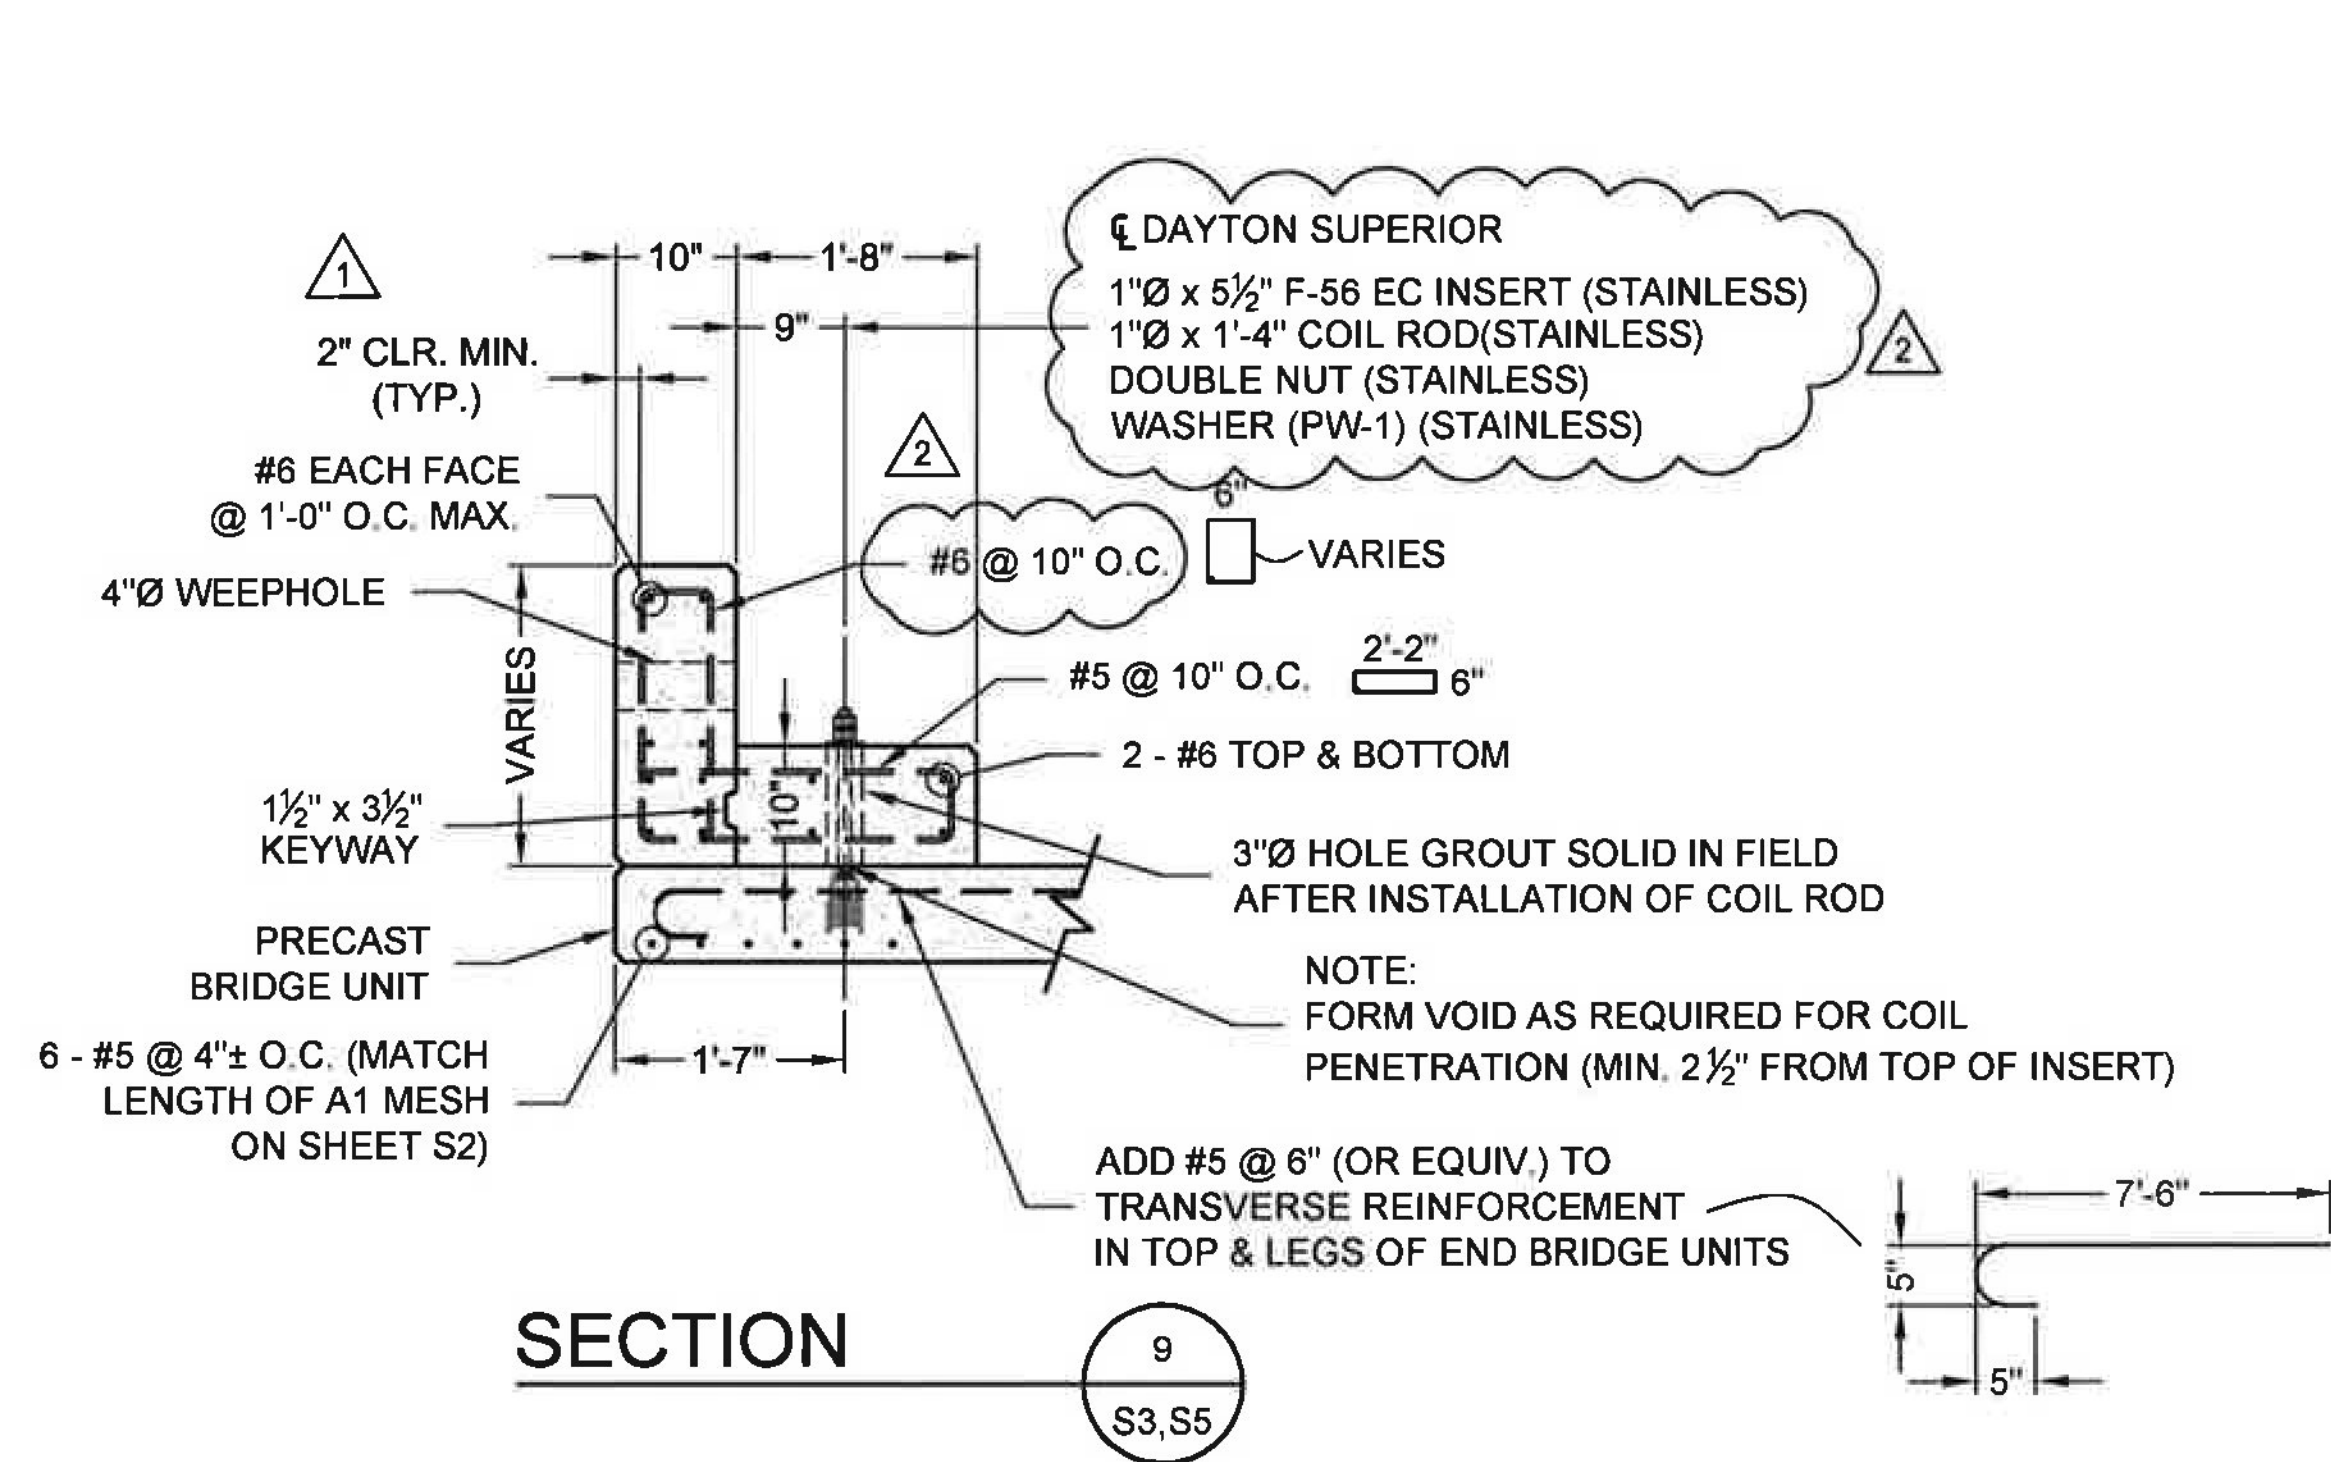

I:\MERLIN\PROJECTS\ACTIVE\468920\CONSPAN_0_SERIES\DRAWINGS\FABRICATION\PRE-468920\10-CC-FAB-D.DWG 4/14/2016 11:20 AM

The design and information shown on this drawing is provided as a service to the project owner, engineer and contractor by Contech Engineered Solutions LLC ("Contech"). Neither this drawing, nor any part thereof, may be used, reproduced or modified in any manner without the prior written consent of Contech. Failure to comply is done at the user's own risk and Contech expressly disclaims any liability or responsibility for such use.

If discrepancies between the supplied information upon which the drawing is based and actual field conditions are encountered as site work progresses, these discrepancies must be reported to Contech immediately for re-evaluation of the design. Contech accepts no liability for designs based on missing, incomplete or inaccurate information supplied by others.

MARK	DATE	REVISION DESCRIPTION	BY
2	4/14/2016	REVIEW COMMENTS	JDR
1	3/16/2016	REVISIONS PER REVIEW COMMENTS	KDK

CONTECH
 ENGINEERED SOLUTIONS LLC
 www.ContechES.com
 9025 Centre Pointe Dr., Suite 400, West Chester, OH 45069
 800-338-1122 513-645-7000 513-645-7993 FAX

CONSPAN
 SERIES
 FABRICATION
 DRAWING

US ROUTE 2
 BRIDGE NO. 126
 TOWN OF LUNENBURG
 ESSEX COUNTY, VERMONT

PROJECT No:	SEQ. No:	DATE:
468920	010	12/8/2015
DESIGNED:	DRAWN:	
KDK	TRL	
CHECKED:	APPROVED:	
JDR	PAC	
SHEET NO:		
S7 OF S22		