

INDEX OF SHEETS

- 1 TITLE SHEET
- 2 PRELIMINARY INFORMATION SHEET
- 3 RIGHT OF WAY SHEET
- 4 TIE SHEET & ESTIMATED QUANTITIES
- 5 PROJECT NOTES
- 6 LAYOUT SHEET
- 7 PROFILE SHEET
- 8 BORING INFORMATION SHEET
- 9-10 BORING LOGS
- 11 PLAN SHEET
- 12 FOOTING & RIGID FRAME DETAILS
- 13 REINFORCING STEEL SCHEDULE
- 14-15 PHASING PLAN SHEETS
- 16 PHASING TYPICAL SECTIONS
- 17-19 ROADWAY CROSS SECTIONS

STRUCTURES DETAILS

- SD-501.00
- SD-502.00

INDEX OF STANDARDS

B-5	06/01/1994
C-10	02/11/2008
E-100	01/02/2004
E-100A	01/02/2004
E-101	05/30/2003
E-102	06/30/2003
E-102A	05/01/2004
E-106	03/01/2004
E-107	06/30/2003
E-107A	06/08/2009
E-108	06/08/2009
E-193	08/18/1995
G-1	01/03/2000
G-1D	01/03/2000
S-360A	12/14/2009
S-360B	12/14/2009
S-363	12/14/2009

RECORD PLANS

CONTRACTOR:	S. D. IRELAND CONC. CONST. CORP - BURLINGTON, VT
RESIDENT ENGINEER:	VICTOR DWIRE
CONSTRUCTION BEGAN:	JANUARY 9, 2012
CONSTRUCTION COMPLETE:	JULY 2, 2012
RECORD PLANS BY:	VICTOR DWIRE

I HEREBY CERTIFY THAT ALL THE CONSTRUCTION REQUIRED BY THIS SET OF DRAWINGS HAS BEEN ACCOMPLISHED AS INDICATED HEREIN.

BY Vic Dwire RESIDENT ENGINEER
DATE 01-22-2014

NOTE: Any further information concerning final quantities, amounts or other details relative to this project may be found at Central Files in the electronic archives.

STATE OF VERMONT AGENCY OF TRANSPORTATION





PROPOSED IMPROVEMENT BRIDGE PROJECT

TOWNS OF WARREN & GRANVILLE
COUNTIES OF WASHINGTON & ADDISON

ROUTE NO : VT100 BRIDGE NO : 165

PROJECT LOCATION: LOCATED IN THE COUNTY OF WASHINGTON, BRIDGE NO. 165 ON VT ROUTE 100, APPROXIMATELY 50 FEET NORTH OF THE WARREN AND GRANVILLE TOWN LINE.

PROJECT DESCRIPTION: THE REPLACEMENT OF THE EXISTING STRUCTURE ALONG WITH RELATED CHANNEL AND ROADWAY WORK.

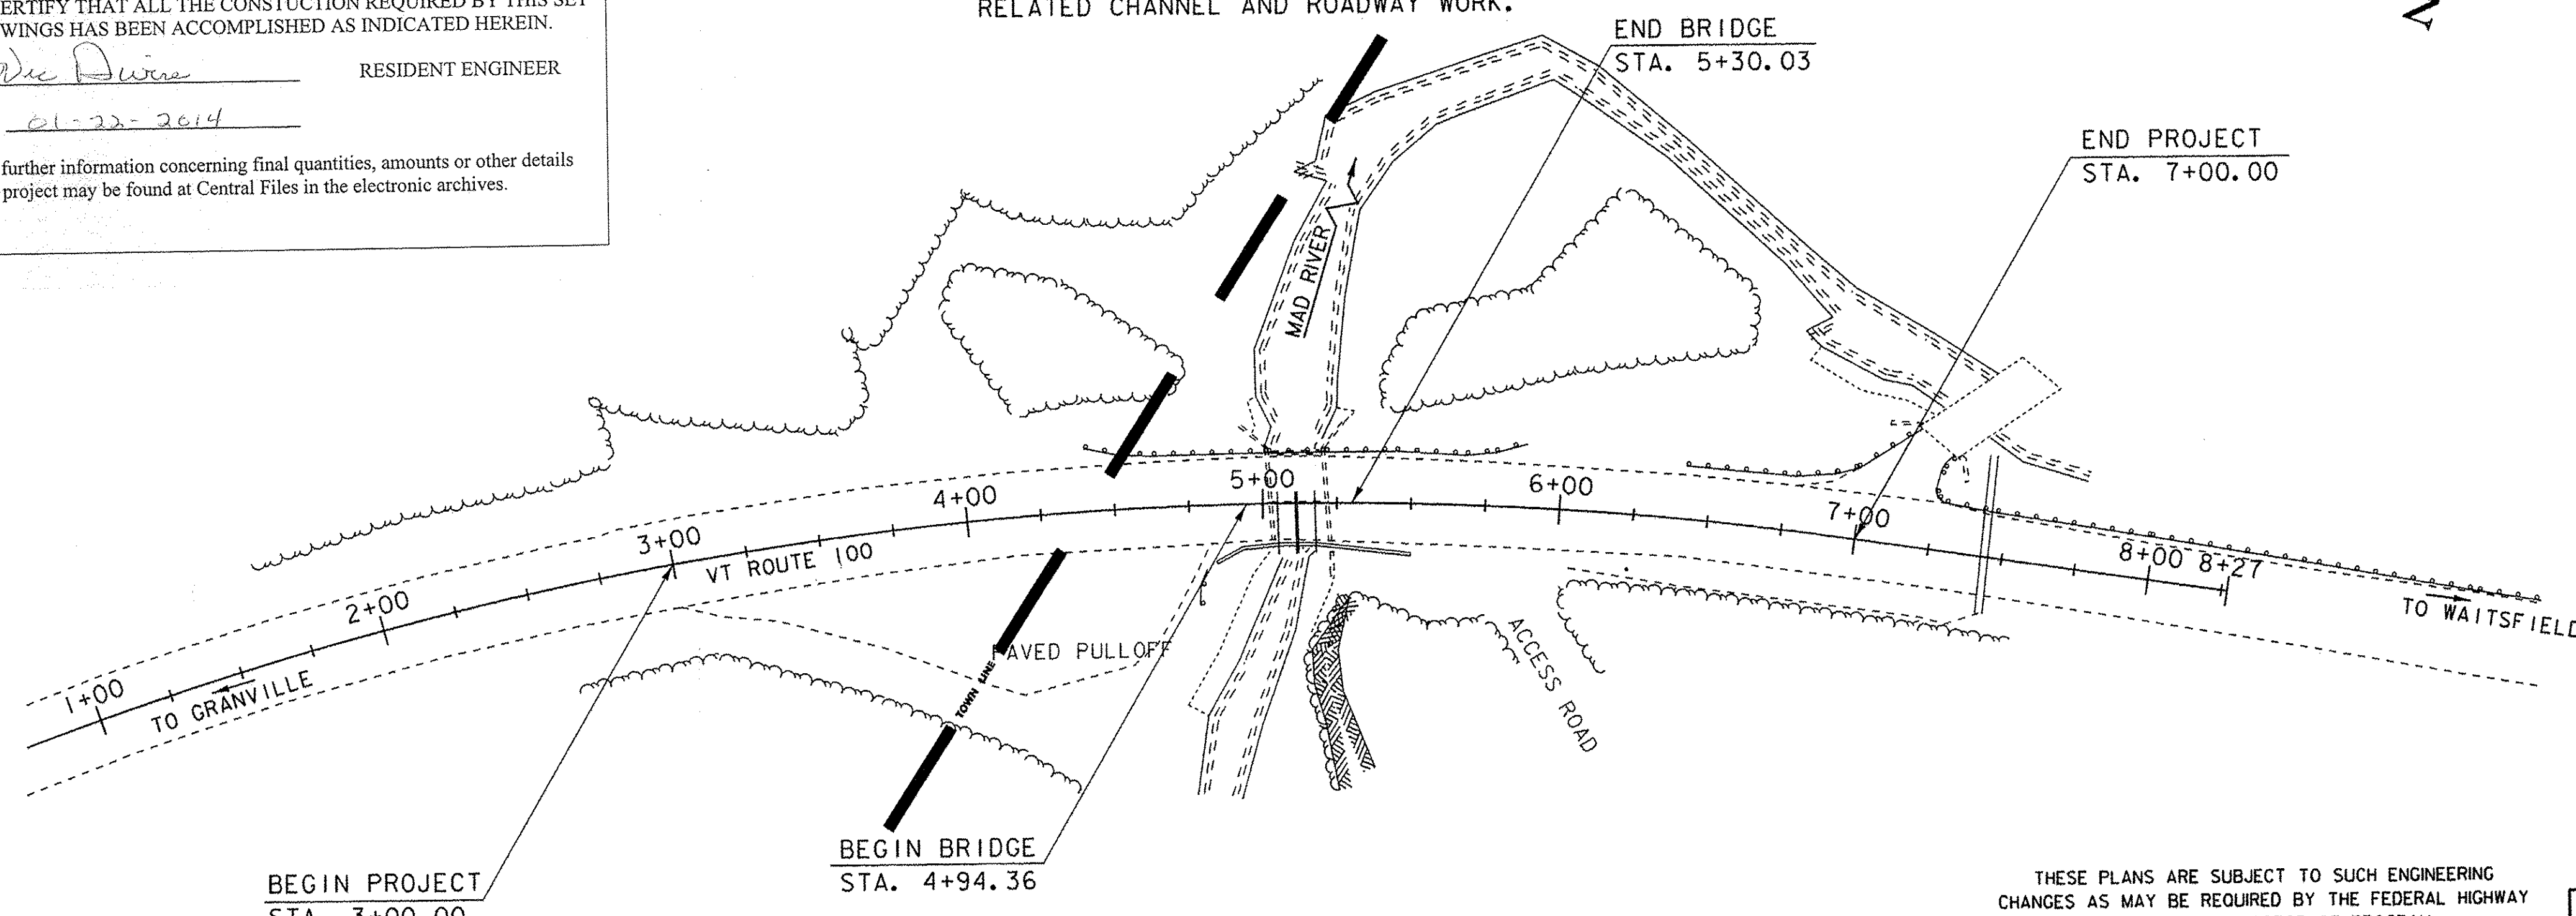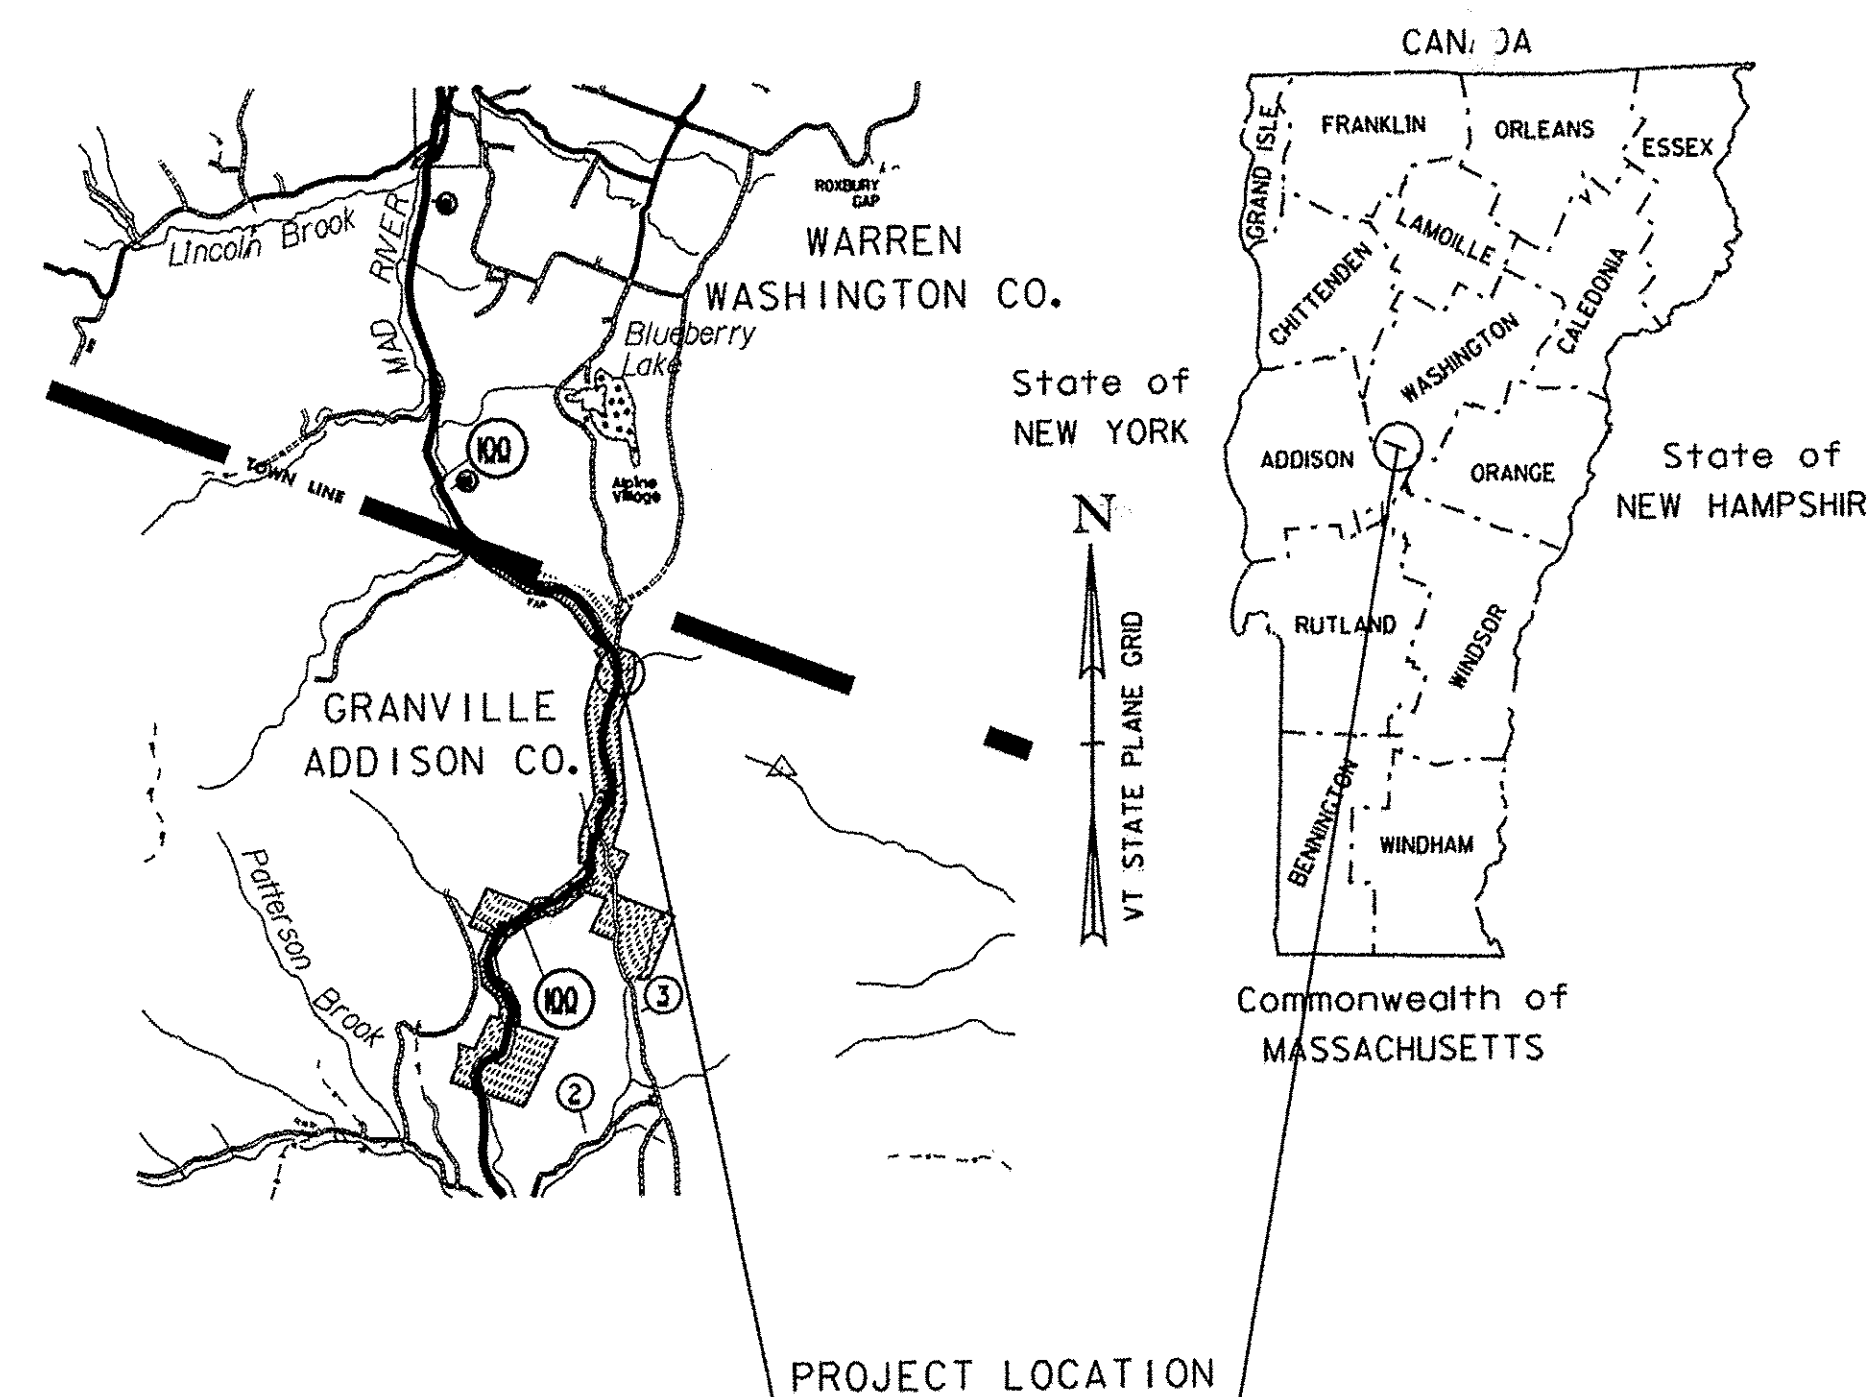

QUALITY ASSURANCE PROGRAM: LEVEL 1

CONVENTIONAL SYMBOLS

COUNTY LINE	— — — — —
TOWN LINE	— — — — —
LIMITS OF ACCESS	— — — — —
POINT OF ACCESS	X
FENCE LINE	X — — — — X
STONE WALL	○ — — — — ○
TRAVELED WAY	— — — — —
GUARD RAIL	— — — — —
RAILROAD	— — — — —
SURVEY LINE	— — — — —
CULVERT	— — — — —
POWER POLE	⊕
TELEPHONE POLE	⊕
TREES	⊕
CONTROL OF ACCESS	— — — — —
PROPERTY LINE	— — — — —
R.O.W. TAKING LINE	— — — — —
SLOPE RIGHTS	— — — — —
TOP OF CUT	— — — — —
TOE OF SLOPE	— — — — —

SURVEYED BY : R. BELL
SURVEYED DATE : 9/2011

DATUM
VERTICAL ASSUMED
HORIZONTAL ASSUMED

THESE PLANS ARE SUBJECT TO SUCH ENGINEERING CHANGES AS MAY BE REQUIRED BY THE FEDERAL HIGHWAY ADMINISTRATION OR THE DIRECTOR OF PROGRAM DEVELOPMENT.

CONSTRUCTION IS TO BE CARRIED ON IN ACCORDANCE WITH THESE PLANS AND THE STANDARD SPECIFICATIONS FOR CONSTRUCTION DATED 2006, AS APPROVED BY THE FEDERAL HIGHWAY ADMINISTRATION ON JUNE 15, 2006 FOR USE ON THIS PROJECT, INCLUDING ALL SUBSEQUENT REVISIONS AND SUCH REVISED SPECIFICATIONS AND SPECIAL PROVISIONS AS ARE INCORPORATED IN THESE PLANS.

DIRECTOR OF PROGRAM DEVELOPMENT	
APPROVED <u>[Signature]</u>	DATE <u>10-21-11</u>
PROJECT MANAGER : TIM FILLBACH	
PROJECT NAME : WARREN	
PROJECT NUMBER : ER-STP 013-4 (36)	
SHEET 1 OF 19 SHEETS	