



NOTE: GRADES SHOWN TO THE NEAREST TENTH REPRESENT EXISTING GROUND ELEVATION ALONG THE CENTERLINE.  
 GRADES SHOWN TO THE NEAREST HUNDREDETH REPRESENT FINISH GRADE ELEVATION ALONG THE CENTERLINE.

**PROFILE VT ROUTE 100**

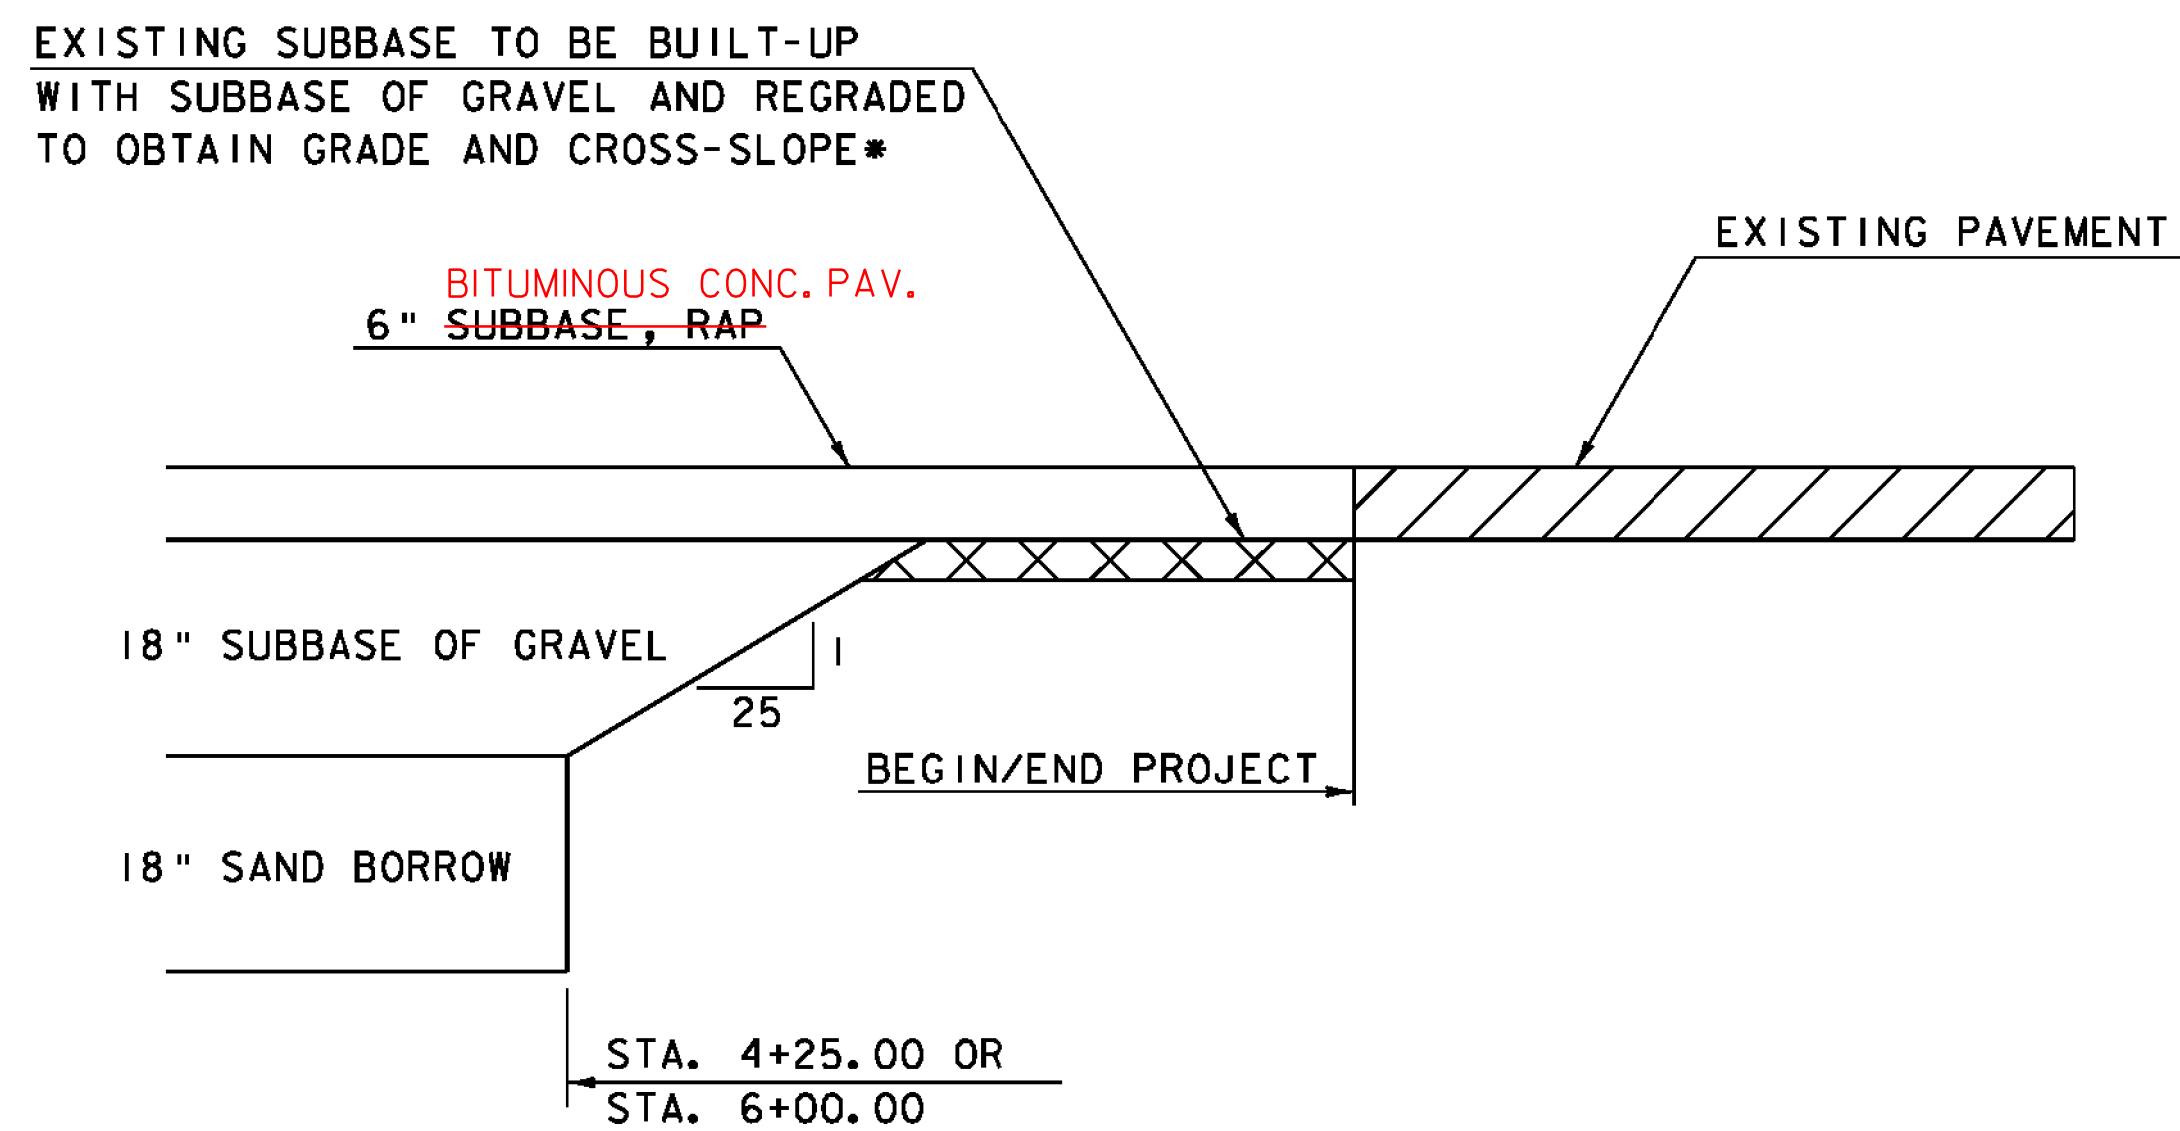

**APPROACH TRANSITION DETAIL**

NOT TO SCALE

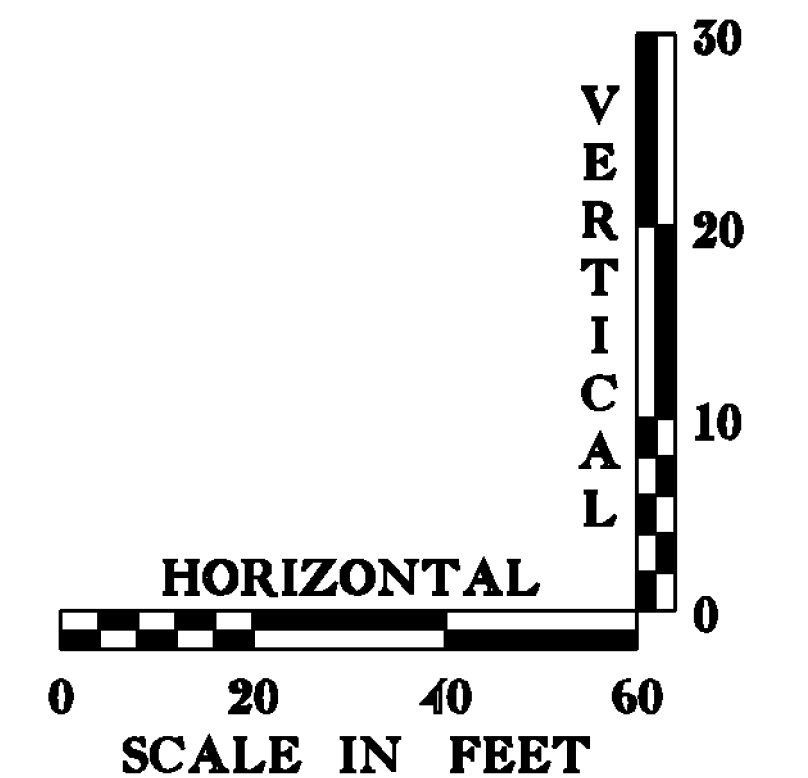

\*REGRADED OF SUBBASE CONSIDERED INCIDENTAL TO ITEM 301.15, "SUBBASE OF GRAVEL".

DATUM  
 VERTICAL ASSUMED  
 HORIZONTAL ASSUMED



**PROFILE SHEET**

PROJECT NAME: WARREN  
 PROJECT NUMBER: ER-STP 013-4 (36)  
 FILE NAME:  
 PROJECT LEADER: JWT  
 DESIGNED BY: RHB  
 PLOT FILE:  
 PLOT DATE: 11/4/2011  
 DRAWN BY: BMB  
 CHECKED BY: EPD  
 SHEET 7 OF 19