




3+50

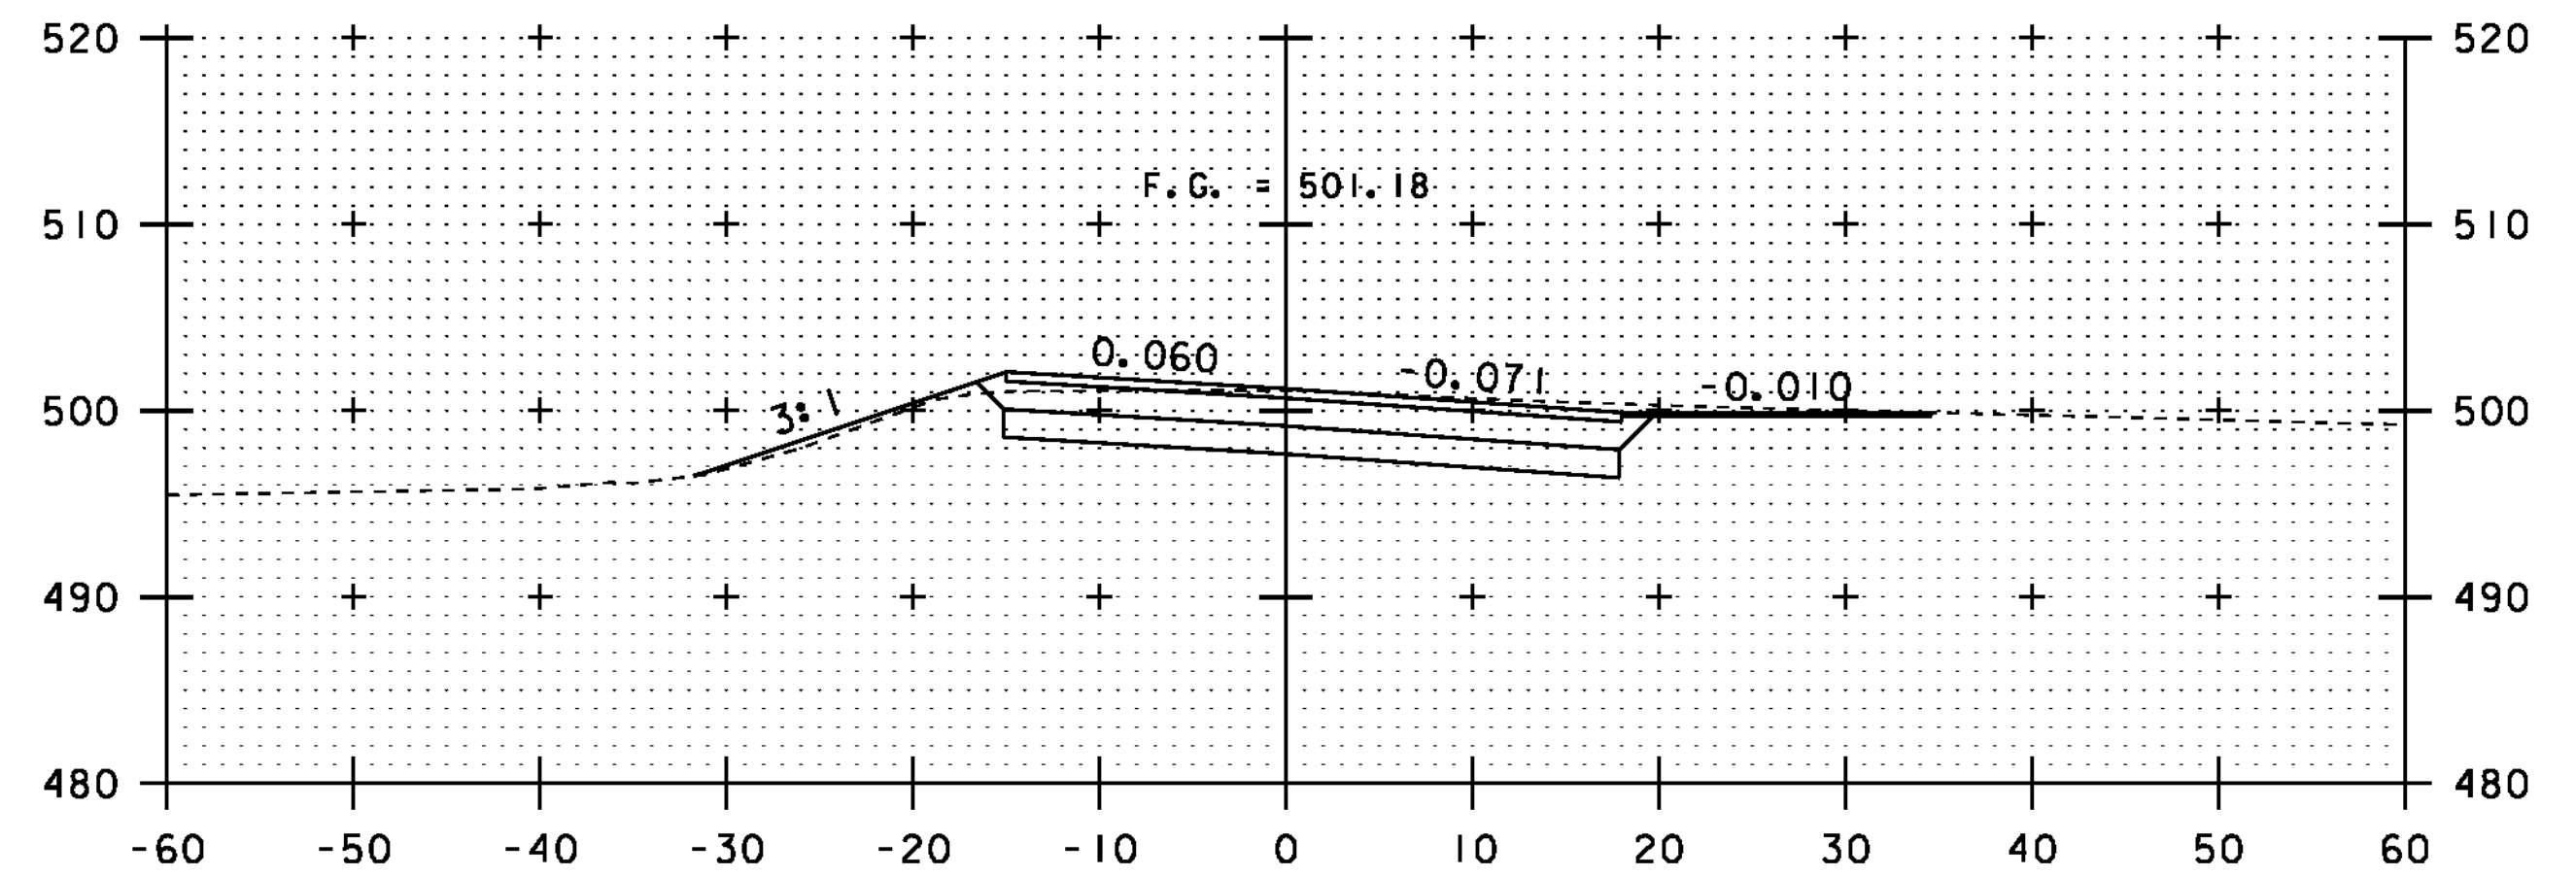


4+25

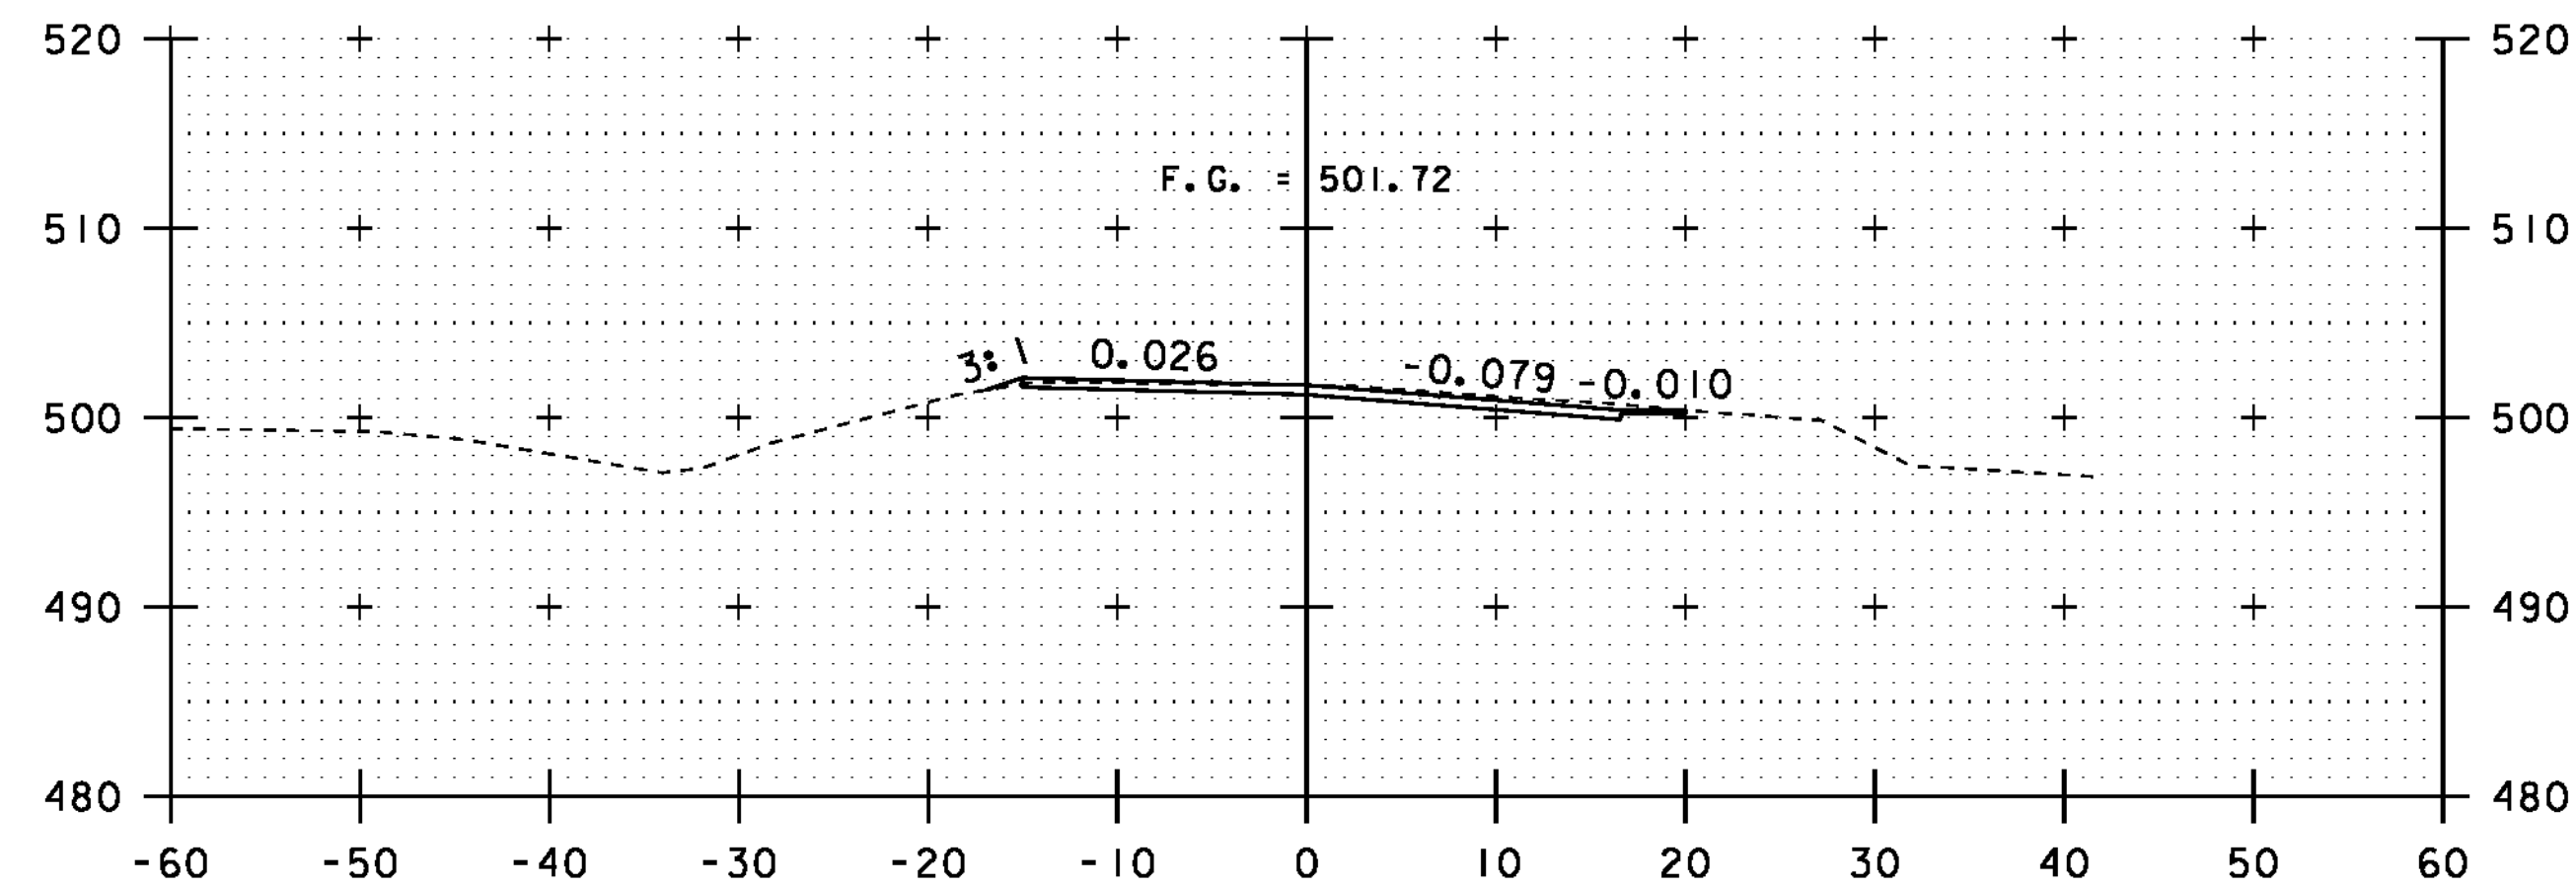

3+25

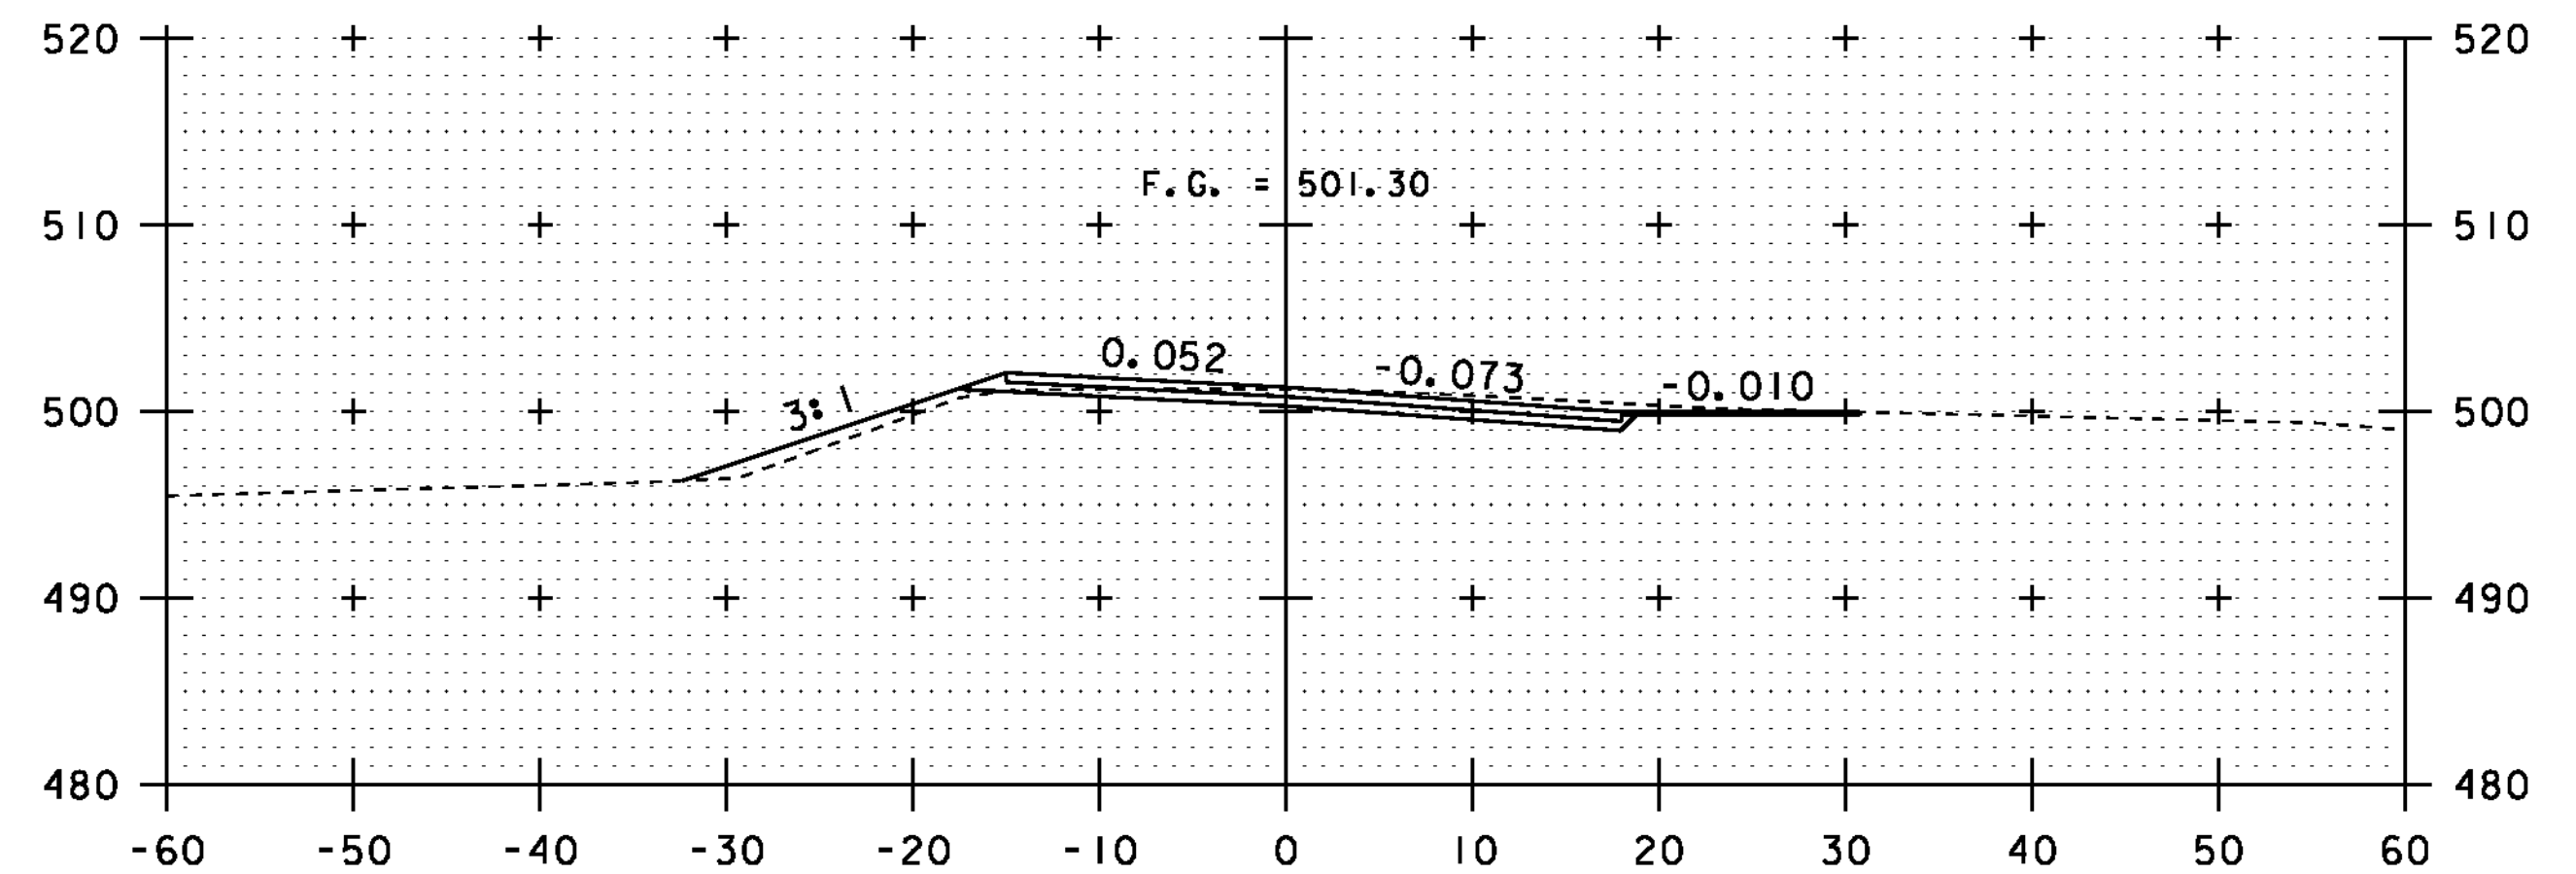


4+00

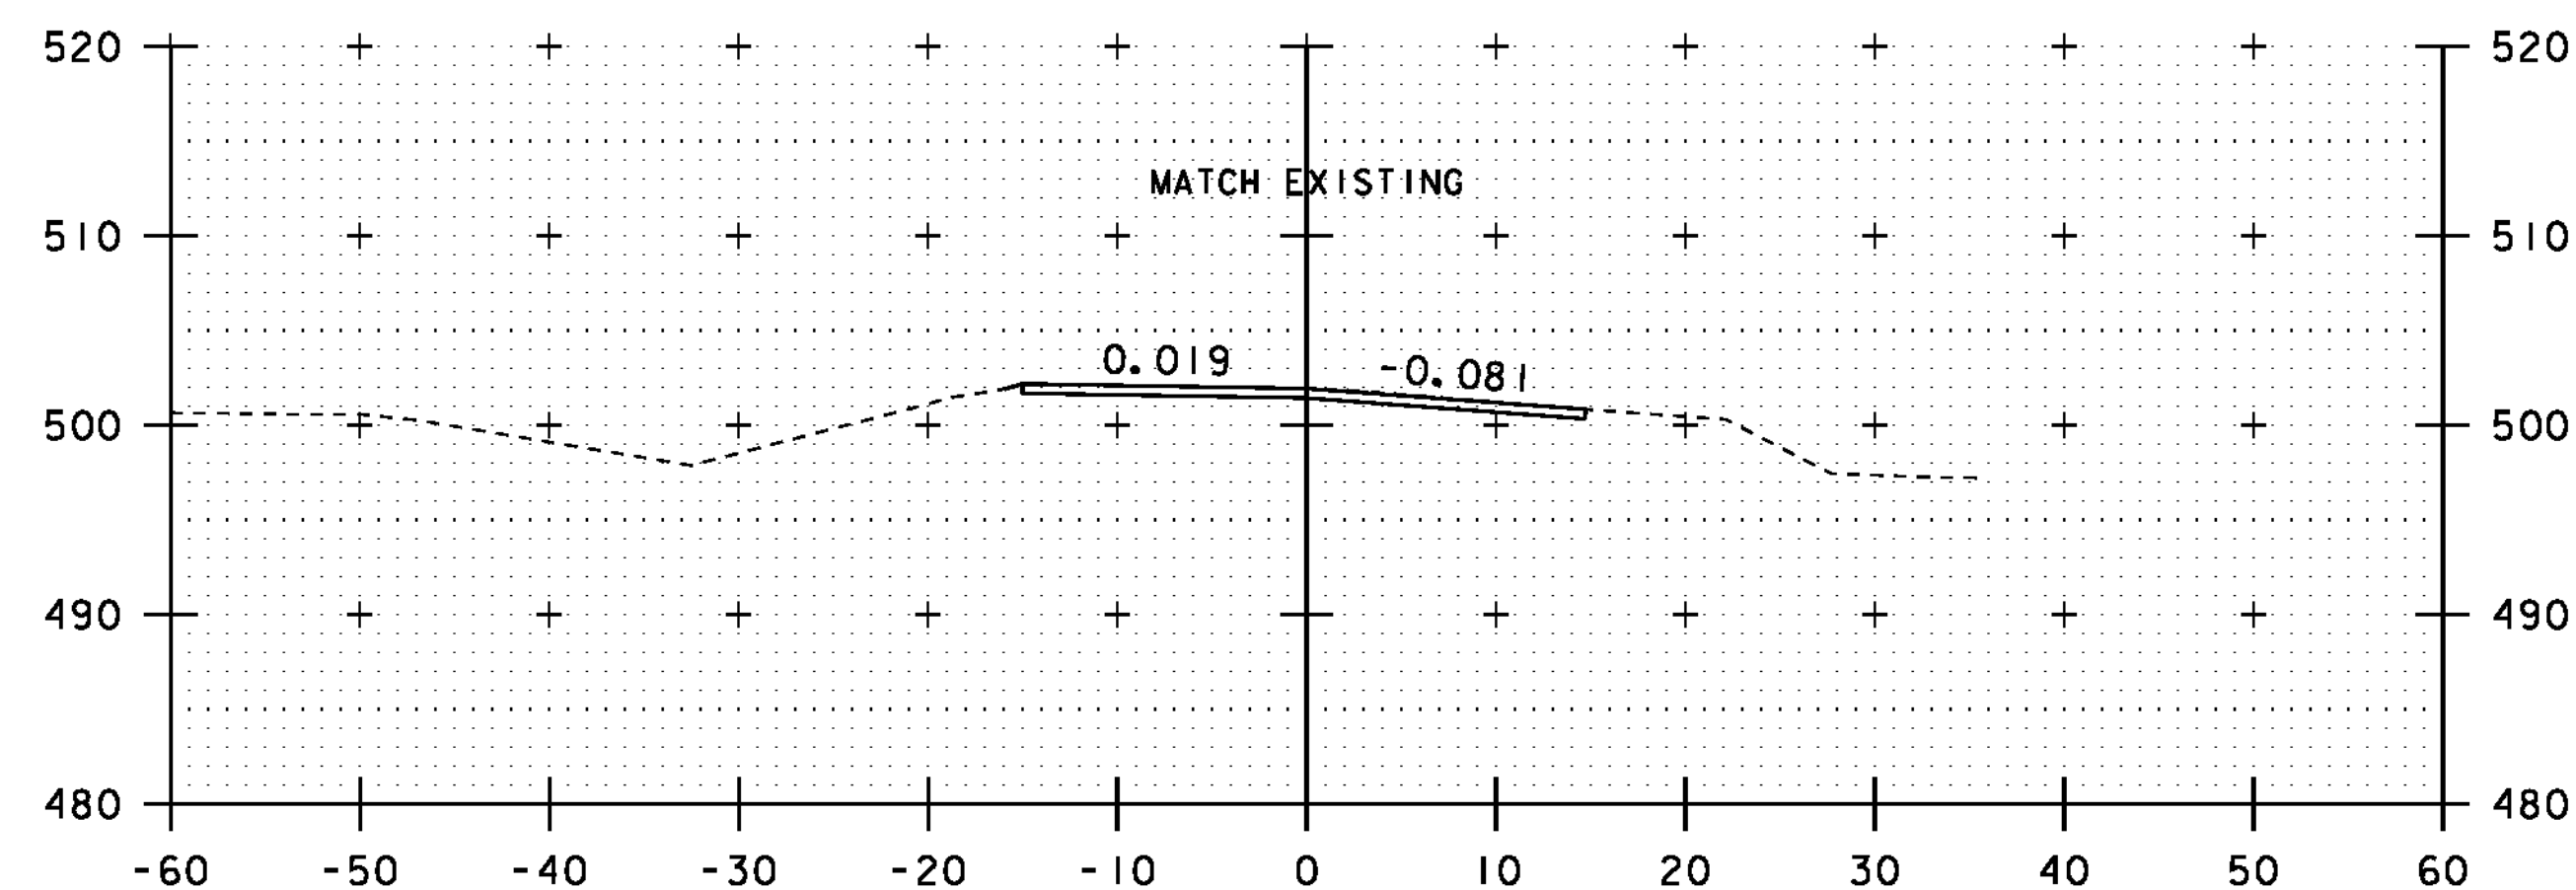

3+00

BEGIN PROJECT
STA. 3+00.00

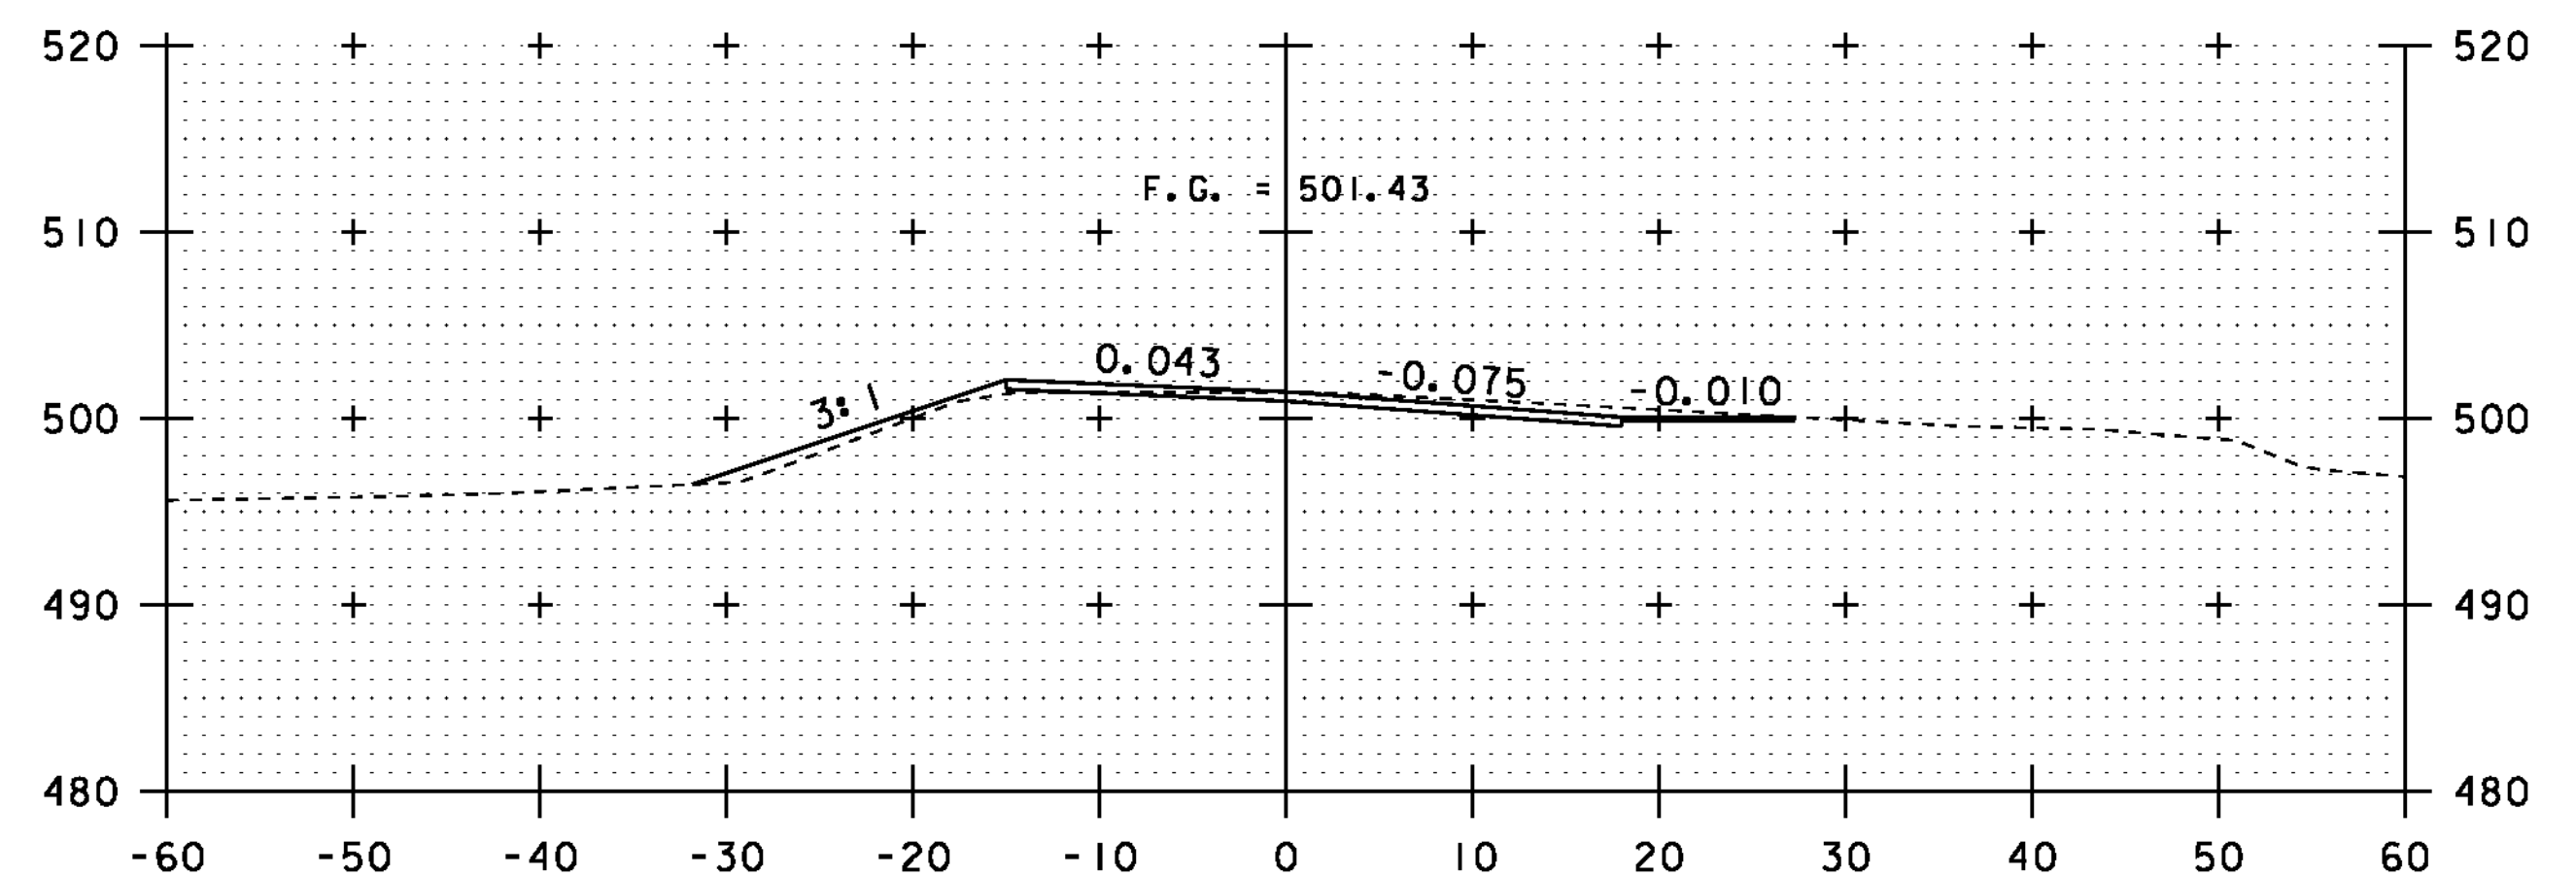

3+75

DATUM
VERTICAL ASSUMED
HORIZONTAL ASSUMED



**ROADWAY
CROSS SECTIONS**

PROJECT NAME: WARREN
PROJECT NUMBER: ER-STP 013-4 (36)

FILE NAME:
PROJECT LEADER: JWT
DESIGNED BY: RHB
PLOT FILE:
PLOT DATE: 11/4/2011
DRAWN BY: BMB
CHECKED BY: EPD
SHEET 17 OF 19