




6+50

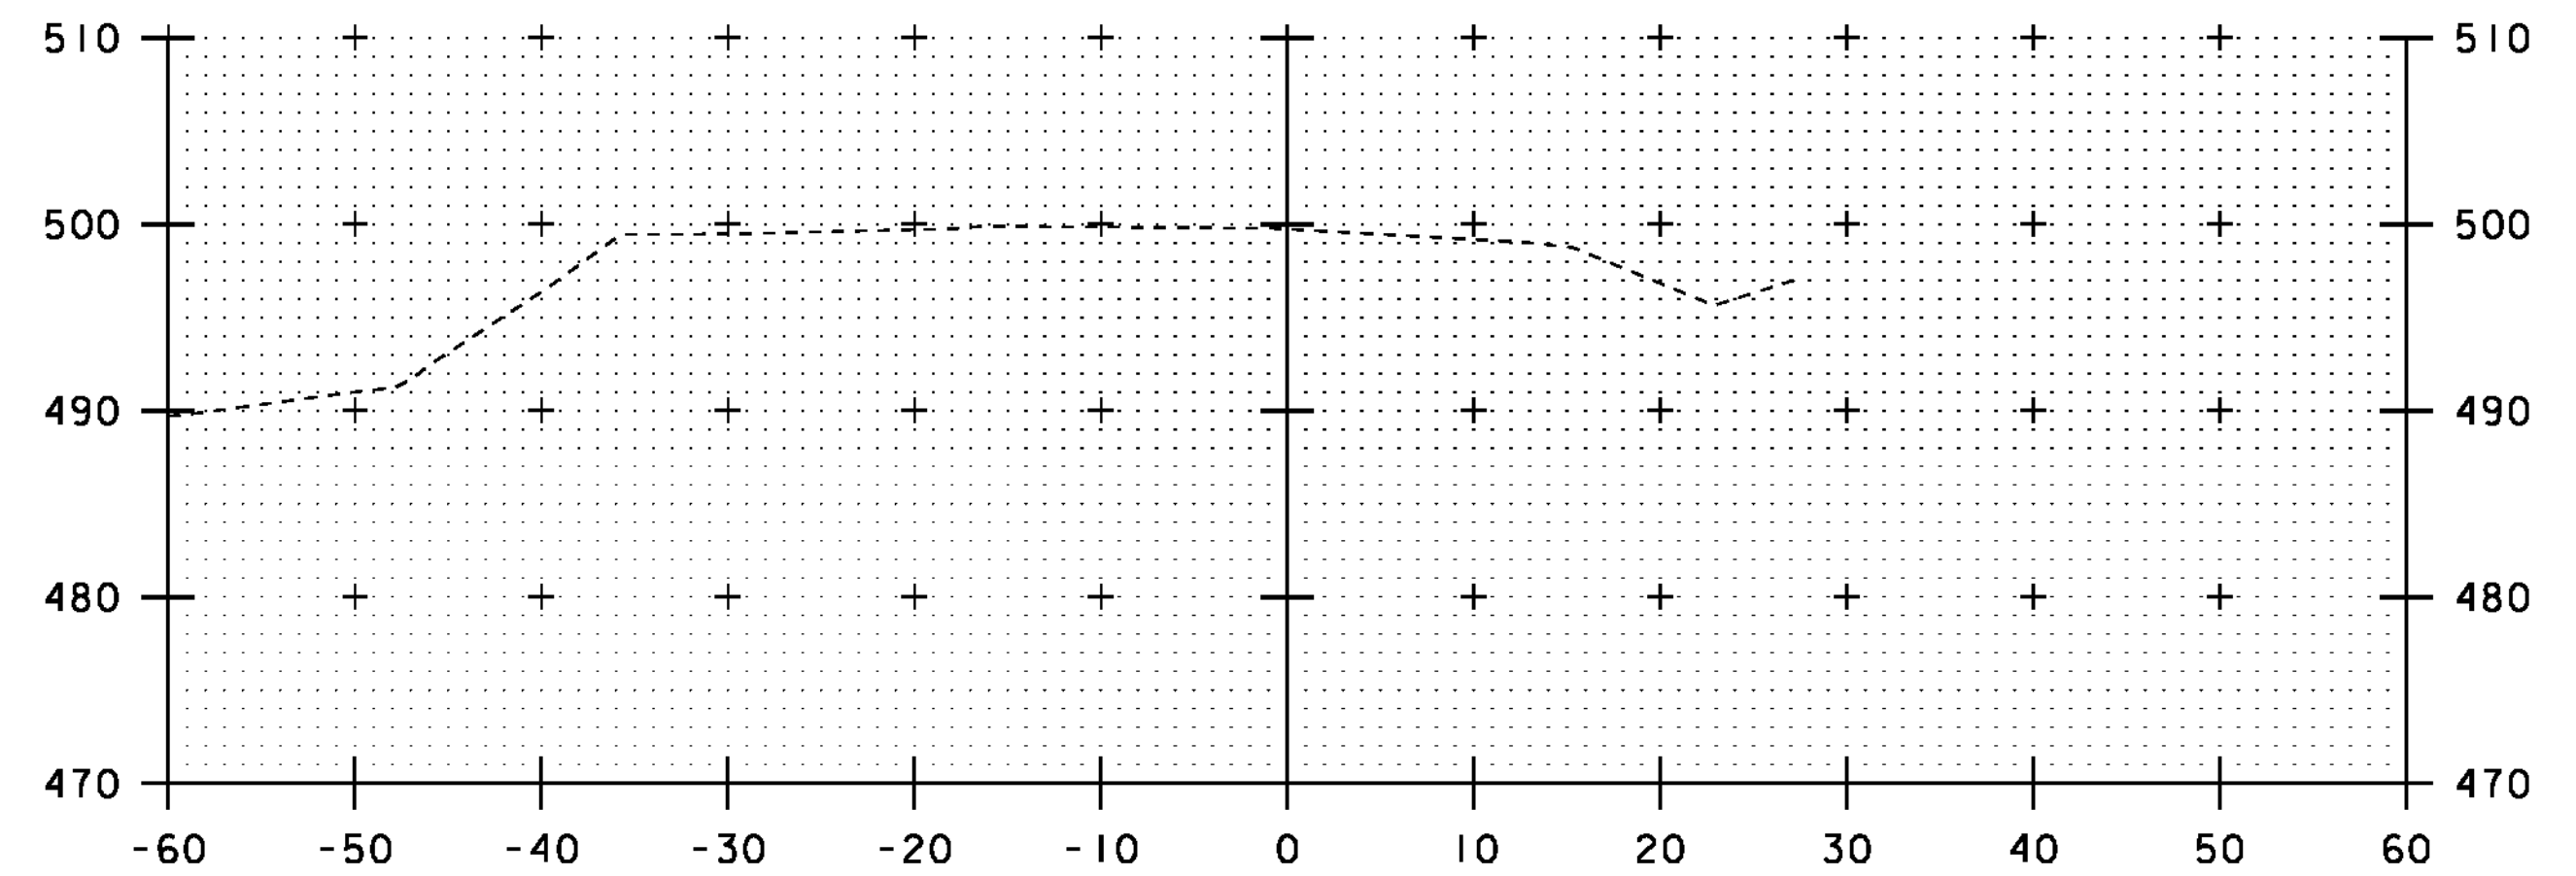

7+25

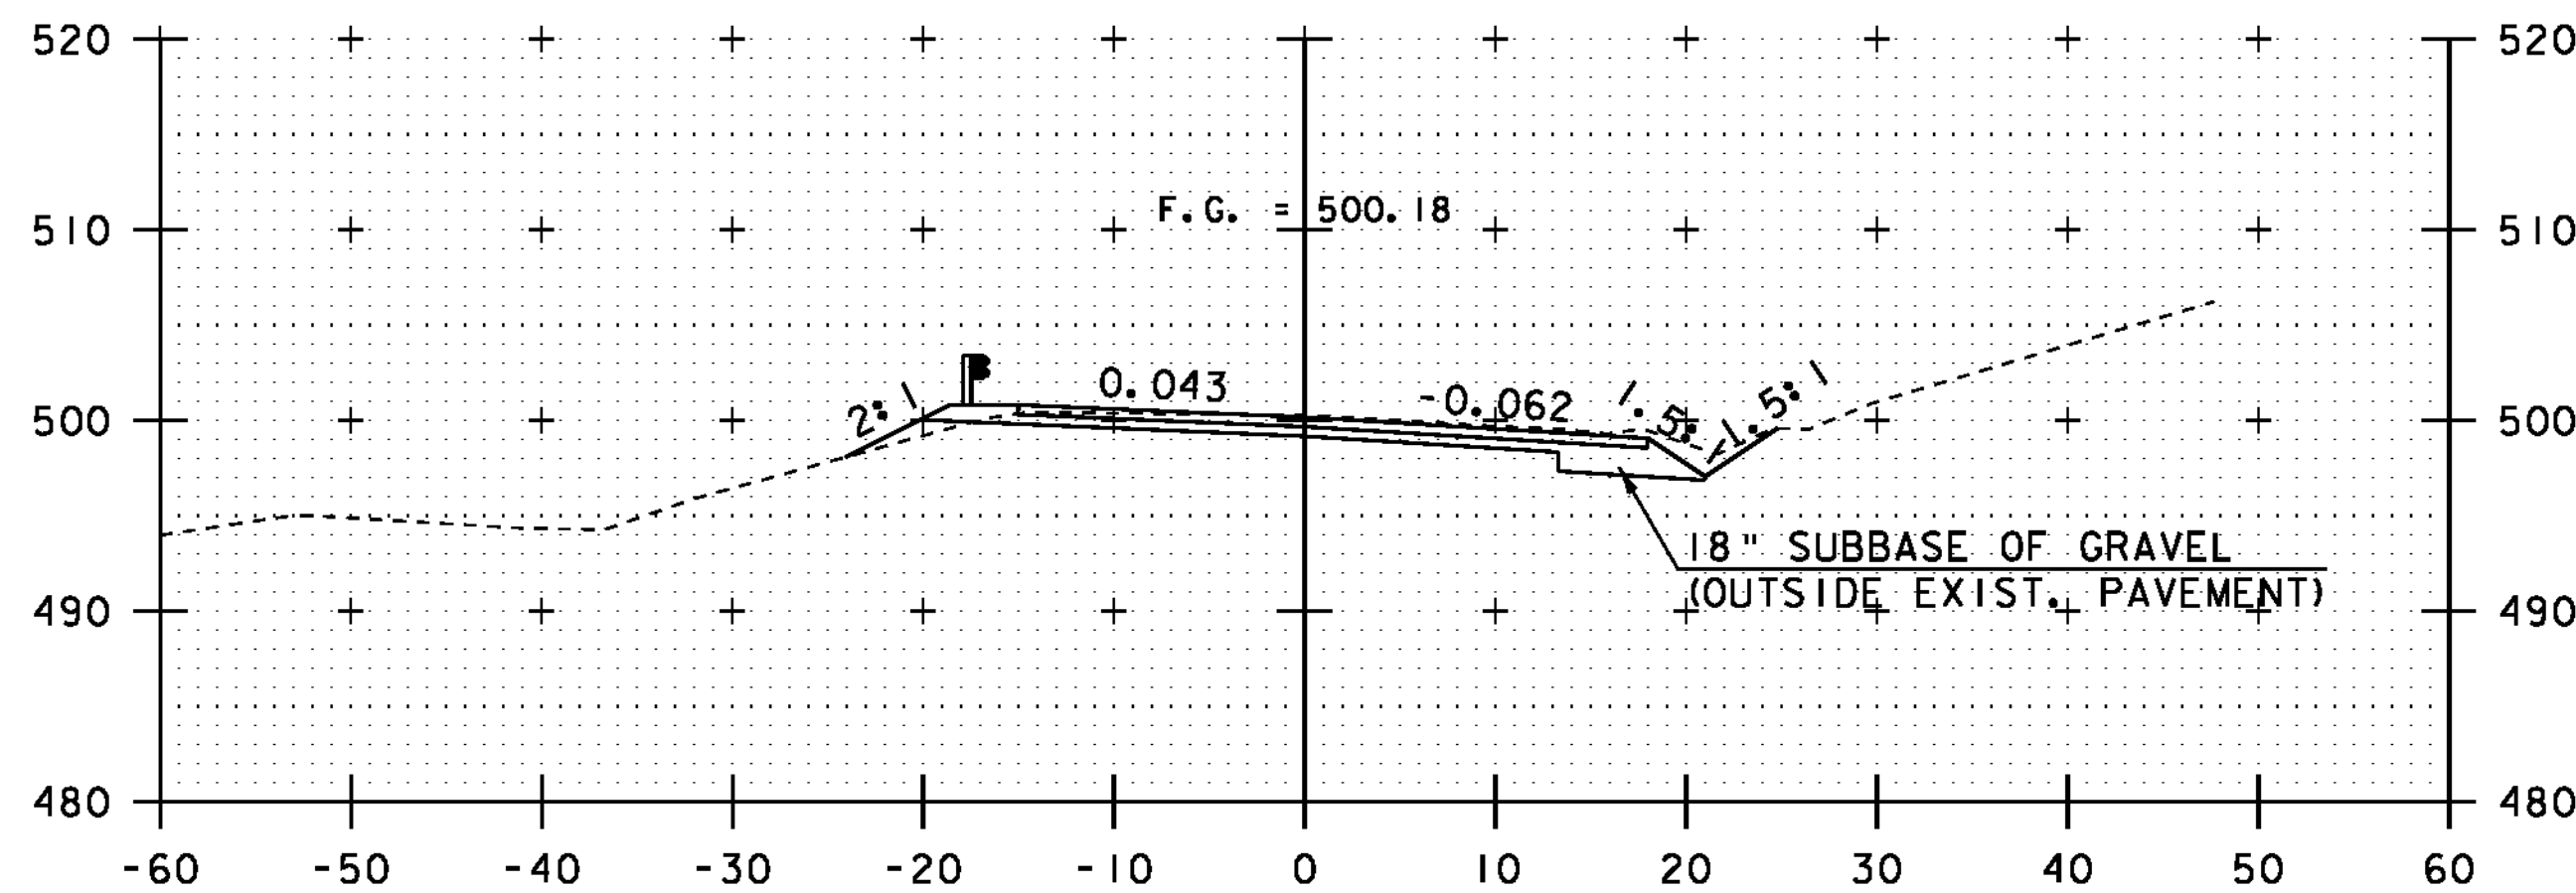


6+25

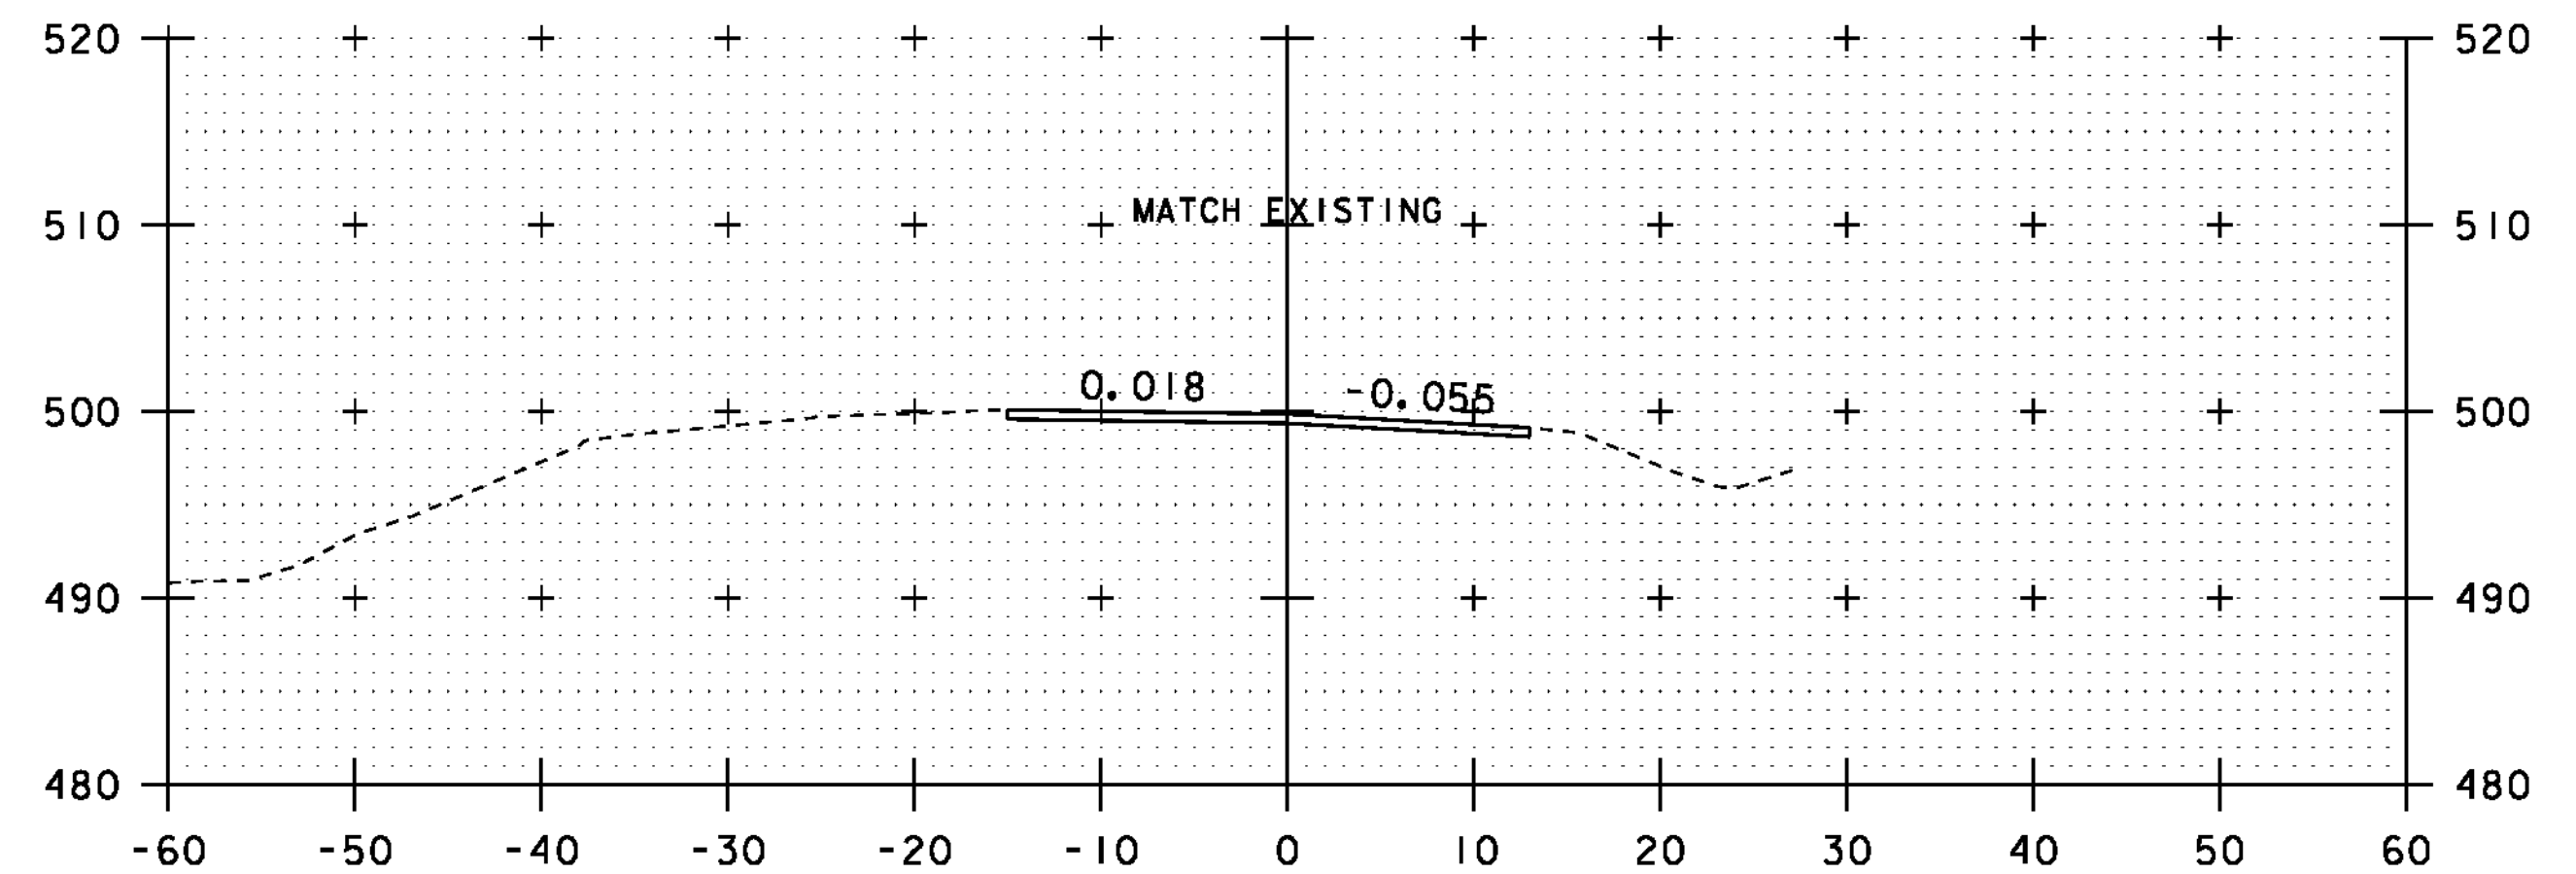


END PROJECT
STA. 7+00.00

7+00

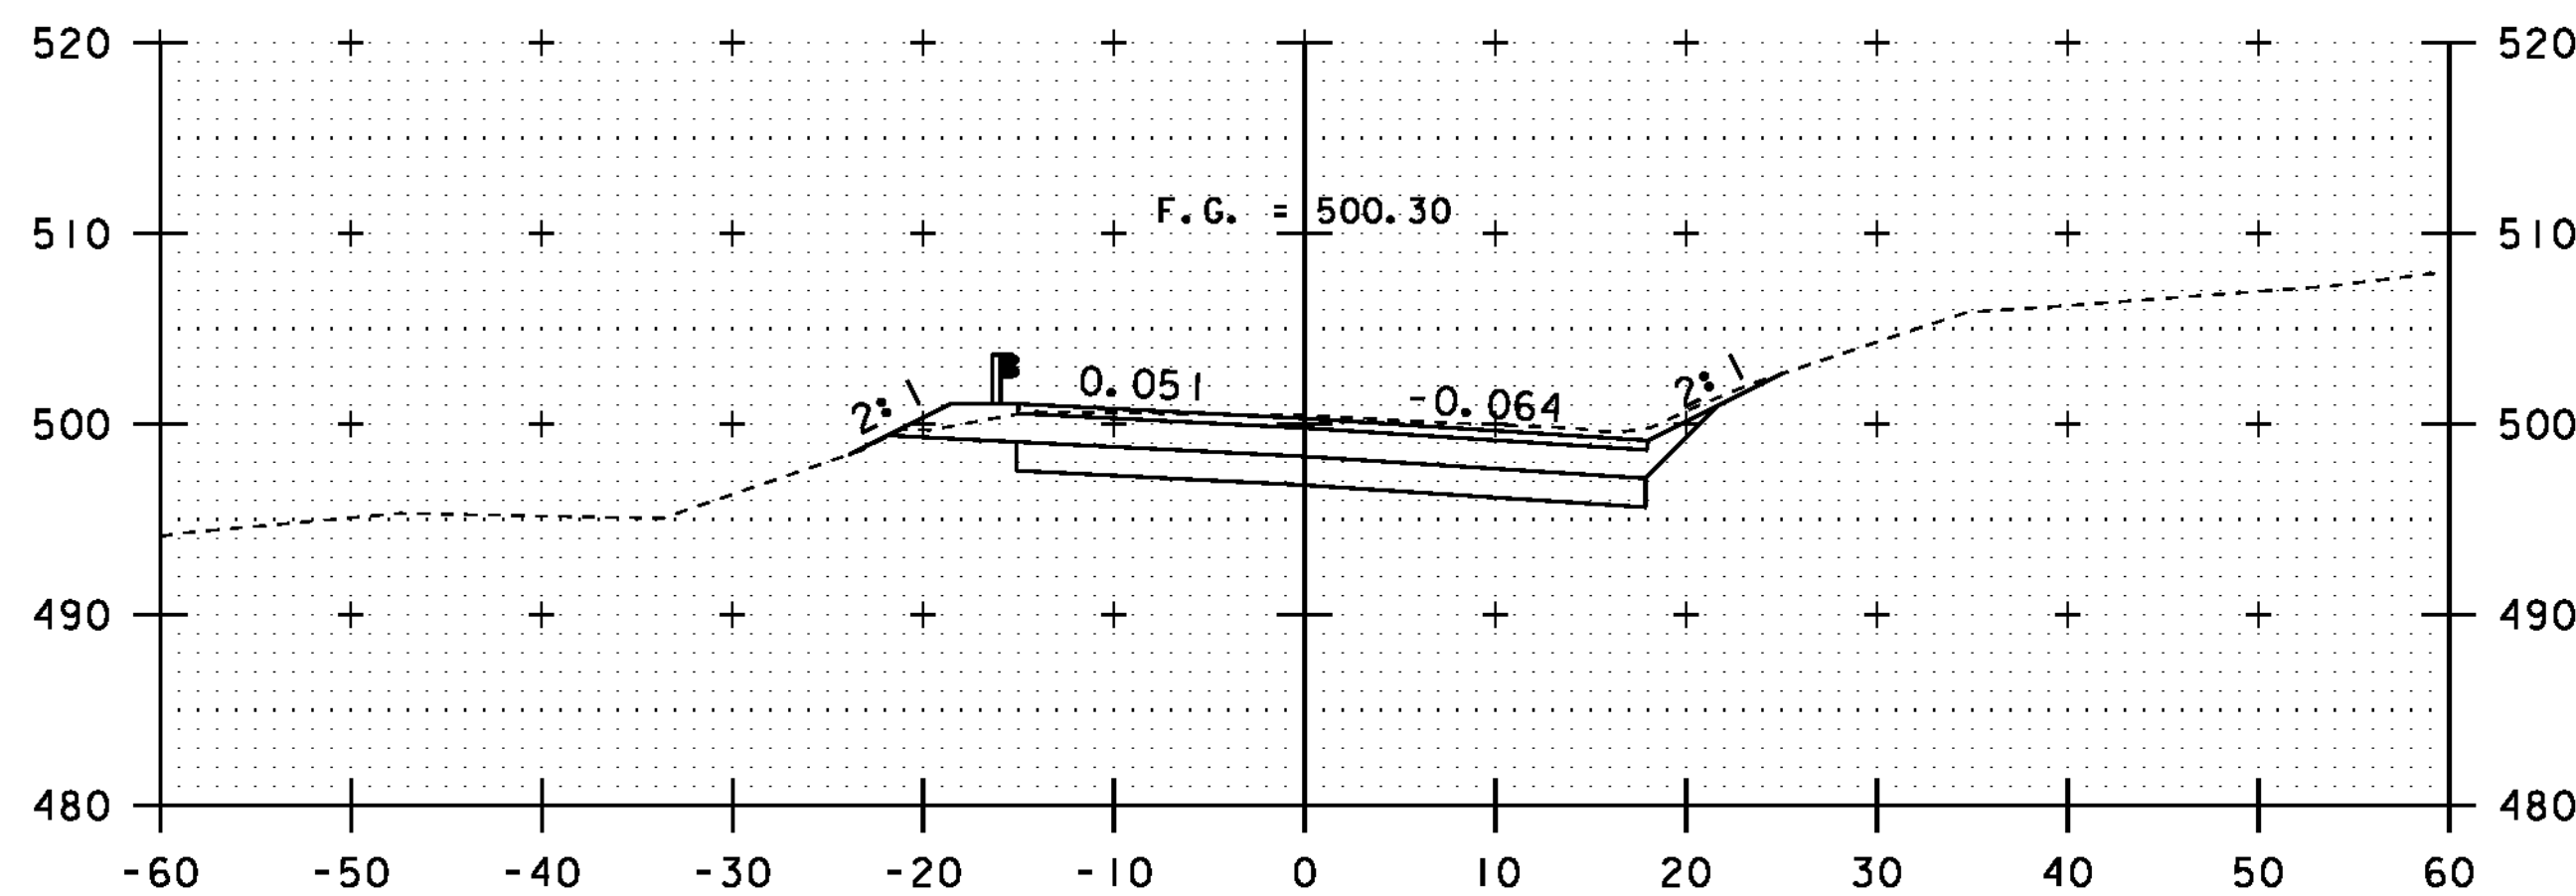

6+00

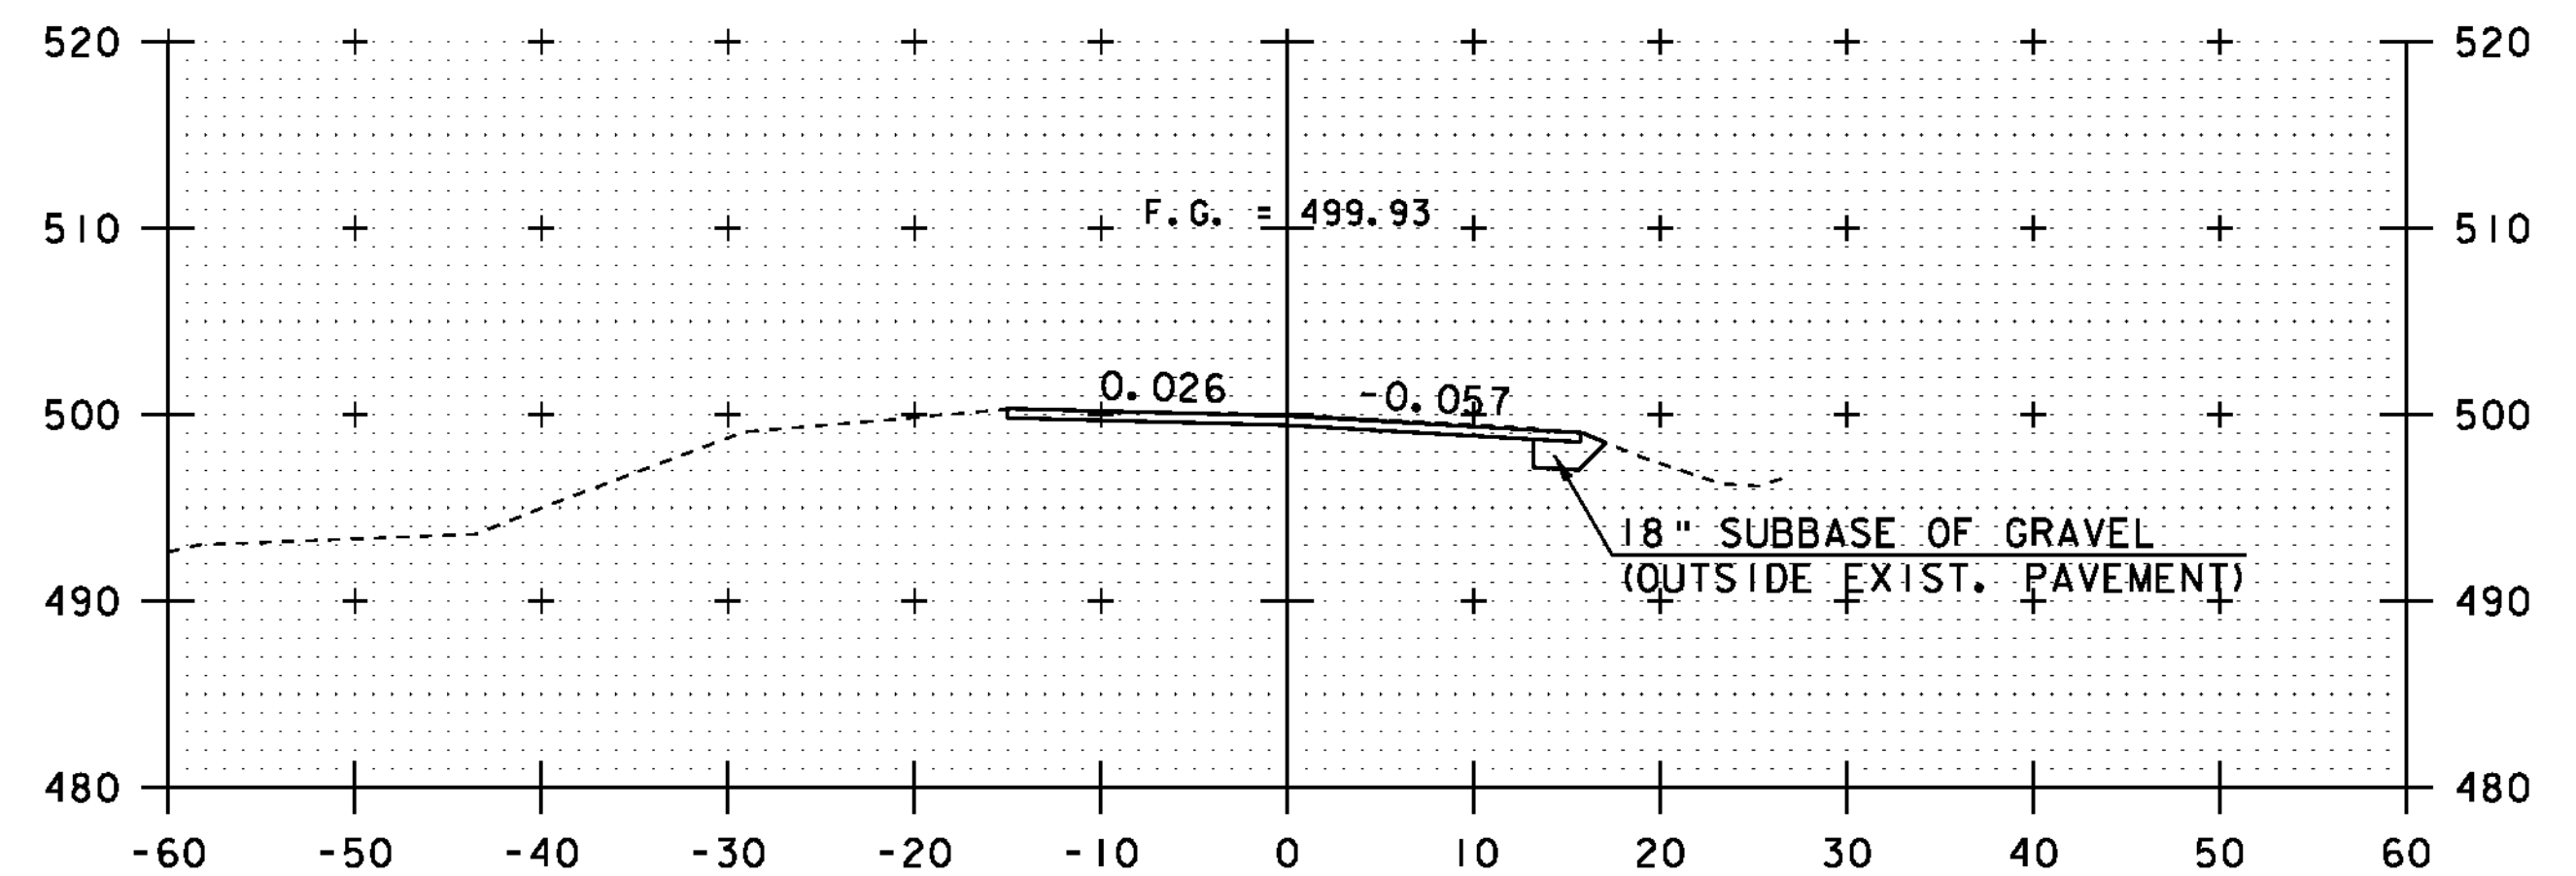

6+75

DATUM
VERTICAL ASSUMED
HORIZONTAL ASSUMED



**ROADWAY
CROSS SECTIONS**

PROJECT NAME: WARREN
PROJECT NUMBER: ER-STP 013-4 (36)

FILE NAME: PLOT DATE: 11/4/2011
PROJECT LEADER: JWT DRAWN BY: BMB
DESIGNED BY: RHB CHECKED BY: EPD
PLOT FILE: SHEET 19 OF 19