



BEGIN BRIDGE
STA. 4+94.36


5+00

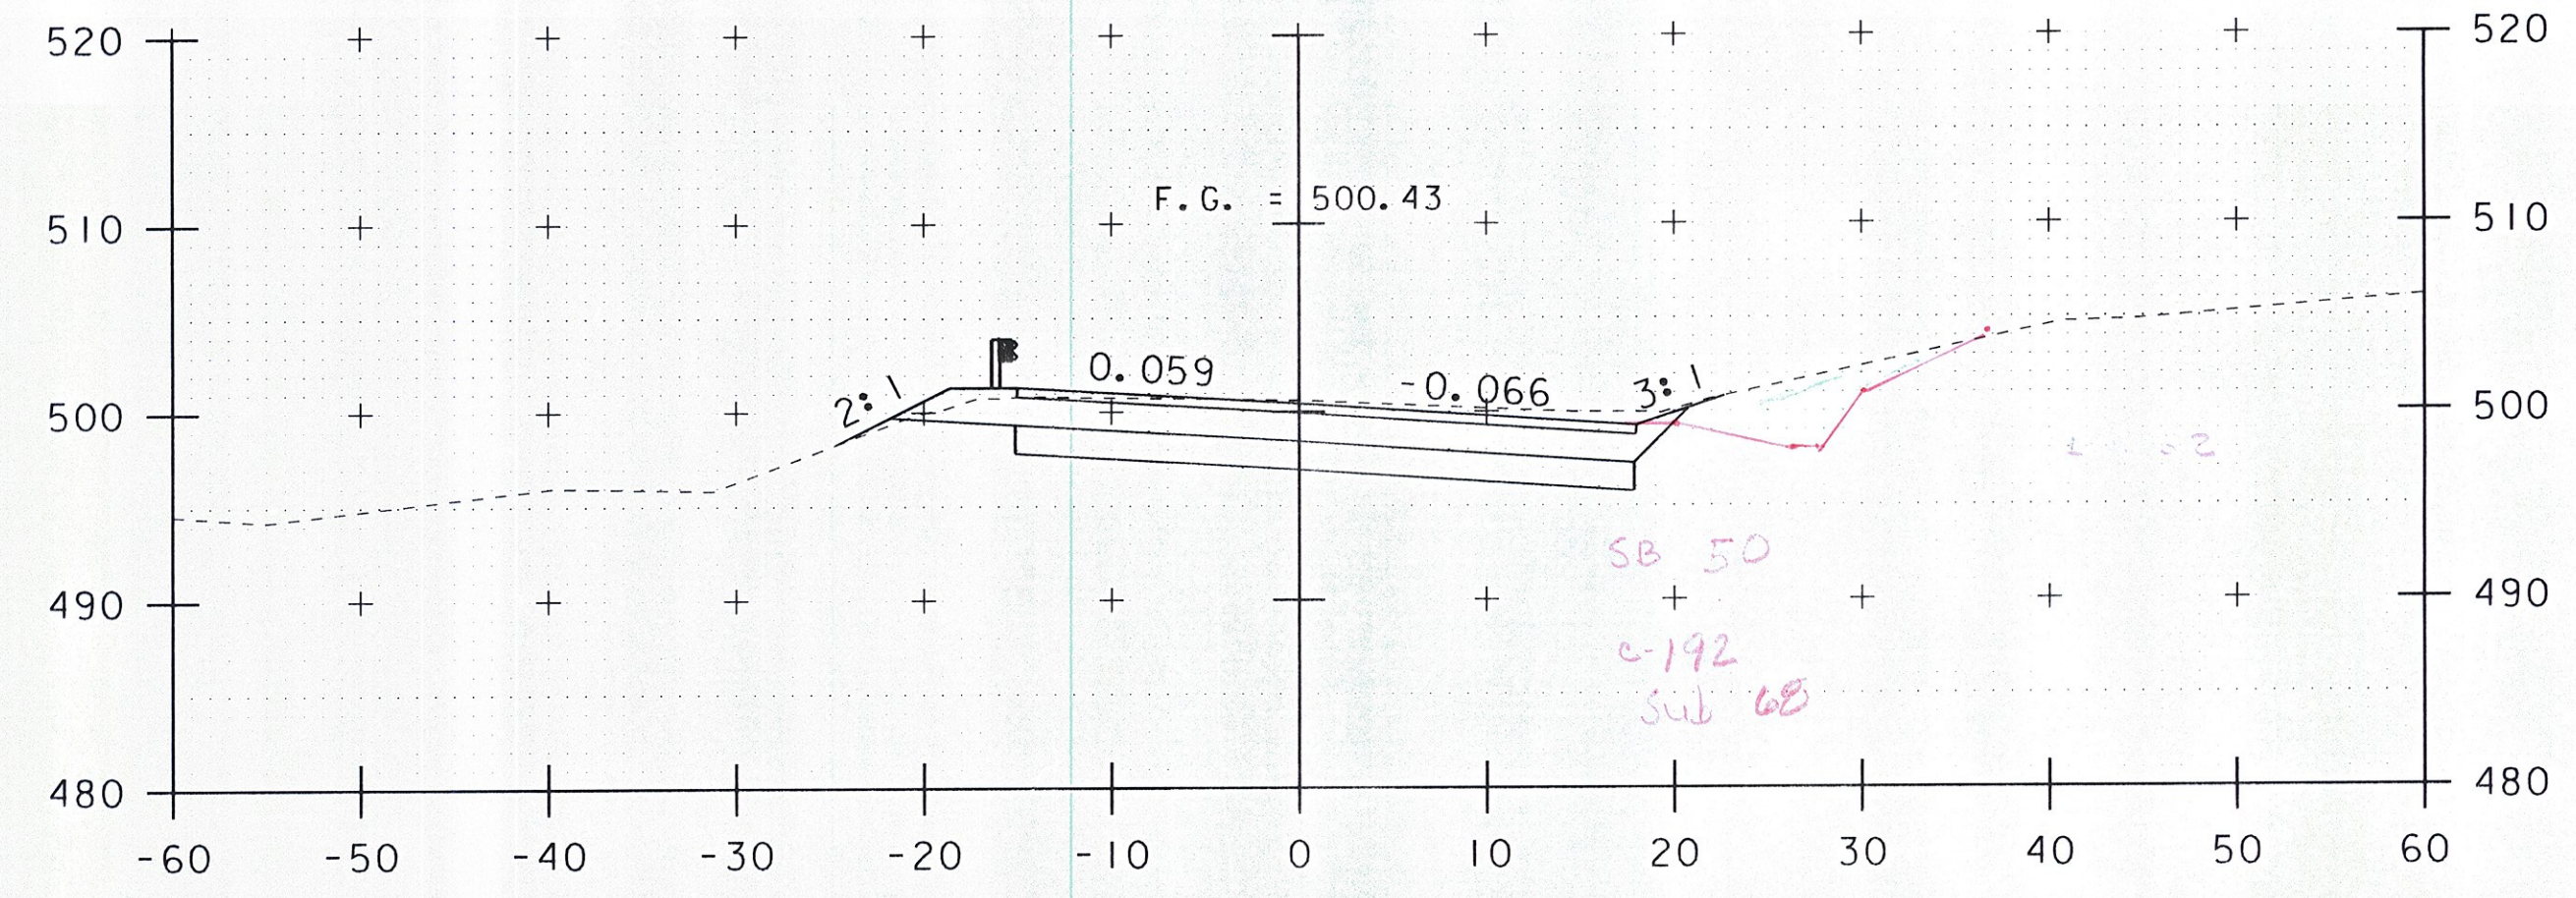

5+75

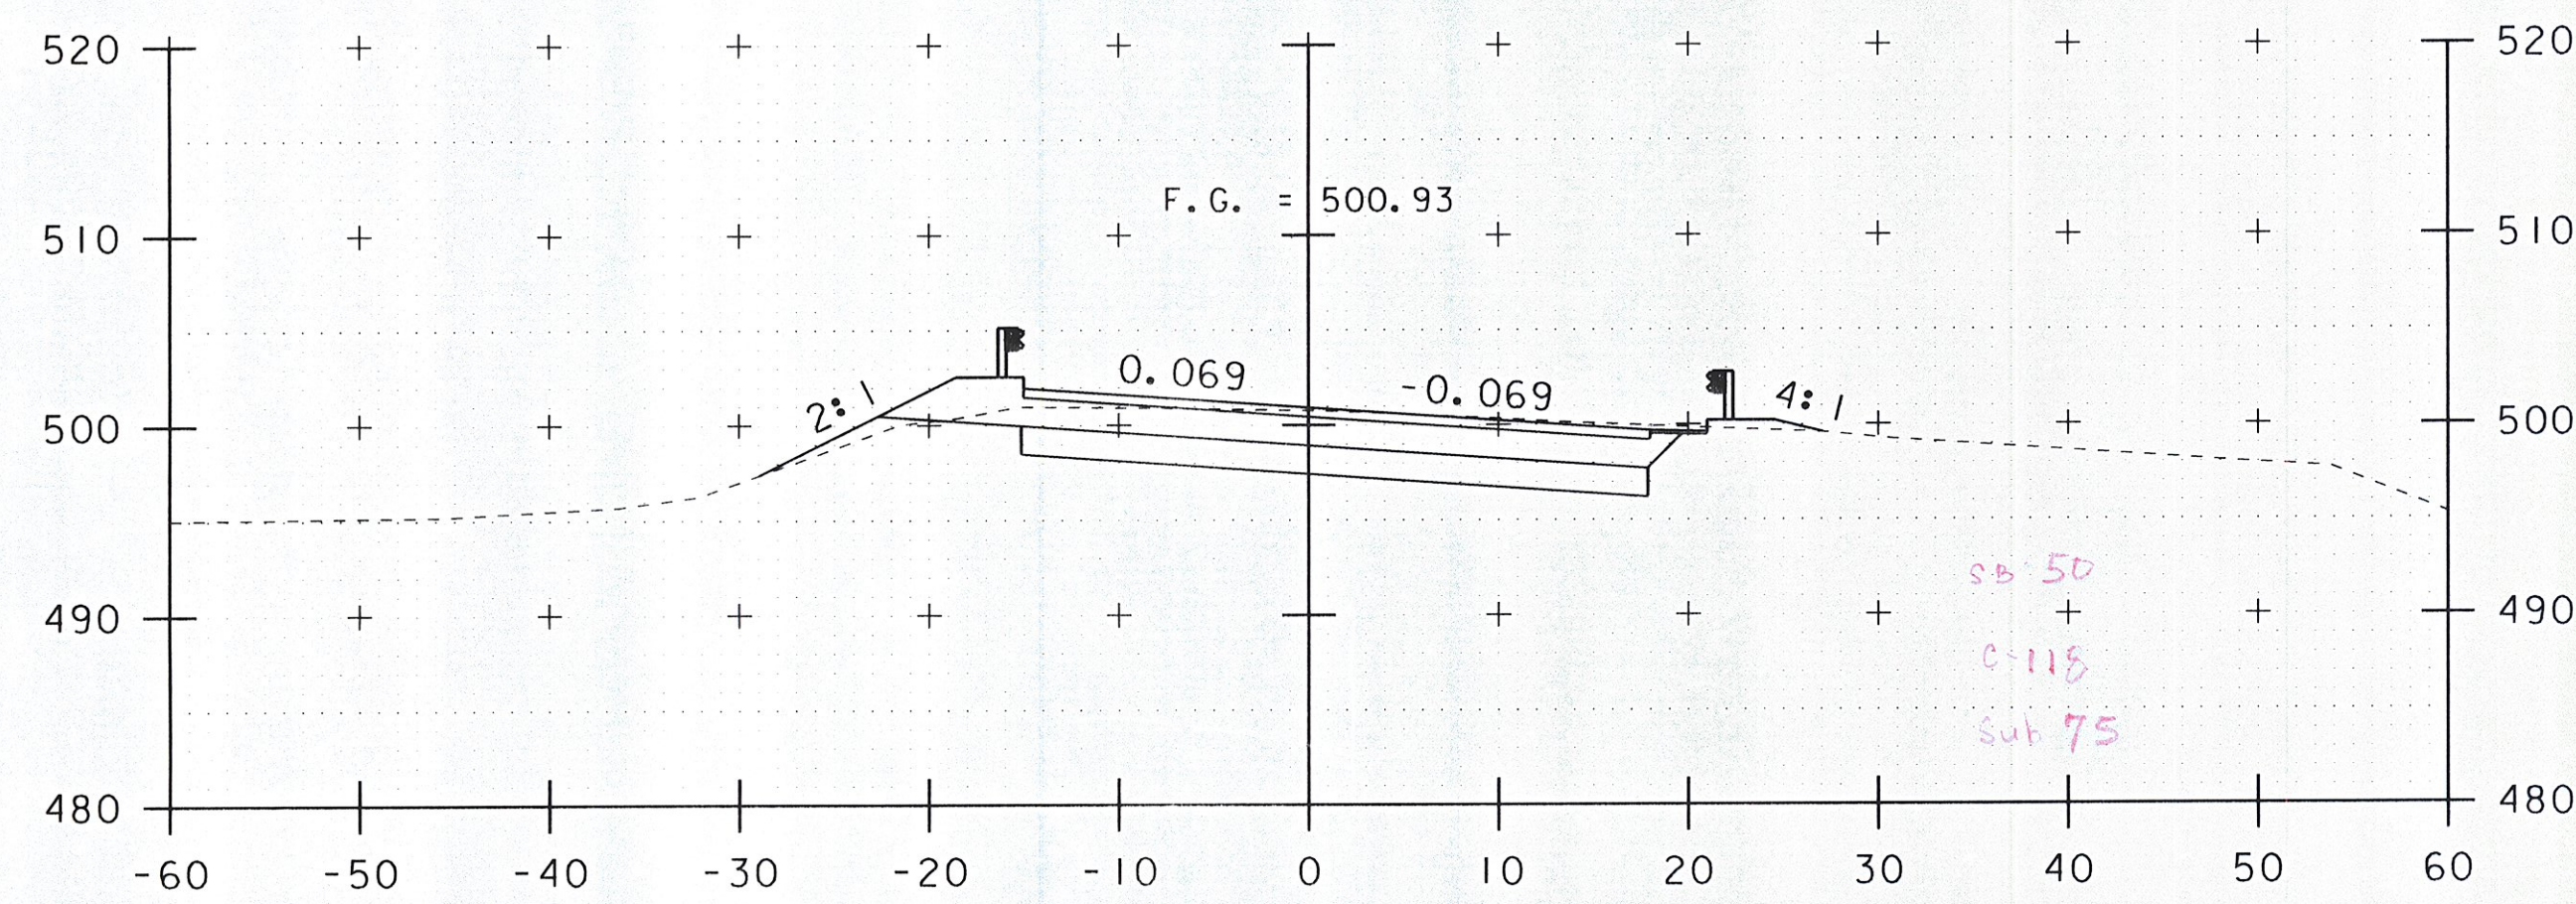


4+75

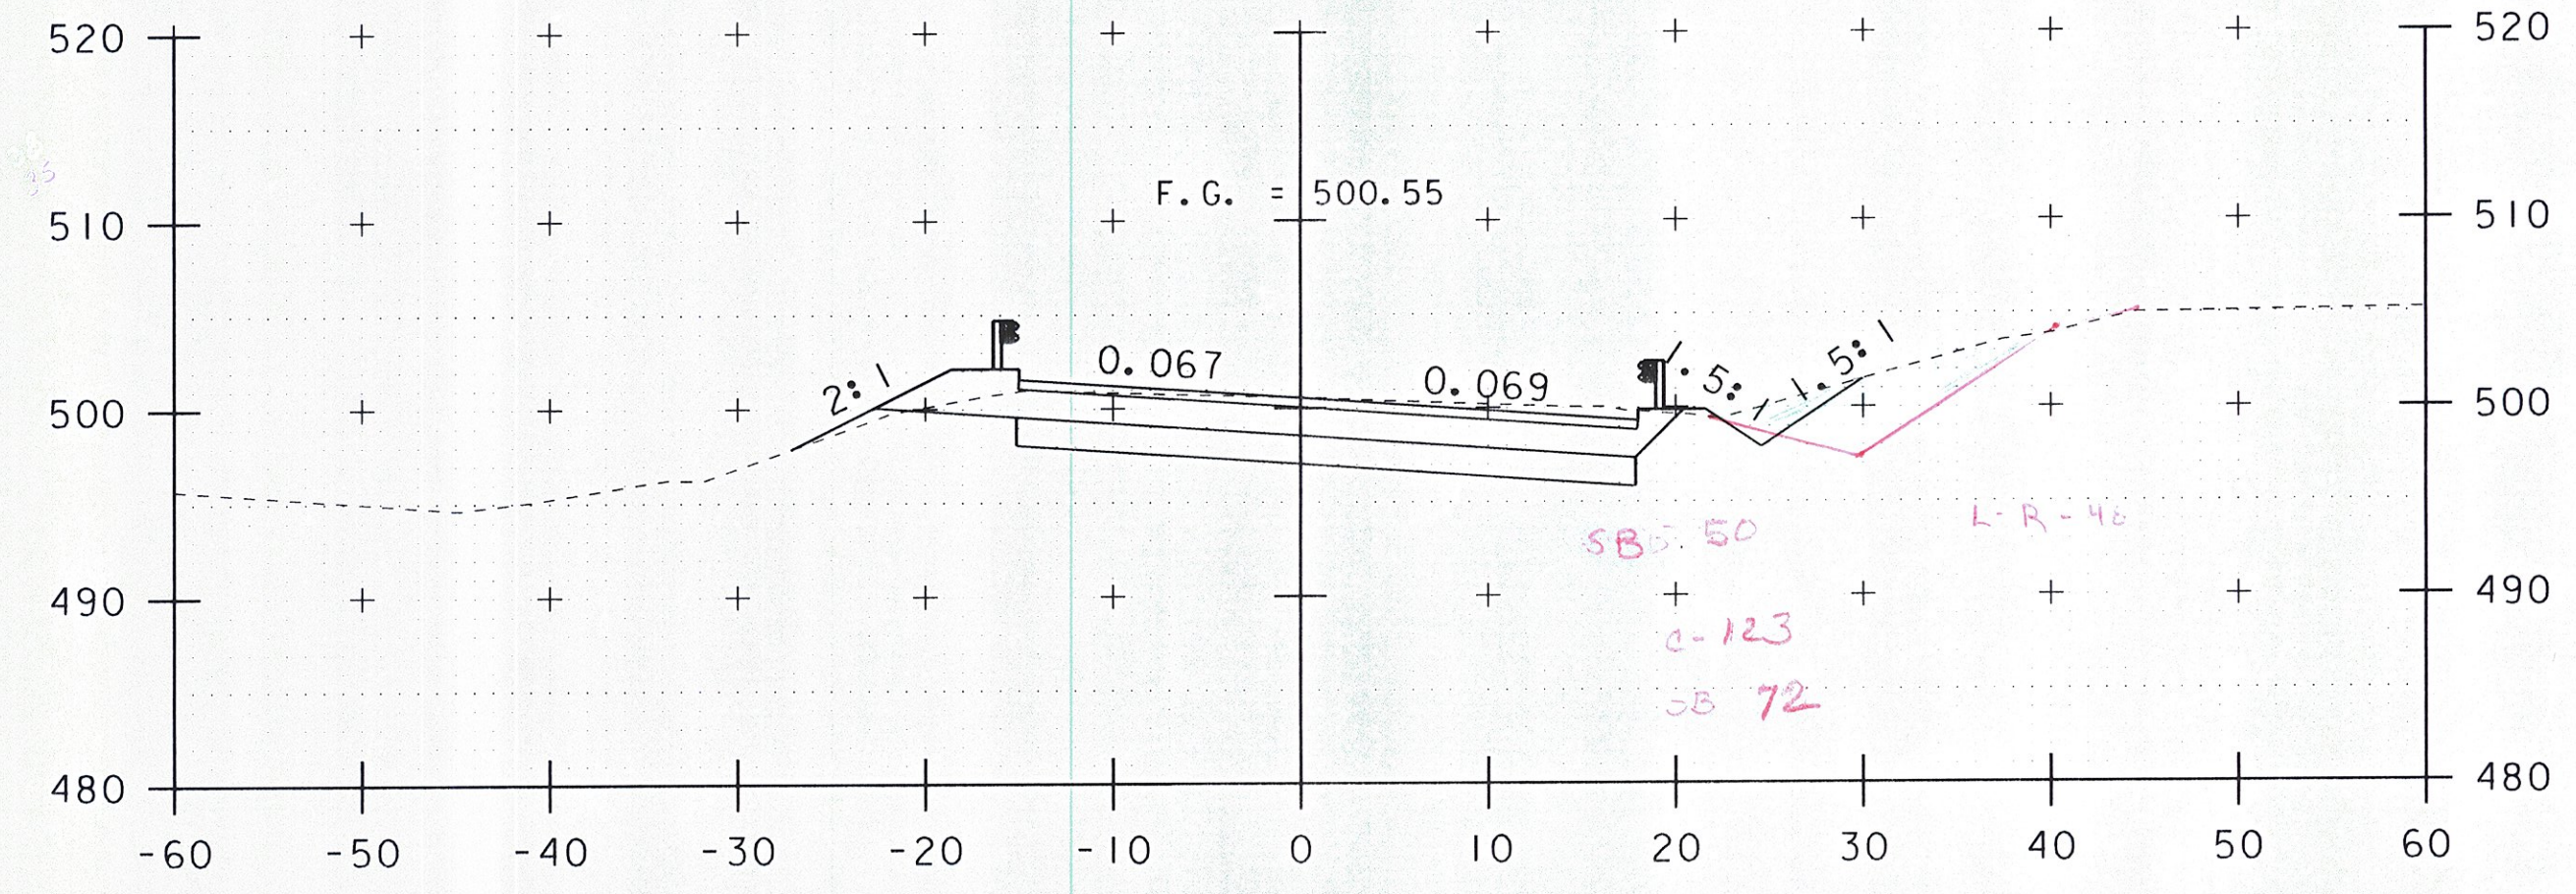


END BRIDGE
STA. 5+30.03

5+50

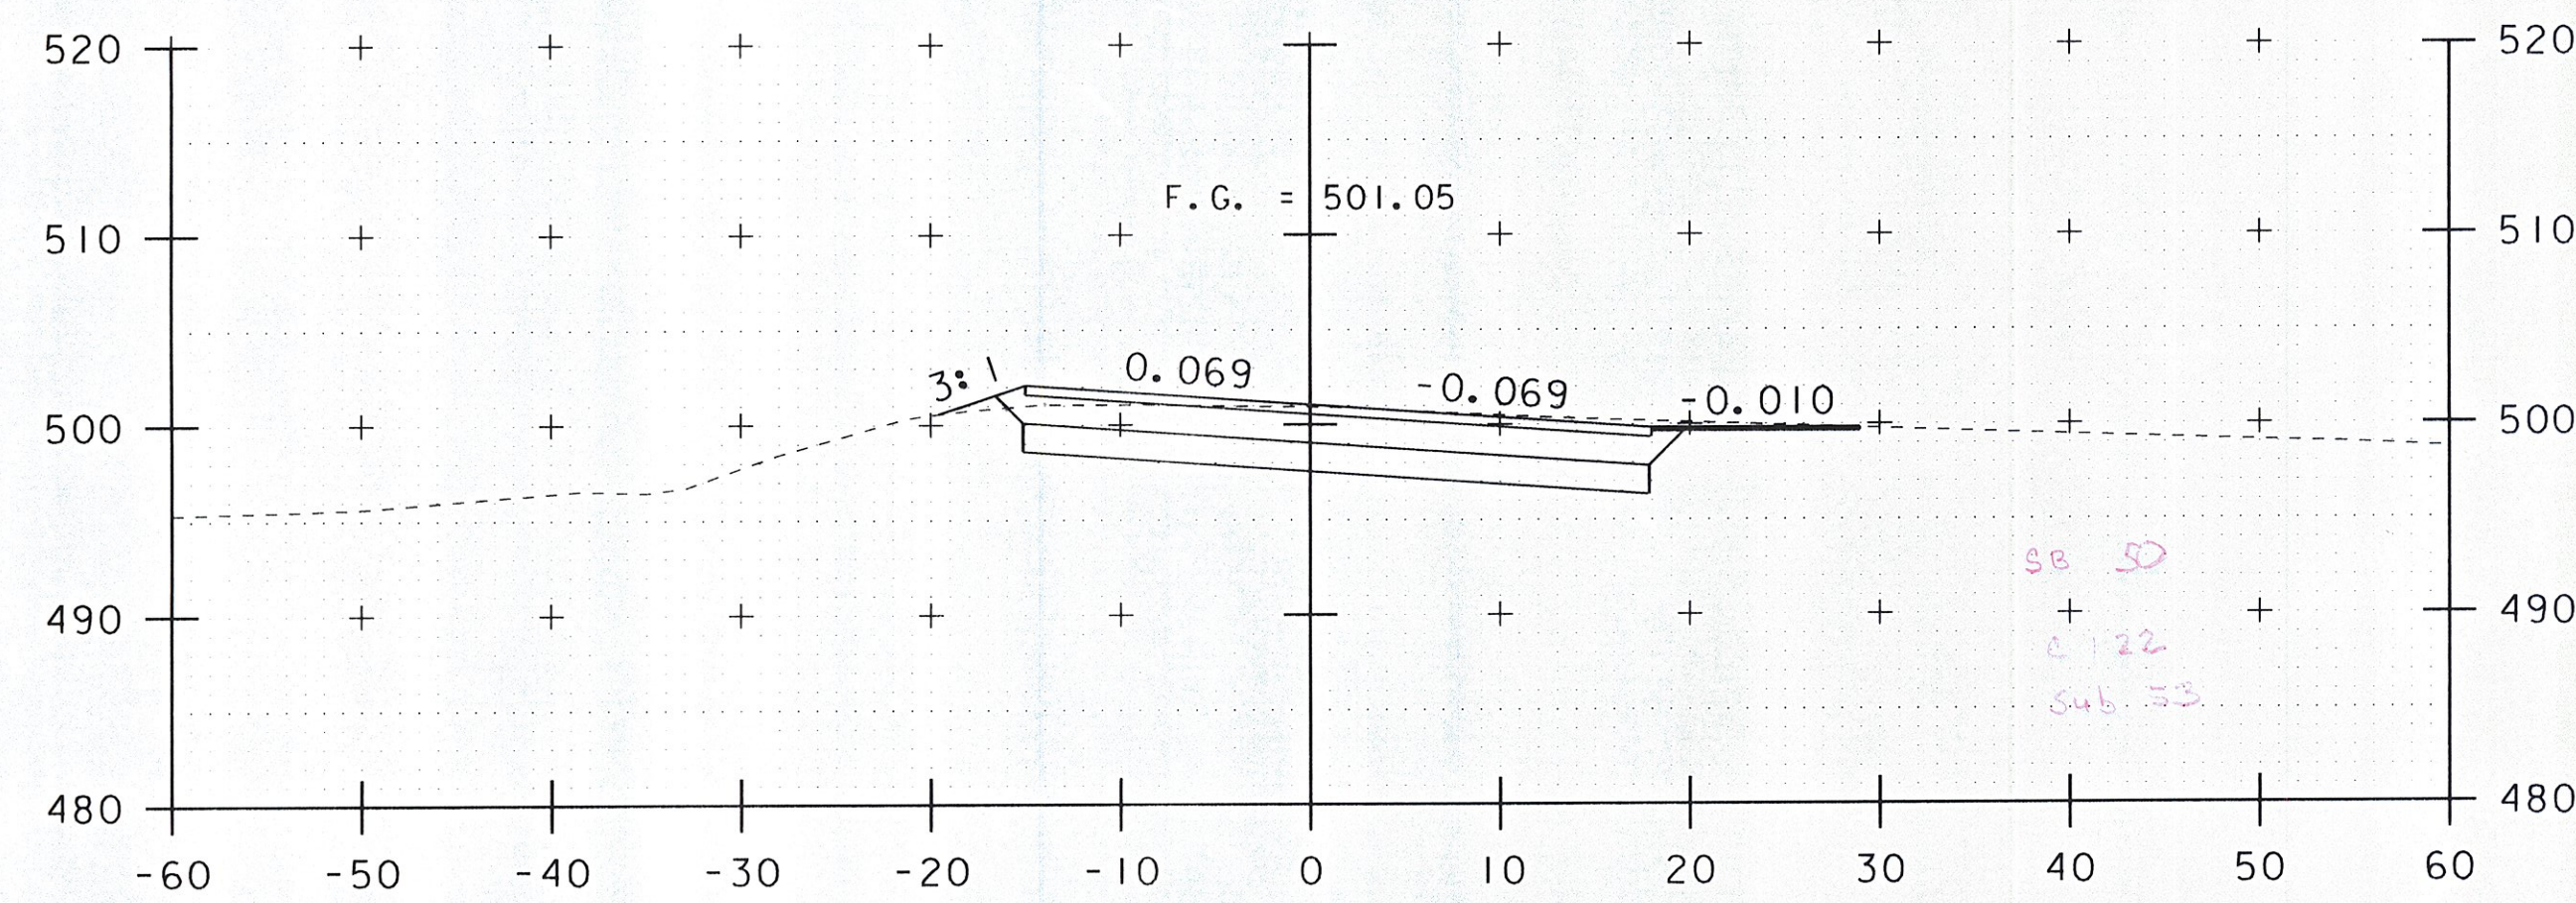

4+50

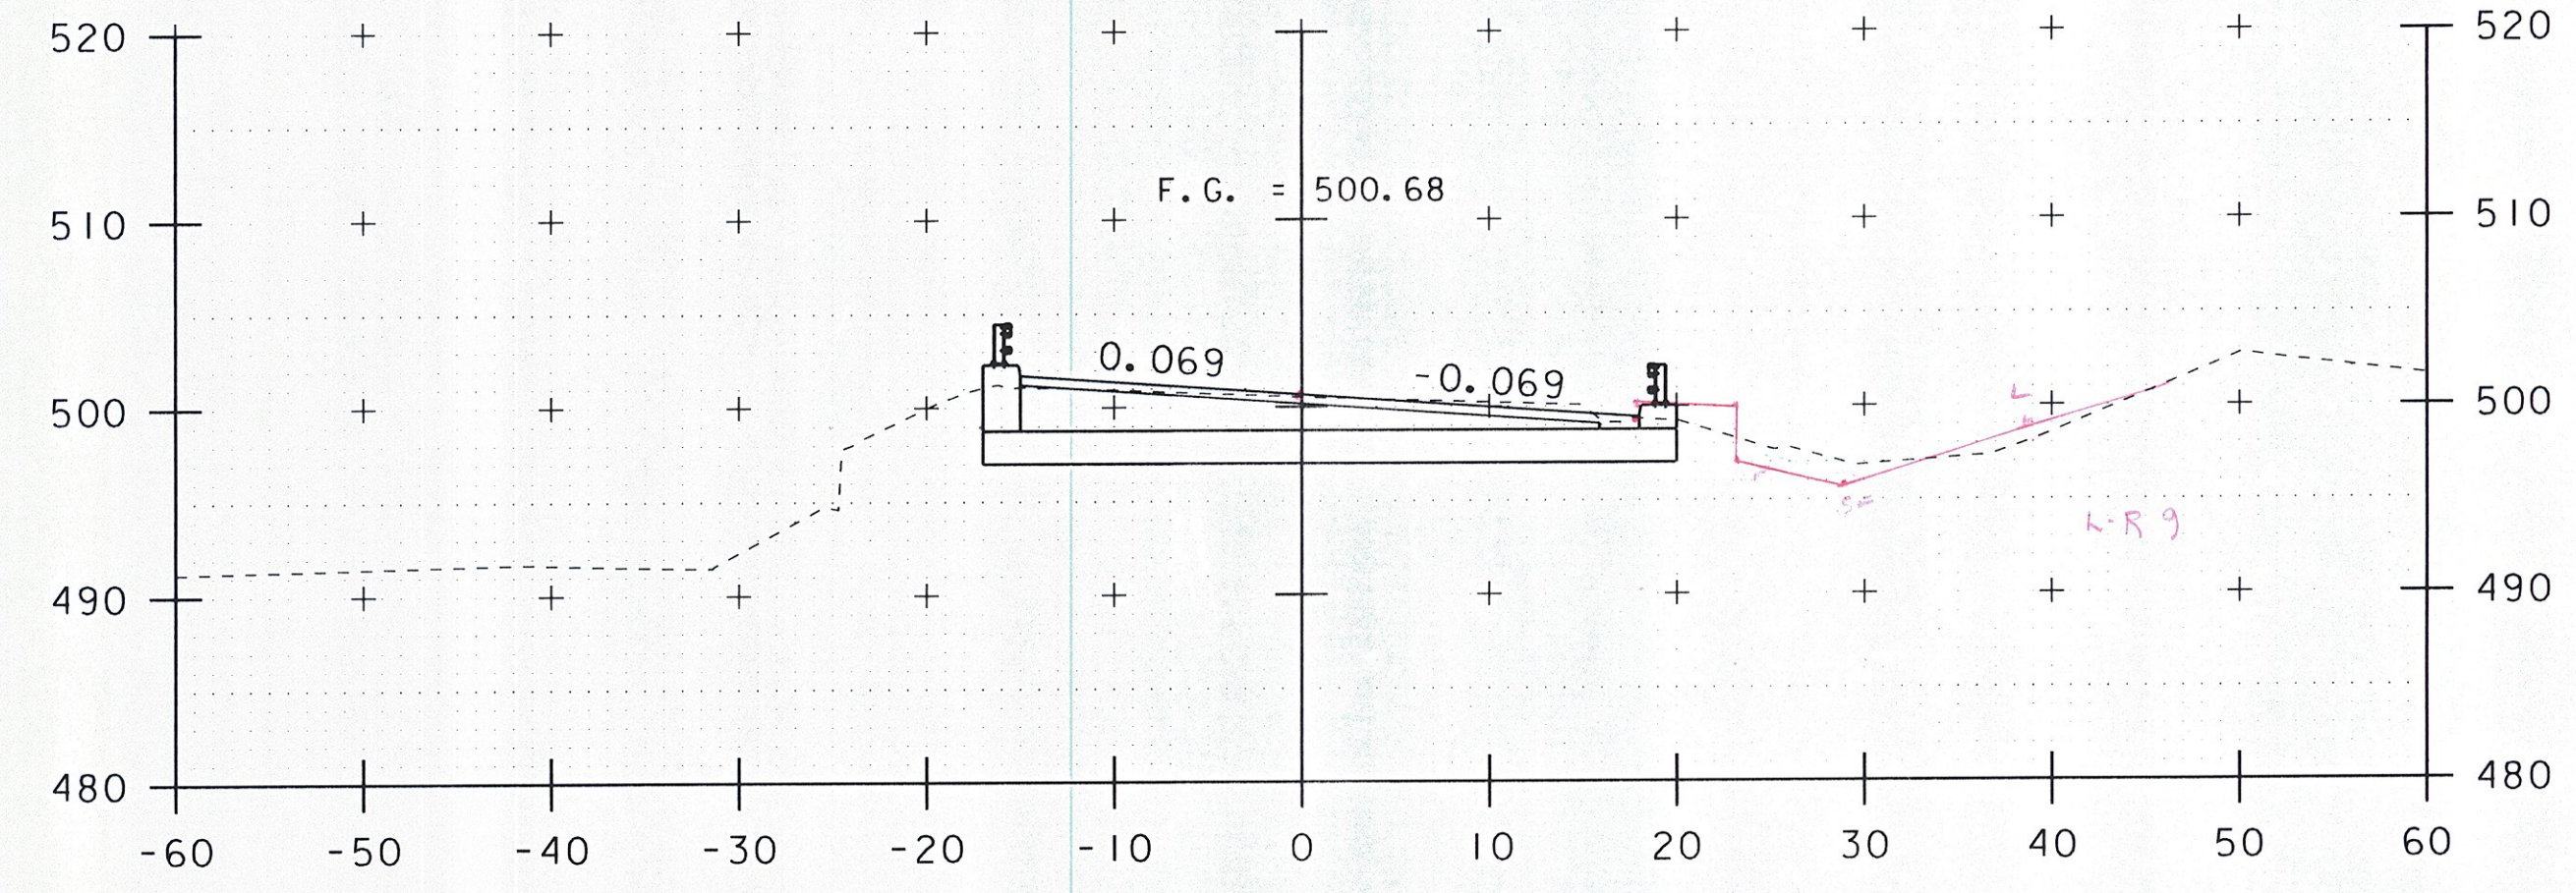

5+25

DATUM
VERTICAL ASSUMED
HORIZONTAL ASSUMED



**ROADWAY
CROSS SECTIONS**

PROJECT NAME: WARREN
PROJECT NUMBER: ER-STP 013-4 (36)

FILE NAME:
PROJECT LEADER: JWT
DESIGNED BY: RHB
PLOT FILE:

PLOT DATE: 11/4/2011
DRAWN BY: BMB
CHECKED BY: EPD
SHEET 18 OF 19