



6+50


END Transition
OSB

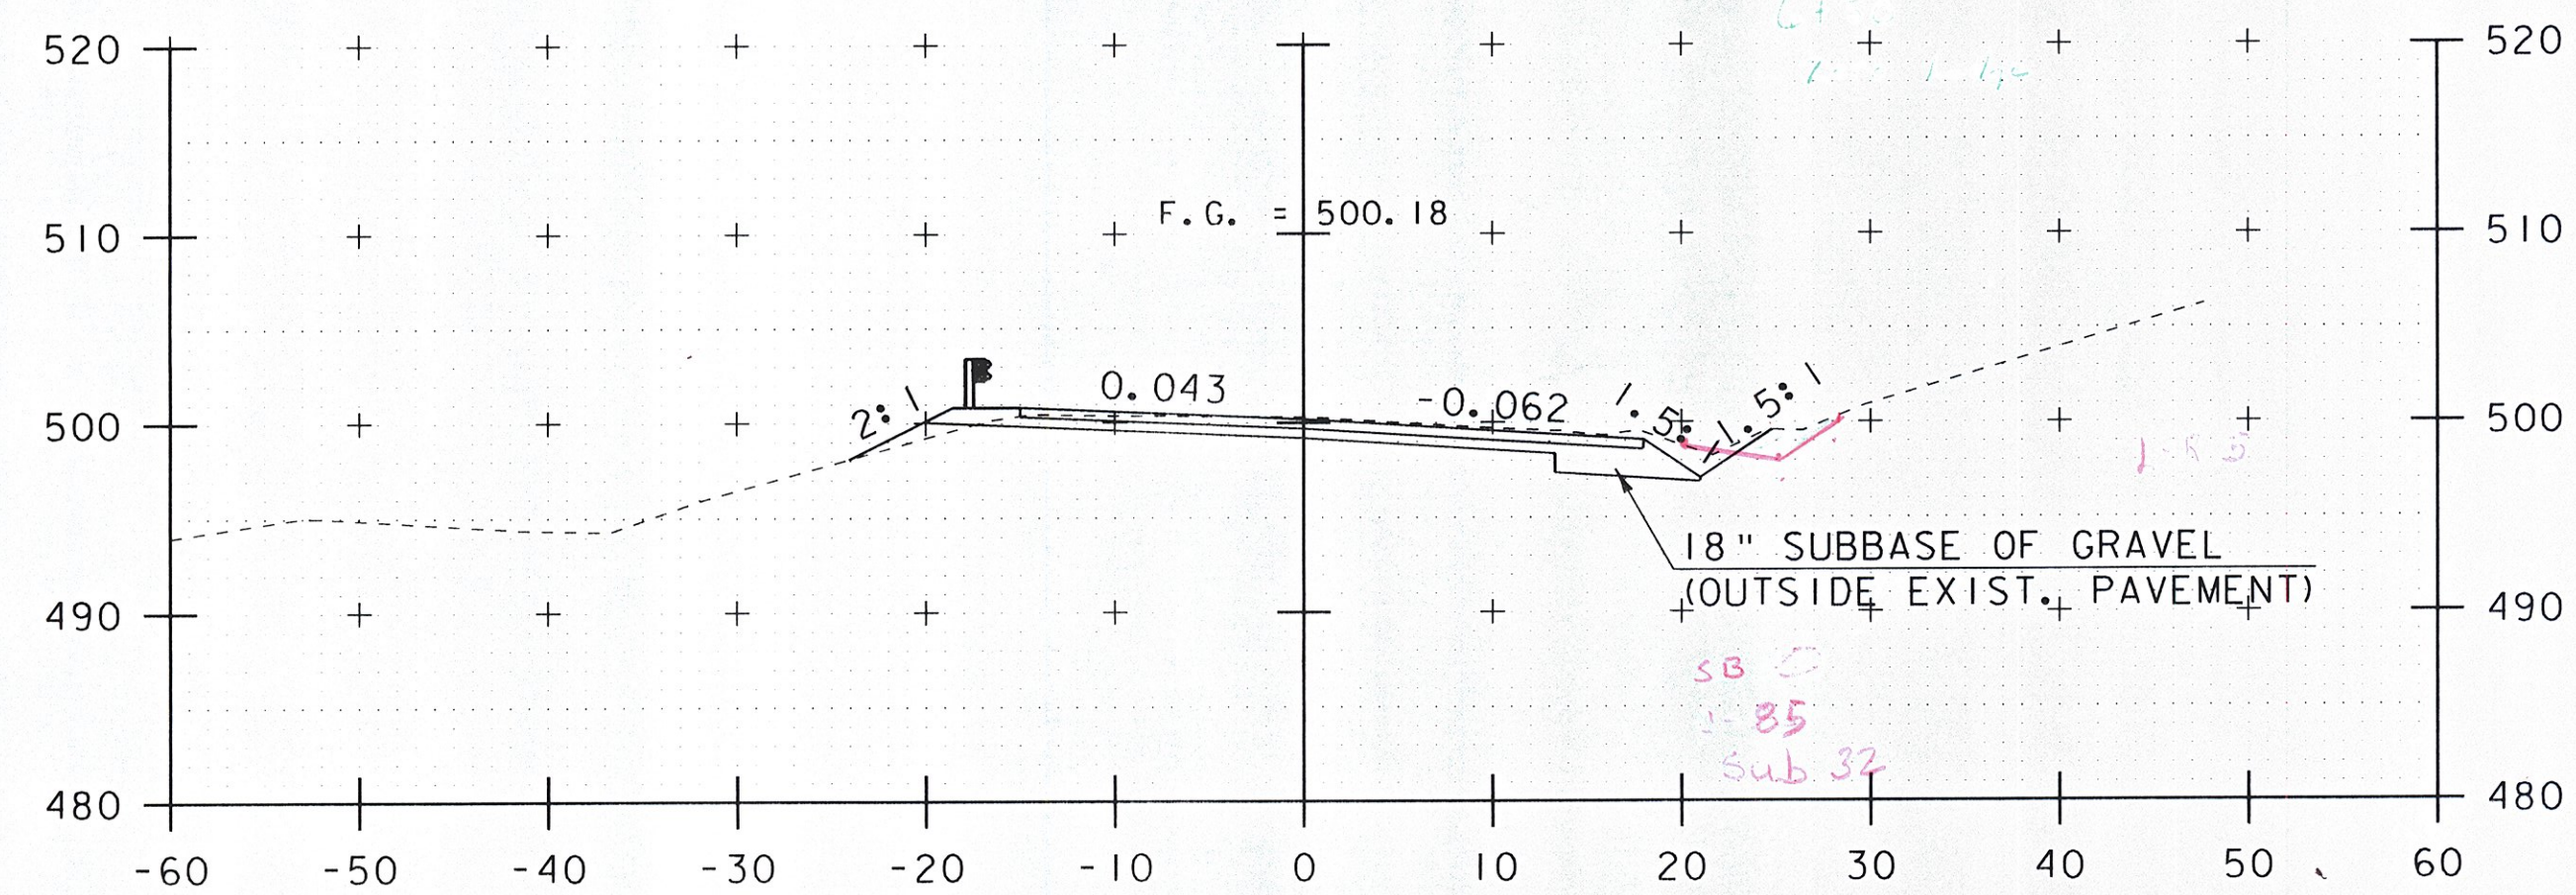


6+25

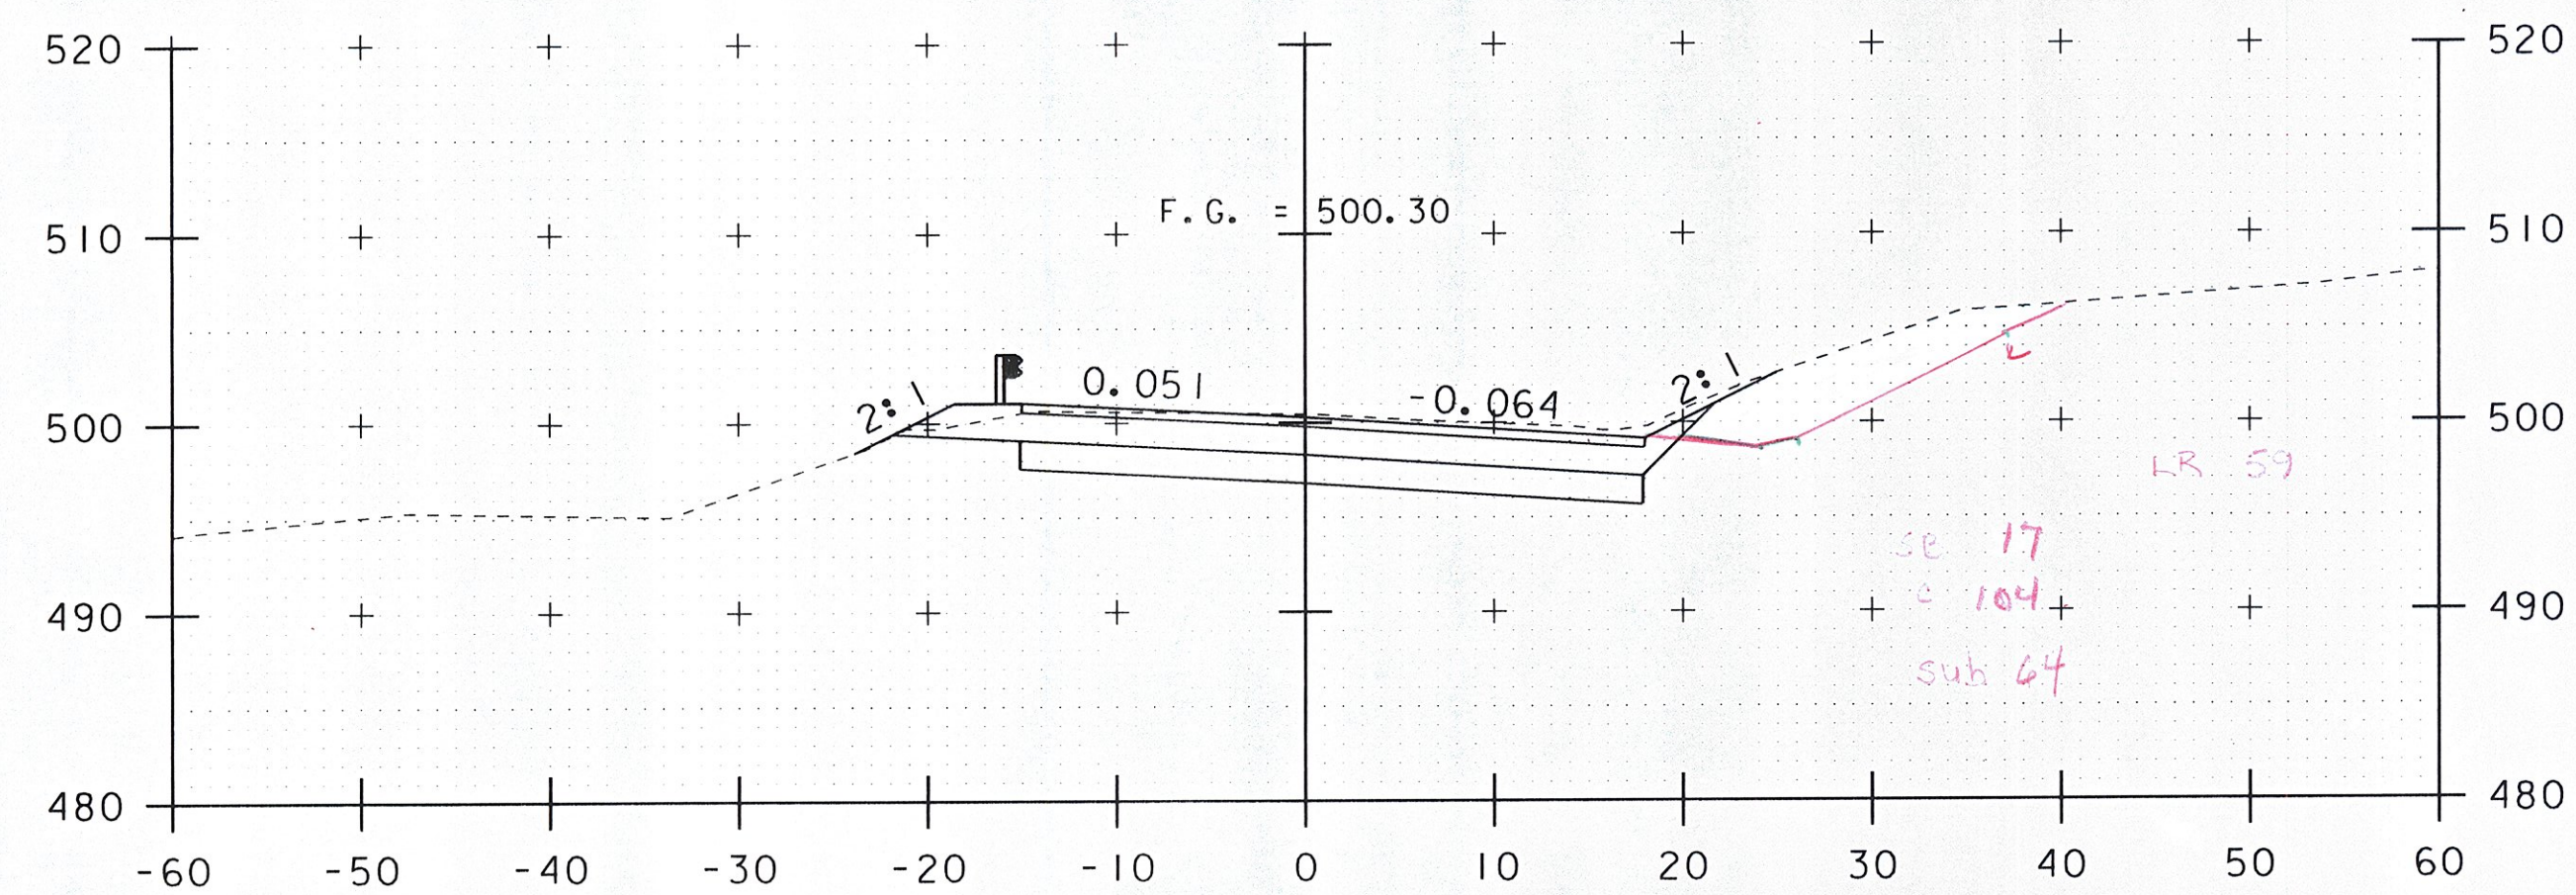

6+00

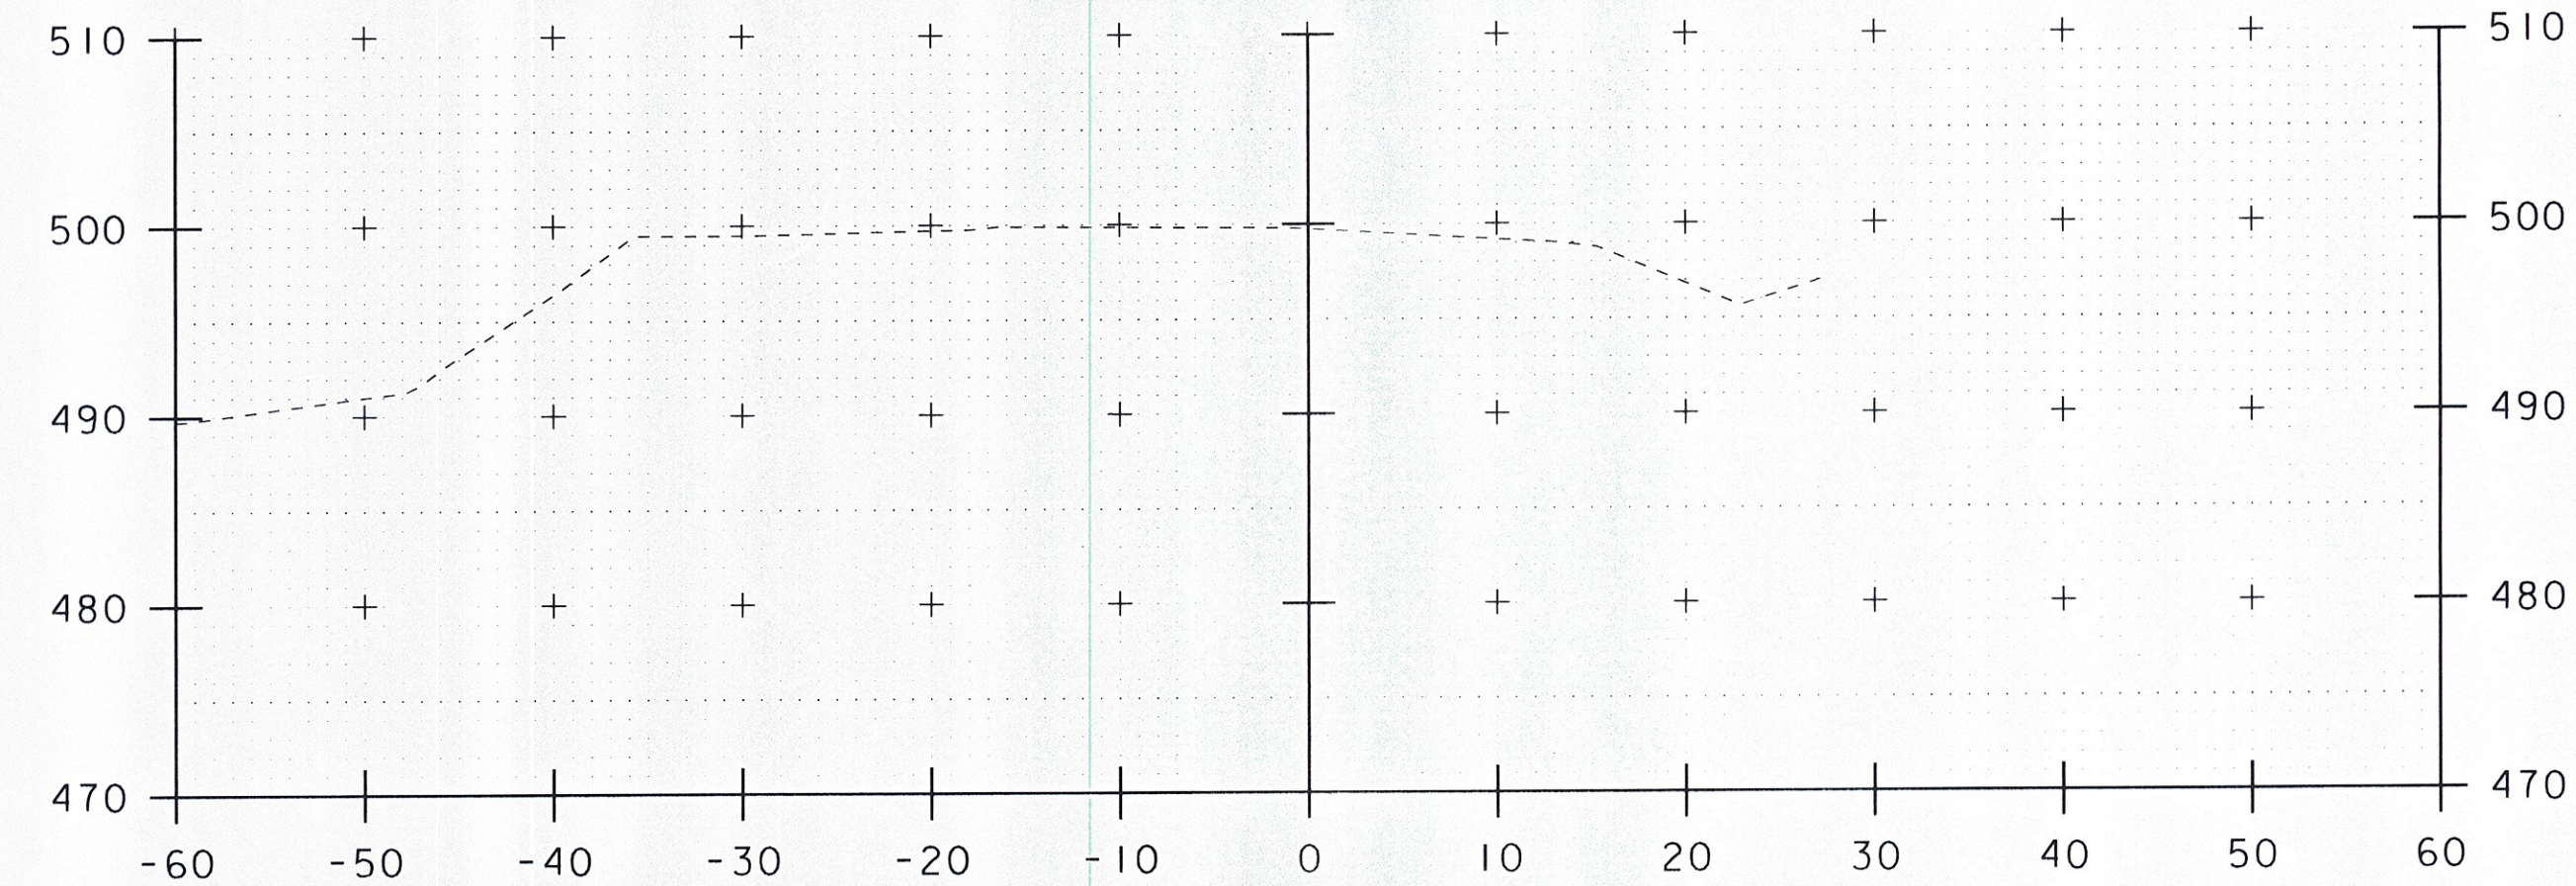


7+25

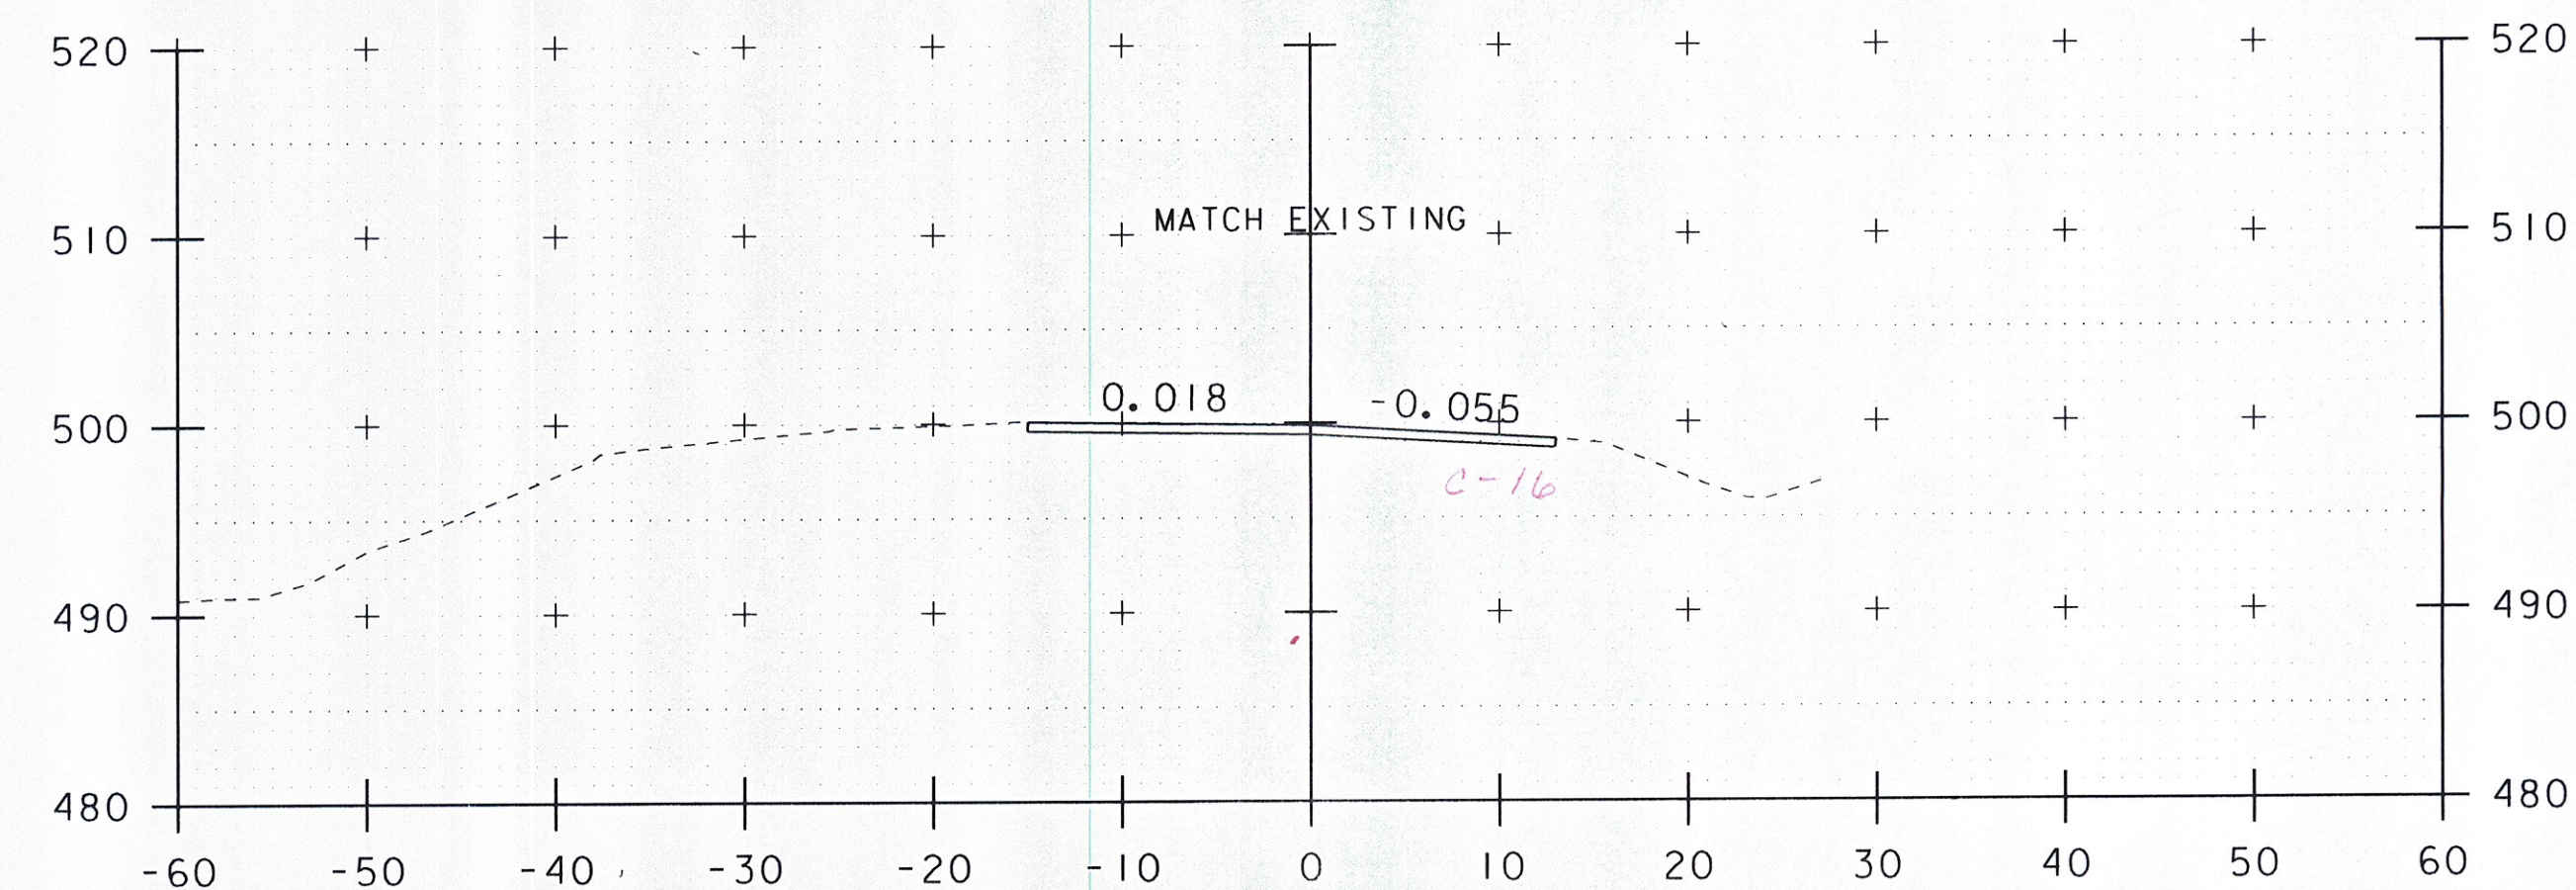

7+00

END PROJECT
STA. 7+00.00

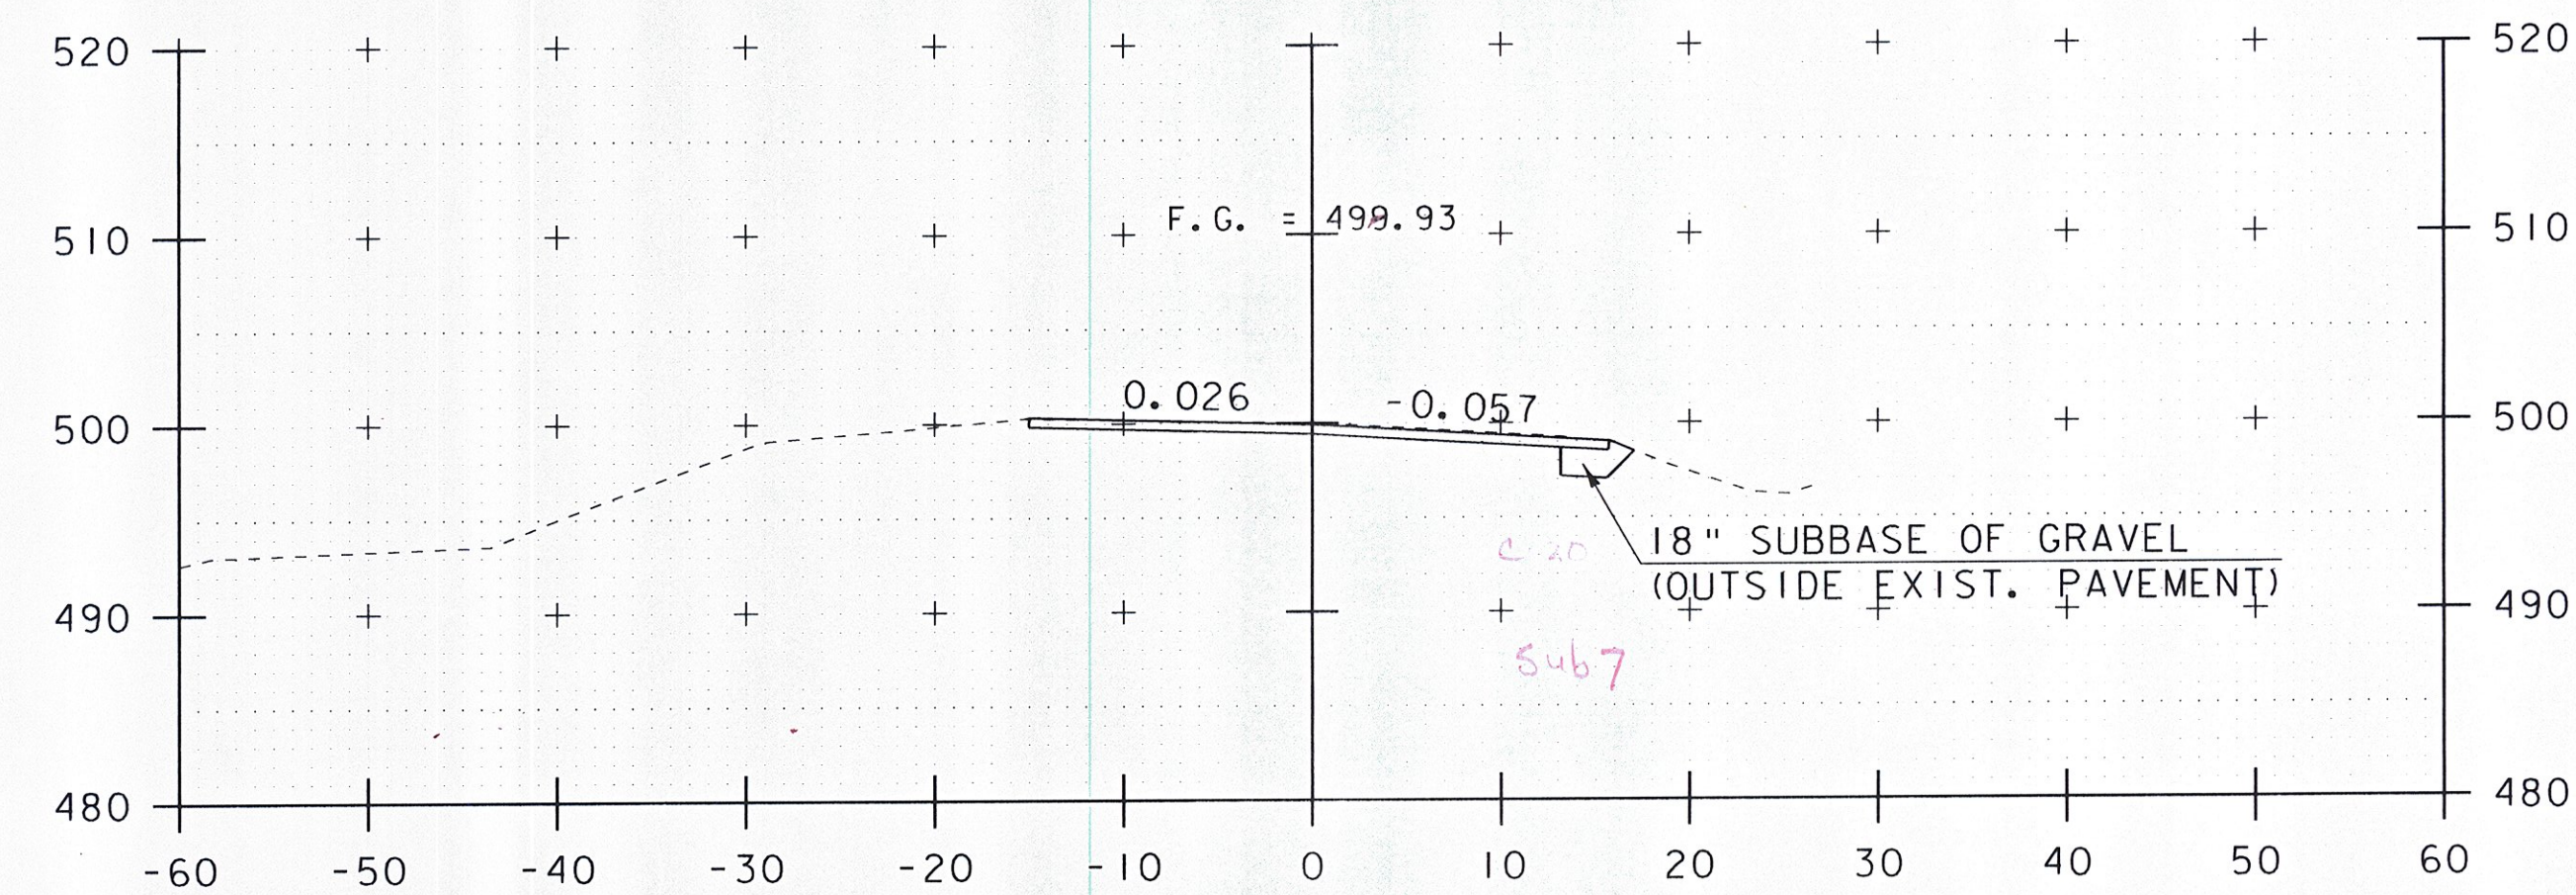

6+75

DATUM
VERTICAL ASSUMED
HORIZONTAL ASSUMED



**ROADWAY
CROSS SECTIONS**

PROJECT NAME: WARREN
PROJECT NUMBER: ER-STP 013-4 (36)

FILE NAME:
PROJECT LEADER: JWT
DESIGNED BY: RHB
PLOT FILE:

PLOT DATE: 11/4/2011
DRAWN BY: BMB
CHECKED BY: EPD
SHEET 19 OF 19