

CHANGING ELEVATION OF SEWER MANHOLES
 STA. 59+38, RT


ADJUST ELEVATION OF VALVE BOX
 STA. 58+12, RT
 STA. 58+27, RT

DURABLE & TEMPORARY 4 INCH WHITE LINE
 (ALL LINES WILL INCLUDE EDGE LINE BREAKS
 AND RADII FOR SIDE ROADS)
 STA. 55+00 TO 60+00, SOLID LT & RT

DURABLE & TEMPORARY 4 INCH YELLOW LINE
 (ALL LINES WILL INCLUDE ϕ BREAKS FOR SIDE ROADS)
 STA. 55+00 TO 60+00, SOLID LT & RT

DURABLE & TEMPORARY 8 INCH WHITE LINE
 STA. 56+47 TO 56+59, LT (HYDRANT)
 STA. 58+69 TO 58+75, LT (HYDRANT)
 SEE SHEET 19

REMOVING SIGNS
 AS SHOWN - 1

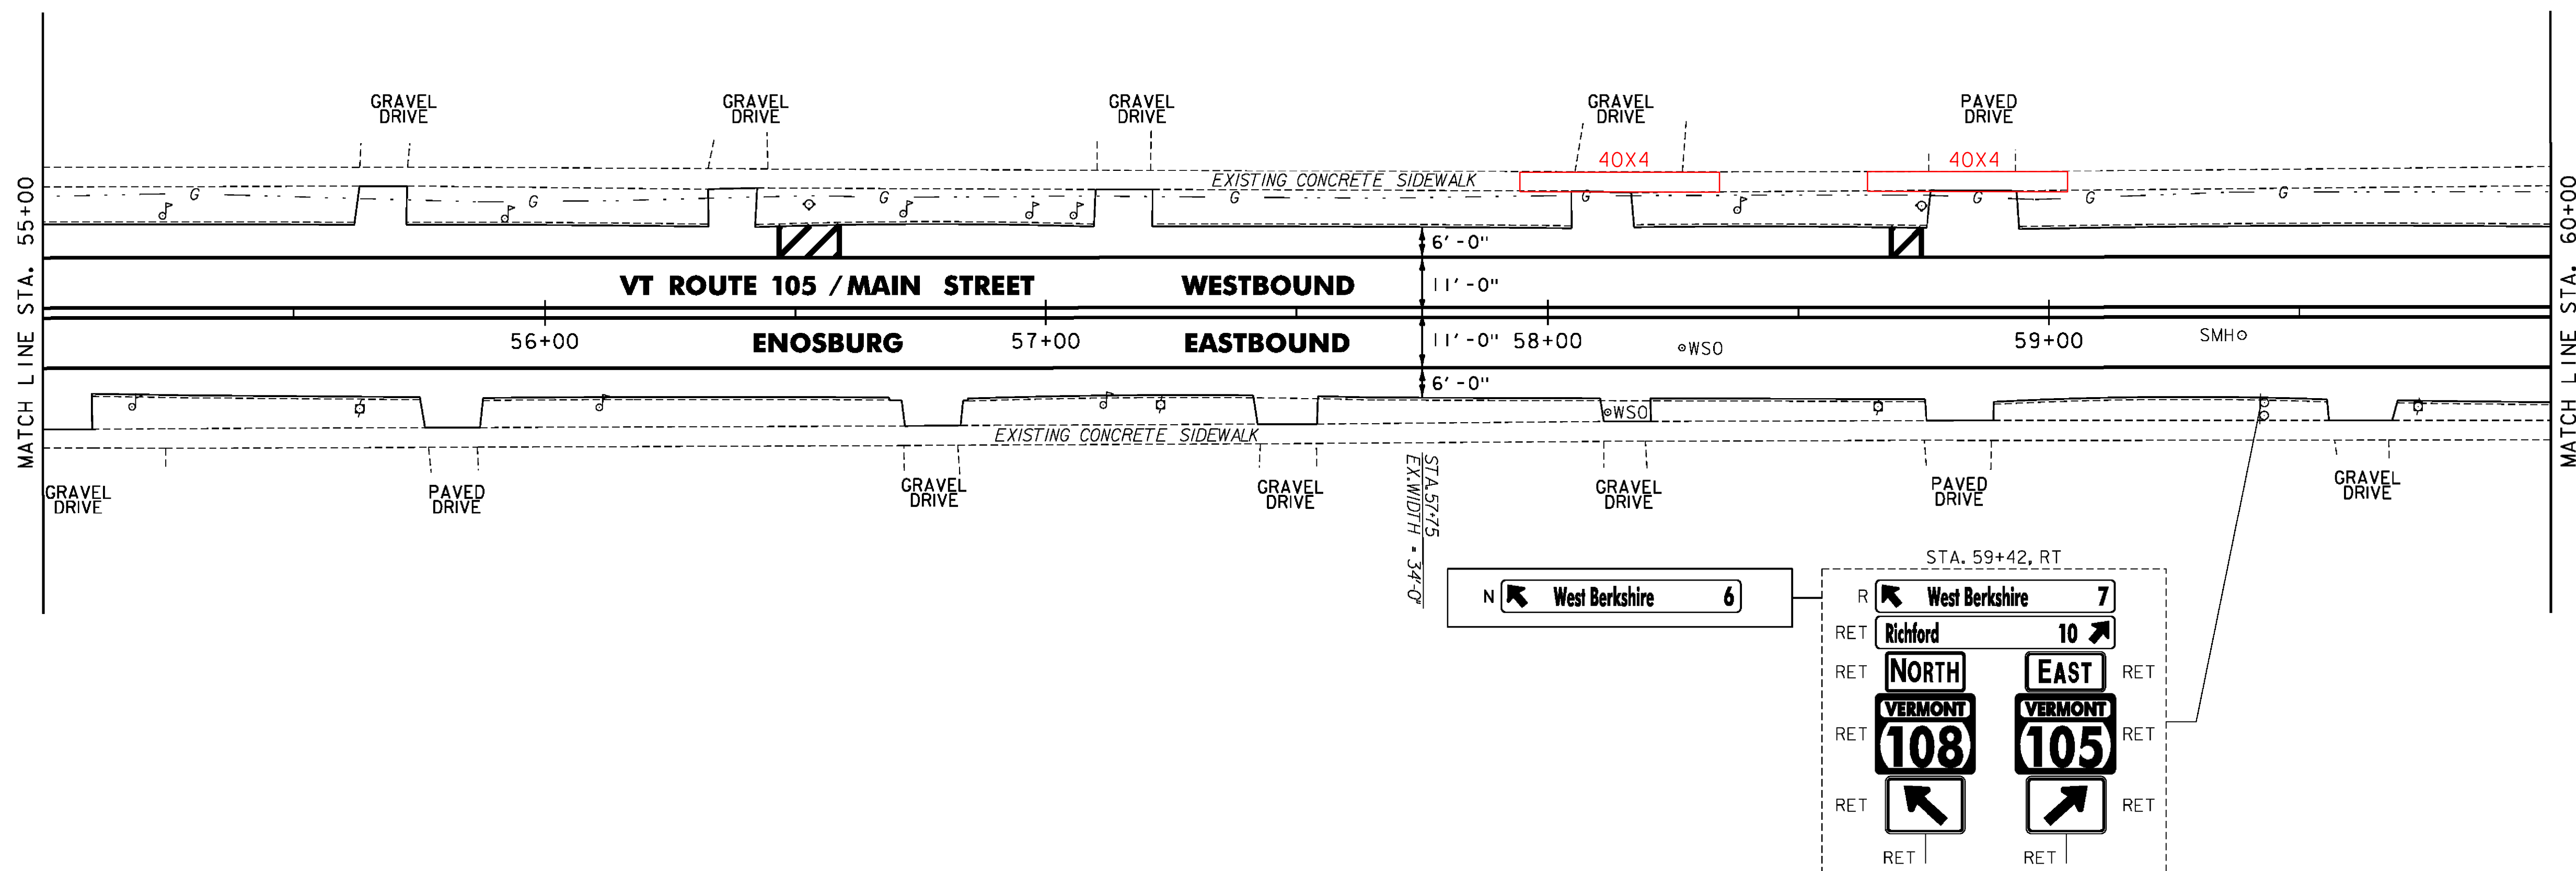

NOTES:

- FOR LEGENDS, SEE SHEET 22.
- ALL EXISTING SIGNS NOT SHOWN SHALL BE RETAINED.

NOT TO SCALE

PROJECT LAYOUT SHEET #7



PROJECT NAME: ENOSBURG-RICHFORD
 PROJECT NUMBER: STP 2939(I)

FILE NAME: p11b312.dgn
 PROJECT LEADER: J. LITTLE
 DESIGNED BY: J. LITTLE
 IPARM FILE: p11b312107.i

PLOT DATE: 3/19/2014
 DRAWN BY: D. DRAPER
 CHECKED BY: J. LITTLE
 SHEET 28 OF 115