

REHAB. DIS. CBS OR MHS, CLASS I OR II
 STA. 249+02, LT
 STA. 249+86, RT

DURABLE & TEMPORARY 4 INCH WHITE LINE
 (ALL LINES WILL INCLUDE EDGE LINE BREAKS
 AND RADIUS FOR SIDE ROADS)
 STA. 245+00 TO 250+00, SOLID LT & RT
 STA. 248+79, SOLID LT (EDGE LINES, DUFFY HILL RD.)


DURABLE & TEMPORARY 4 INCH YELLOW LINE
 (ALL LINES WILL INCLUDE G BREAKS FOR SIDE ROADS)
 STA. 245+00 TO 250+00, SOLID LT & RT
 STA. 248+79, DOUBLE SOLID LT (DUFFY HILL RD.)

DURABLE & TEMPORARY 24 INCH STOP BAR
 STA. 248+79, LT (DUFFY HILL RD.)

DURABLE & TEMPORARY LETTER OR SYMBOL
 STA. 248+79, LT "STOP" (DUFFY HILL RD.)
 STA. 249+80, RT "STOP"


REMOVING SIGNS
 AS SHOWN - 16

ERECTING SALVAGED SIGNS
 AS SHOWN - 1

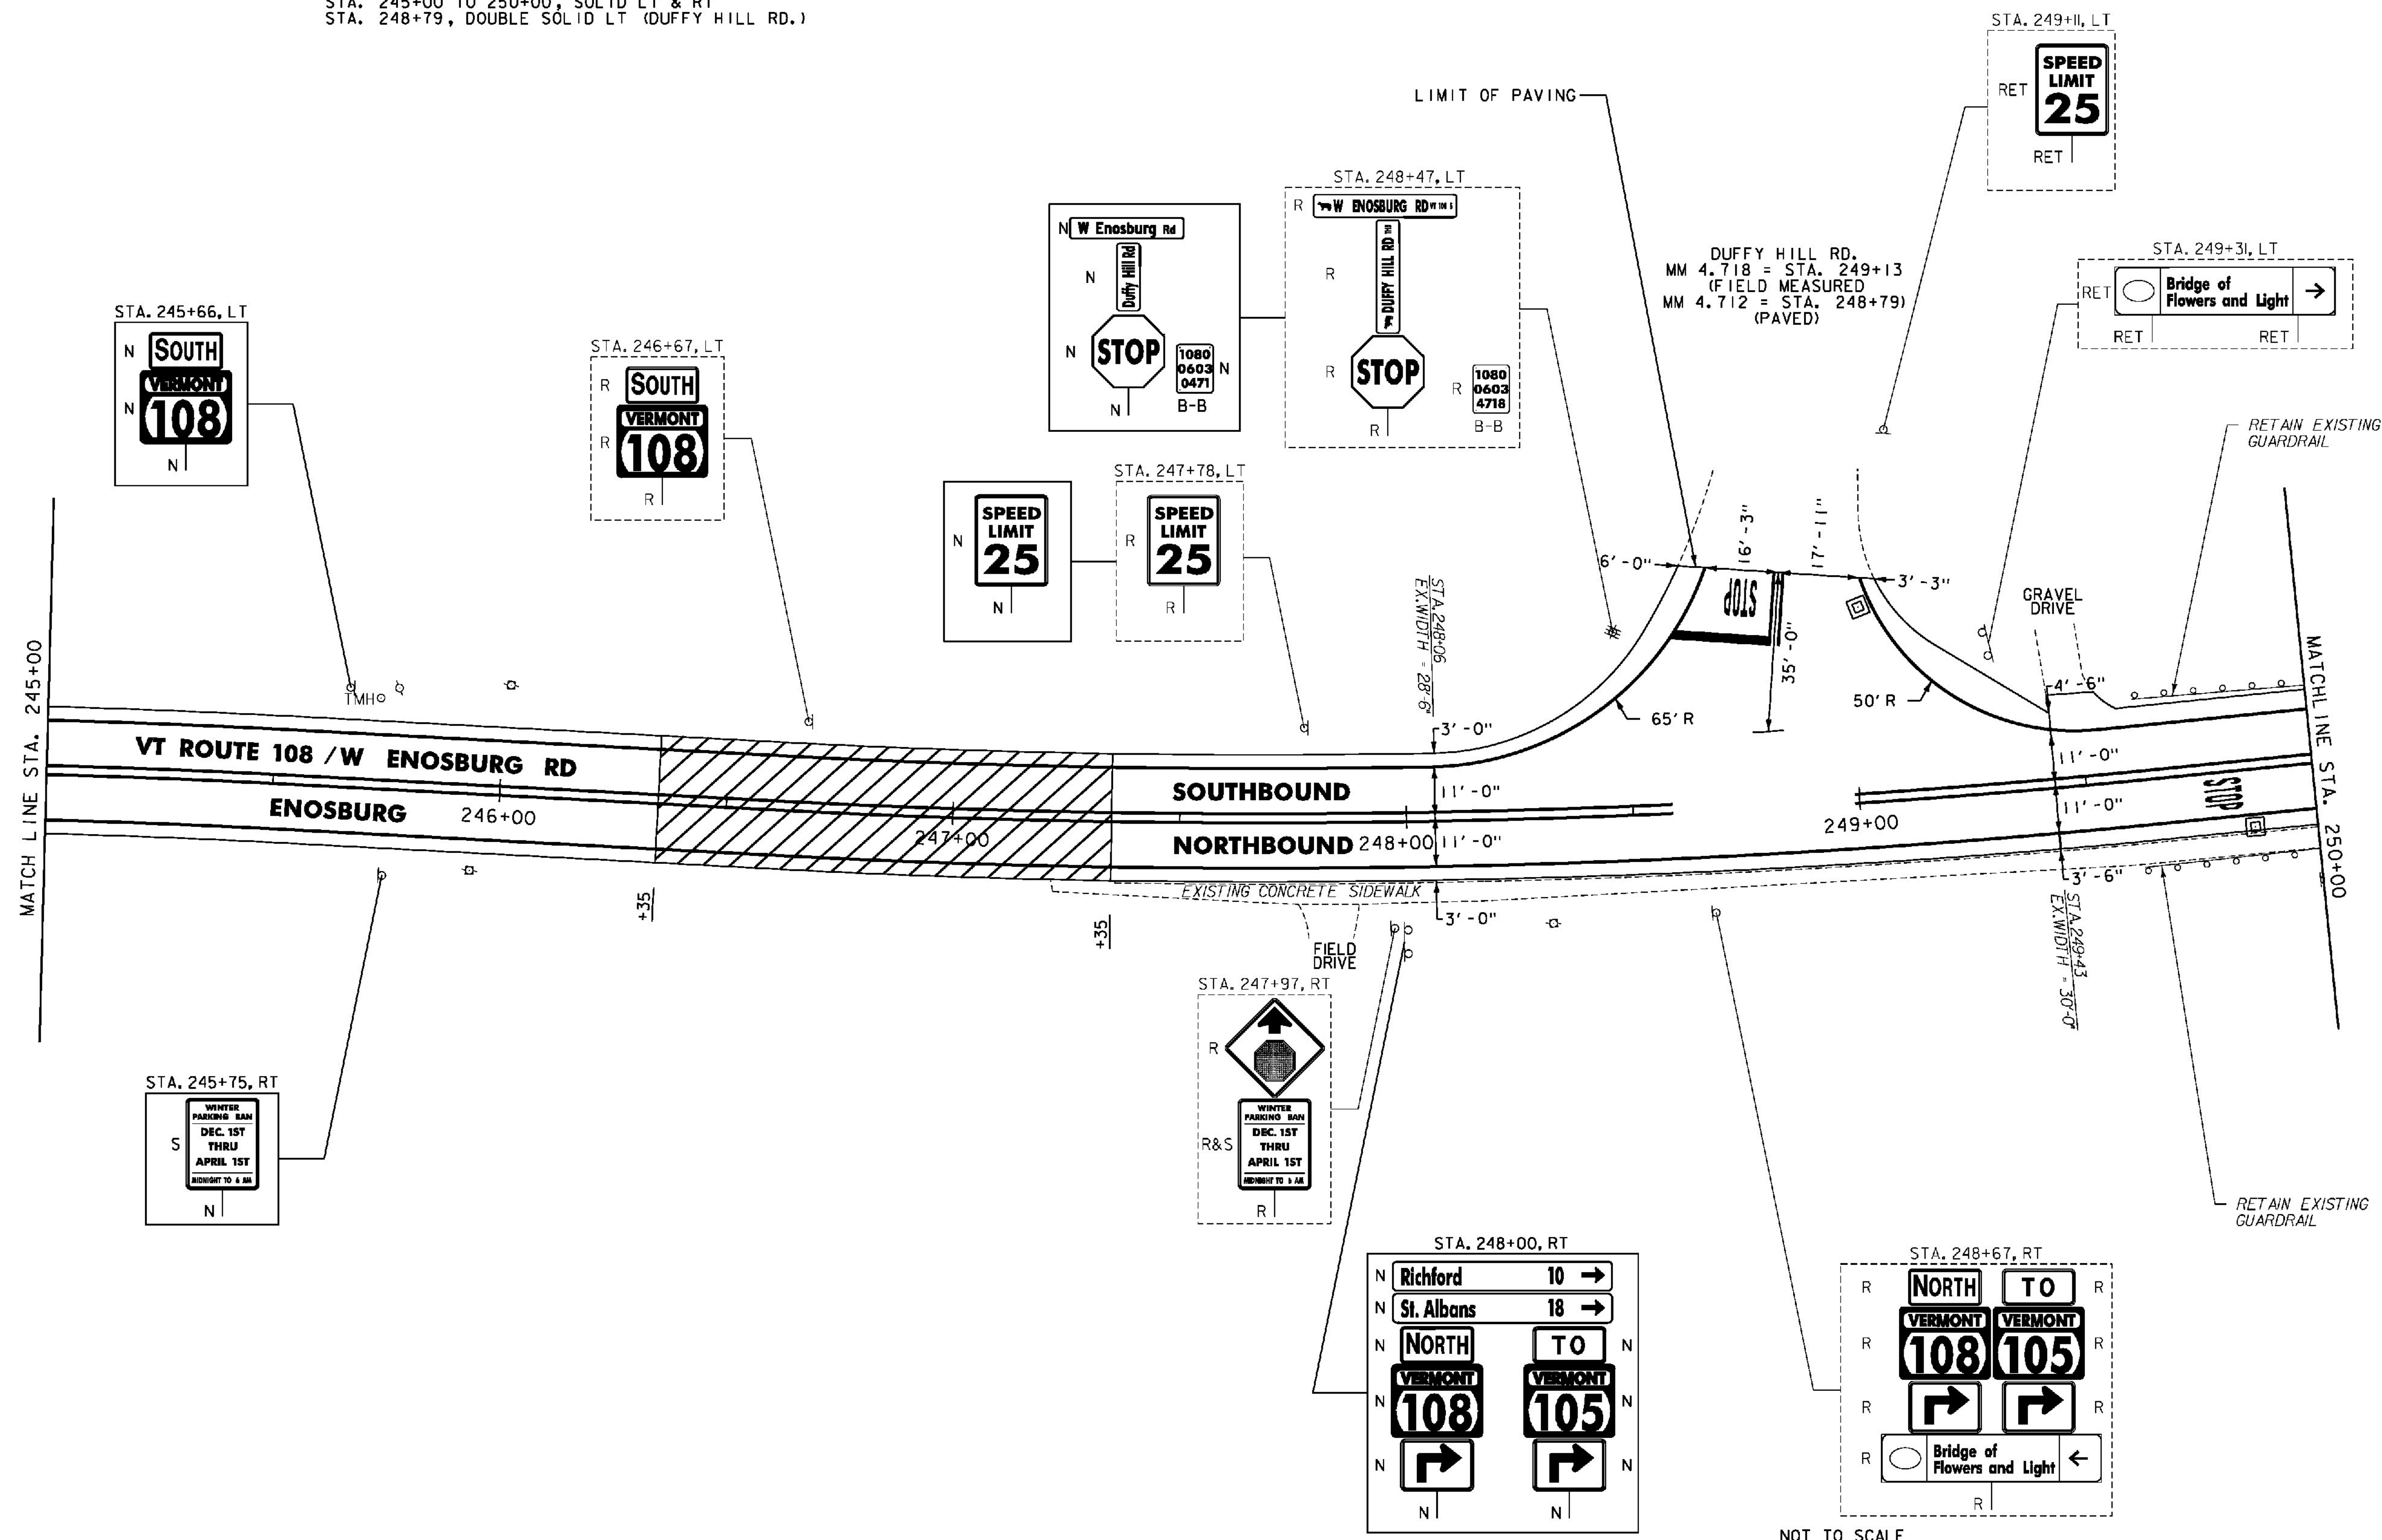

NOTES:

- FOR LEGENDS, SEE SHEET 22.
- ALL EXISTING SIGNS NOT SHOWN SHALL BE RETAINED.

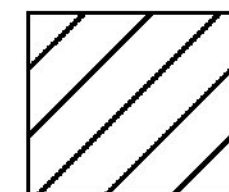

COLD PLANE TRANSITION AREA
 (FOR TYPICAL, SEE SHEET 4)



PROJECT LAYOUT SHEET #14

NOT TO SCALE

PROJECT NAME: ENOSBURG-RICHFORD
 PROJECT NUMBER: STP 2939(I)

FILE NAME: p11b312.dgn
 PROJECT LEADER: J. LITTLE
 DESIGNED BY: J. LITTLE
 IPARM FILE: p11b312114.i

PLOT DATE: 3/19/2014
 DRAWN BY: D. DRAPER
 CHECKED BY: J. LITTLE
 SHEET 35 OF 115