


ADJUST ELEVATION OF VALVE BOX
STA. 282+52, LT

DURABLE & TEMPORARY 4 INCH WHITE LINE
(ALL LINES WILL INCLUDE EDGE LINE BREAKS
AND RADII FOR SIDE ROADS)
STA. 280+00 TO 285+00, SOLID LT & RT

DURABLE & TEMPORARY 4 INCH YELLOW LINE
(ALL LINES WILL INCLUDE C BREAKS FOR SIDE ROADS)
STA. 280+00 TO 285+00, SOLID LT & RT

REMOVING SIGNS
AS SHOWN - 3

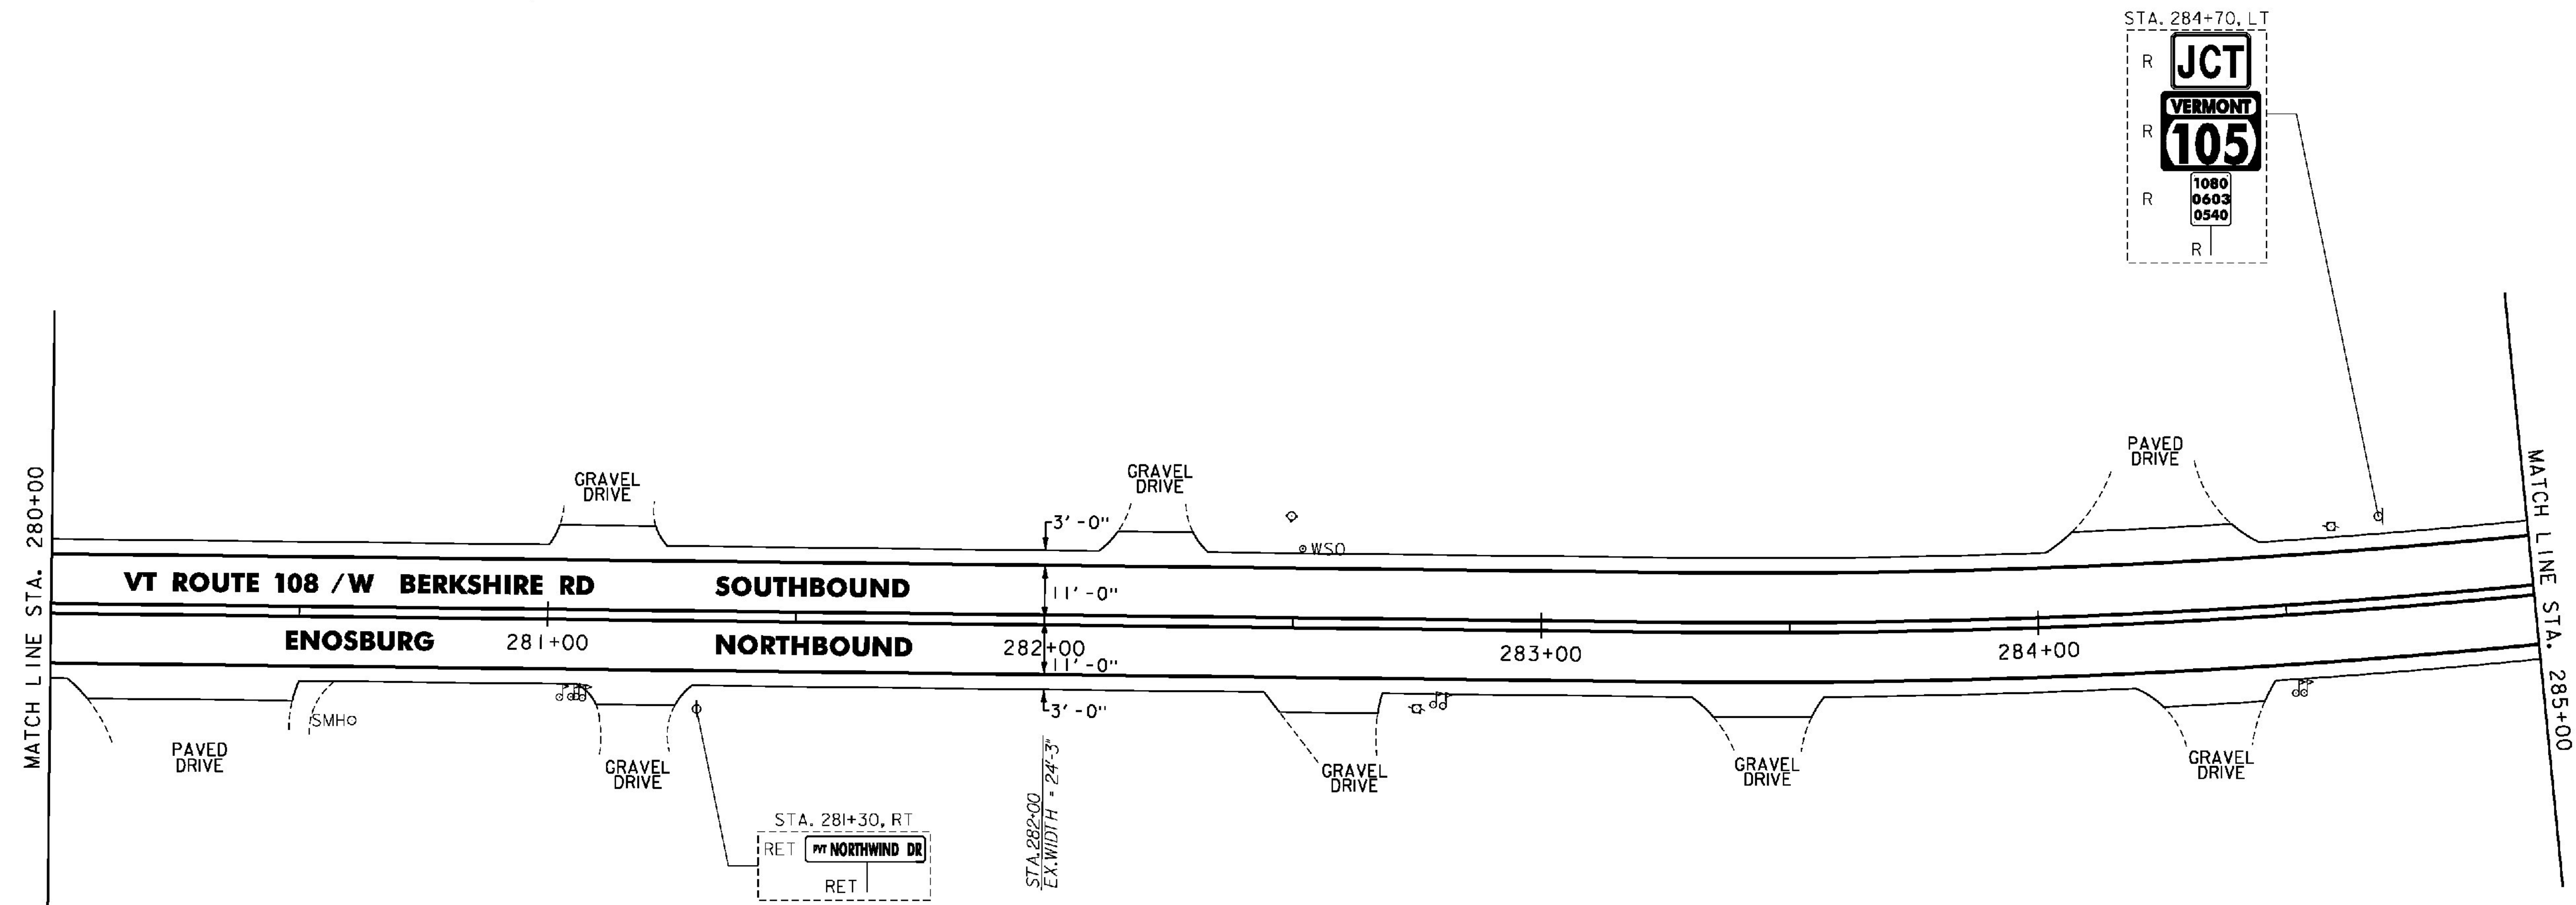

CHANGING ELEVATION OF DIS, CBS OR MHS
STA. 288+30, RT

CHANGING ELEVATION OF SEWER MANHOLES
STA. 285+31, RT


STA. 286+60, LT

DURABLE & TEMPORARY 4 INCH WHITE LINE
(ALL LINES WILL INCLUDE EDGE LINE BREAKS
AND RADII FOR SIDE ROADS)
STA. 285+00 TO 290+00, SOLID LT & RT

DURABLE & TEMPORARY 4 INCH YELLOW LINE
(ALL LINES WILL INCLUDE C BREAKS FOR SIDE ROADS)
STA. 285+00 TO 290+00, SOLID LT & RT

REMOVING SIGNS
AS SHOWN - 6

ERECTING SALVAGED SIGNS
AS SHOWN - 1

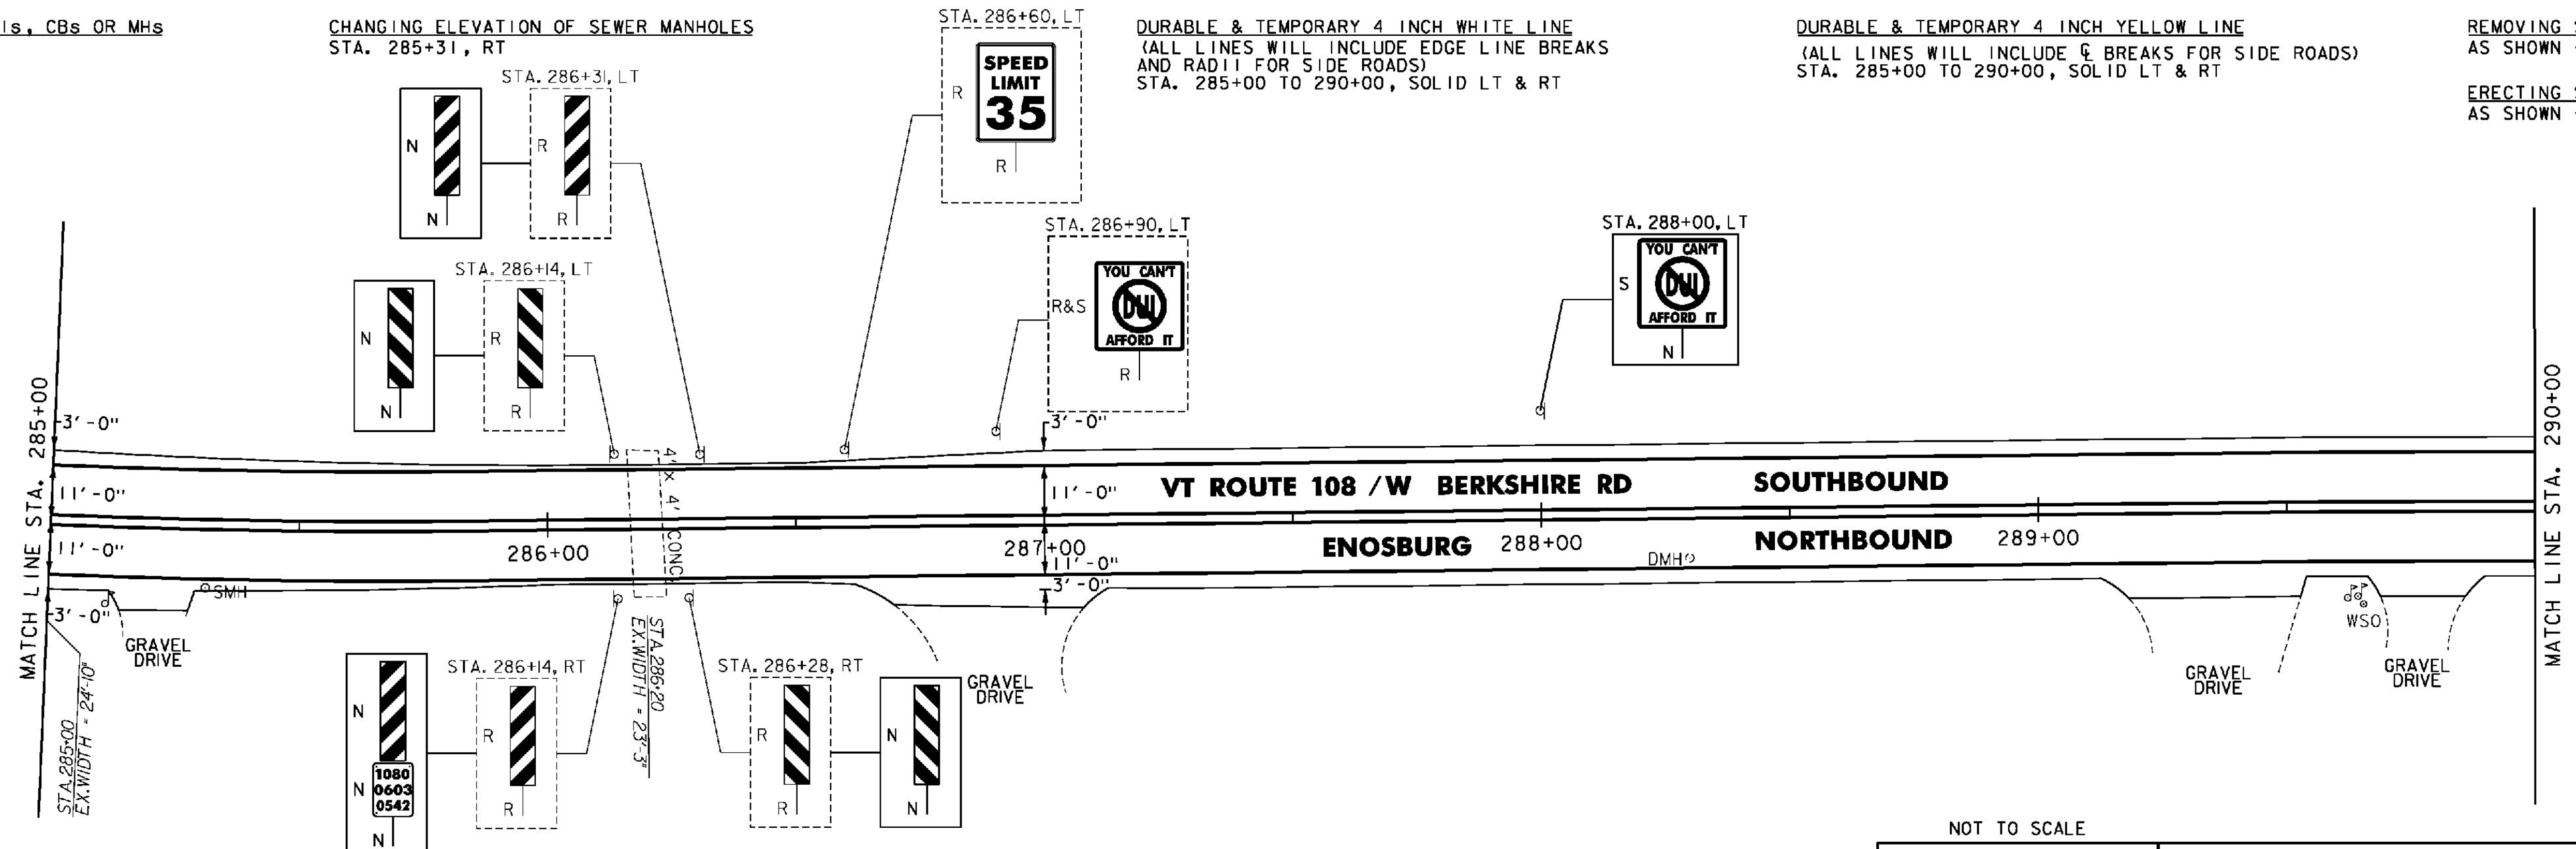

NOTES:

- FOR LEGENDS, SEE SHEET 22.
- ALL EXISTING SIGNS NOT SHOWN SHALL BE RETAINED.



NOT TO SCALE

PROJECT LAYOUT SHEET #19

PROJECT NAME: ENOSBURG-RICHFORD

PROJECT NUMBER: STP 2939(I)

FILE NAME: p11b312.dgn

PROJECT LEADER: J. LITTLE

DESIGNED BY: J. LITTLE

IPARM FILE: p11b312119.i

PLOT DATE: 3/19/2014

DRAWN BY: D. DRAPER

CHECKED BY: J. LITTLE

SHEET 40 OF 115