


DURABLE & TEMPORARY 4 INCH WHITE LINE
 (ALL LINES WILL INCLUDE EDGE LINE BREAKS
 AND RADII FOR SIDE ROADS)
 STA. 300+00 TO 304+00, SOLID LT & RT

DURABLE & TEMPORARY 4 INCH YELLOW LINE
 (ALL LINES WILL INCLUDE ϕ BREAKS FOR SIDE ROADS)
 STA. 300+00 TO 304+00, SOLID LT & RT

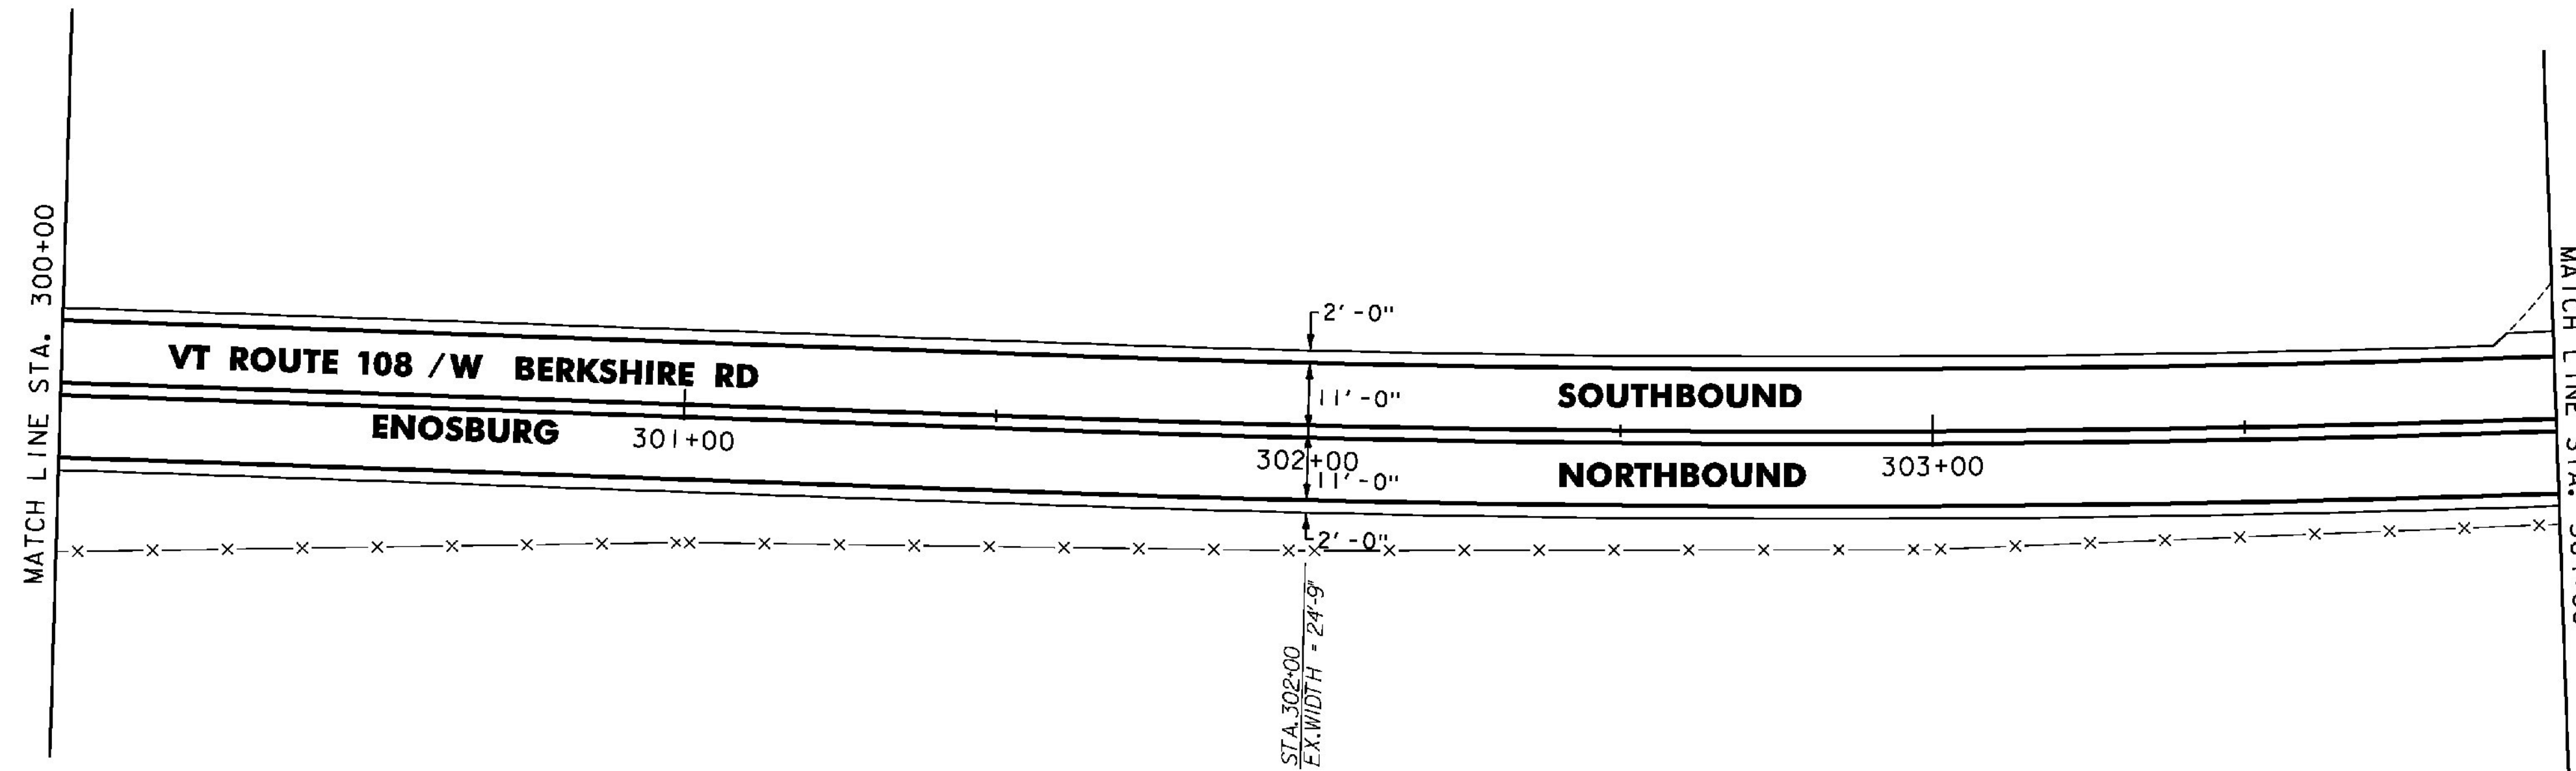


RELOCATE MAILBOX, SINGLE SUPPORT
 STA. 307+59, RT

DURABLE & TEMPORARY 4 INCH WHITE LINE
 (ALL LINES WILL INCLUDE EDGE LINE BREAKS
 AND RADII FOR SIDE ROADS)
 STA. 304+00 TO 308+00, SOLID LT & RT

DURABLE & TEMPORARY 4 INCH YELLOW LINE
 (ALL LINES WILL INCLUDE ϕ BREAKS FOR SIDE ROADS)
 STA. 304+00 TO 308+00, SOLID LT & RT

REMOVING SIGNS
 AS SHOWN - 1

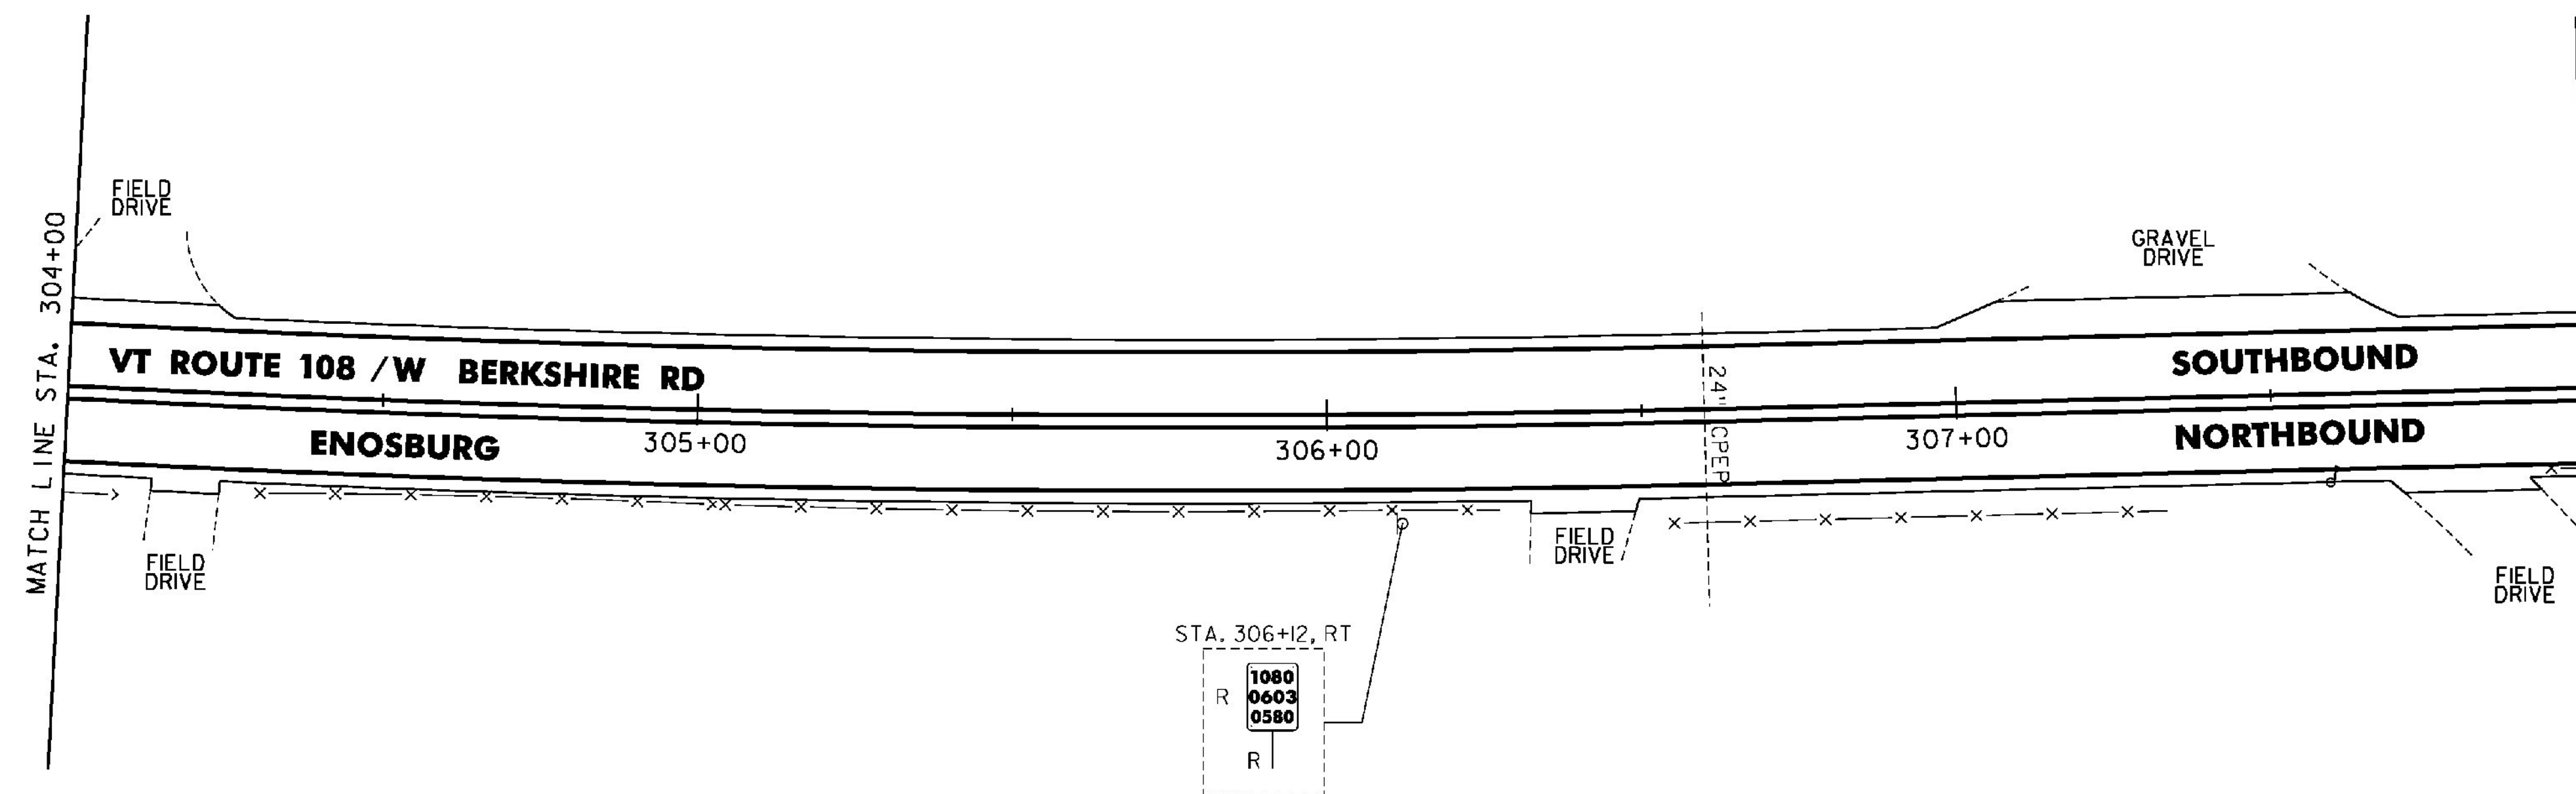

NOTES:

- FOR LEGENDS, SEE SHEET 22.
- ALL EXISTING SIGNS NOT SHOWN SHALL BE RETAINED.



NOT TO SCALE

PROJECT LAYOUT SHEET #21

PROJECT NAME: ENOSBURG-RICHFORD
 PROJECT NUMBER: STP 2939(I)

FILE NAME: p11b312.dgn
 PROJECT LEADER: J. LITTLE
 DESIGNED BY: J. LITTLE
 IPARM FILE: p11b312121.i

PLOT DATE: 3/19/2014
 DRAWN BY: D. DRAPER
 CHECKED BY: J. LITTLE
 SHEET 42 OF 115