

REHAB. DIS. CBs OR MHs. CLASS I OR II

- STA. 10+34, LT
- STA. 10+46, LT
- STA. 10+70, LT
- STA. 11+92, RT
- STA. 11+93, LT
- STA. 13+01, RT
- STA. 13+02, LT
- STA. 13+45, RT
- STA. 13+45, LT

CHANGING ELEVATION OF SEWER MANHOLES

- STA. 10+15, RT
- STA. 10+87, RT
- STA. 11+58, LT

CAST-IN-PLACE CONCRETE CURB, TYPE B

- STA. 10+74, LT

REMOVAL OF EXISTING CURB

- STA. 10+74, LT

PORTLAND CEMENT CONCRETE SIDEWALK, 5 INCH

- STA. 10+74, LT
- STA. 11+48, RT
- STA. 11+48, LT

DETECTABLE WARNING SURFACE

- STA. 10+74, LT
- STA. 11+48, RT
- STA. 11+48, LT

ADJUST ELEVATION OF VALVE BOX

- STA. 10+48, LT
- STA. 10+50, LT
- STA. 10+67, LT
- STA. 10+67, RT
- STA. 11+03, RT
- STA. 11+41, LT
- STA. 12+99, LT
- STA. 13+01, LT
- STA. 13+03, LT

DURABLE & TEMPORARY 4 INCH WHITE LINE

(ALL LINES WILL INCLUDE EDGE LINE BREAKS AND RADI FOR SIDE ROADS)
 STA. 10+00 TO 14+00, SOLID LT & RT
 STA. 10+00 TO 14+00, SOLID LT & RT (PARKING SPACES & DIAGONALS) SEE SHEET 19 (TYP.)

DURABLE & TEMPORARY 4 INCH YELLOW LINE

(ALL LINES WILL INCLUDE 1/2" BREAKS FOR SIDE ROADS)
 STA. 10+00 TO 14+00, SOLID LT & RT
 STA. 10+51, DOUBLE SOLID LT (POWELL ST. TH-65)

DURABLE & TEMPORARY 24 INCH STOP BAR

STA. 10+51, LT (POWELL ST. TH-65)

DURABLE & TEMPORARY LETTER OR SYMBOL

STA. 10+51, LT "STOP" (POWELL ST. TH-65)
 STA. 11+82, RT HANDICAP SYMBOL
 STA. 12+80, RT "STOP"
 STA. 13+20, RT "AHEAD"


DURABLE & TEMPORARY CROSSWALK MARKING

STA. 10+51, LT (POWELL ST. TH-65)
 STA. 11+48, LT TO RT
 SEE SHEET 19 (TYP.)
 STA. 11+51 TO 11+83, LT

PAINTED CURB

STA. 10+34 TO 10+43, RT
 STA. 10+74 TO 10+94, LT
 STA. 11+17 TO 11+37, LT
 STA. 11+96 TO 13+25, LT
 STA. 13+00 TO 13+27, RT

REMOVING SIGNS AS SHOWN - 5

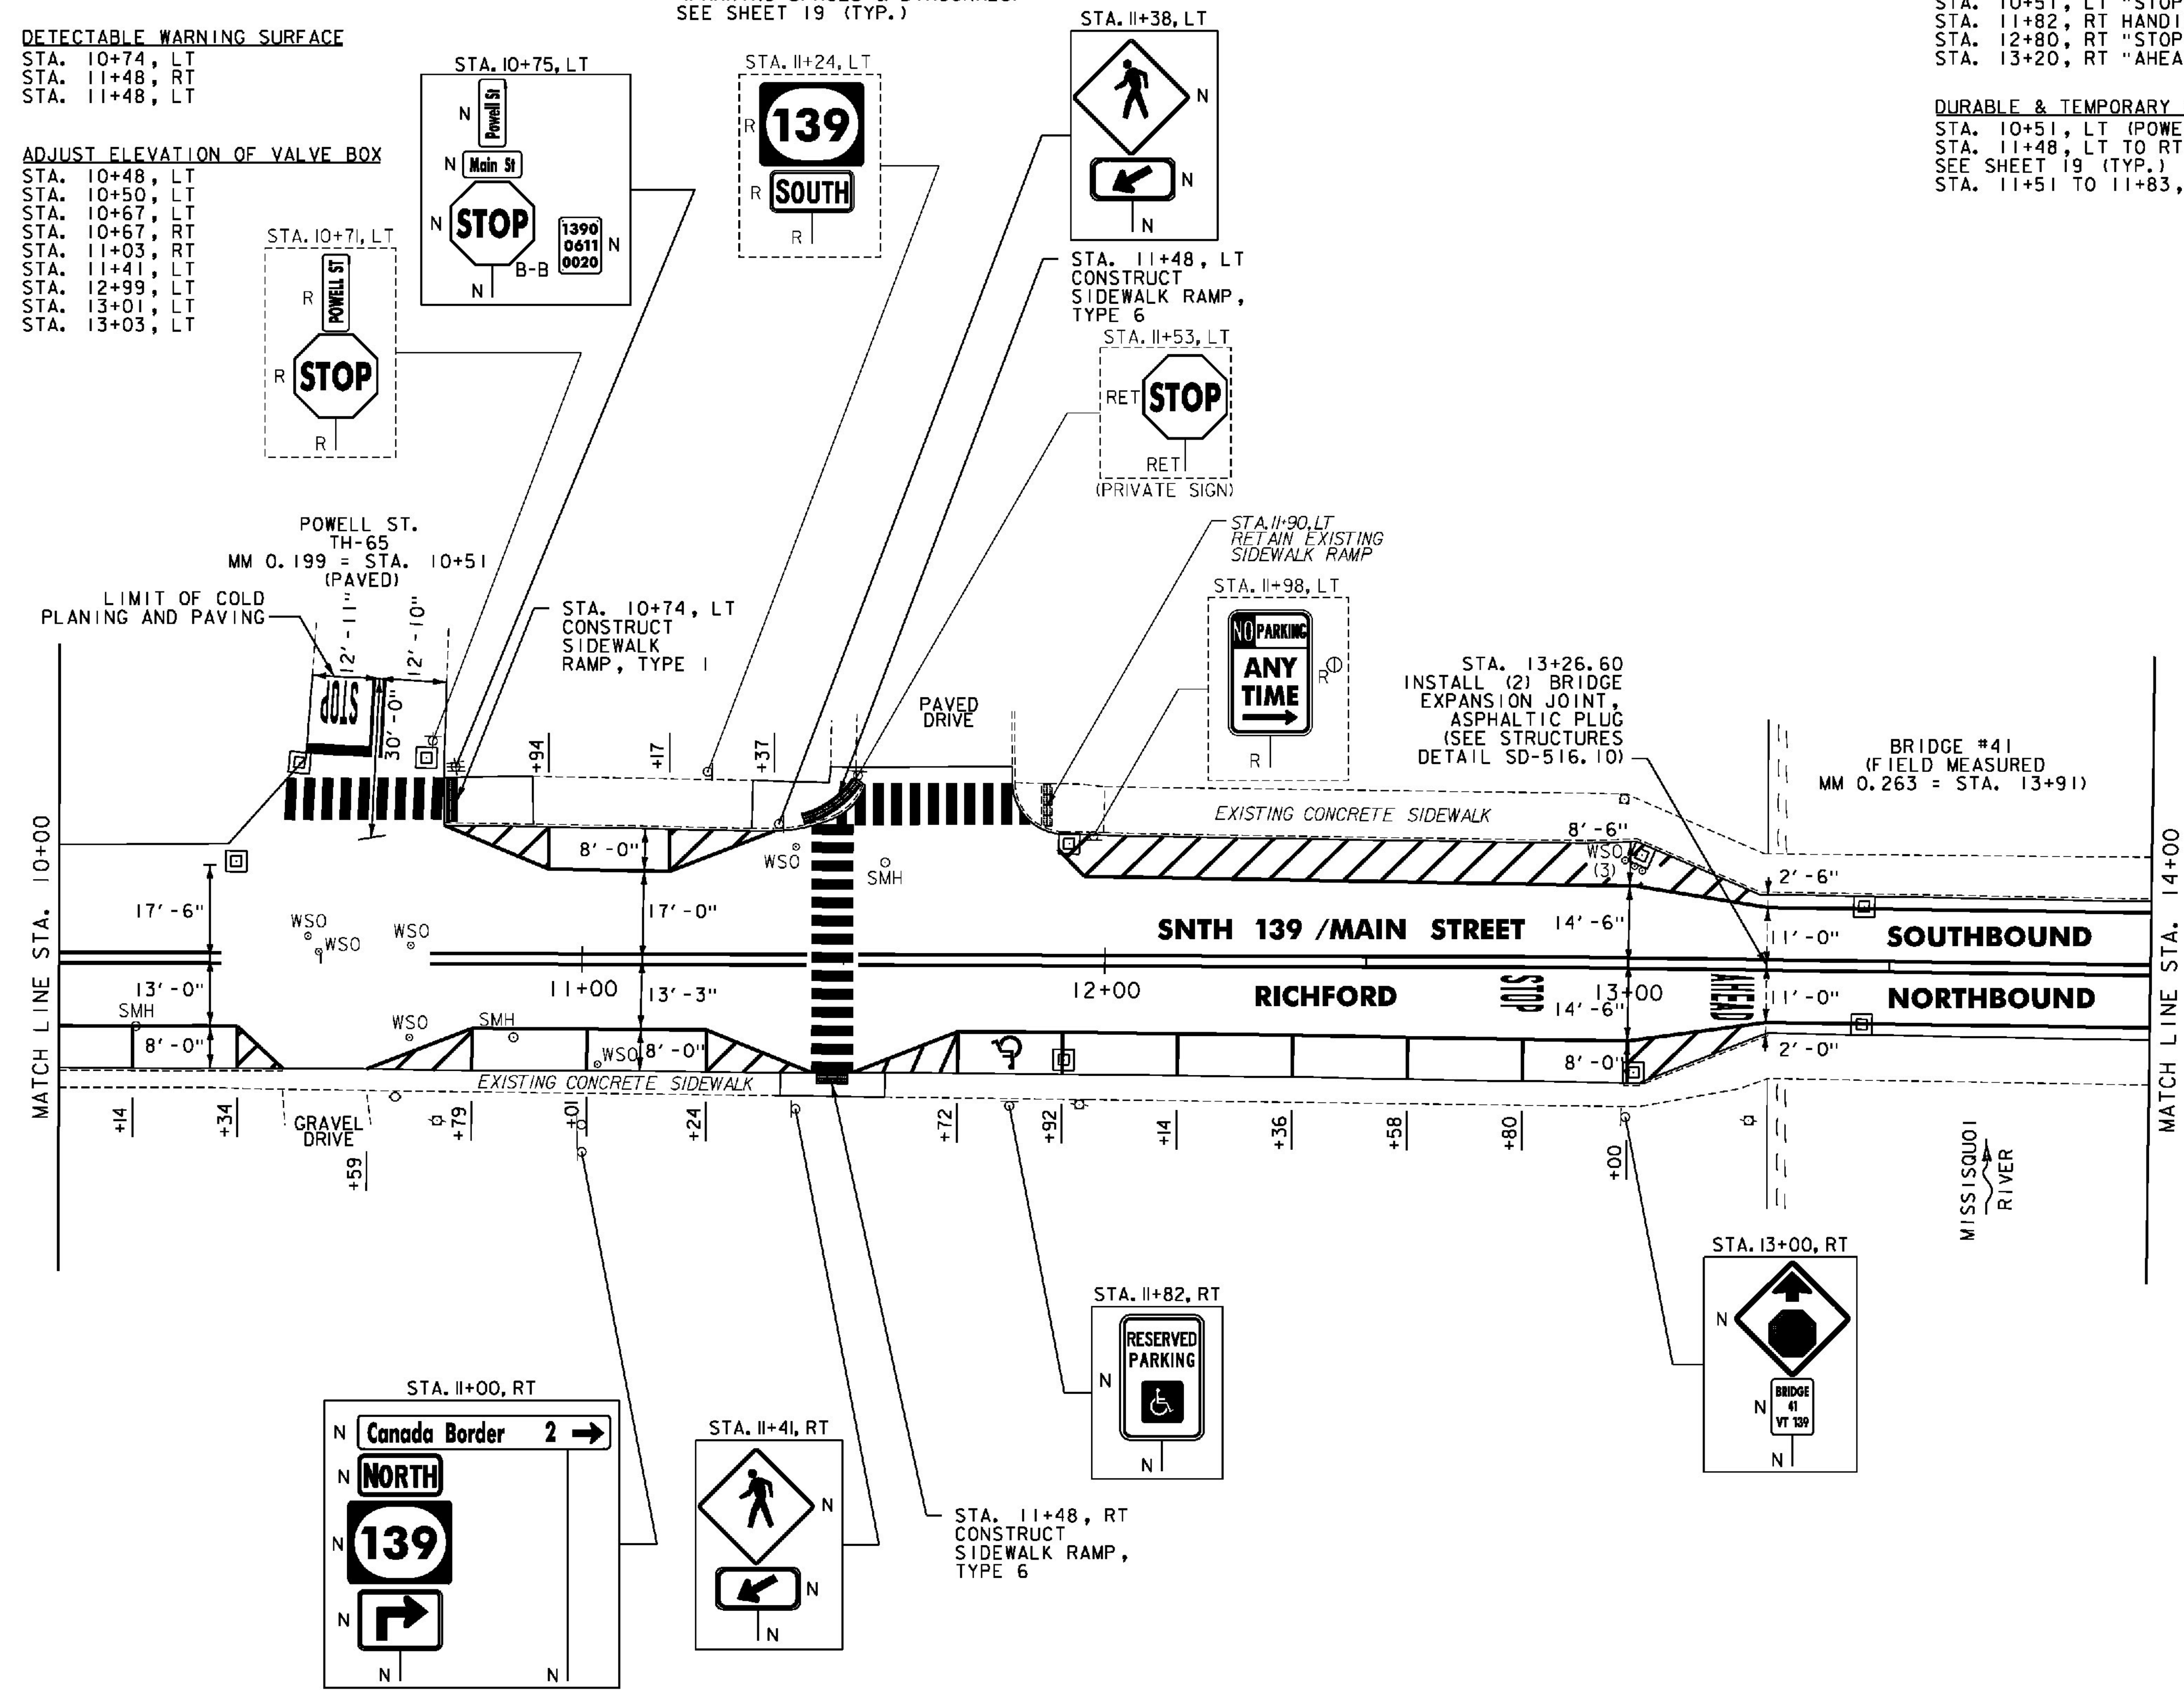

- NOTES:
1. FOR LEGENDS, SEE SHEET 22.
 2. ALL EXISTING SIGNS NOT SHOWN SHALL BE RETAINED.



NOT TO SCALE

PROJECT LAYOUT SHEET #36

PROJECT NAME: ENOSBURG-RICHFORD	PLOT DATE: 3/19/2014
PROJECT NUMBER: STP 2939(I)	DRAWN BY: D. DRAPER
FILE NAME: p11b312.dgn	CHECKED BY: J. LITTLE
PROJECT LEADER: J. LITTLE	SHEET 57 OF 115
DESIGNED BY: J. LITTLE	
IPARM FILE: p11b312136.i	