

REHAB. DIS. CBS OR MHS. CLASS I OR II
 STA. 37+51, RT
 STA. 38+60, RT
 STA. 40+21, RT

CHANGING ELEVATION OF SEWER MANHOLES
 STA. 38+02, LT (MH UNKNOWN)
 STA. 41+16, LT


ADJUST ELEVATION OF VALVE BOX
 STA. 39+91, RT

DURABLE & TEMPORARY 4 INCH WHITE LINE
 (ALL LINES WILL INCLUDE EDGE LINE BREAKS
 AND RADII FOR SIDE ROADS)
 STA. 37+00 TO 42+00, SOLID LT & RT

DURABLE & TEMPORARY 4 INCH YELLOW LINE
 (ALL LINES WILL INCLUDE ϵ BREAKS FOR SIDE ROADS)
 STA. 37+00 TO 42+00, SOLID LT & RT

DURABLE & TEMPORARY 8 INCH WHITE LINE
 STA. 39+86 TO 39+98, RT (HYDRANT)
 SEE SHEET 19

REMOVING SIGNS
 AS SHOWN - 1

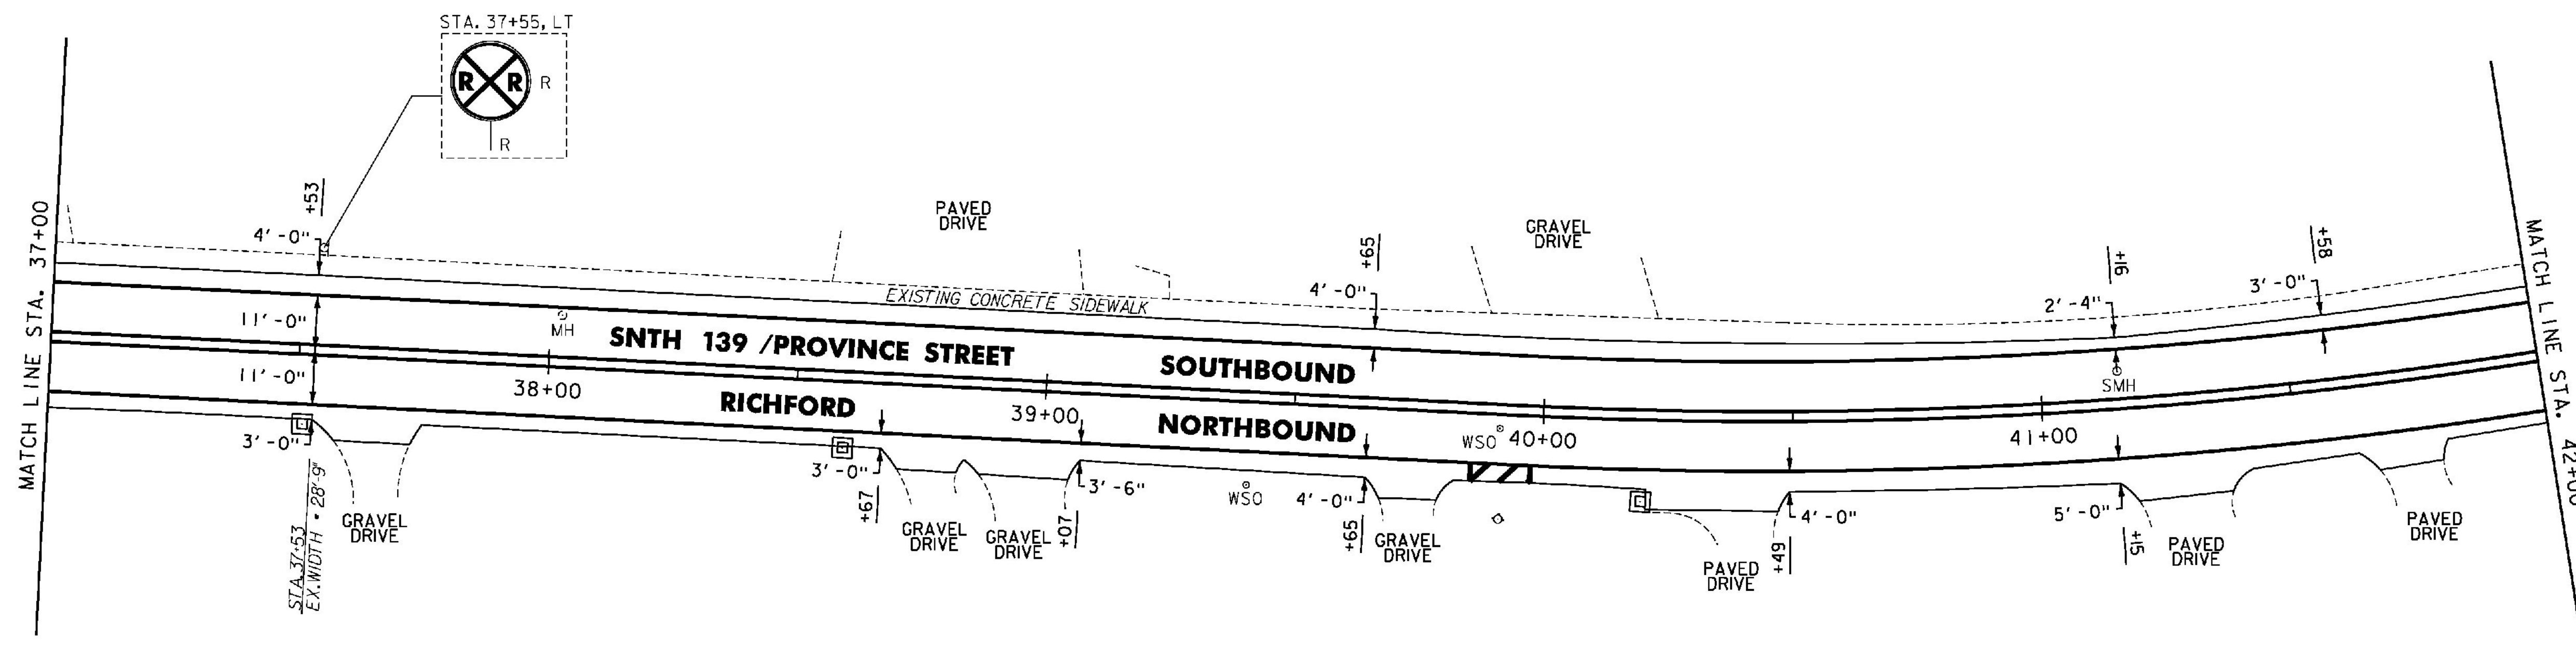

NOTES:

- FOR LEGENDS, SEE SHEET 22.
- ALL EXISTING SIGNS NOT SHOWN SHALL BE RETAINED.



NOT TO SCALE

PROJECT LAYOUT SHEET #42

PROJECT NAME: ENOSBURG-RICHFORD
 PROJECT NUMBER: STP 2939(I)

FILE NAME: p11b312.dgn
 PROJECT LEADER: J. LITTLE
 DESIGNED BY: J. LITTLE
 IPARM FILE: p11b312142.i

PLOT DATE: 3/19/2014
 DRAWN BY: D. DRAPER
 CHECKED BY: J. LITTLE
 SHEET 63 OF 115