

CHANGING ELEVATION OF SEWER MANHOLES

STA. 48+65, LT (MH UNKNOWN)
STA. 51+42, LT

ADJUST ELEVATION OF VALVE BOX

STA. 47+08, RT
STA. 48+04, RT
STA. 48+10, RT
STA. 48+12, RT

DURABLE & TEMPORARY 4 INCH WHITE LINE

(ALL LINES WILL INCLUDE EDGE LINE BREAKS AND RADII FOR SIDE ROADS)
STA. 47+00 TO 52+00, SOLID LT & RT
STA. 48+10, SOLID RT (EDGELINES, GOLF COURSE RD. TH-7)

DURABLE & TEMPORARY 4 INCH YELLOW LINE

(ALL LINES WILL INCLUDE C BREAKS FOR SIDE ROADS)
STA. 47+00 TO 52+00, SOLID LT & RT
STA. 48+10, DOUBLE SOLID RT (GOLF COURSE RD. TH-7)

DURABLE & TEMPORARY 24 INCH STOP BAR


STA. 48+10, RT (GOLF COURSE RD. TH-7)

DURABLE & TEMPORARY LETTER OR SYMBOL

STA. 48+10, RT "STOP" (GOLF COURSE RD. TH-7)

REMOVING SIGNS

AS SHOWN - 3

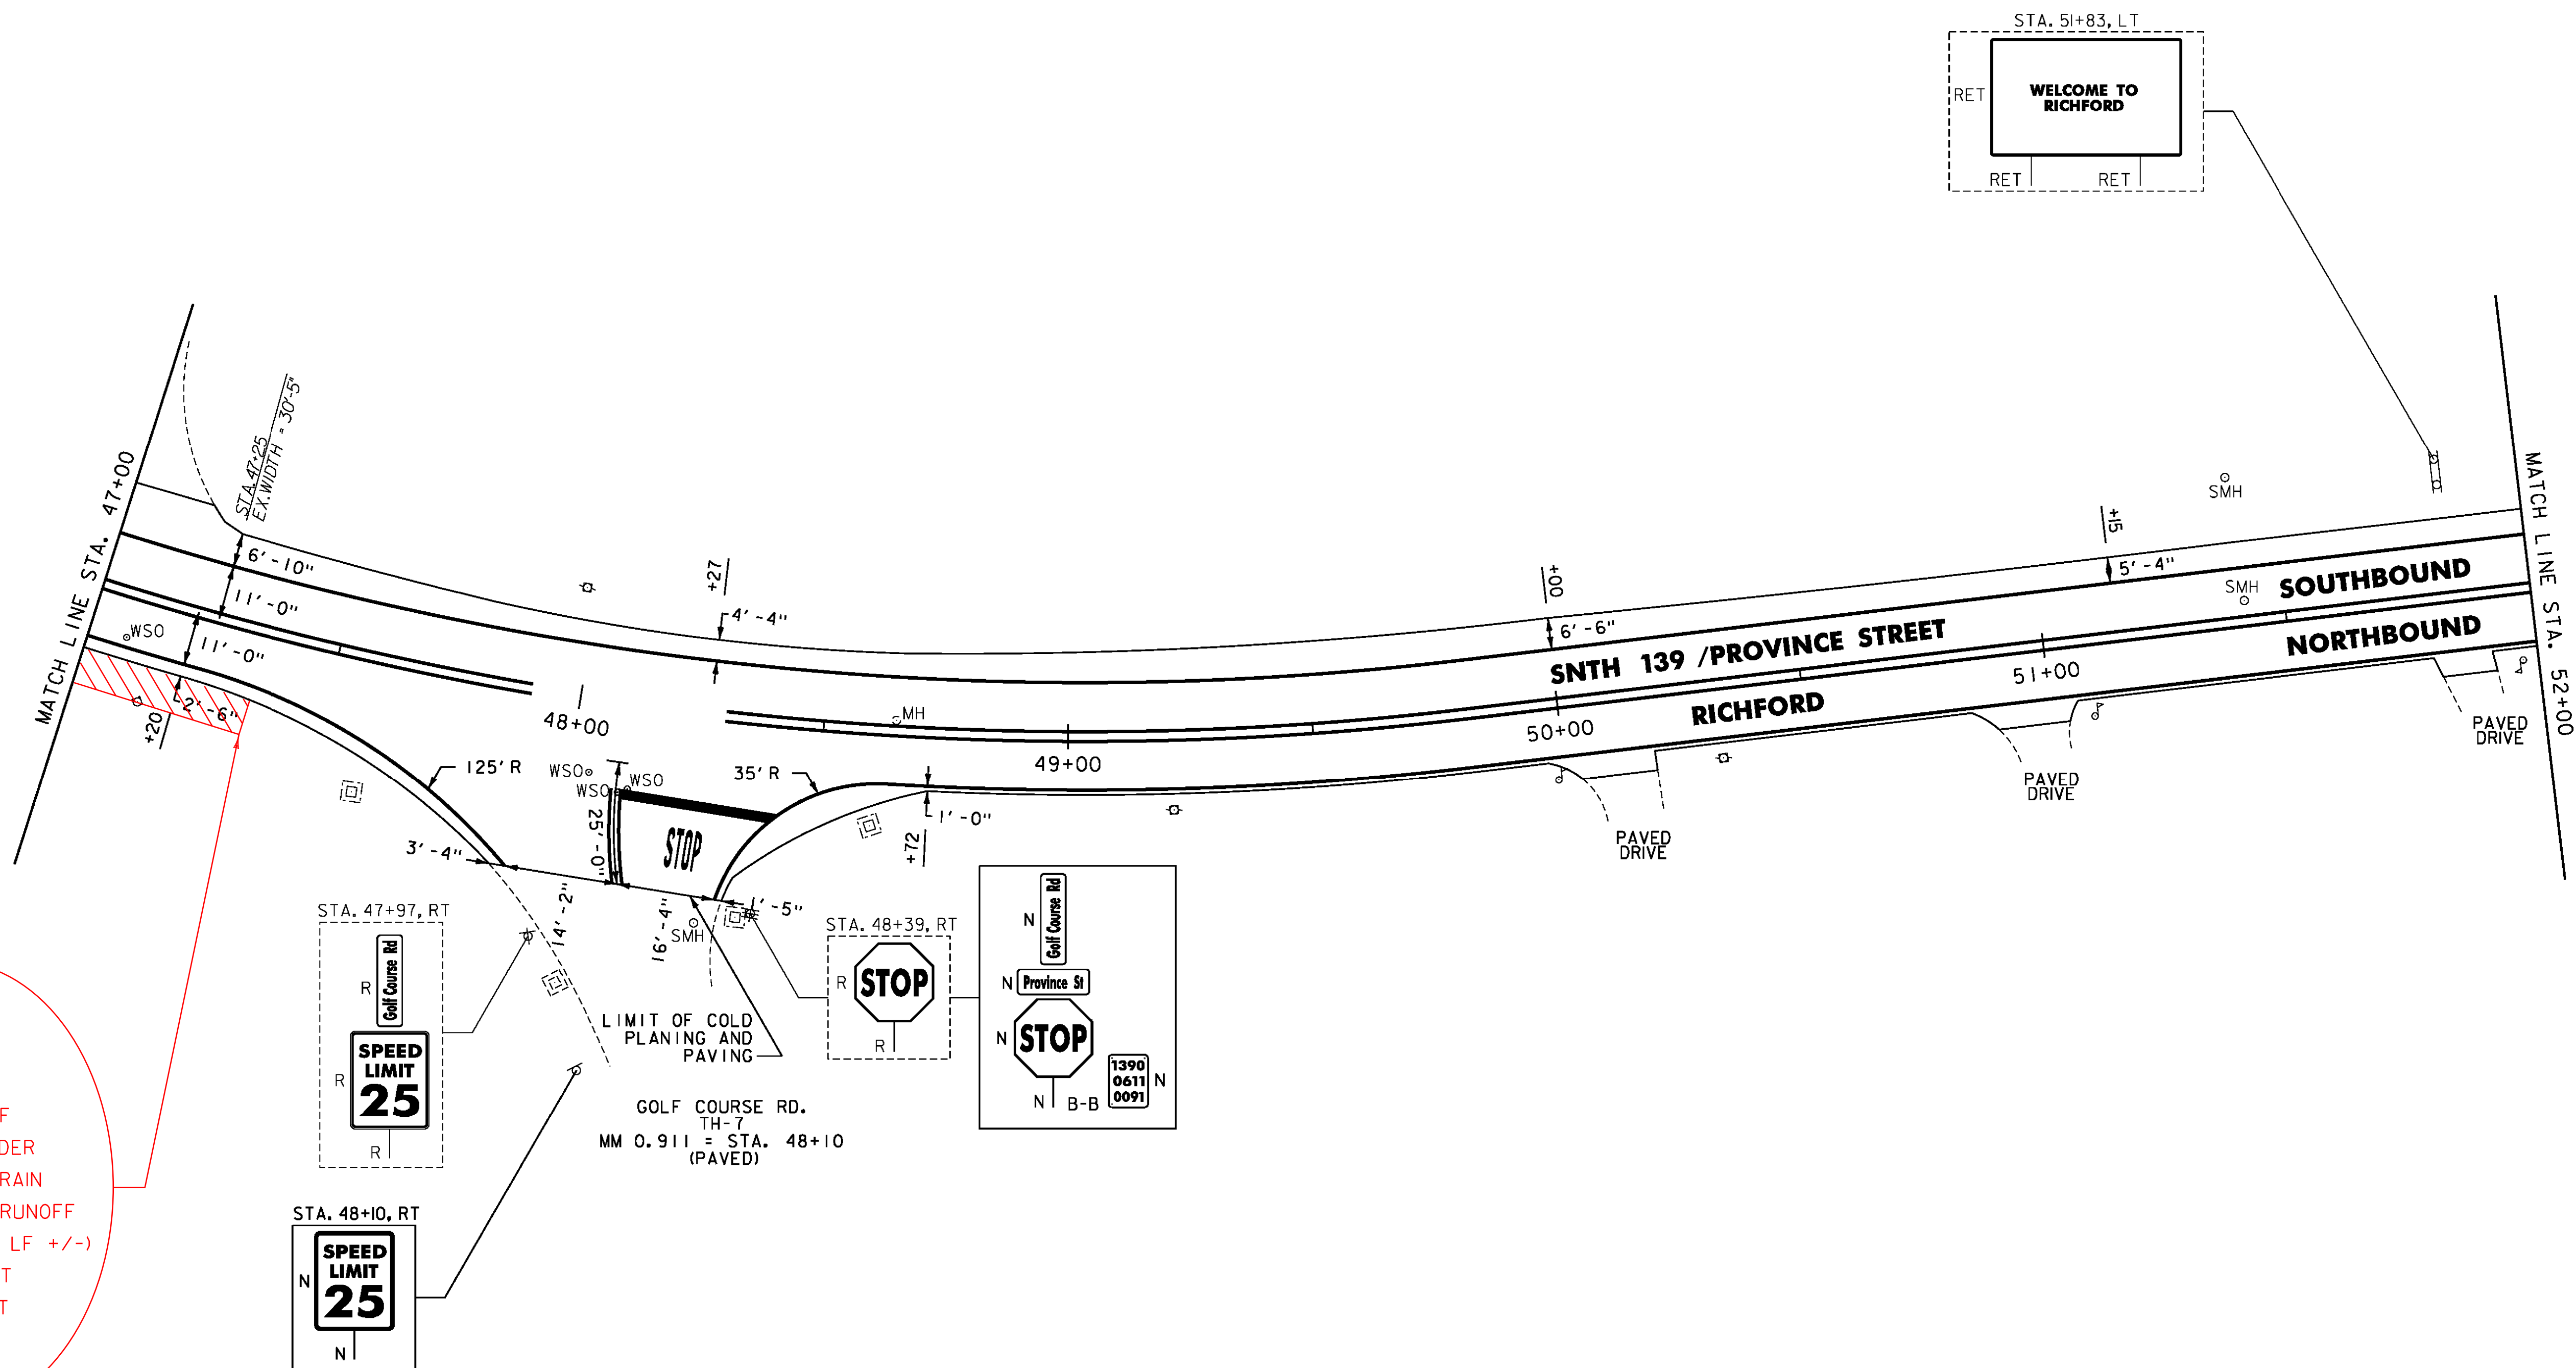

COD/SA NO. 3
EXTRA WORK
DITCHED 35 LF
ALONG SHOULDER
TO BETTER DRAIN
SHEET FLOW RUNOFF
(6.6 FT X 35 LF +/-)
STA 47+00 RT
STA 47+35 RT

- NOTES:
- FOR LEGENDS, SEE SHEET 22.
 - ALL EXISTING SIGNS NOT SHOWN SHALL BE RETAINED.

NOT TO SCALE



PROJECT LAYOUT SHEET #44	PROJECT NAME: ENOSBURG-RICHFORD PROJECT NUMBER: STP 2939(I)
	FILE NAME: p11b312.dgn PROJECT LEADER: J. LITTLE DESIGNED BY: J. LITTLE IPARM FILE: p11b312i44.i
	PLOT DATE: 3/19/2014 DRAWN BY: D. DRAPER CHECKED BY: J. LITTLE SHEET 65 OF 115