


DURABLE & TEMPORARY 4 INCH WHITE LINE  
 (ALL LINES WILL INCLUDE EDGE LINE BREAKS  
 AND RADII FOR SIDE ROADS)  
 STA. 57+00 TO 62+00, SOLID LT & RT


DURABLE & TEMPORARY 4 INCH YELLOW LINE  
 (ALL LINES WILL INCLUDE C BREAKS FOR SIDE ROADS)  
 STA. 57+00 TO 62+00, SOLID LT & RT

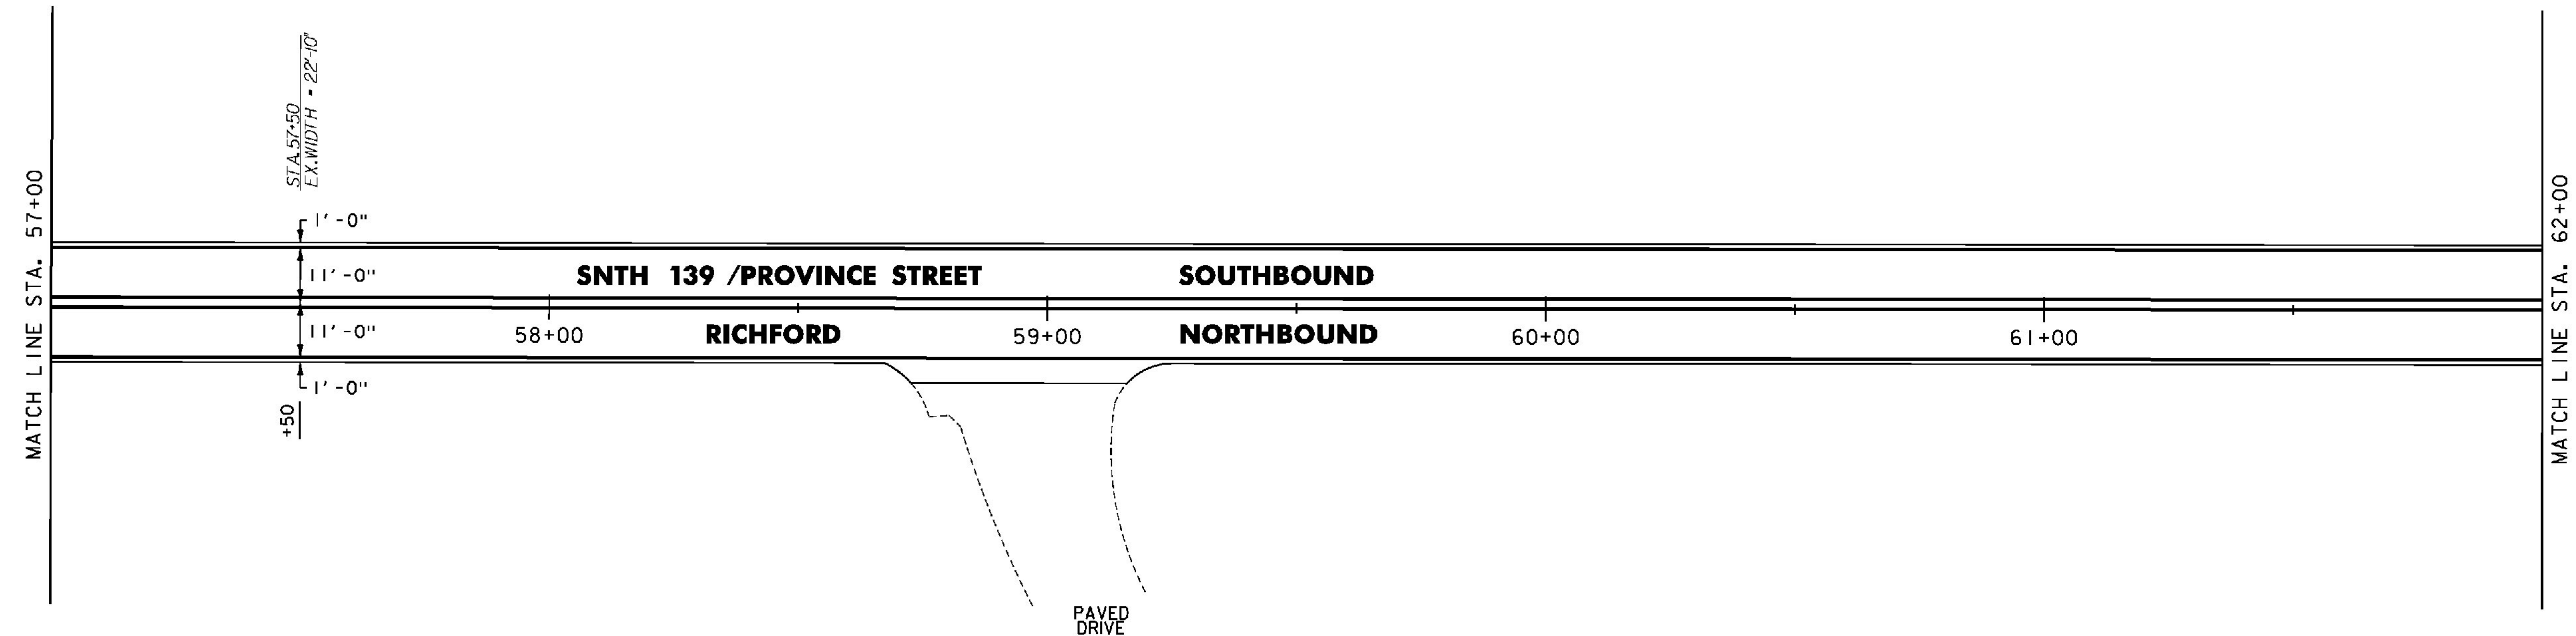

DURABLE & TEMPORARY 4 INCH WHITE LINE  
 (ALL LINES WILL INCLUDE EDGE LINE BREAKS  
 AND RADII FOR SIDE ROADS)  
 STA. 62+00 TO 67+00, SOLID LT & RT

DURABLE & TEMPORARY 4 INCH YELLOW LINE  
 (ALL LINES WILL INCLUDE C BREAKS FOR SIDE ROADS)  
 STA. 62+00 TO 67+00, SOLID LT & RT

REMOVING SIGNS  
 AS SHOWN - 1

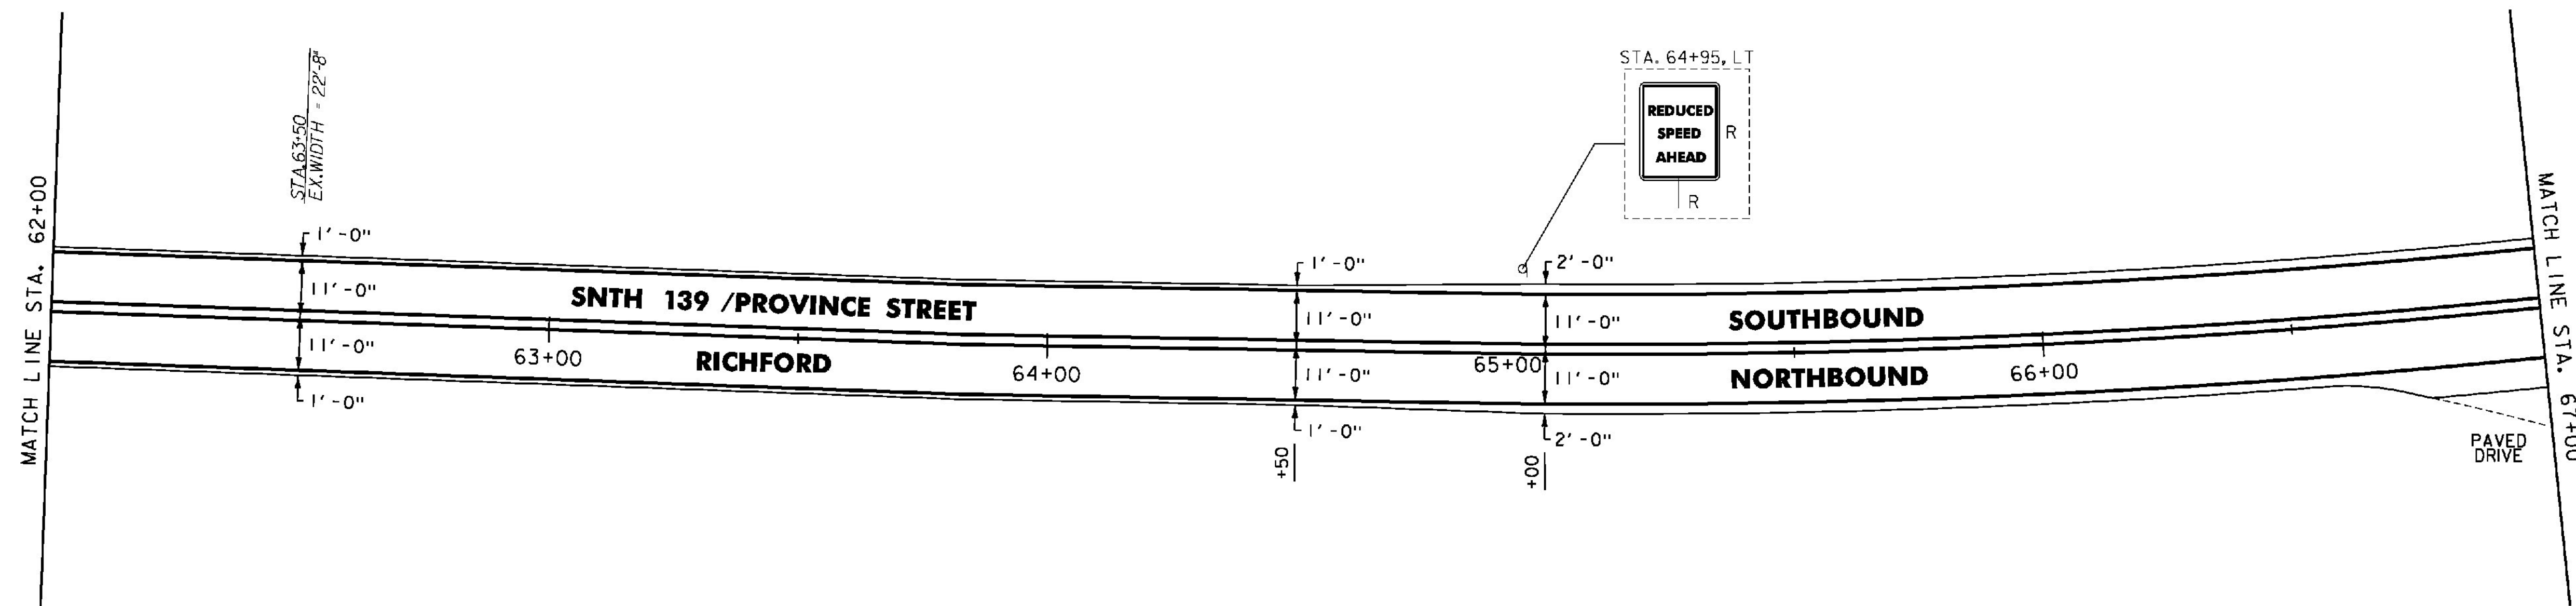

NOTES:

1. FOR LEGENDS, SEE SHEET 22.
2. ALL EXISTING SIGNS NOT SHOWN SHALL BE RETAINED.



NOT TO SCALE

**PROJECT LAYOUT SHEET #46**

PROJECT NAME: ENOSBURG-RICHFORD

PROJECT NUMBER: STP 2939(I)

FILE NAME: p11b312.dgn

PROJECT LEADER: J. LITTLE

DESIGNED BY: J. LITTLE

IPARM FILE: p11b312146.i

PLOT DATE: 3/19/2014

DRAWN BY: D. DRAPER

CHECKED BY: J. LITTLE

SHEET 67 OF 115