


TYPICAL ROAD SECTION

SCALE 1" = 3'-0"

- * 1 1/2" BITUMINOUS CONCRETE PAVEMENT (TYPE IVS)
- 1 1/2" BITUMINOUS CONCRETE PAVEMENT (TYPE IVS)
- 2 1/2" BITUMINOUS CONCRETE PAVEMENT (TYPE IIS)
- 2'-0" SUBBASE OPTION
- 1'-0" SAND BORROW

DECK REINFORCING STEEL COVER
2 1/2" TOP
1 1/2" BOTTOM

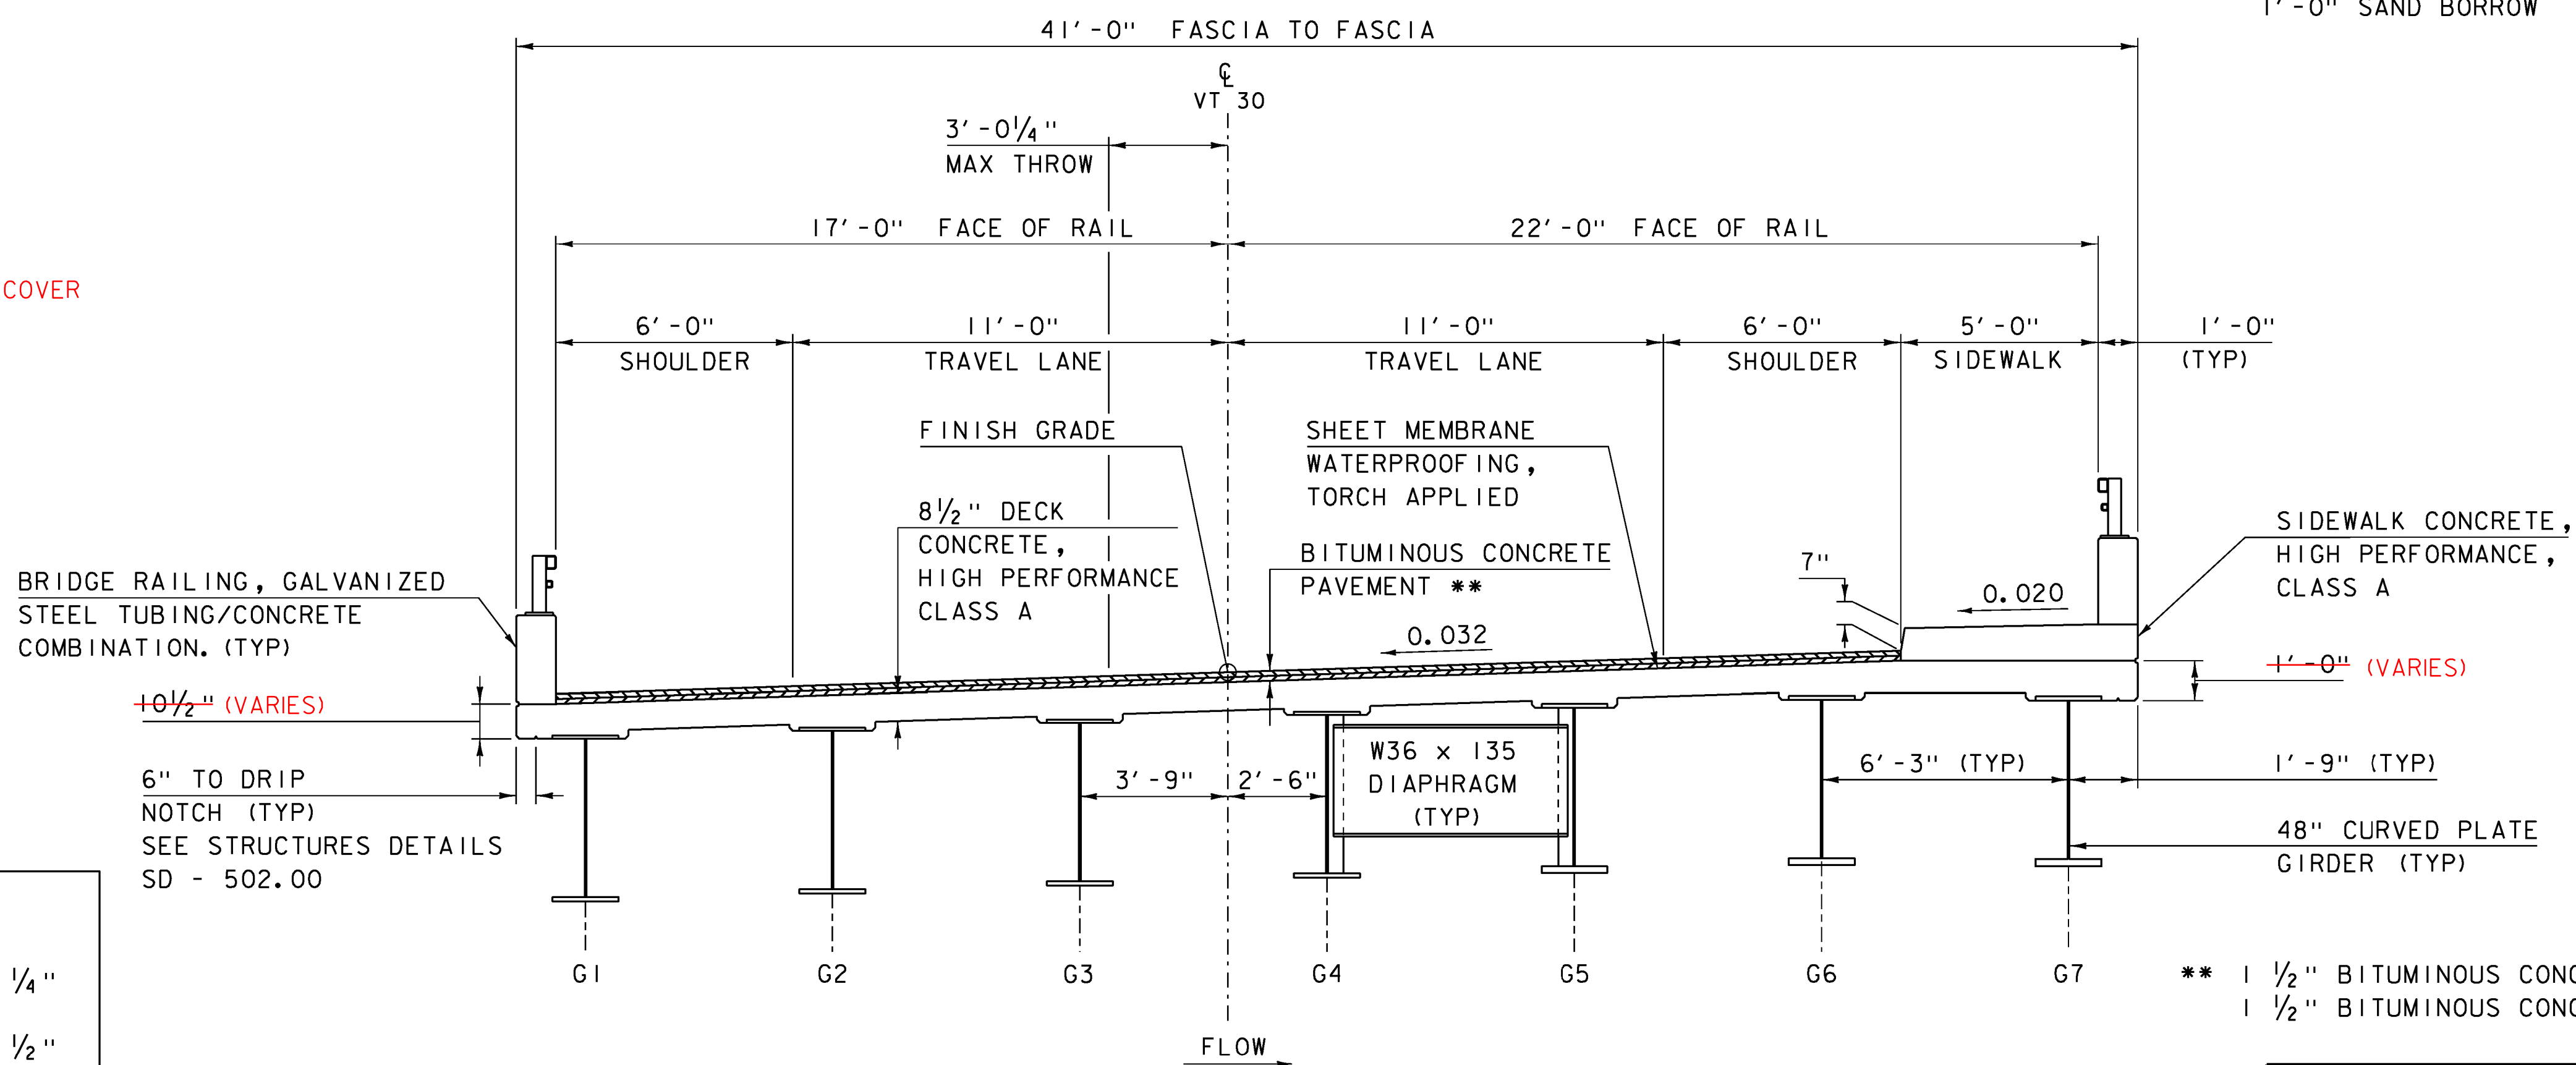

TYPICAL BRIDGE SECTION

SCALE 1" = 3'-0"

- ** 1 1/2" BITUMINOUS CONCRETE PAVEMENT (TYPE IVS) OVER
- 1 1/2" BITUMINOUS CONCRETE PAVEMENT (TYPE IVS)

MATERIAL TOLERANCES

(IF USED ON PROJECT)

| SURFACE | TOLERANCE |
|------------------------------|-----------|
| - PAVEMENT (TOTAL THICKNESS) | +/- 1/4" |
| - AGGREGATE SURFACE COURSE | +/- 1/2" |
| SUBBASE | +/- 1" |
| SAND BORROW | +/- 1" |

6" TO DRIP NOTCH (TYP)
SEE STRUCTURES DETAILS
SD - 502.00

PROJECT NAME: JAMAICA
PROJECT NUMBER: ER-BRF 015-1(23)

FILE NAME: s1lb316typ.dgn
PROJECT LEADER: K. HIGGINS
DESIGNED BY: G. LAROCHE
TYPICAL SECTIONS I

PLOT DATE: 07-DEC-2012
DRAWN BY: K. FRIEDLAND
CHECKED BY: W. LAMMER
SHEET 9 OF 82