


TYPICAL ROAD SECTION

SCALE 1" = 3'-0"

- * 1 1/2" BITUMINOUS CONCRETE PAVEMENT (TYPE IVS)
- 1 1/2" BITUMINOUS CONCRETE PAVEMENT (TYPE IVS)
- 2 1/2" BITUMINOUS CONCRETE PAVEMENT (TYPE IIS)
- 2'-0" SUBBASE OPTION
- 1'-0" SAND BORROW

DECK REINFORCING STEEL COVER
2 1/2" TOP
1 1/2" BOTTOM

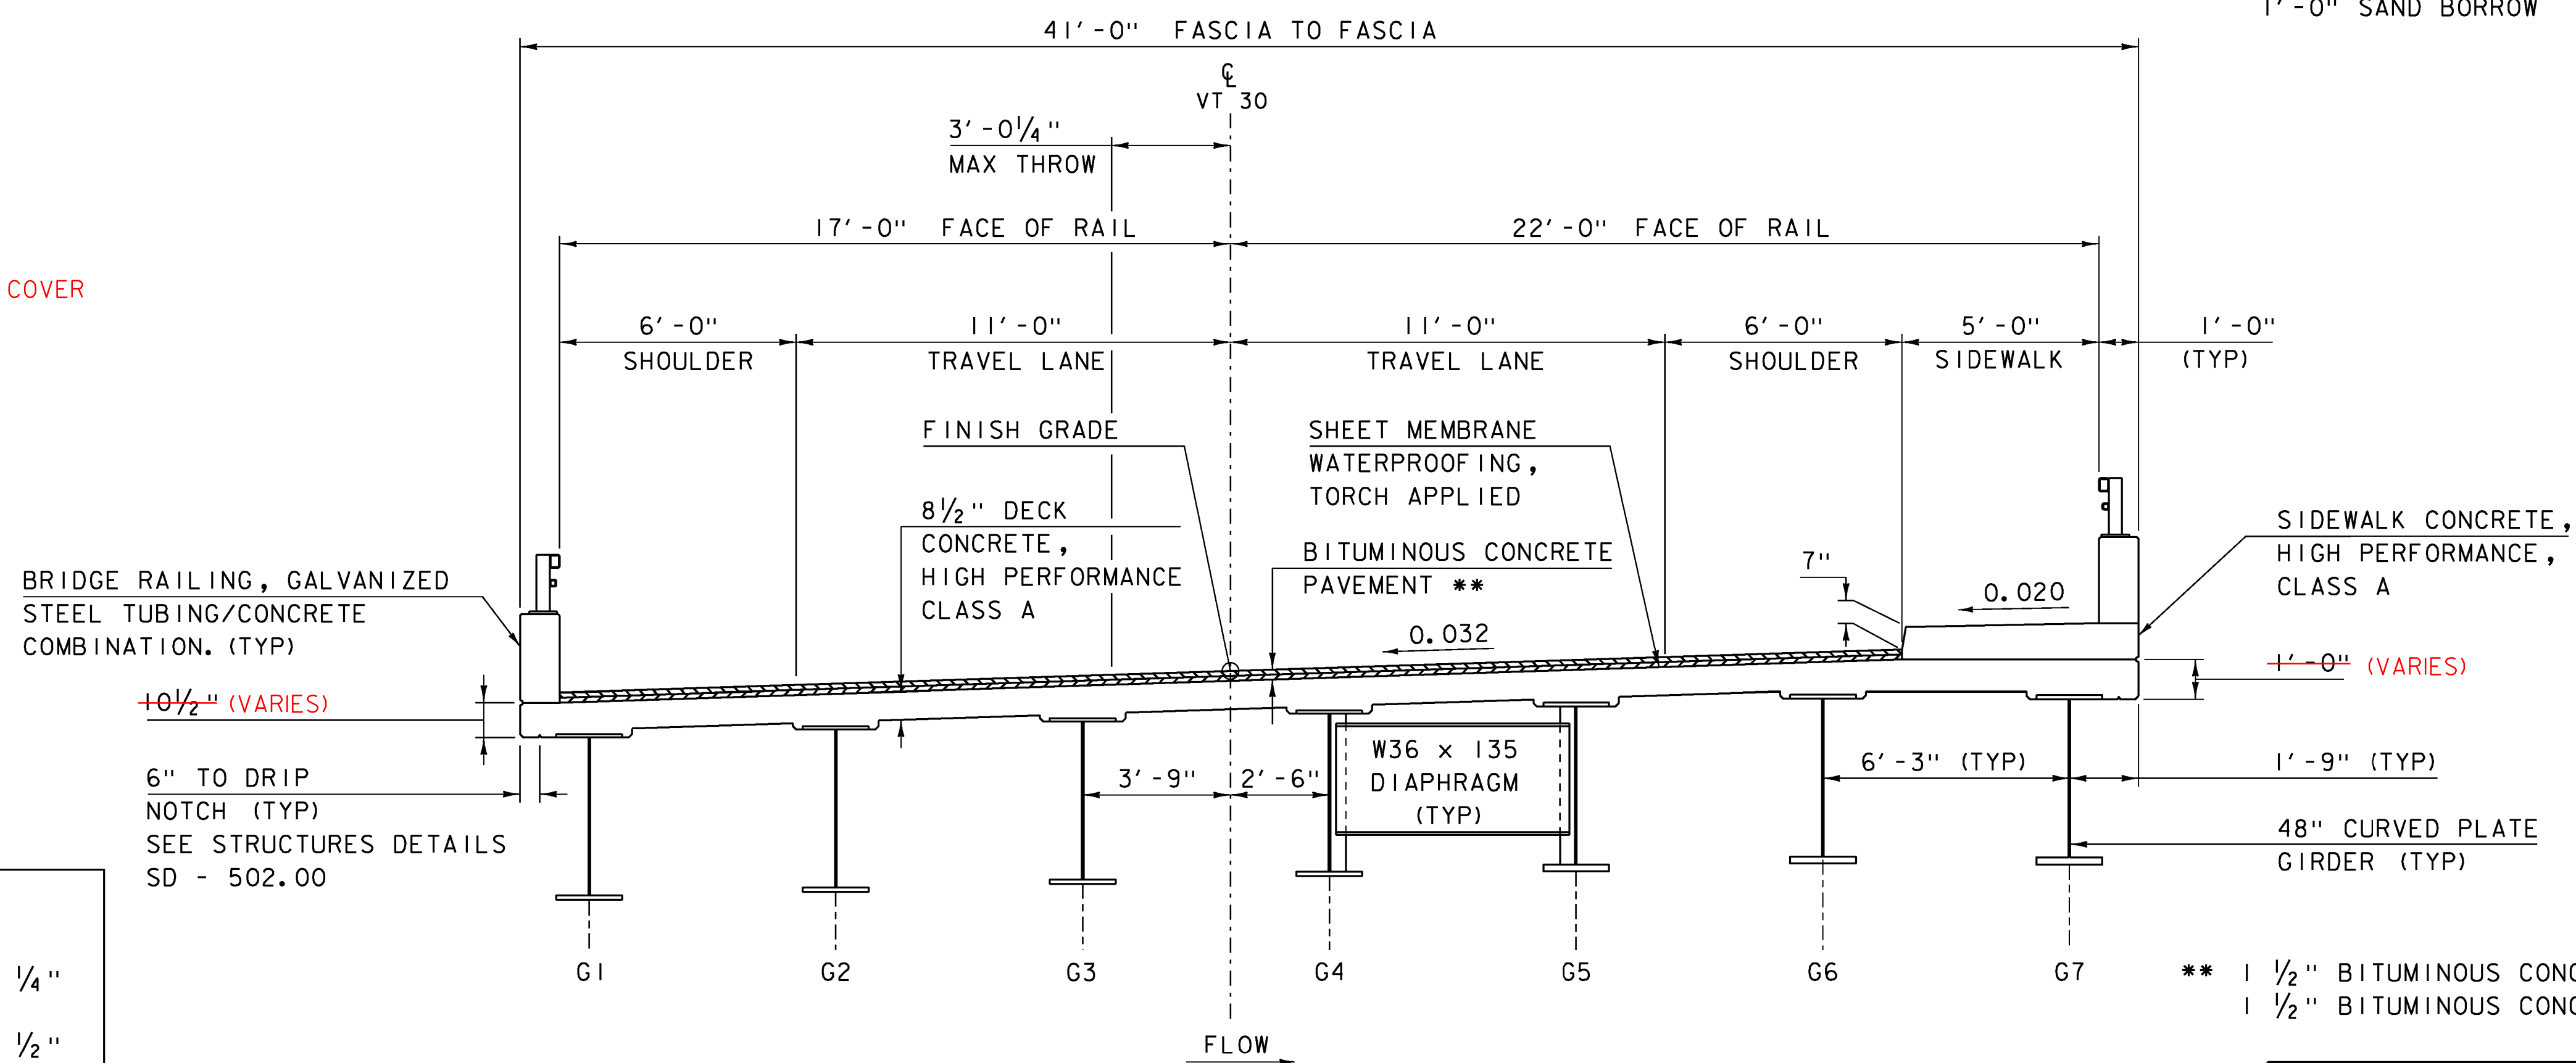

TYPICAL BRIDGE SECTION

SCALE 1" = 3'-0"

- ** 1 1/2" BITUMINOUS CONCRETE PAVEMENT (TYPE IVS) OVER
- 1 1/2" BITUMINOUS CONCRETE PAVEMENT (TYPE IVS)

MATERIAL TOLERANCES
(IF USED ON PROJECT)

SURFACE	
- PAVEMENT (TOTAL THICKNESS)	+/- 1/4"
- AGGREGATE SURFACE COURSE	+/- 1/2"
SUBBASE	
	+/- 1"
SAND BORROW	
	+/- 1"

6" TO DRIP NOTCH (TYP)
SEE STRUCTURES DETAILS
SD - 502.00

PROJECT NAME: JAMAICA
PROJECT NUMBER: ER-BRF 015-1(23)

FILE NAME: s1lb316typ.dgn PLOT DATE: 07-DEC-2012
PROJECT LEADER: K. HIGGINS DRAWN BY: K. FRIEDLAND
DESIGNED BY: G. LAROCHE CHECKED BY: W. LAMMER
TYPICAL SECTIONS I SHEET 9 OF 82