


BOX CULVERT PROFILE

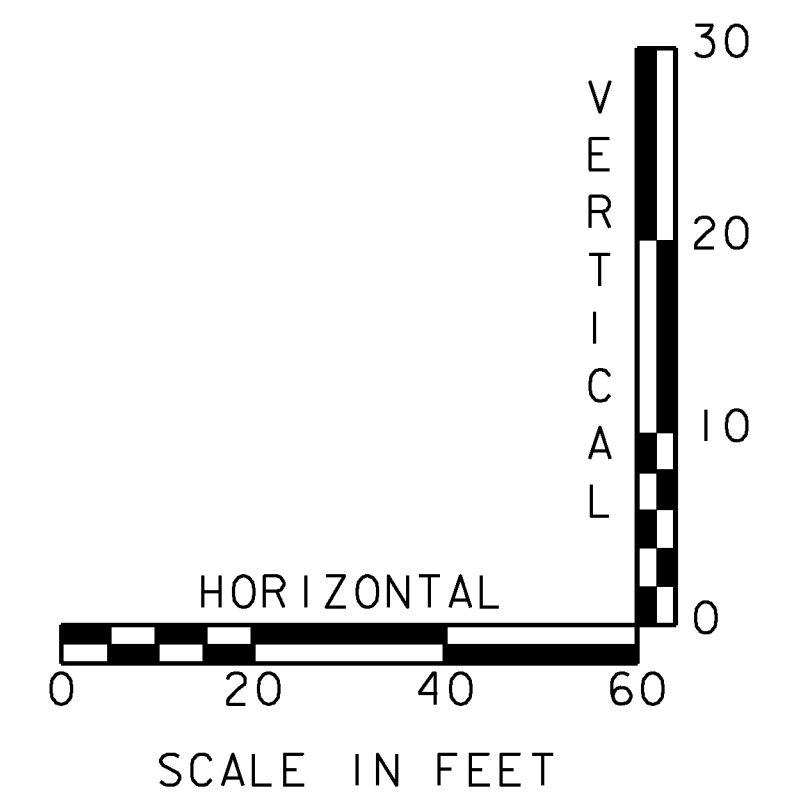

THE GRADES SHOWN TO THE NEAREST TENTH ARE THE ORIGINAL GROUND ELEVATIONS ALONG THE PROPOSED ALIGNMENT.

THE GRADES SHOWN TO THE NEAREST HUNDREDTH ARE THE FINISH GRADES ALONG THE PROPOSED ALIGNMENT.

PROJECT NAME: JAMAICA	PLOT DATE: 07-DEC-2012
PROJECT NUMBER: ER-BRF 015-1(23)	DRAWN BY: K. FRIEDLAND
FILE NAME: s11b316.pro.dgn	CHECKED BY: G. LAROCHE
DESIGNED BY: G. LAROCHE	SHEET 18 OF 82
BOX CULVERT PROFILE	