


EXIST. STRUCTURE CAPPED
AND TIED TO NEW CATCH
BASIN
UNKNOWN VARIOUS DRAINS
INTO EXIST. STRUCTURE

24" OPTION PIPE PROFILE
STA 211+60.52 - 212+61.85 RT

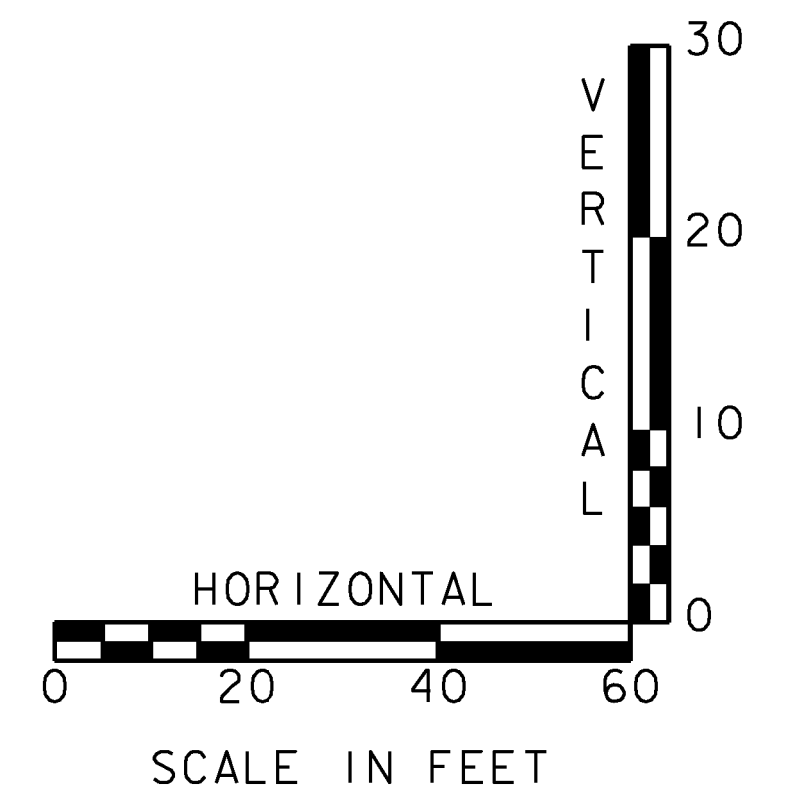

PROJECT NAME: JAMAICA	PLOT DATE: 07-DEC-2012
PROJECT NUMBER: ER-BRF 015-1(23)	DRAWN BY: K. FRIEDLAND
FILE NAME: s1b316.pro.dgn	CHECKED BY: G. LAROCHE
PROJECT LEADER: K. HIGGINS	SHEET 19 OF 82
DESIGNED BY: G. LAROCHE	
DRAINAGE PIPE PROFILE	