
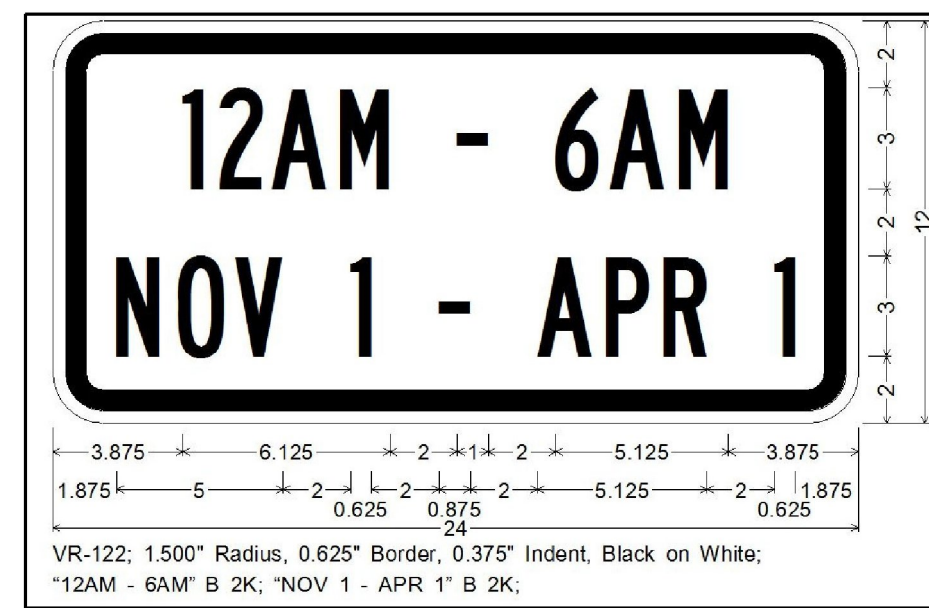
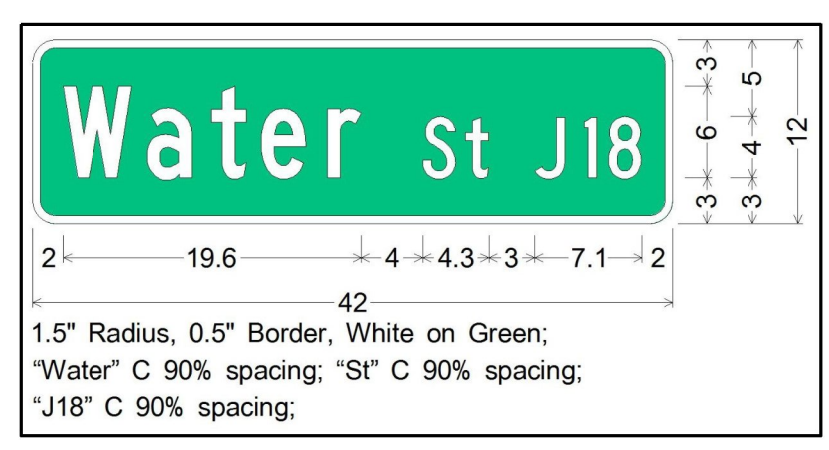


• LENGTHS INCLUDE ANCHOR

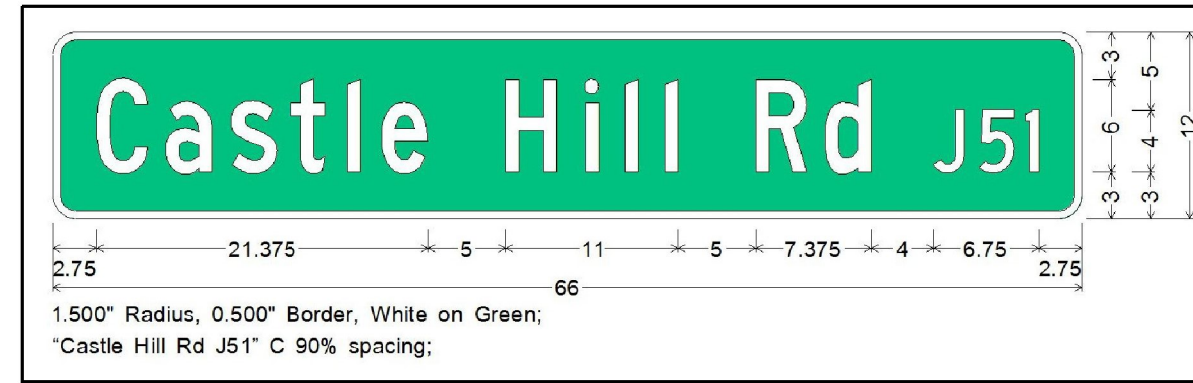


REMOVING SIGNS  
 STA 214+10.00 LT  
 STA 214+20.30 LT  
 STA 214+49.60 RT  
 STA 214+73.40 LT (2)

TRAFFIC SIGNS, TYPE A  
 STA 214+10.00 LT  
 STA 214+20.30 LT  
 STA 214+49.60 RT  
 STA 214+73.40 LT

4 INCH WHITE LINE  
 STA 213+75.00 - STA 215+00.00 RT  
 STA 213+75.00 - STA 213+90.00 LT  
 STA 214+55.00 - STA 215+00.00 LT

4 INCH YELLOW LINE (DOUBLE)  
 STA 213+75.00 - STA 214+10.00 C  
 STA 214+50.00 - STA 215+00.00 C


MATCHLINE 213+75

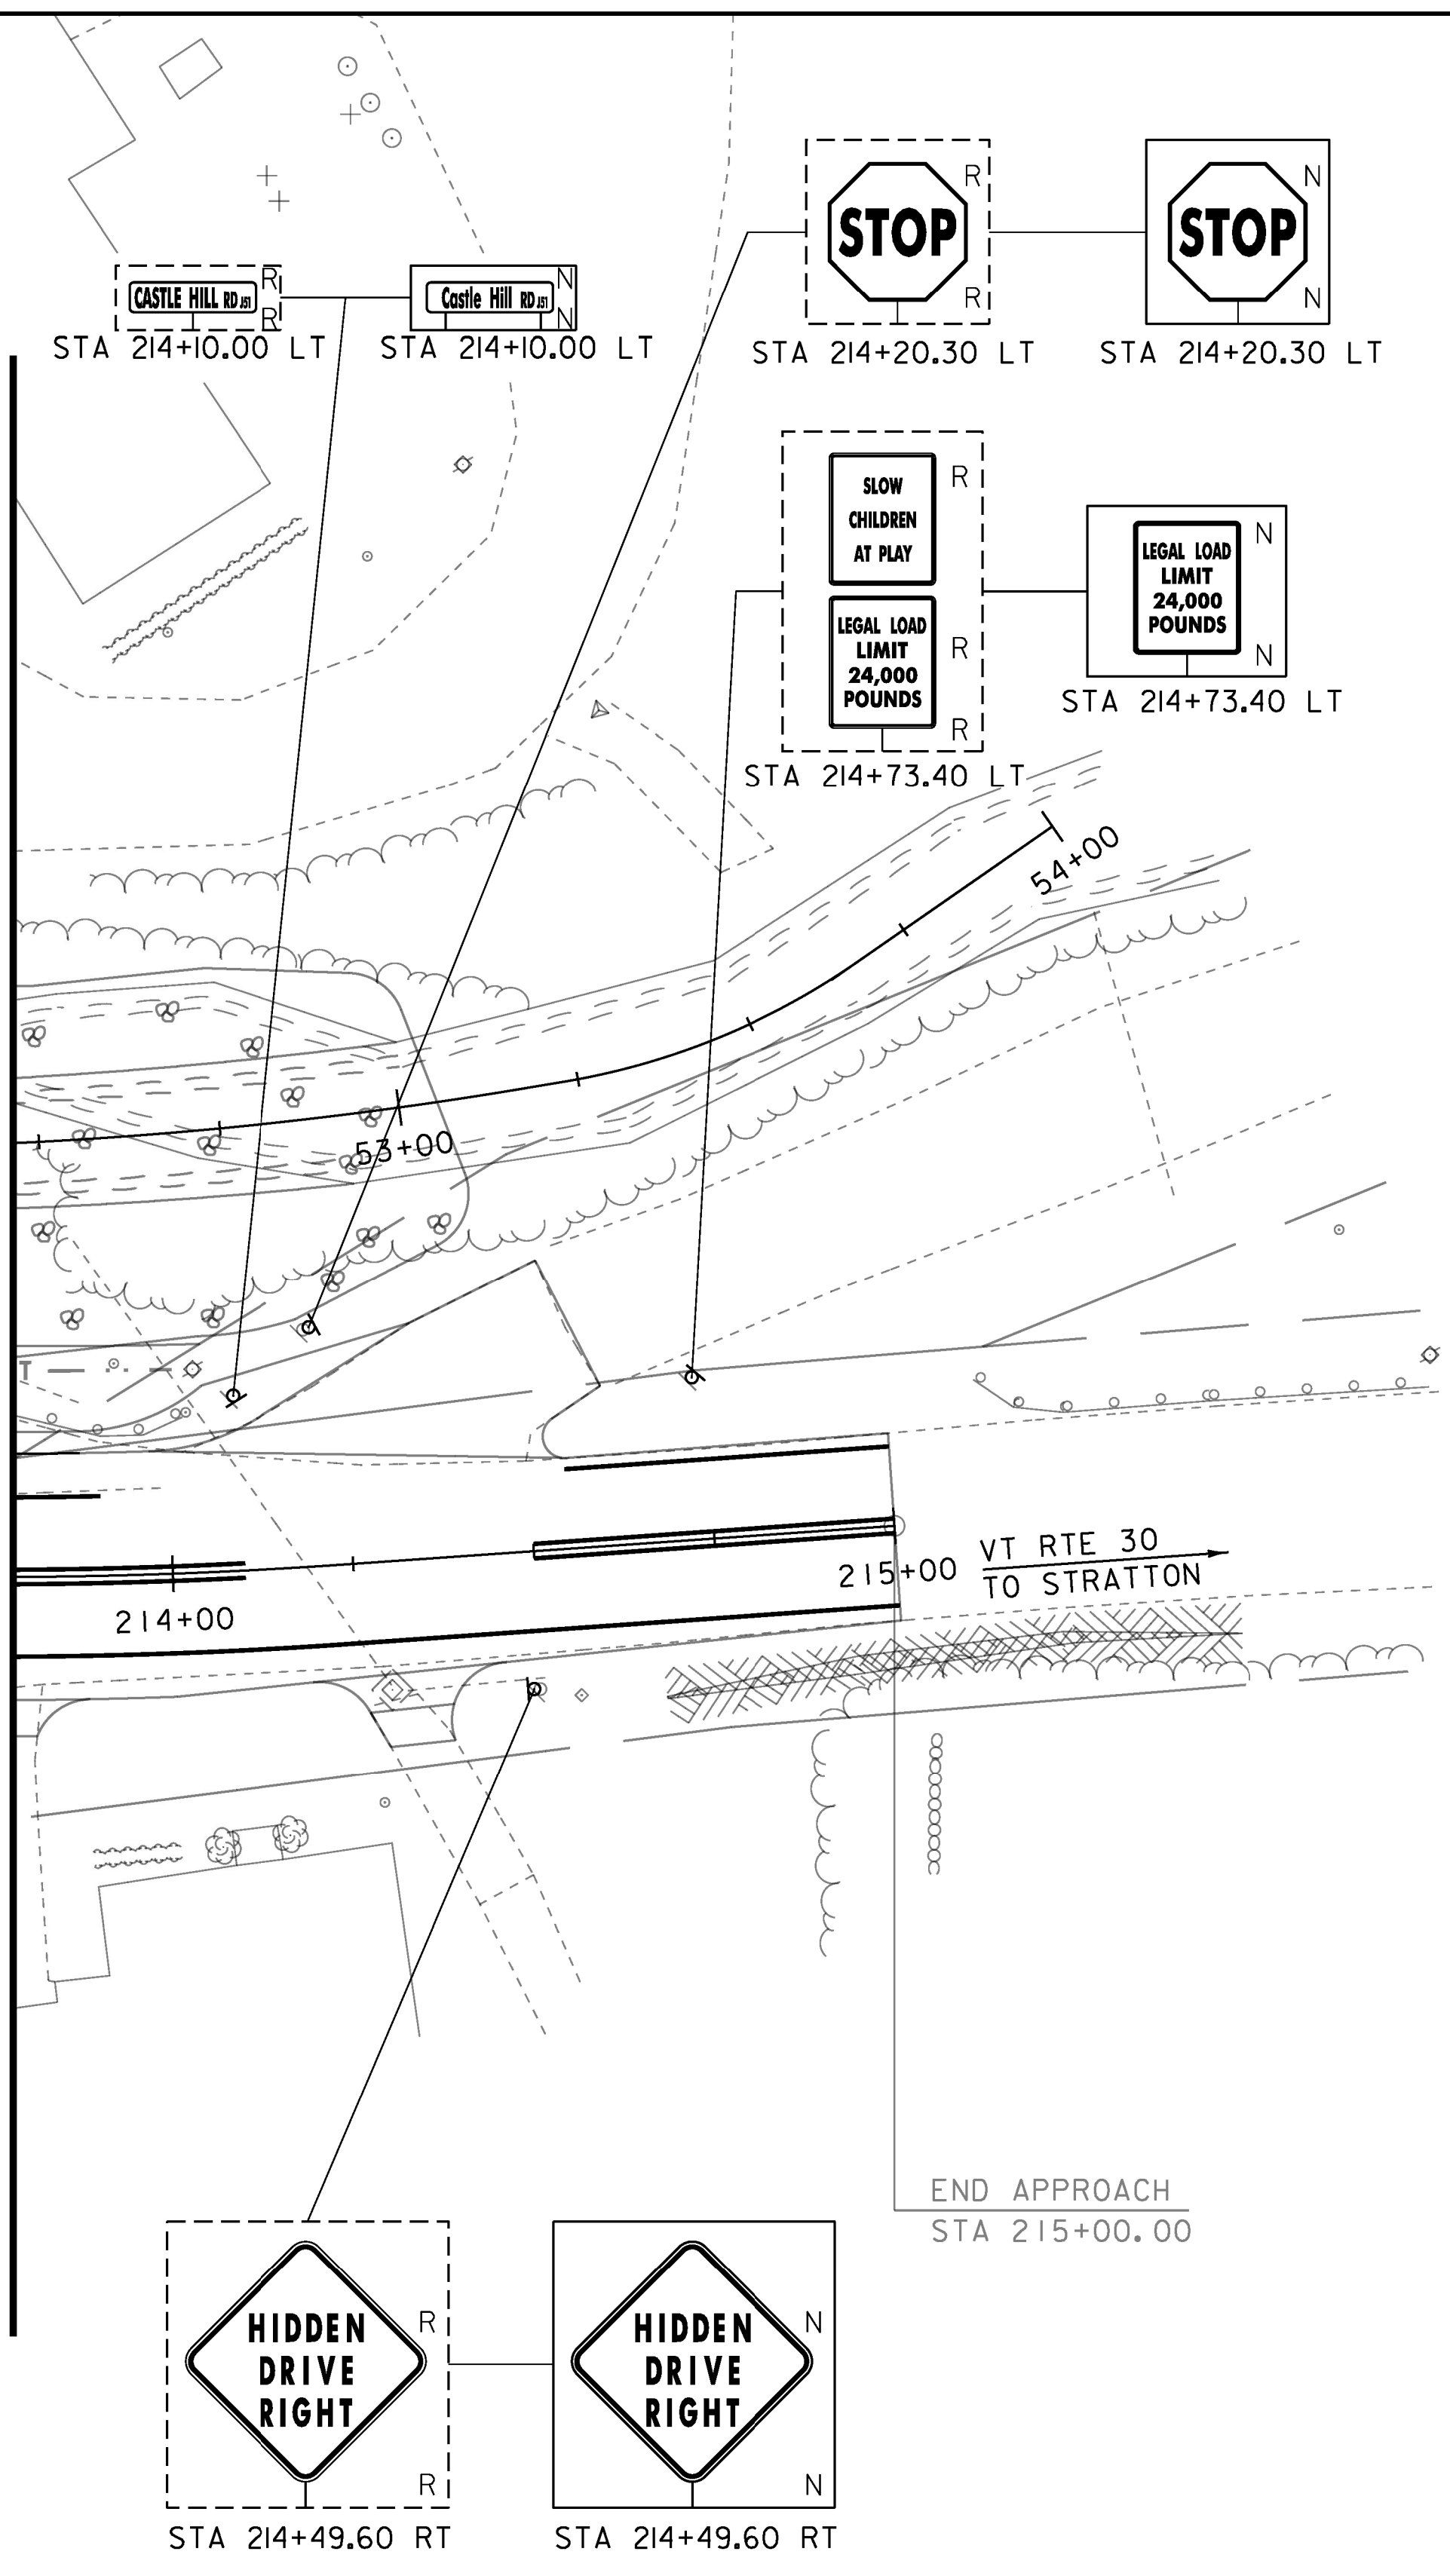

SIGN LEGEND

N	= NEW
R	= REMOVE
S	= SALVAGE
R&S	= REMOVE & SALVAGE

SIGN & PAVEMENT MARKINGS 2

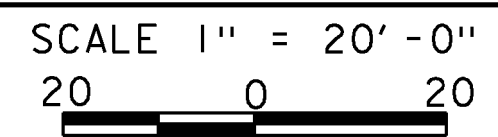

MILEMARKER OR STATION	SIGN LEGEND	SIGN DIMENSIONS		NEW SIGN "A"	EXISTING SIGN RETAIN	NO. OF POSTS	NEW SIGN POSTS SQUARE STEEL (in)			REMARKS	SIGN DETAIL	
		WIDTH	HEIGHT				ANCHOR	SQUARE STEEL			DETAIL ON SHEET NUMBER	STD. SHEET NUMBER
								1.75 lb/ft	2.0 lb/ft			
STA 209+90.00 LT		30	30	6.25		1				W1-2 (FYG)	E-152	
		24	12	2.00					-5-14.25	W16-9p (FYG)	E-152	
STA 210+00.00 RT		6	8	0.33		1			-7-6.75	VD-701	E-134	
		6	8	0.33						VD-701	E-134	
STA 211+68.00 LT		24	30	5.00		1			-5-12.25	R2-1	SHS	
STA 211+72.50 RT		24	30	5.00		1			-5-13.25	VR-017	E-141	
STA 212+27.00 RT		42	12	3.50		1				D3-1	SEE THIS SHEET SHS	
		30	30	6.25					-5-13.75	R1-1	SHS	
STA 213+12.00 LT		24	24	4.00						R8-3	E-143	
		24	10	1.67		1			-5-14.0	VR-122	SEE THIS SHEET	
		24	12	2.00						M4-6	E-140	
STA 213+12.00 RT		24	24	4.00						R8-3	E-143	
		24	10	1.67		1			15	VR-122	SEE THIS SHEET	
		24	12	2.00						M4-14	E-140	
STA 214+10.00 LT		66	12	5.50		2			10.25 -30 10.25	D3-1	SEE THIS SHEET SHS	
STA 214+20.30 LT		30	30	6.25		1			-5-12.25	R1-1	SHS	
STA 214+49.60 RT		30	30	6.25		1			-5-14.0	VW-054	E-154	
STA 214+73.40 LT		24	30	5.00		1			-5-12.25	VR-017	E-141	
							FT	FT	FT	EA		
							7	165				
<b>TOTALS</b>							SF	FT				
							67.00	172-148.25				

FINAL POST LENGTHS ARE TO BE DETERMINED IN THE FIELD. POST SIZES ARE COMPUTED BASED ON INFORMATION FURNISHED ON THE STANDARD SHEETS AND THE VTRANS "SIGN POST DESIGN GUIDELINE."

SHS = STANDARD HIGHWAY SIGNS (MUTCD)

NOTE:  
 ADJUST NEW CENTERLINE AND EDGE LINES TO MATCH EXISTING LINES AT BEGIN/END APPROACH

PROJECT NAME: JAMAICA	FILE NAME: s11b316.sign.dgn	PLOT DATE: 14-DEC-2012
PROJECT NUMBER: ER-BRF 015-1(23)	PROJECT LEADER: K. HIGGINS	DRAWN BY: K. FRIEDLAND
	DESIGNED BY: G. LAROCHE	CHECKED BY: J. SALVATORI
	SIGN & PAVEMENT MARKINGS 2	SHEET 22 OF 82