


APPROACH RAIL PLAN @ WW2
 (WW4 SIMILAR BUT CURVED)
 NOT TO SCALE

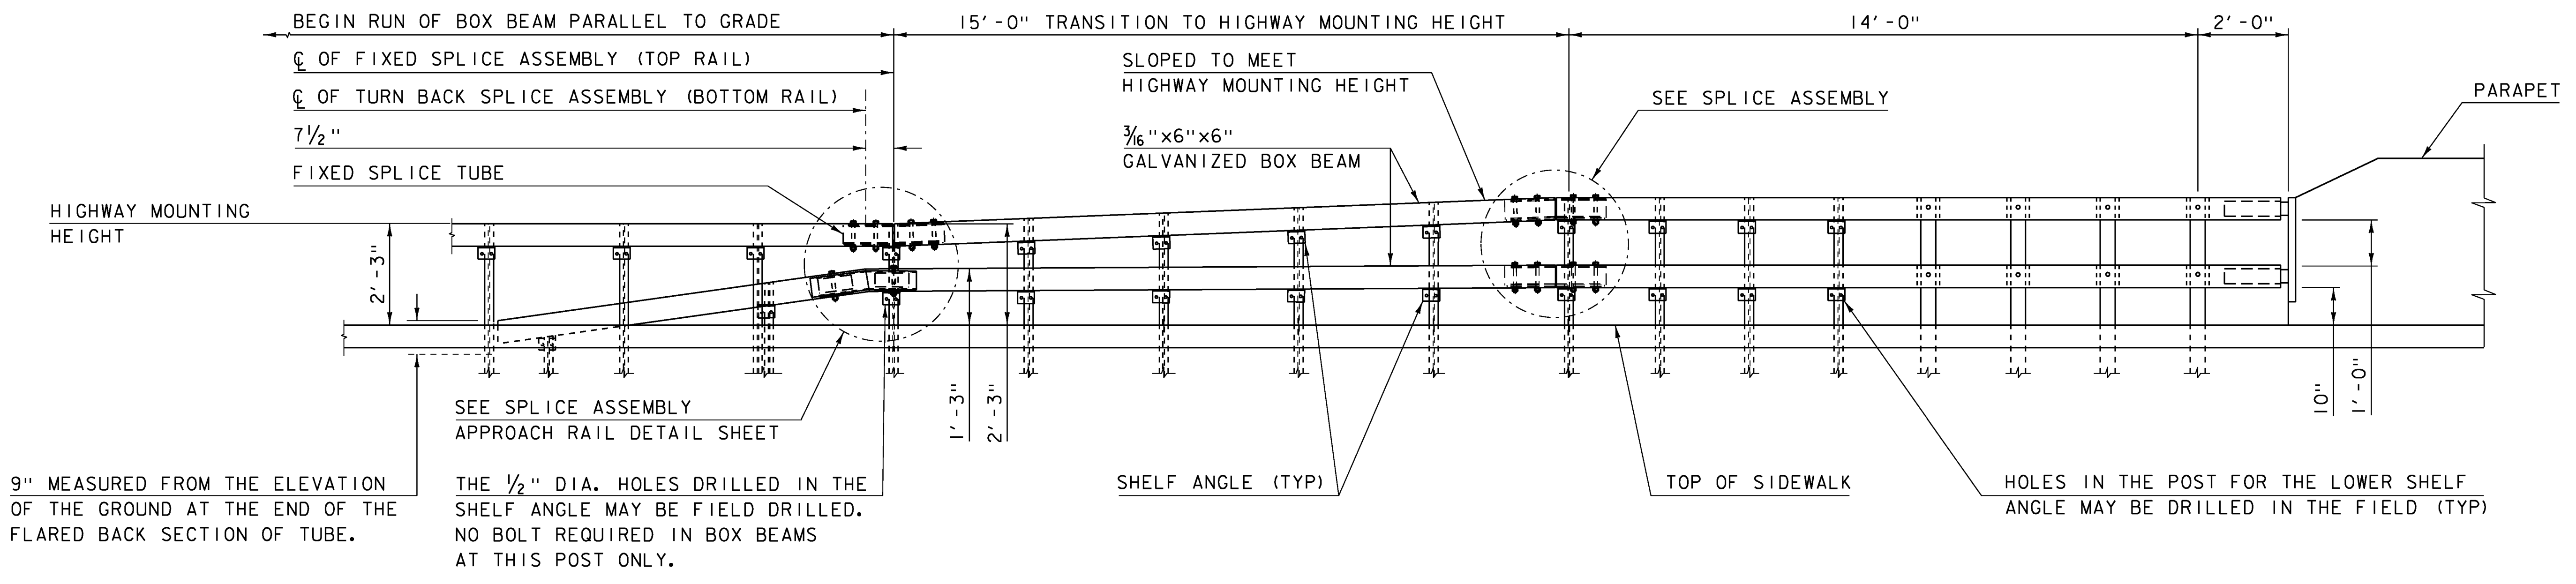

APPROACH RAIL ELEVATION
 NOT TO SCALE

OTHER STANDARDS REQUIRED: G-1B

PROJECT NAME: JAMAICA	PLOT DATE: 07-DEC-2012
PROJECT NUMBER: ER-BRF 015-1(23)	DRAWN BY: G. LAROCHE
FILE NAME: s11b316raildet.dgn	CHECKED BY: J. SALVATORI
PROJECT LEADER: K. HIGGINS	SHEET 27 OF 82
DESIGNED BY: G. LAROCHE	
APPROACH RAIL WW2 AND WW4	