


APPROACH SLAB 1 PLAN
SCALE 3/16" = 1'-0"


TOS = TOP OF SLAB

BALL MOUNTAIN BROOK
FLOW

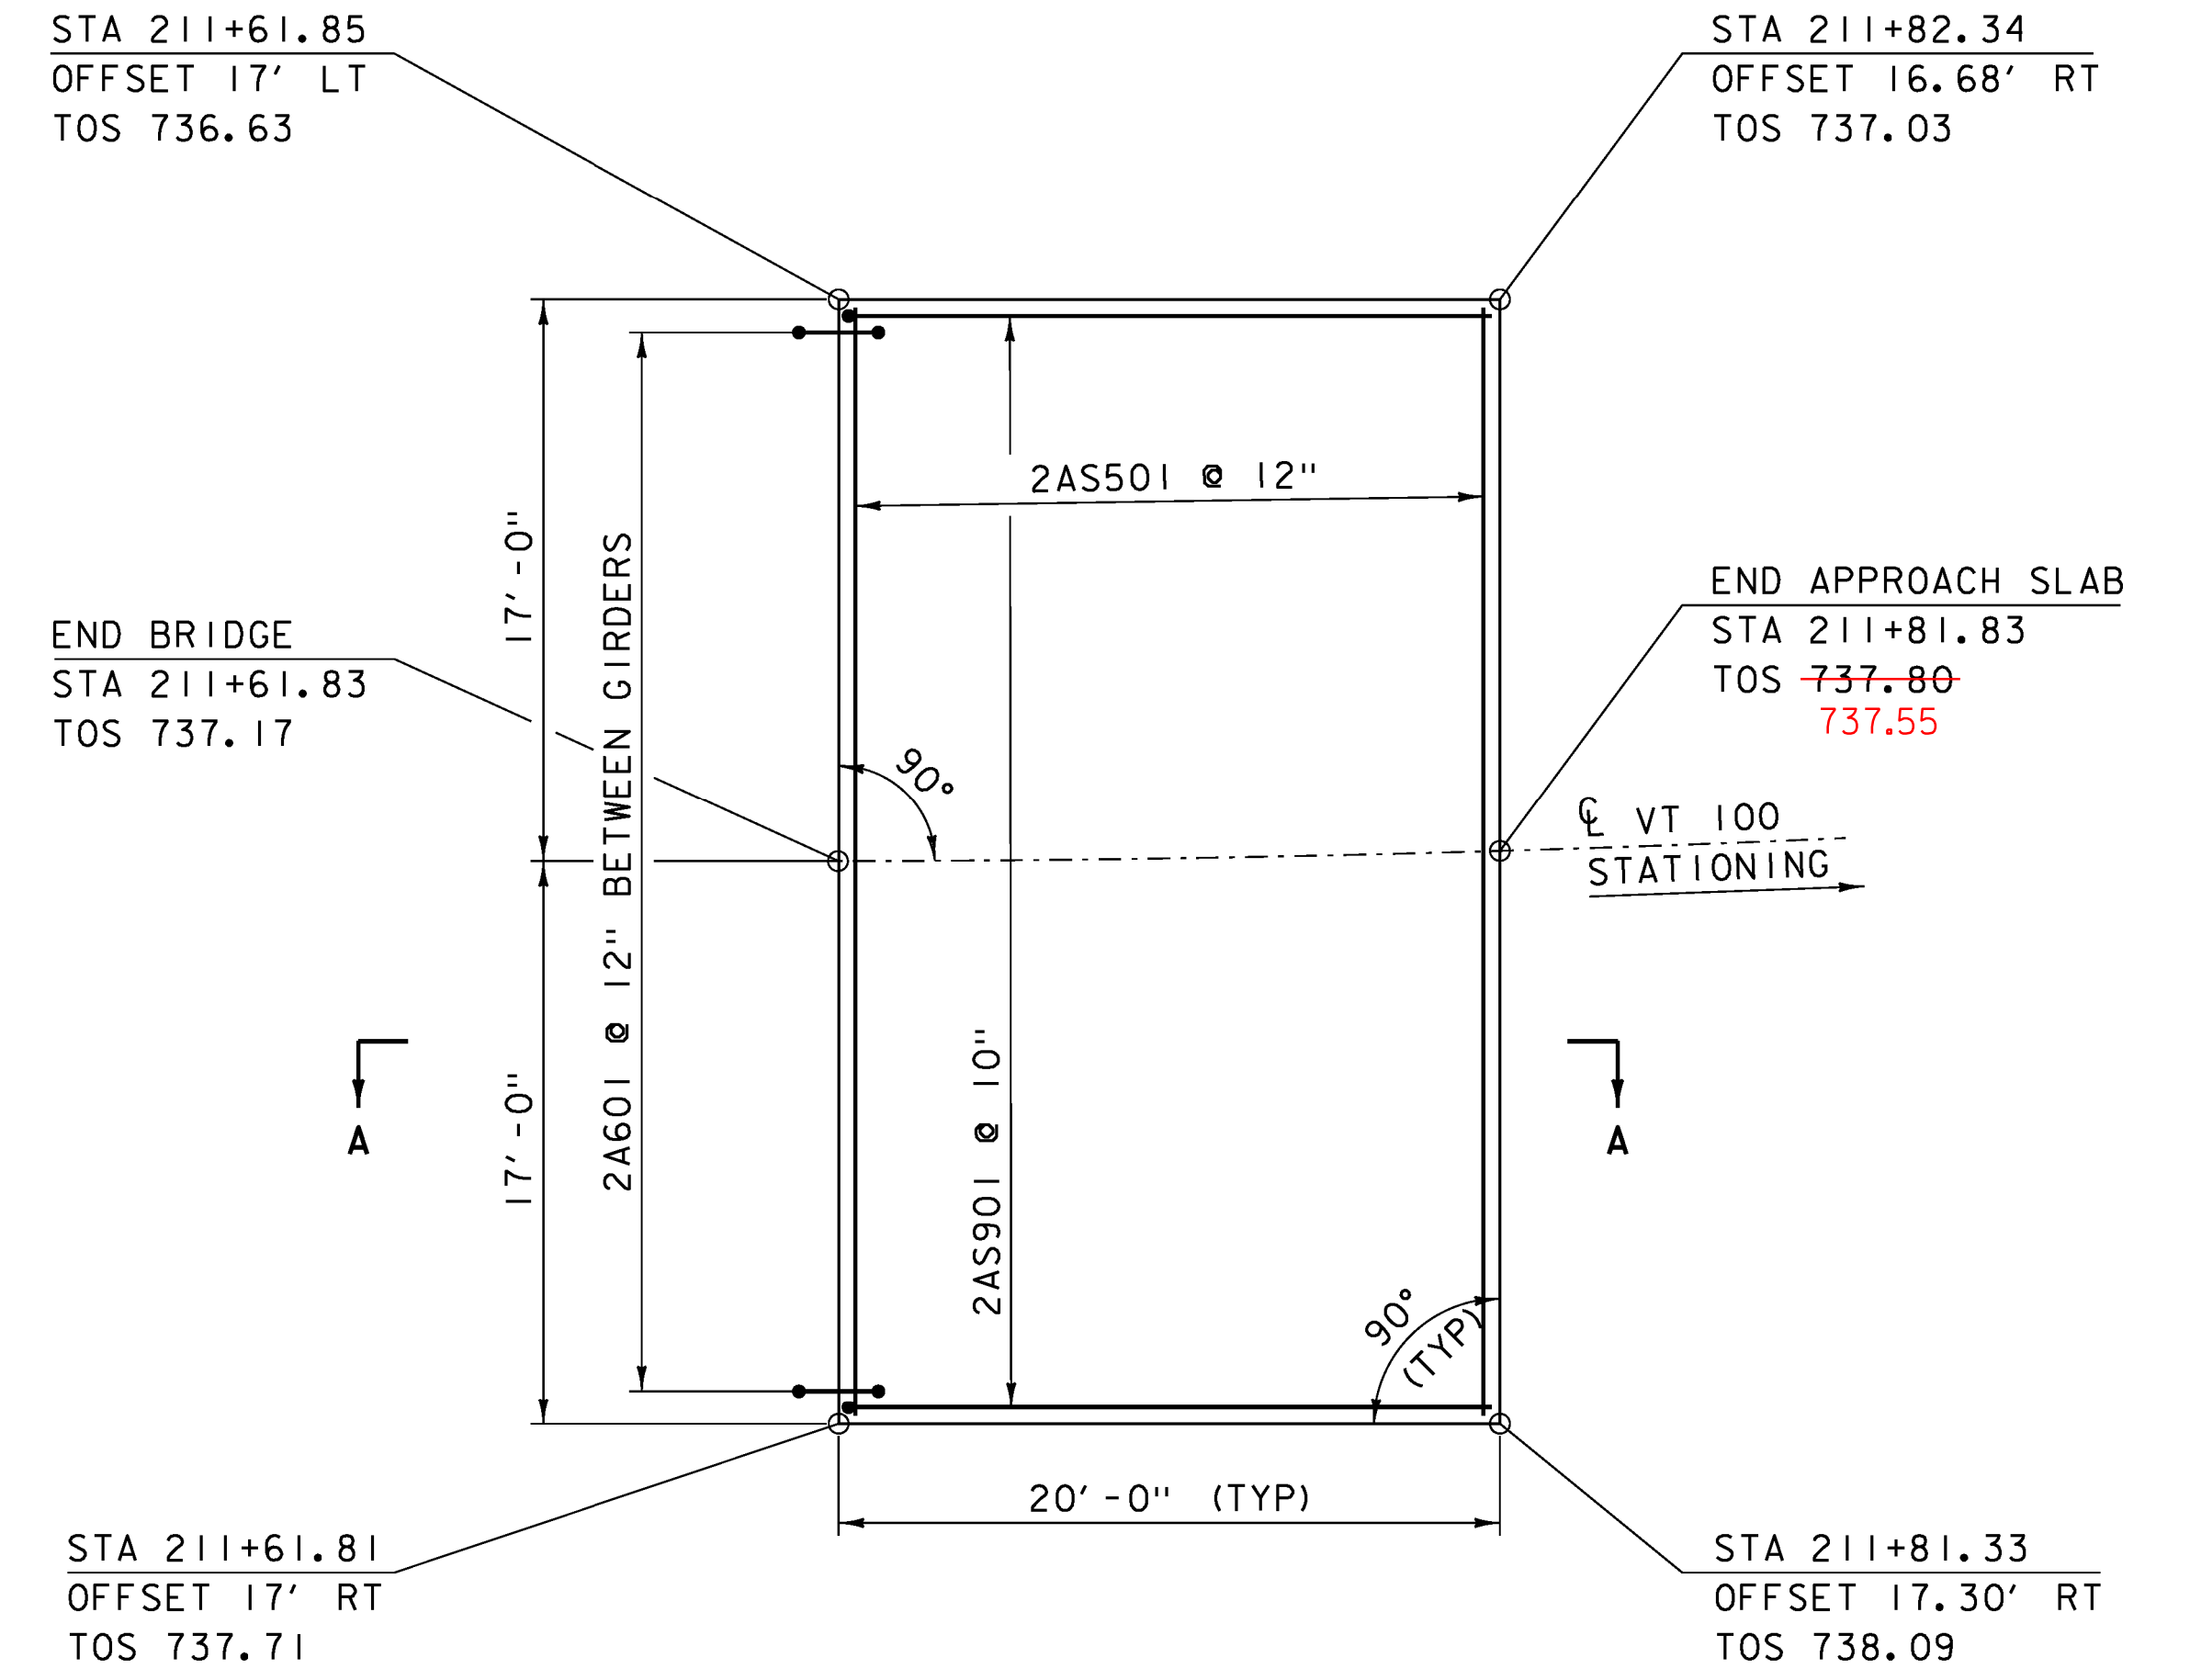


APPROACH SLAB 2 PLAN
SCALE 3/16" = 1'-0"

NOTE:
NF = NEAR FACE
FF = FAR FACE
EF = EACH FACE
▲ = CUT TO FIT IN FIELD
3" CLEAR, UNLESS OTHERWISE SPECIFIED ON THE PLANS.
3'-0" BAR LAP UNLESS OTHERWISE SPECIFIED ON THE PLANS.

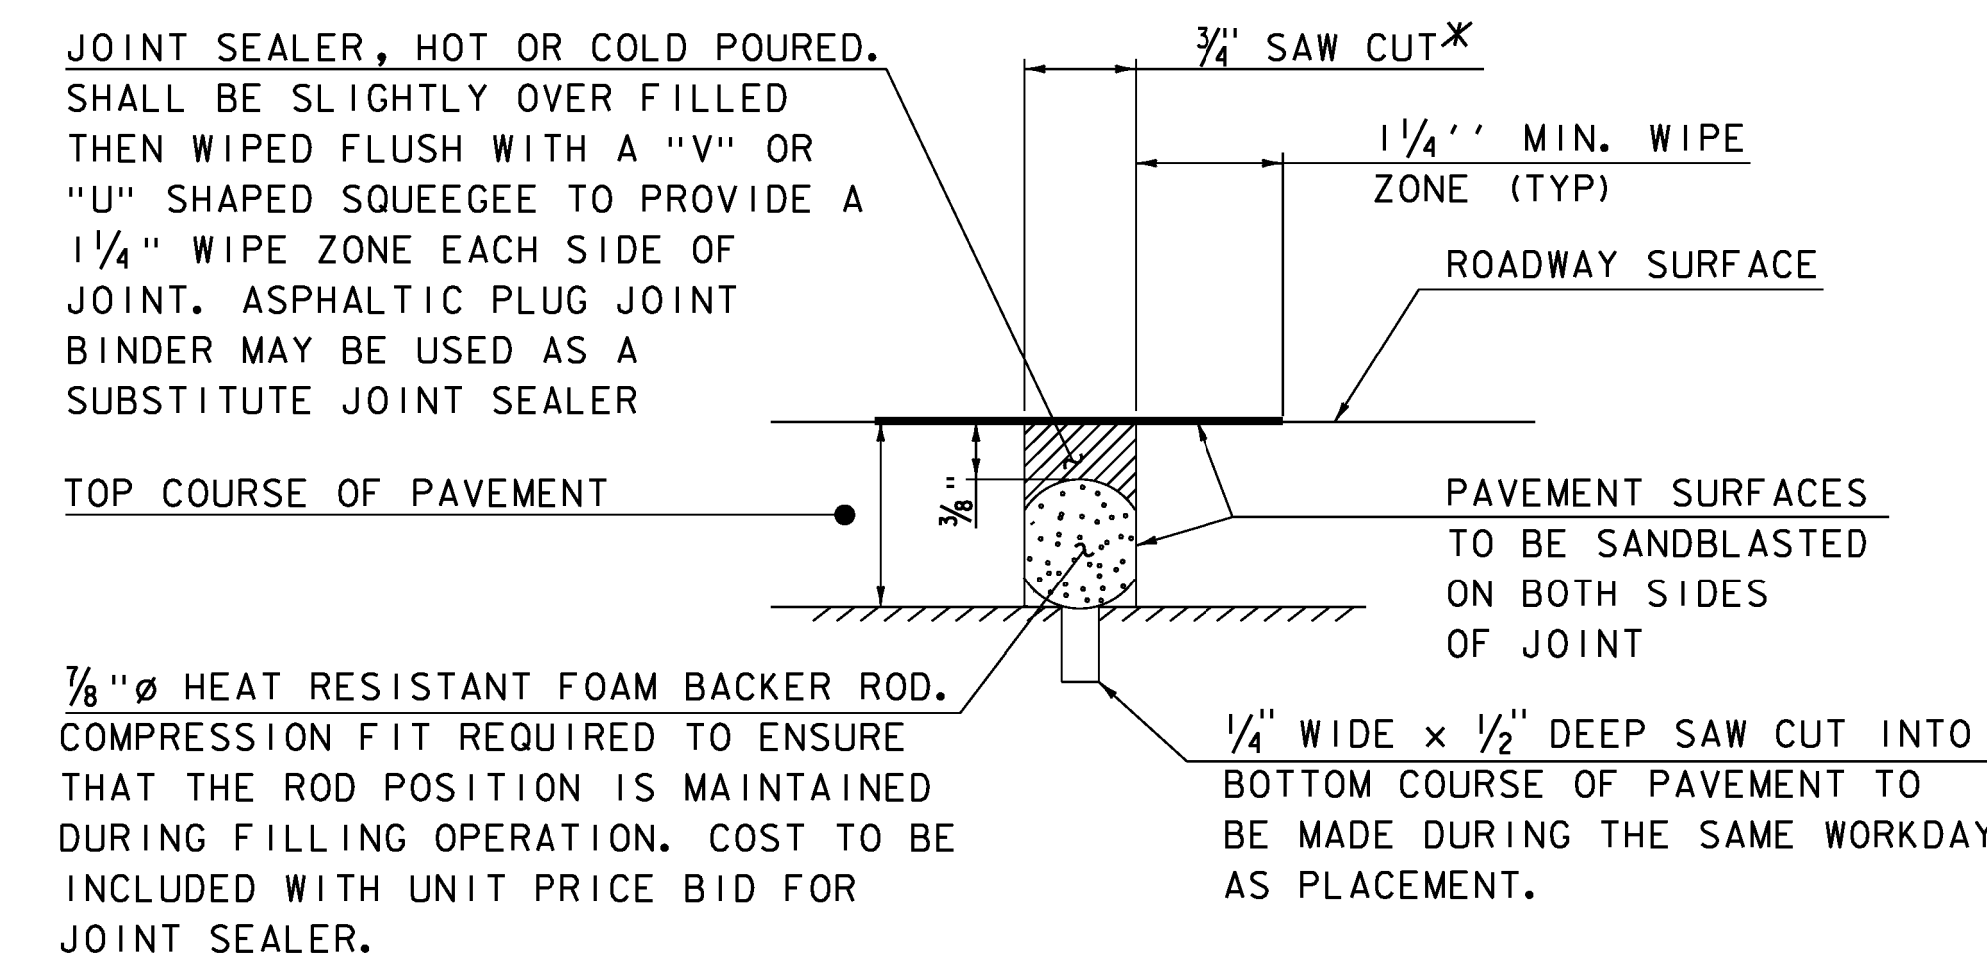

SAWED PAVEMENT JOINT DETAIL
(NOT TO SCALE)

* JOINT IS TO BE LOCATED ACCURATELY BY STRING LINING, OR OTHER MEANS, PRIOR TO PAVING, SO THAT THE SAW CUTS WILL BE MADE DIRECTLY OVER THE END OF CONCRETE DECK. JOINT SHALL BE CUT DRY IN A SINGLE PASS AND BE SEALED WITHIN 24 HOURS OR PRIOR TO EXPOSURE TO TRAFFIC. JOINT SHALL BE CLEANED PRIOR TO APPLYING THE JOINT SEALER.

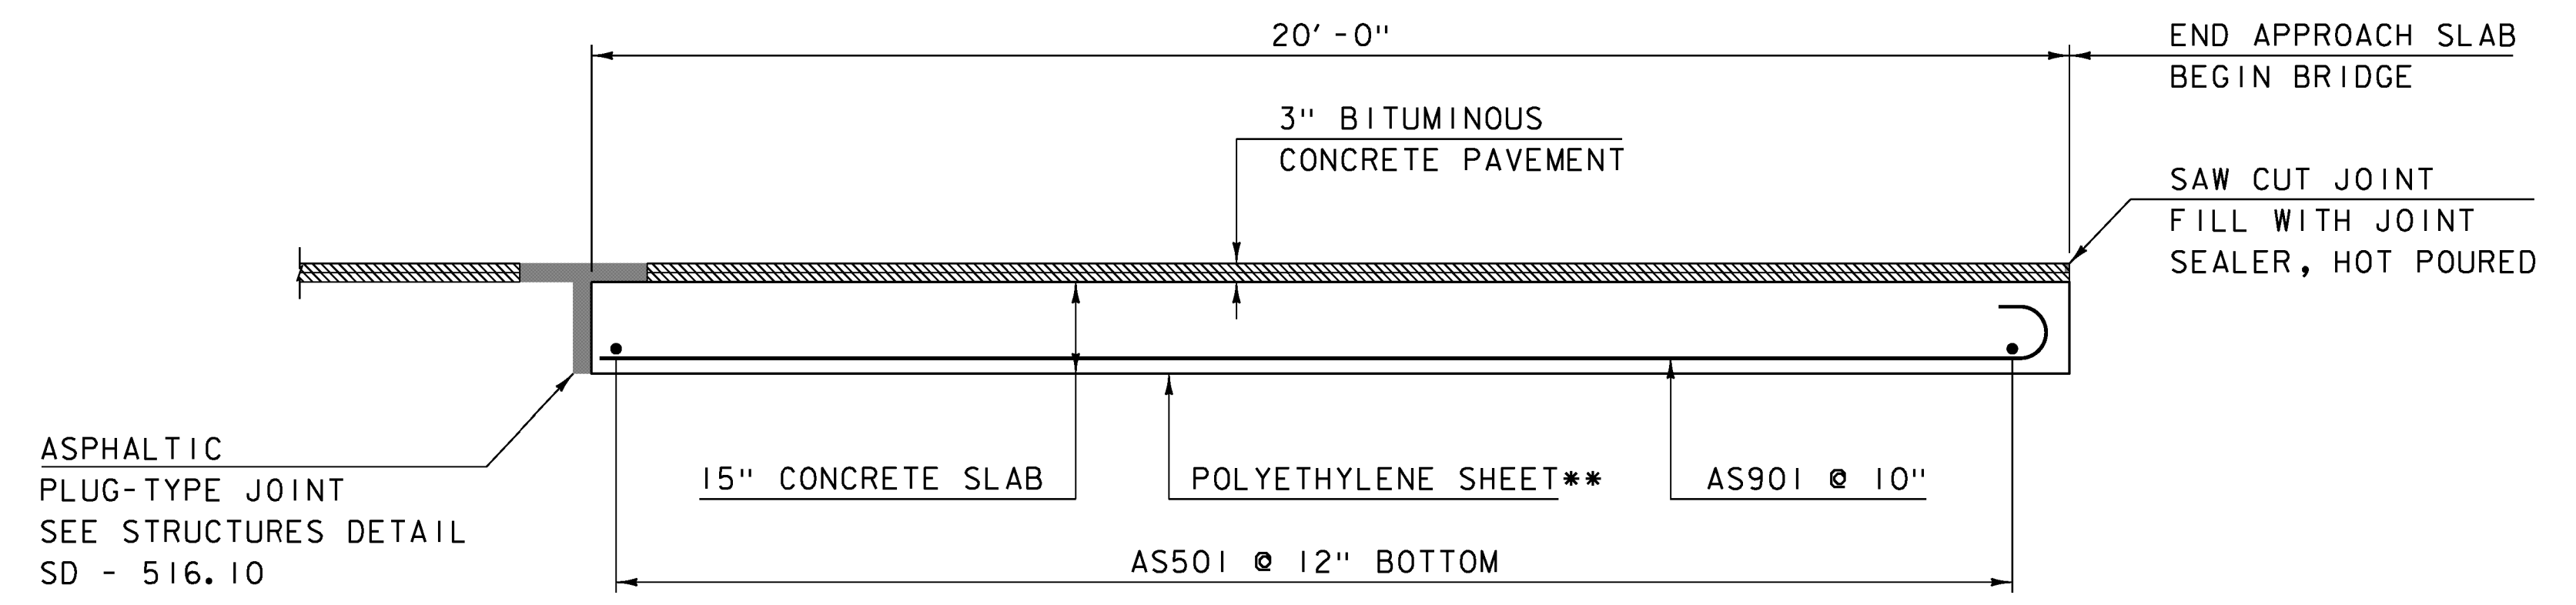

APPROACH SLAB DETAIL
SCALE 1/2" = 1'-0"

** THE POLYETHYLENE SHEET SHALL BE INCIDENTAL TO THE CONCRETE BID ITEM

PROJECT NAME:	JAMAICA
PROJECT NUMBER:	ER-BRF 015-1(23)
FILE NAME:	slb316sup.dgn
PROJECT LEADER:	K. HIGGINS
DESIGNED BY:	G. LAROCHE
APPROACH SLAB DETAILS	
PLOT DATE:	07-DEC-2012
DRAWN BY:	K. FRIEDLAND
CHECKED BY:	W. LAMMER
SHEET	38 OF 82