



ABUTMENT I PLAN
SCALE 1/4" = 1'-0"

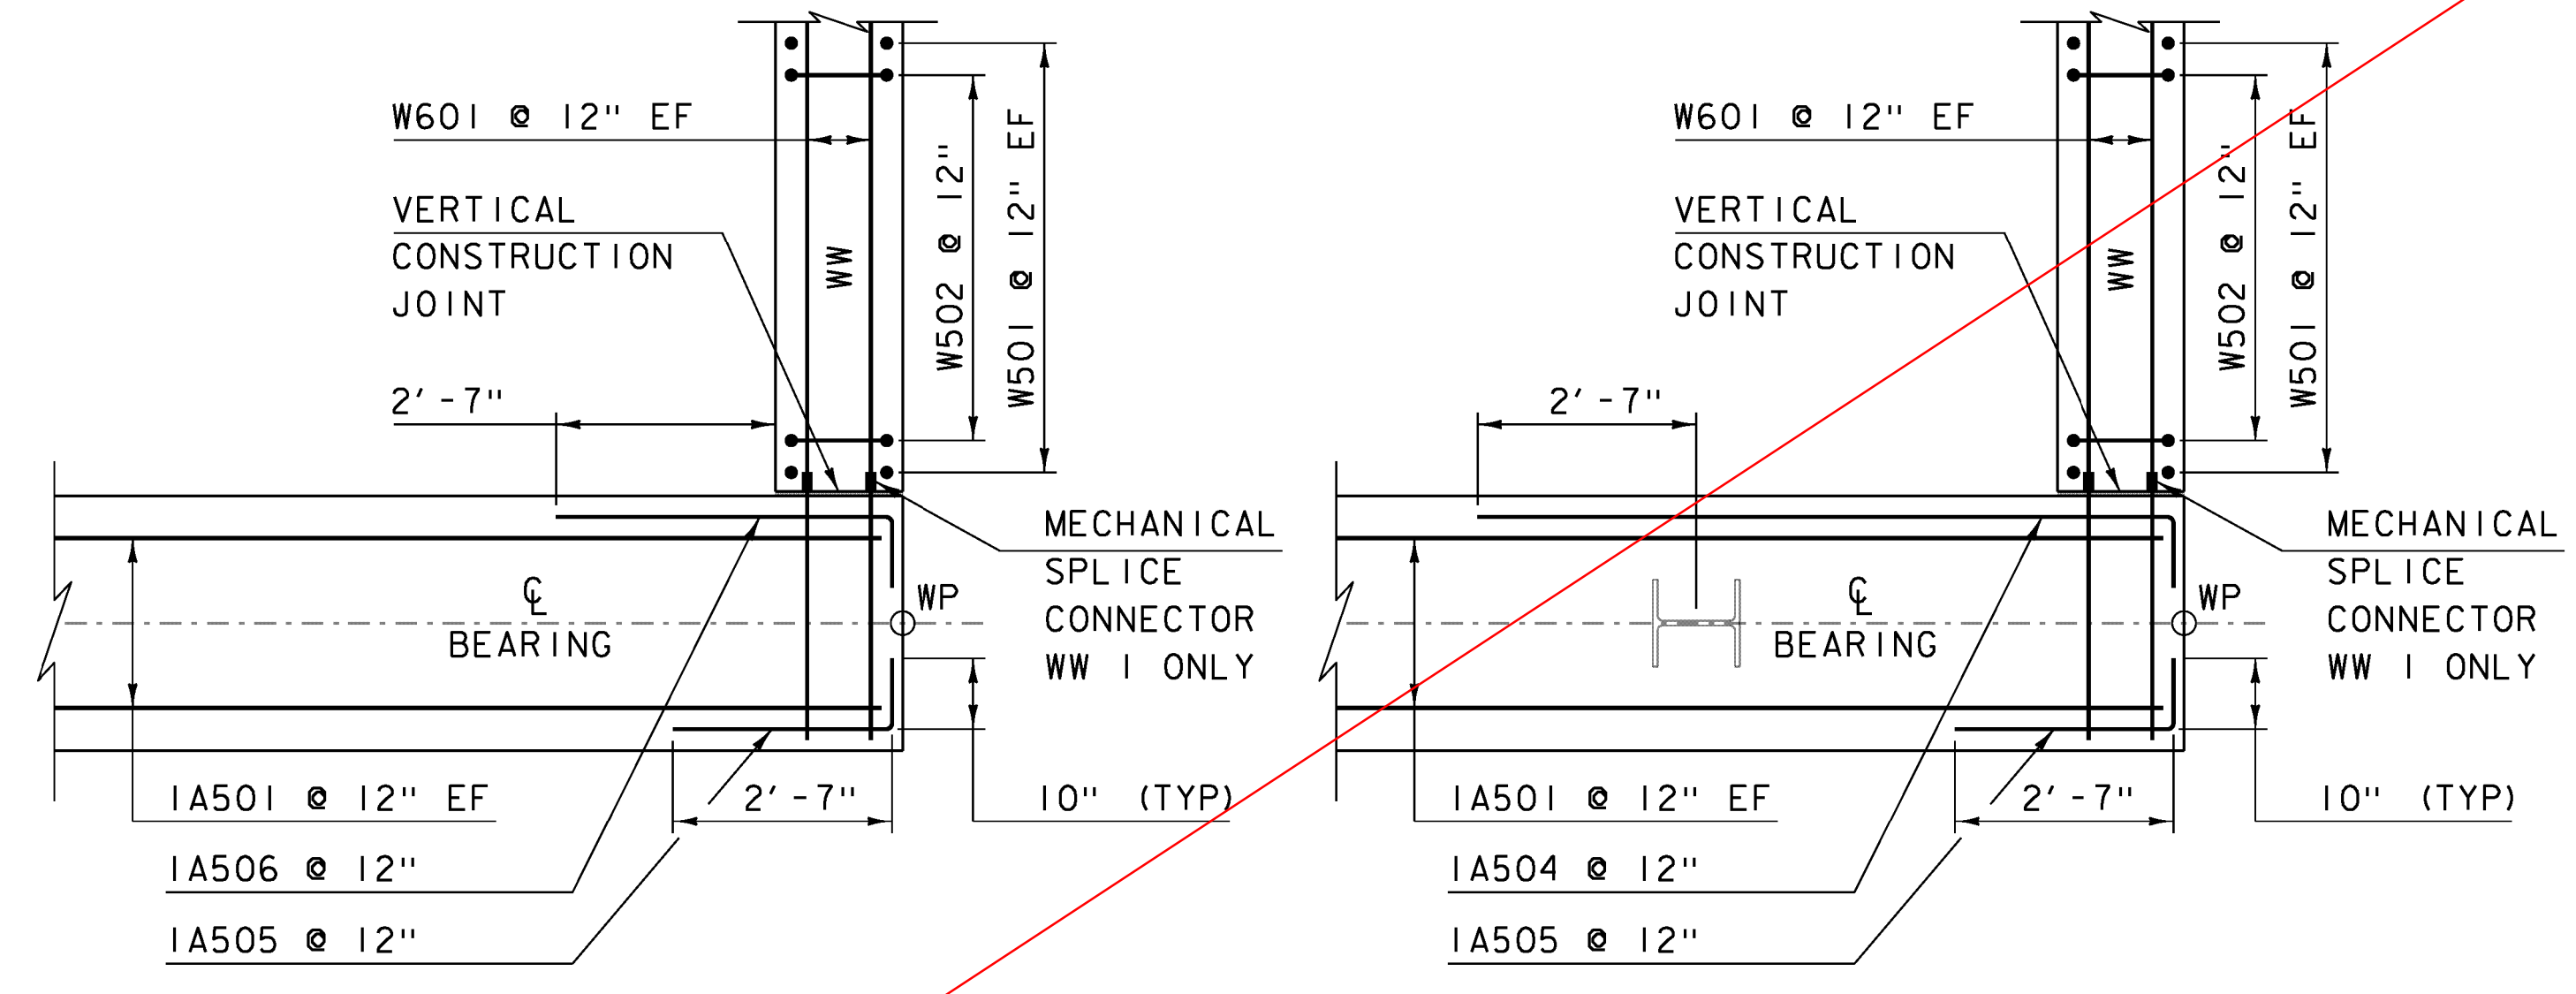


CORNER DETAIL ABOVE
BRIDGE SEAT
SCALE 1/2" = 1'-0"

CORNER DETAIL BELOW
BRIDGE SEAT
SCALE 1/2" = 1'-0"

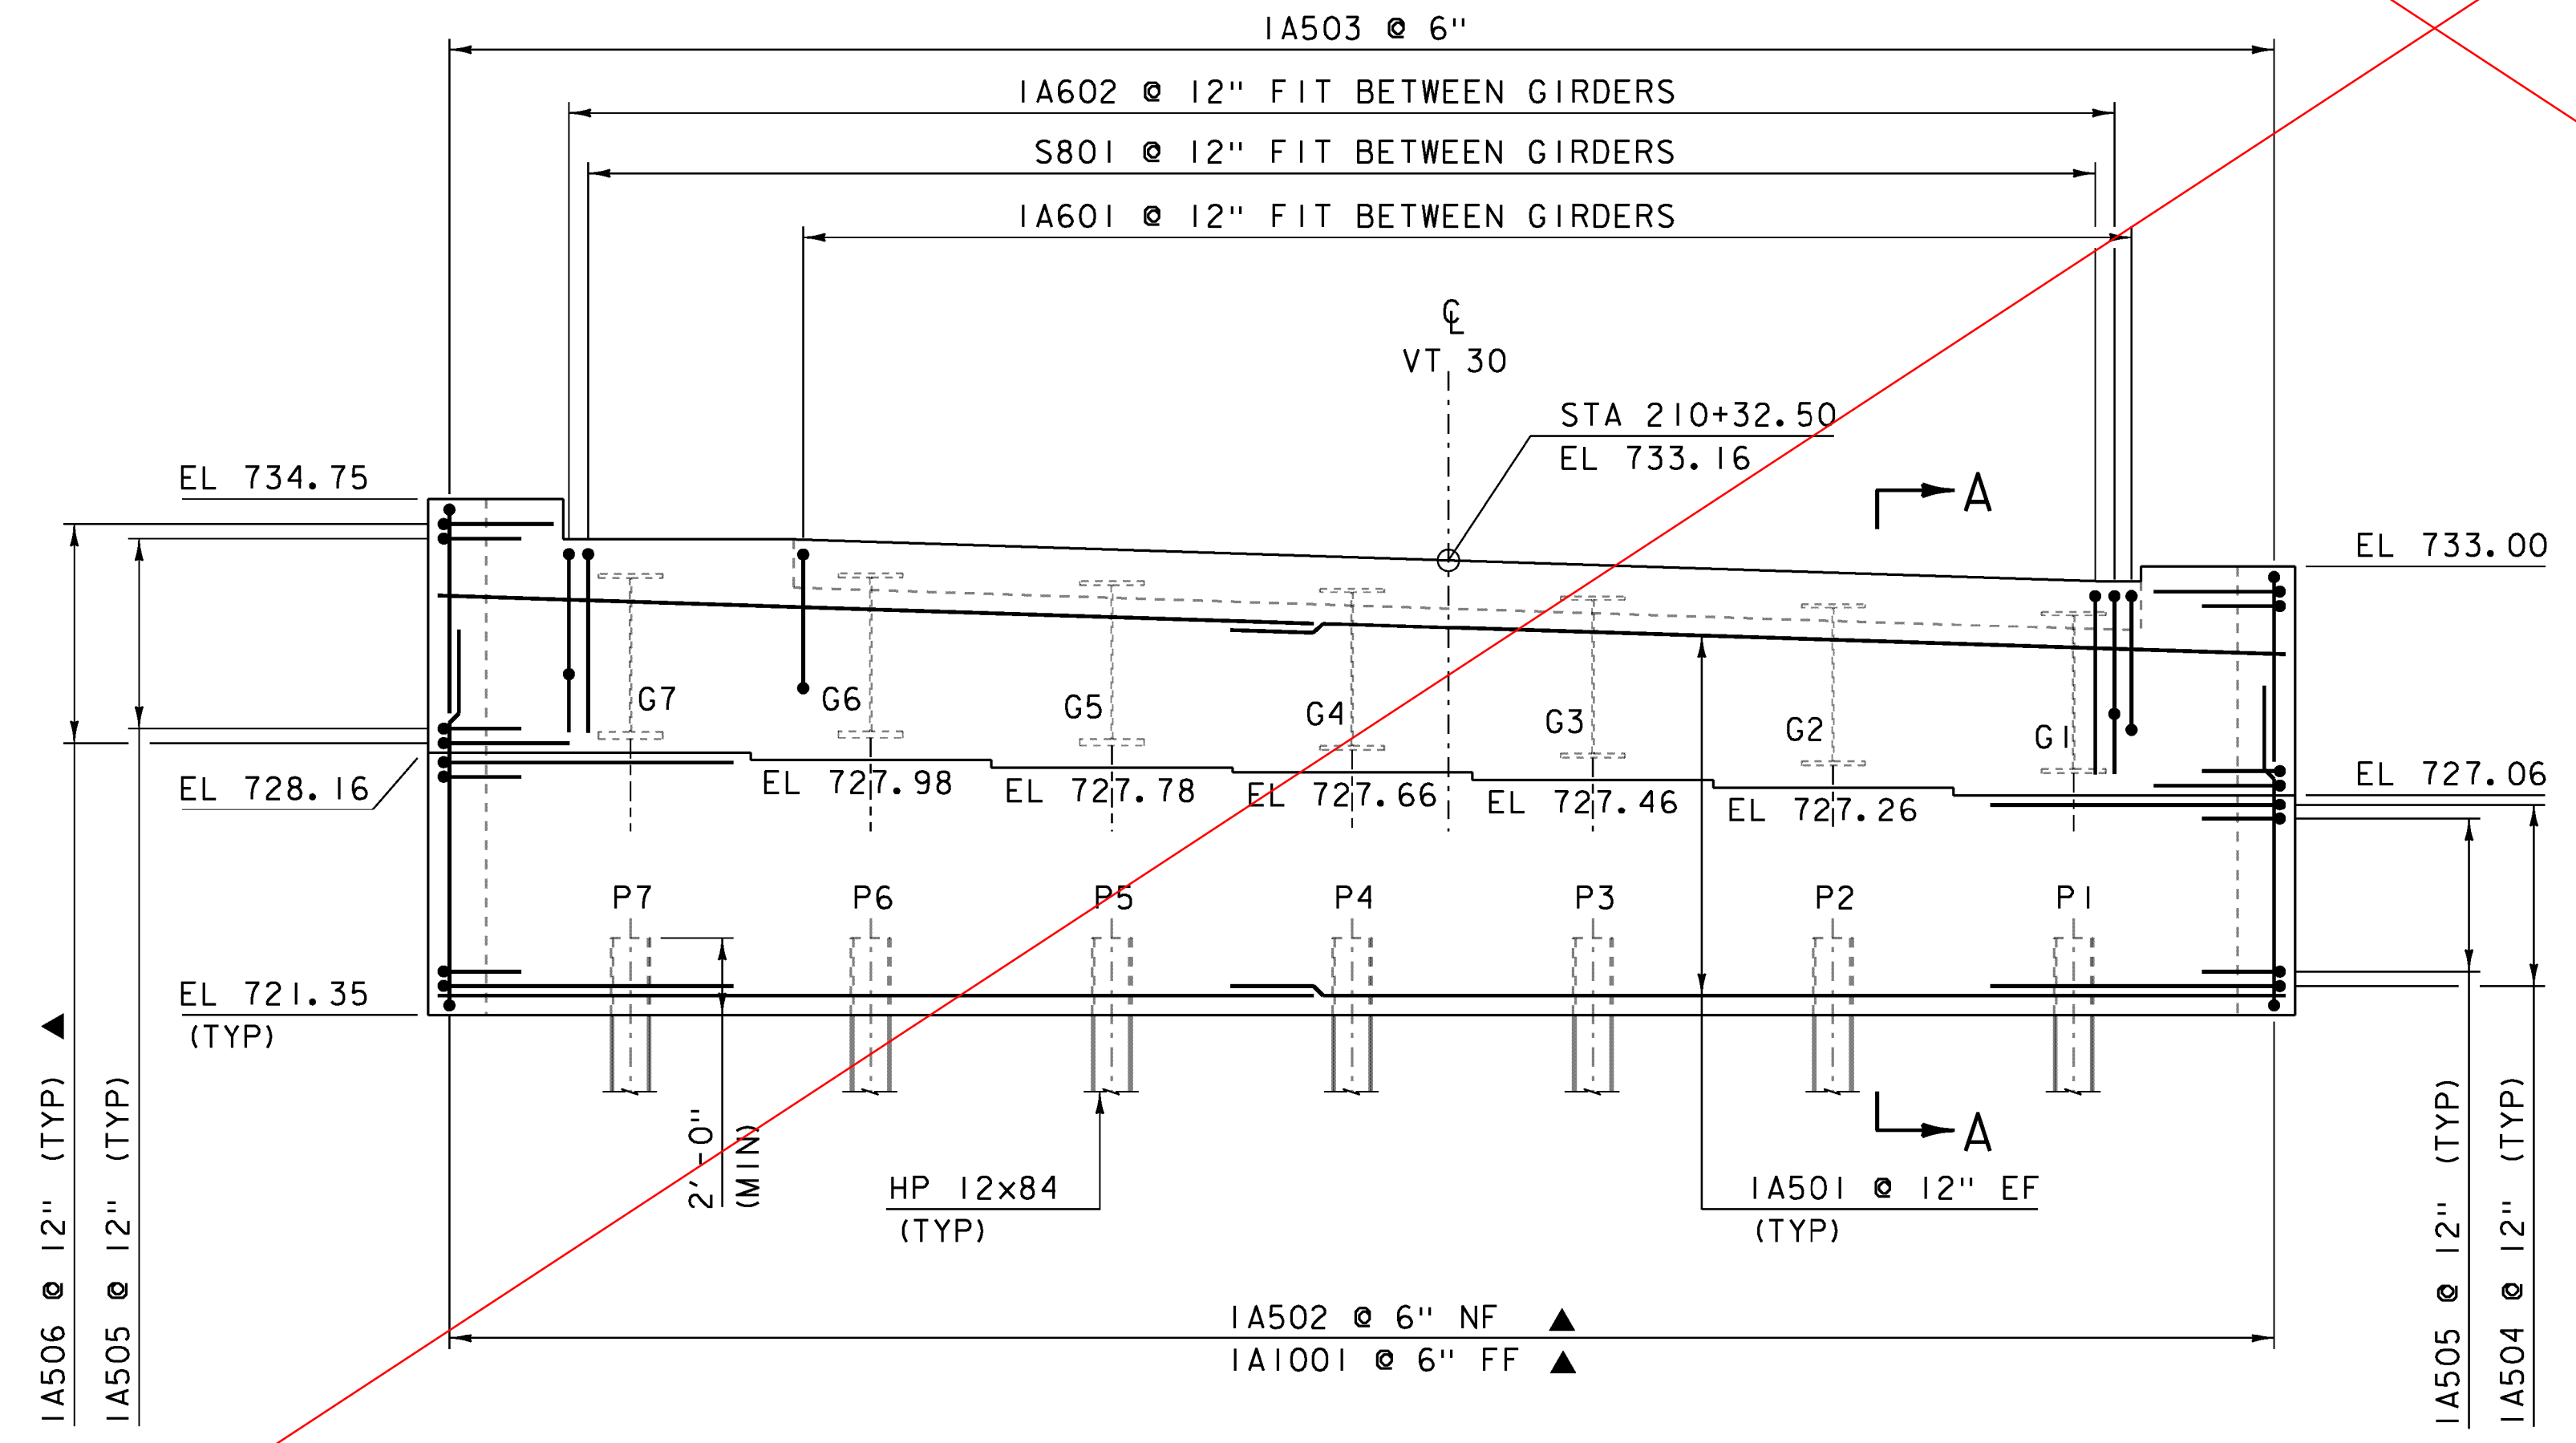

ABUTMENT I ELEVATION
SCALE 1/4" = 1'-0"

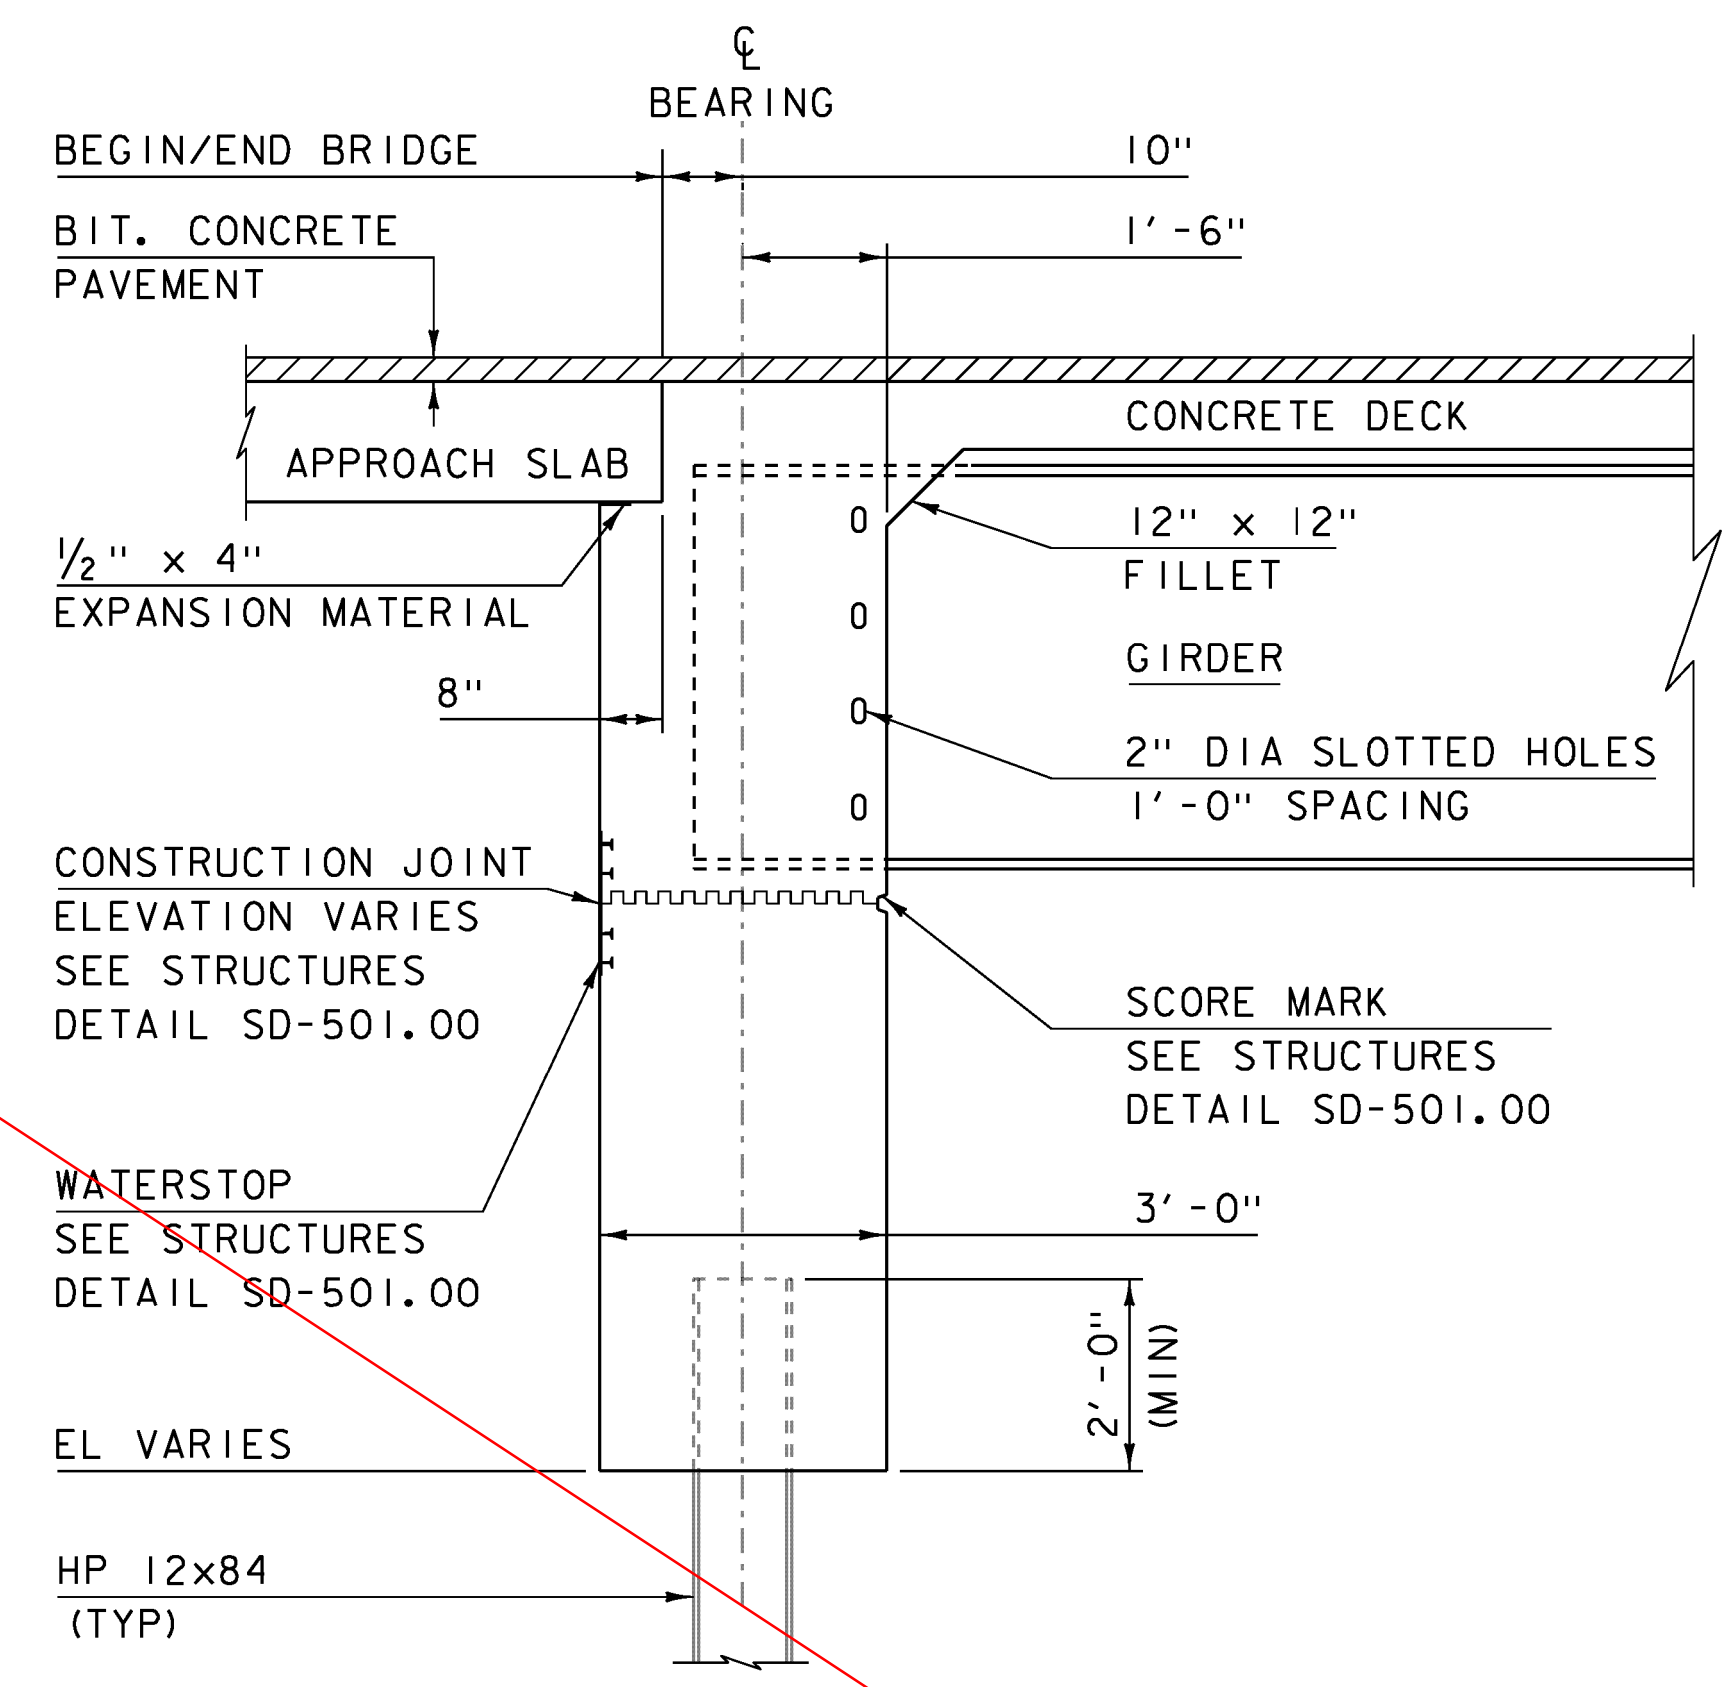

SECTION A-A
ABUTMENT TYPICAL SECTION
SCALE 1/2" = 1'-0"

* SEE ATTACHED REVISION
SHEET 39R
4-16-16

NOTE:
NF = NEAR FACE
FF = FAR FACE
EF = EACH FACE
▲ = CUT TO FIT IN FIELD
3" CLEAR, UNLESS OTHERWISE
SPECIFIED ON THE PLANS.
2'-7" BAR LAP UNLESS OTHERWISE
SPECIFIED ON THE PLANS.

PROJECT NAME:	JAMAICA	PLOT DATE:	14-DEC-2012
PROJECT NUMBER:	ER-BRF 015-1(23)	DRAWN BY:	K. FRIEDLAND
FILE NAME:	s1lb316sub.dgn	DESIGNED BY:	G. LAROCHE
PROJECT LEADER:	K. HIGGINS	CHECKED BY:	W. LAMMER
ABUTMENT I			SHEET 39 OF 82