


WINGWALL I ELEVATION
SCALE 1"=1'-0"

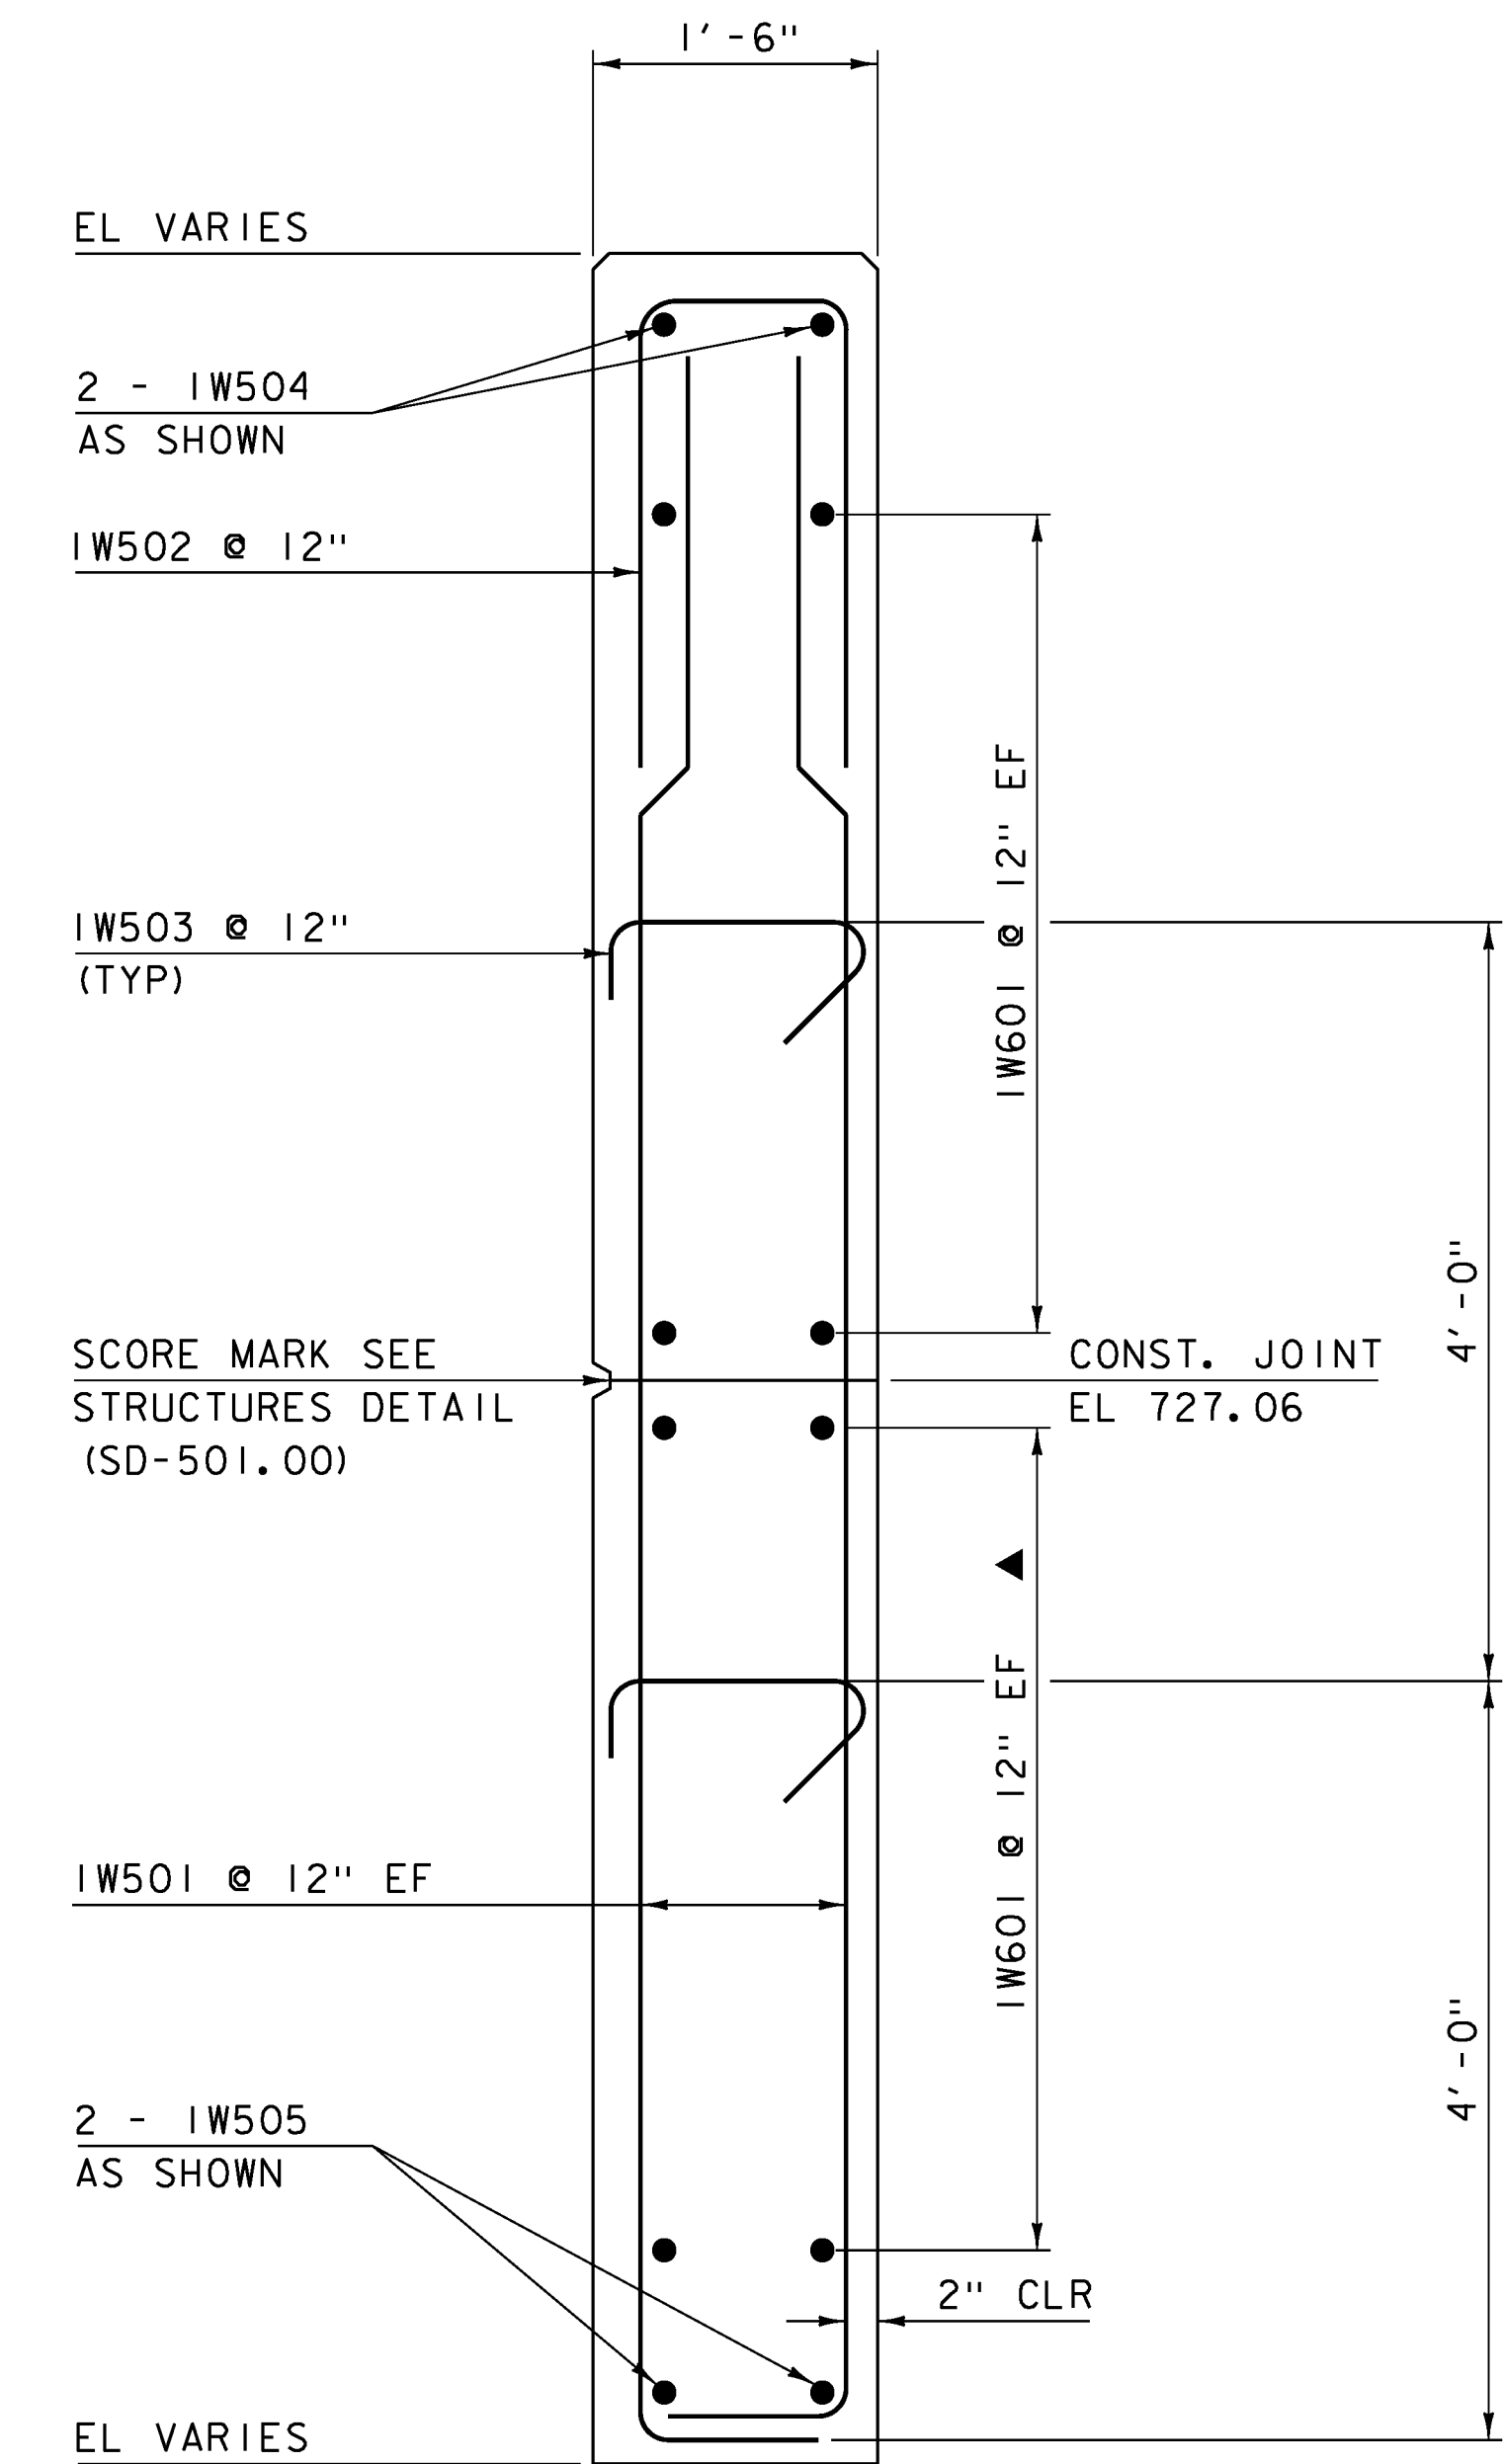

WINGWALL I TYPICAL SECTION
SCALE 1"=1'-0"

NOTES:
1. EPOXY SHALL BE INCIDENTAL TO CONCRETE BID ITEMS.

NOTE:
NF = NEAR FACE
FF = FAR FACE
EF = EACH FACE
▲ = CUT TO FIT IN FIELD
3" CLEAR, UNLESS OTHERWISE SPECIFIED ON THE PLANS.
2'-7" BAR LAP UNLESS OTHERWISE SPECIFIED ON THE PLANS.

PROJECT NAME: JAMAICA	PLOT DATE: 07-DEC-2012
PROJECT NUMBER: ER-BRF 015-1(23)	DRAWN BY: K. FRIEDLAND
FILE NAME: s11b212sub.dgn	CHECKED BY: W. LAMMER
PROJECT LEADER: K. HIGGINS	SHEET 41 OF 82
DESIGNED BY: G. LAROCHE	
WINGWALL #1	