




209+00

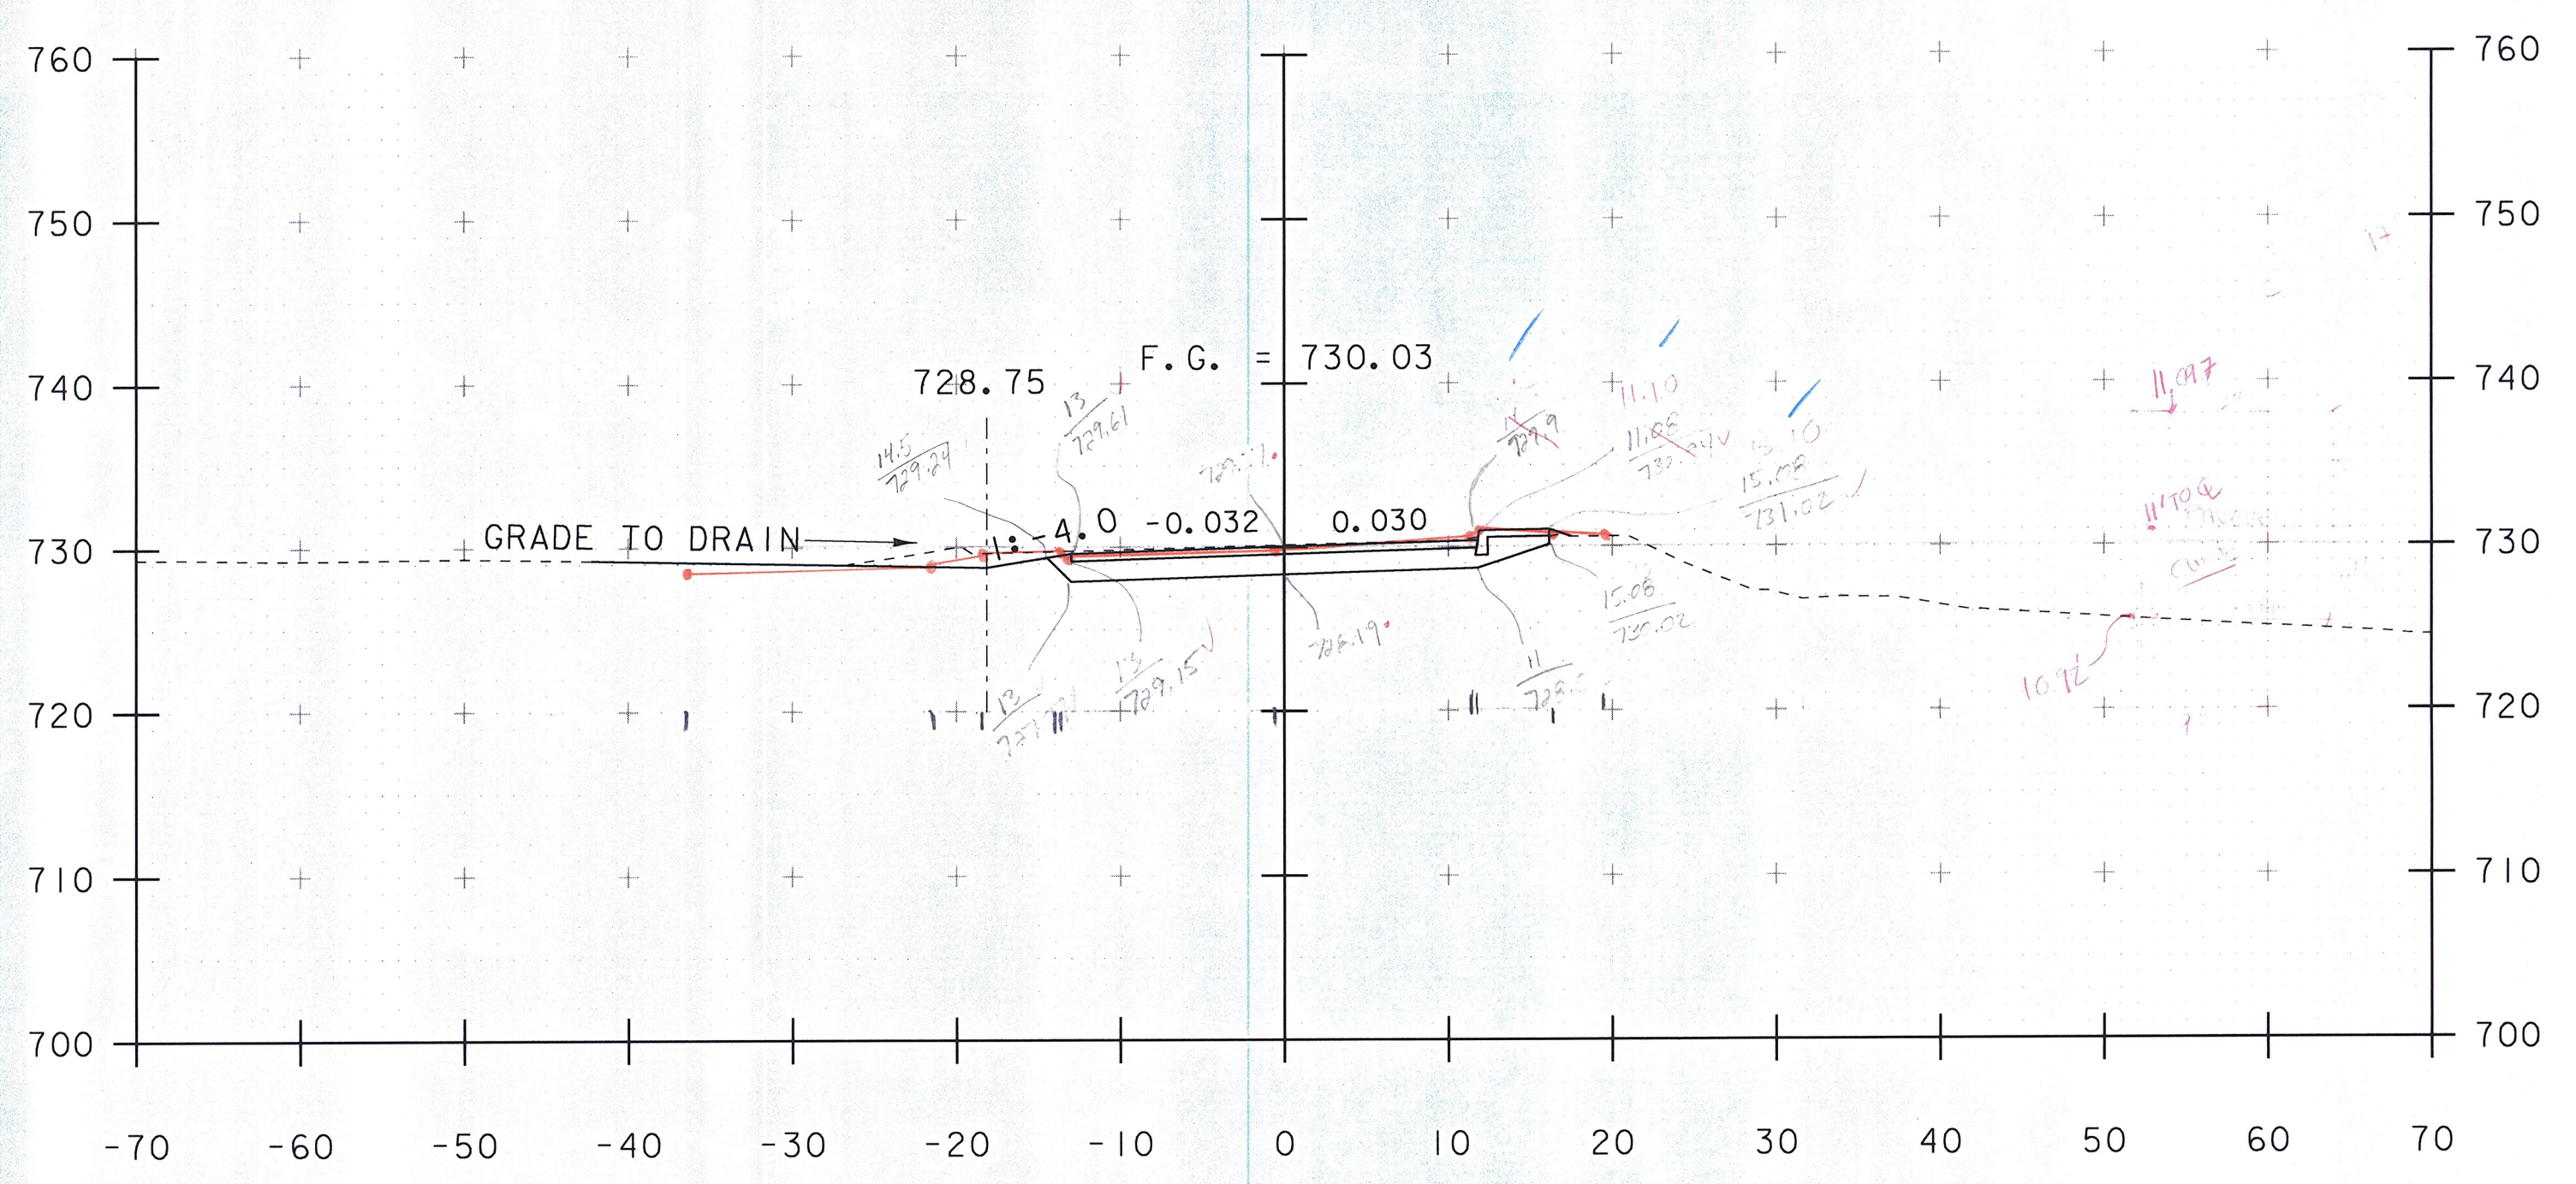

209+50

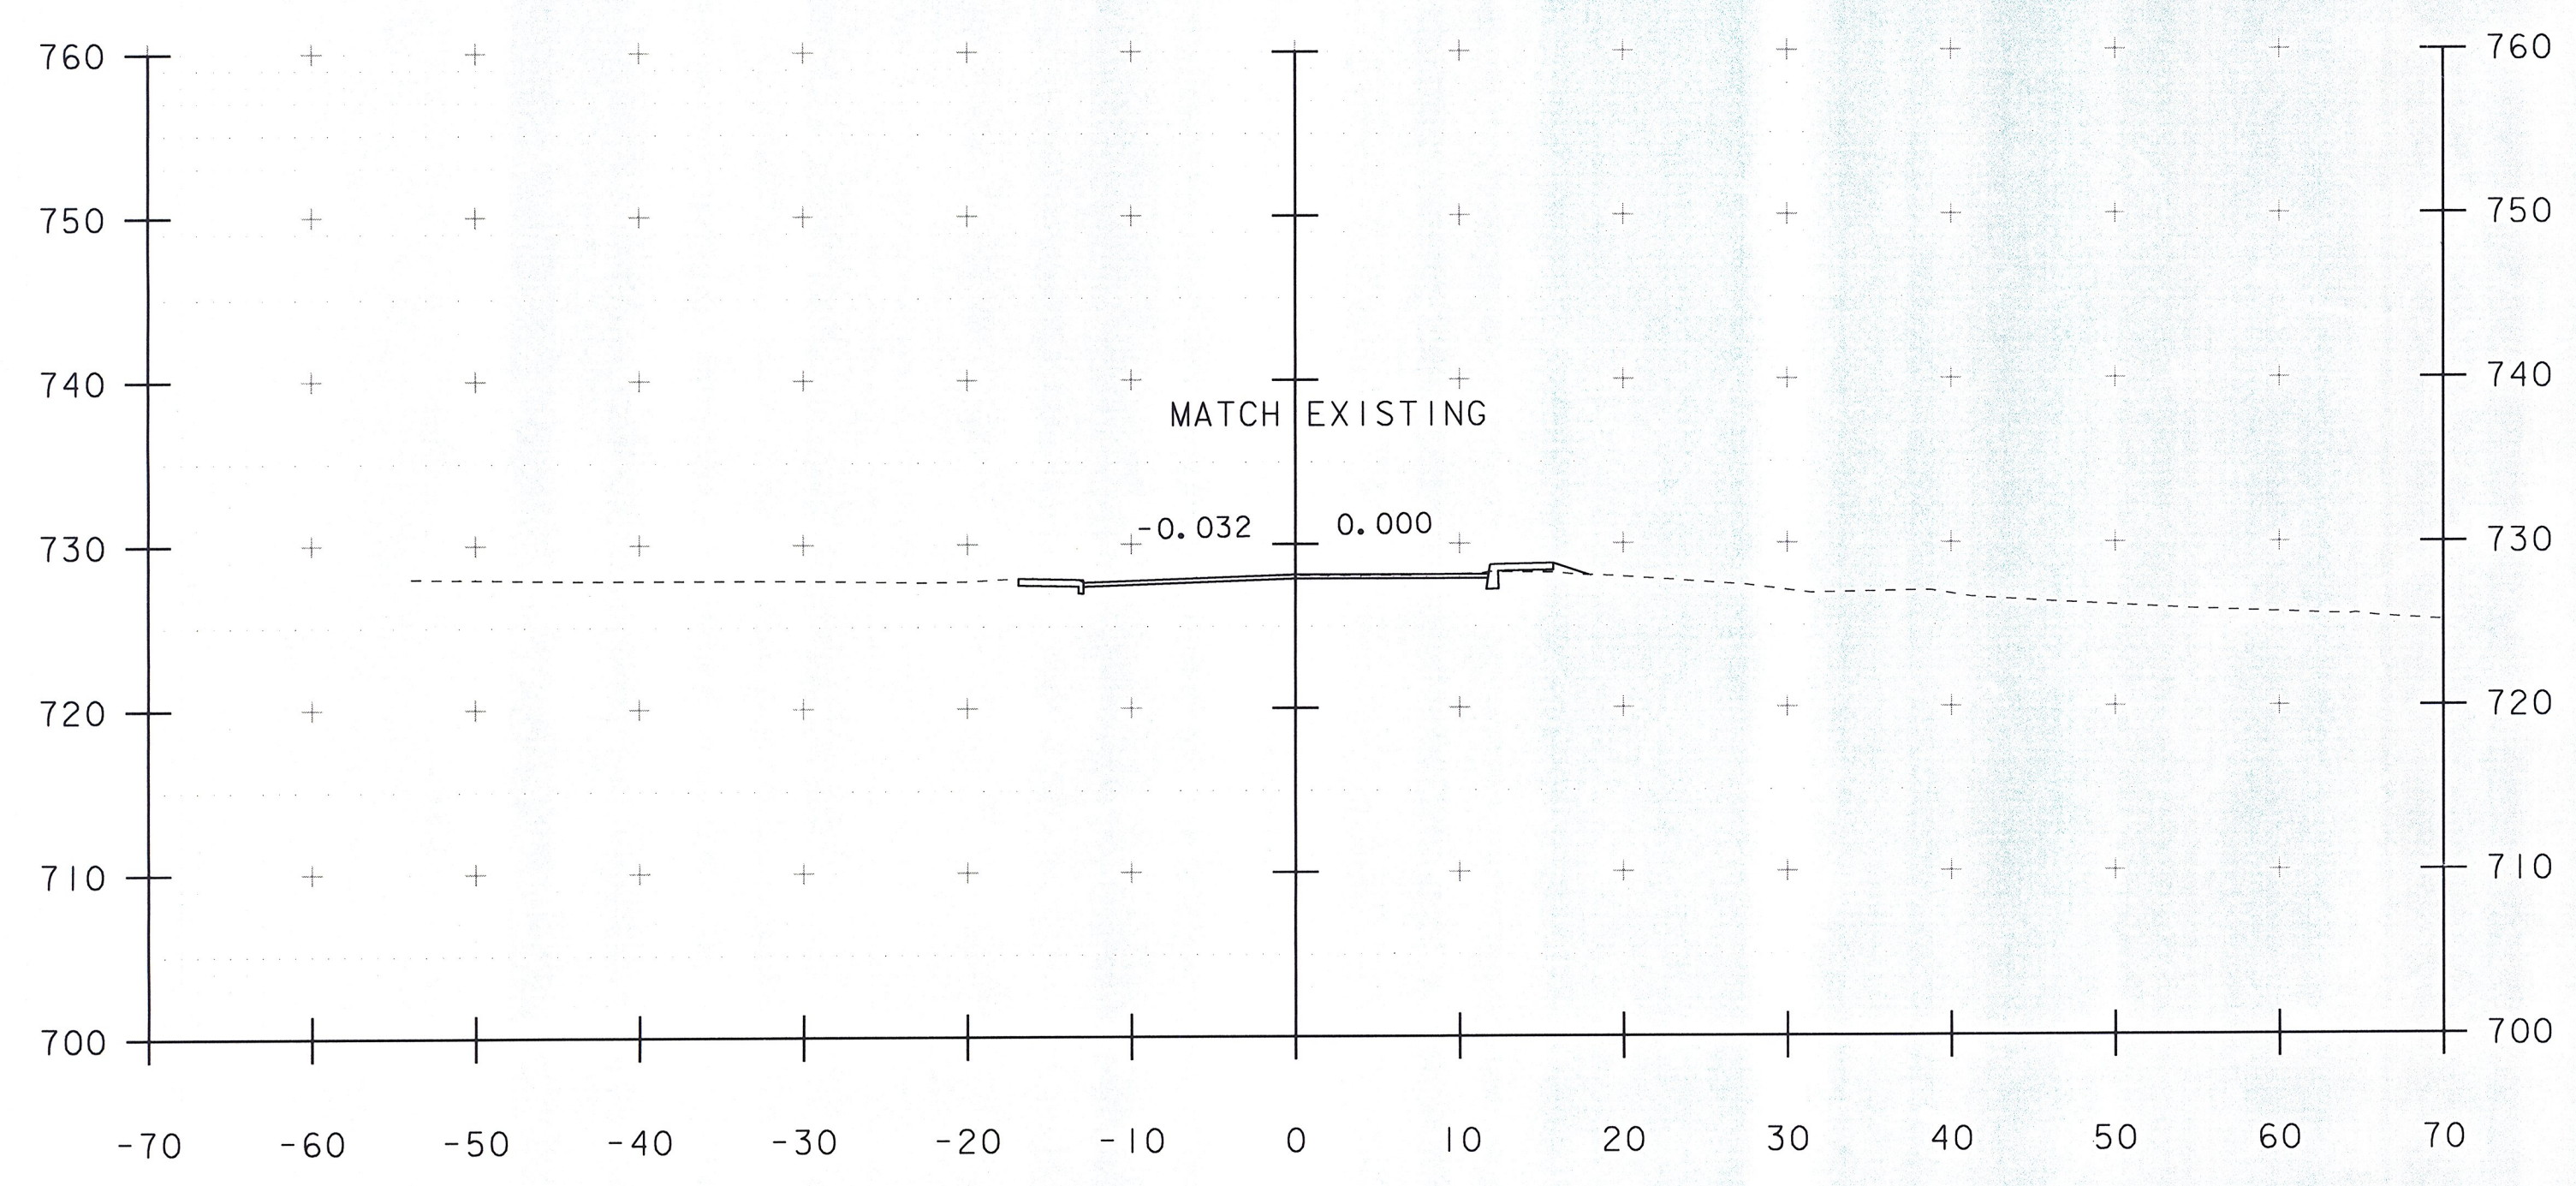

208+75
BEGIN APPROACH

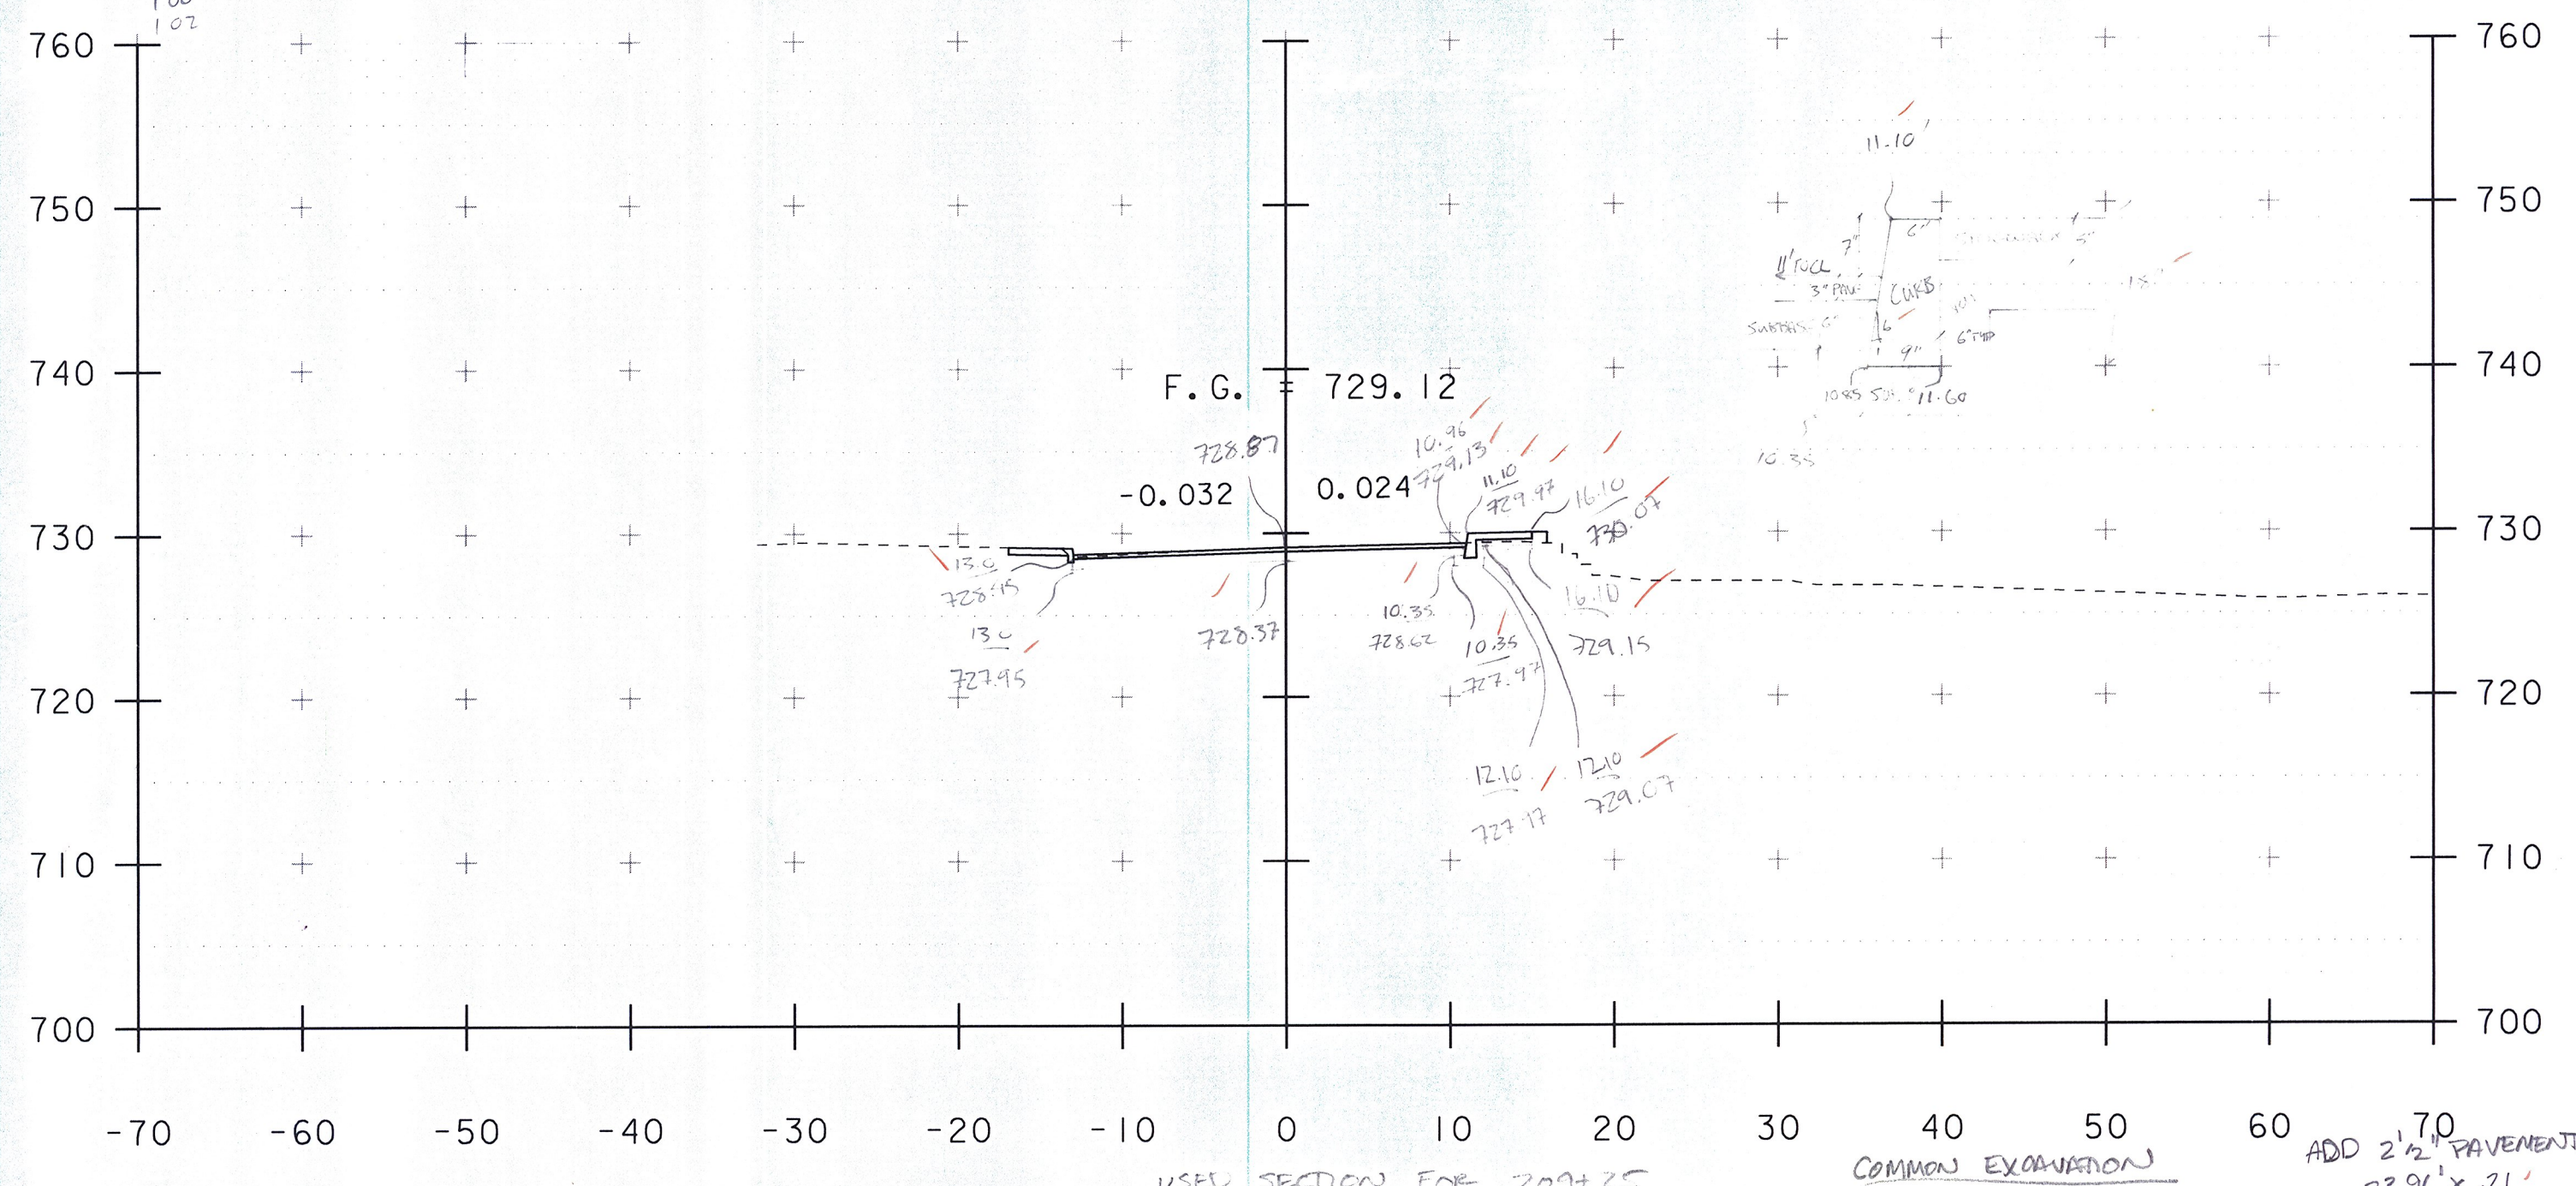

209+20

SCALE 1" = 10' - 0"
10 0 10

STA. 208+75 TO STA. 209+50

PROJECT NAME:	JAMAICA	PLOT DATE:	07-DEC-2012
PROJECT NUMBER:	ER-BRF 015-1 (23)	DRAWN BY:	K. FRIEDLAND
FILE NAME:	slib316.xs.dgn	CHECKED BY:	G. LAROCHE
PROJECT LEADER:	K. HIGGINS	SHEET	56 OF 82
DESIGNED BY:	G. LAROCHE		
MAINLINE SECTIONS I			

COMMON EXCAVATION
 ADD 2" PAVEMENT (BASE COURSE)
 $23.96' \times .21' = 4.99 \text{ SF}$
 $.21 \text{ AVG} \times 100 = 21 \text{ SF}$
 $21 + 4.99 = 25.99 \text{ SF}$
 3.0% SINK
 2.5% SINK