



213+75

Common Exc
 .58
 .55
 .52
 1.62/3 = .56 x 100 = 56.0 FT

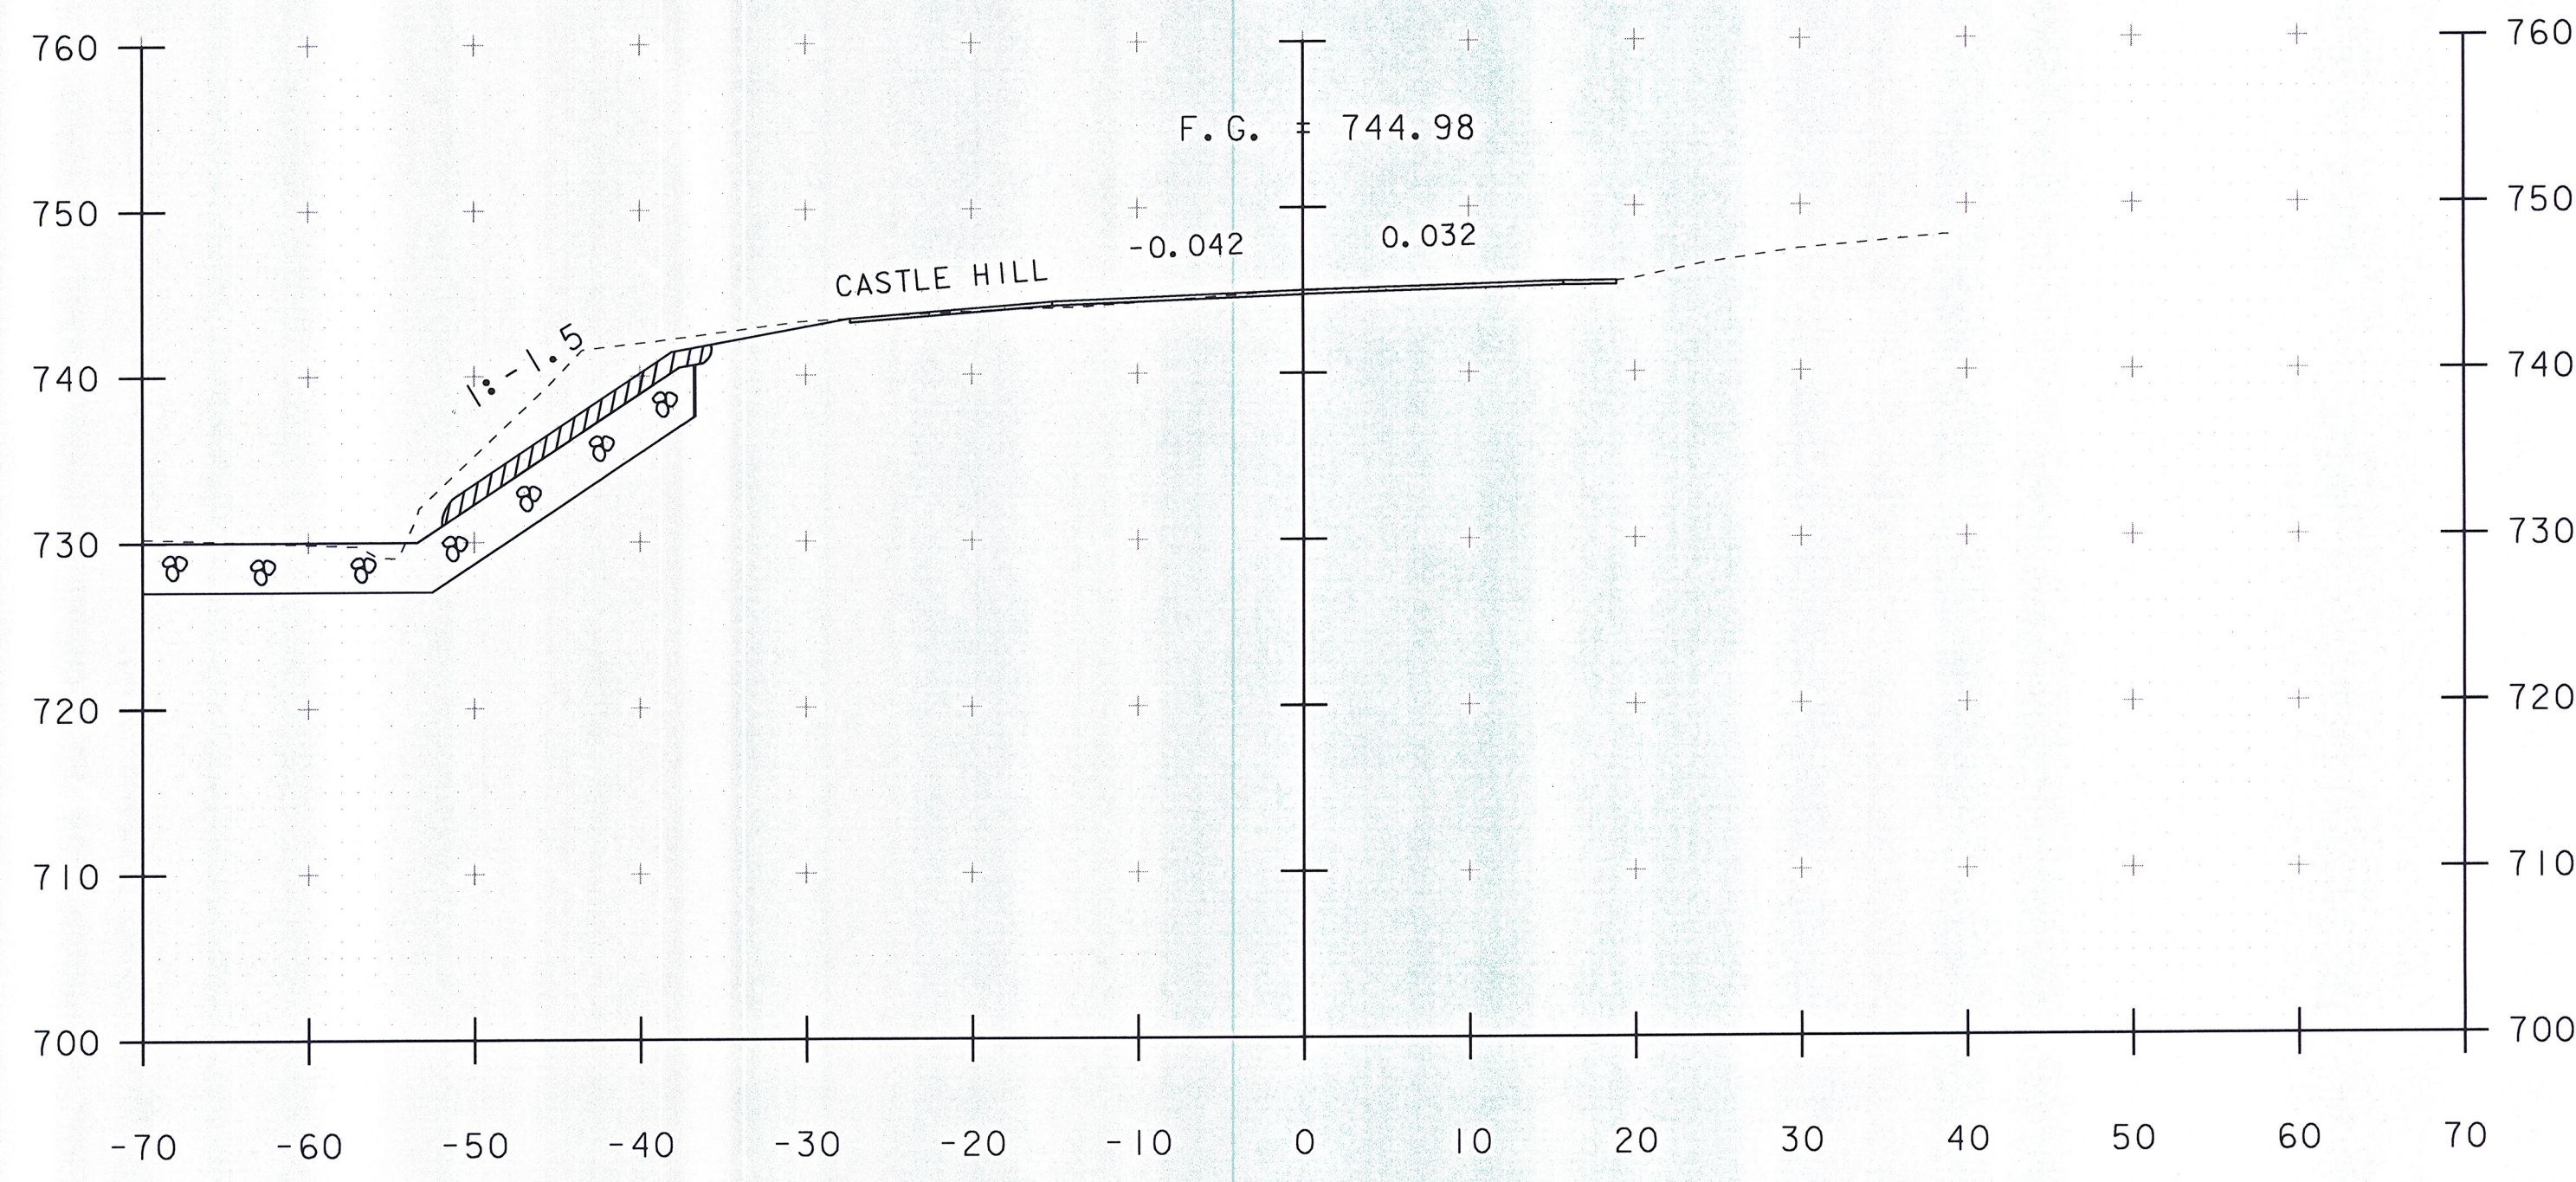


214+25

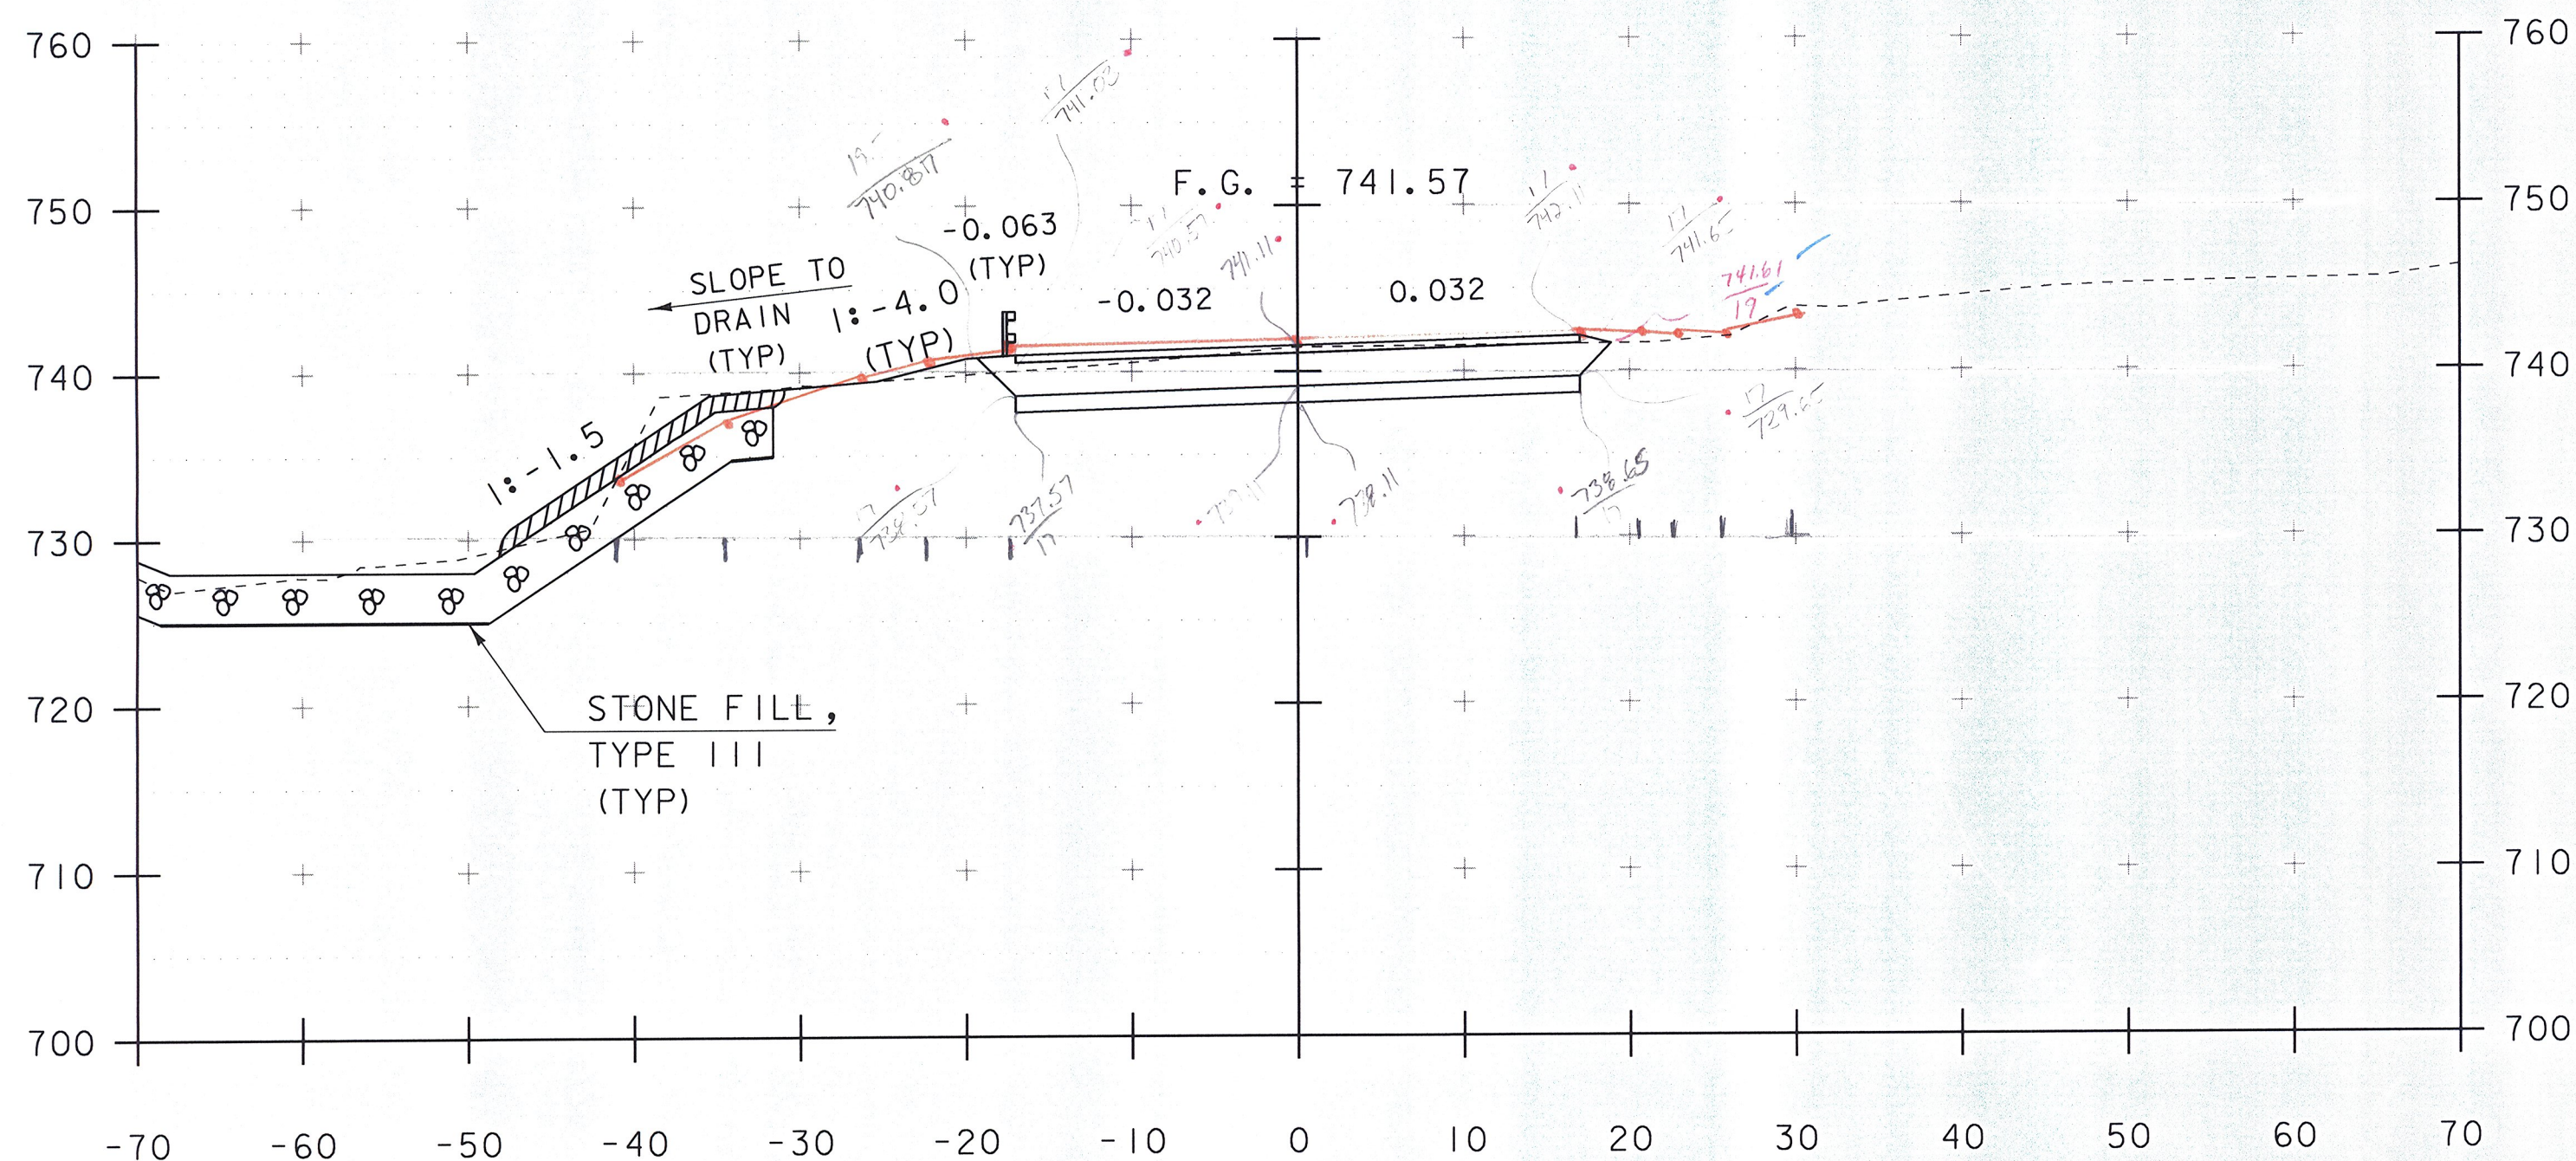

213+50
 END PROJECT

Common Excavation
 1.02
 1.01
 1.03
 3.04/3 = 1.0133 x 100 = 101.33 FT

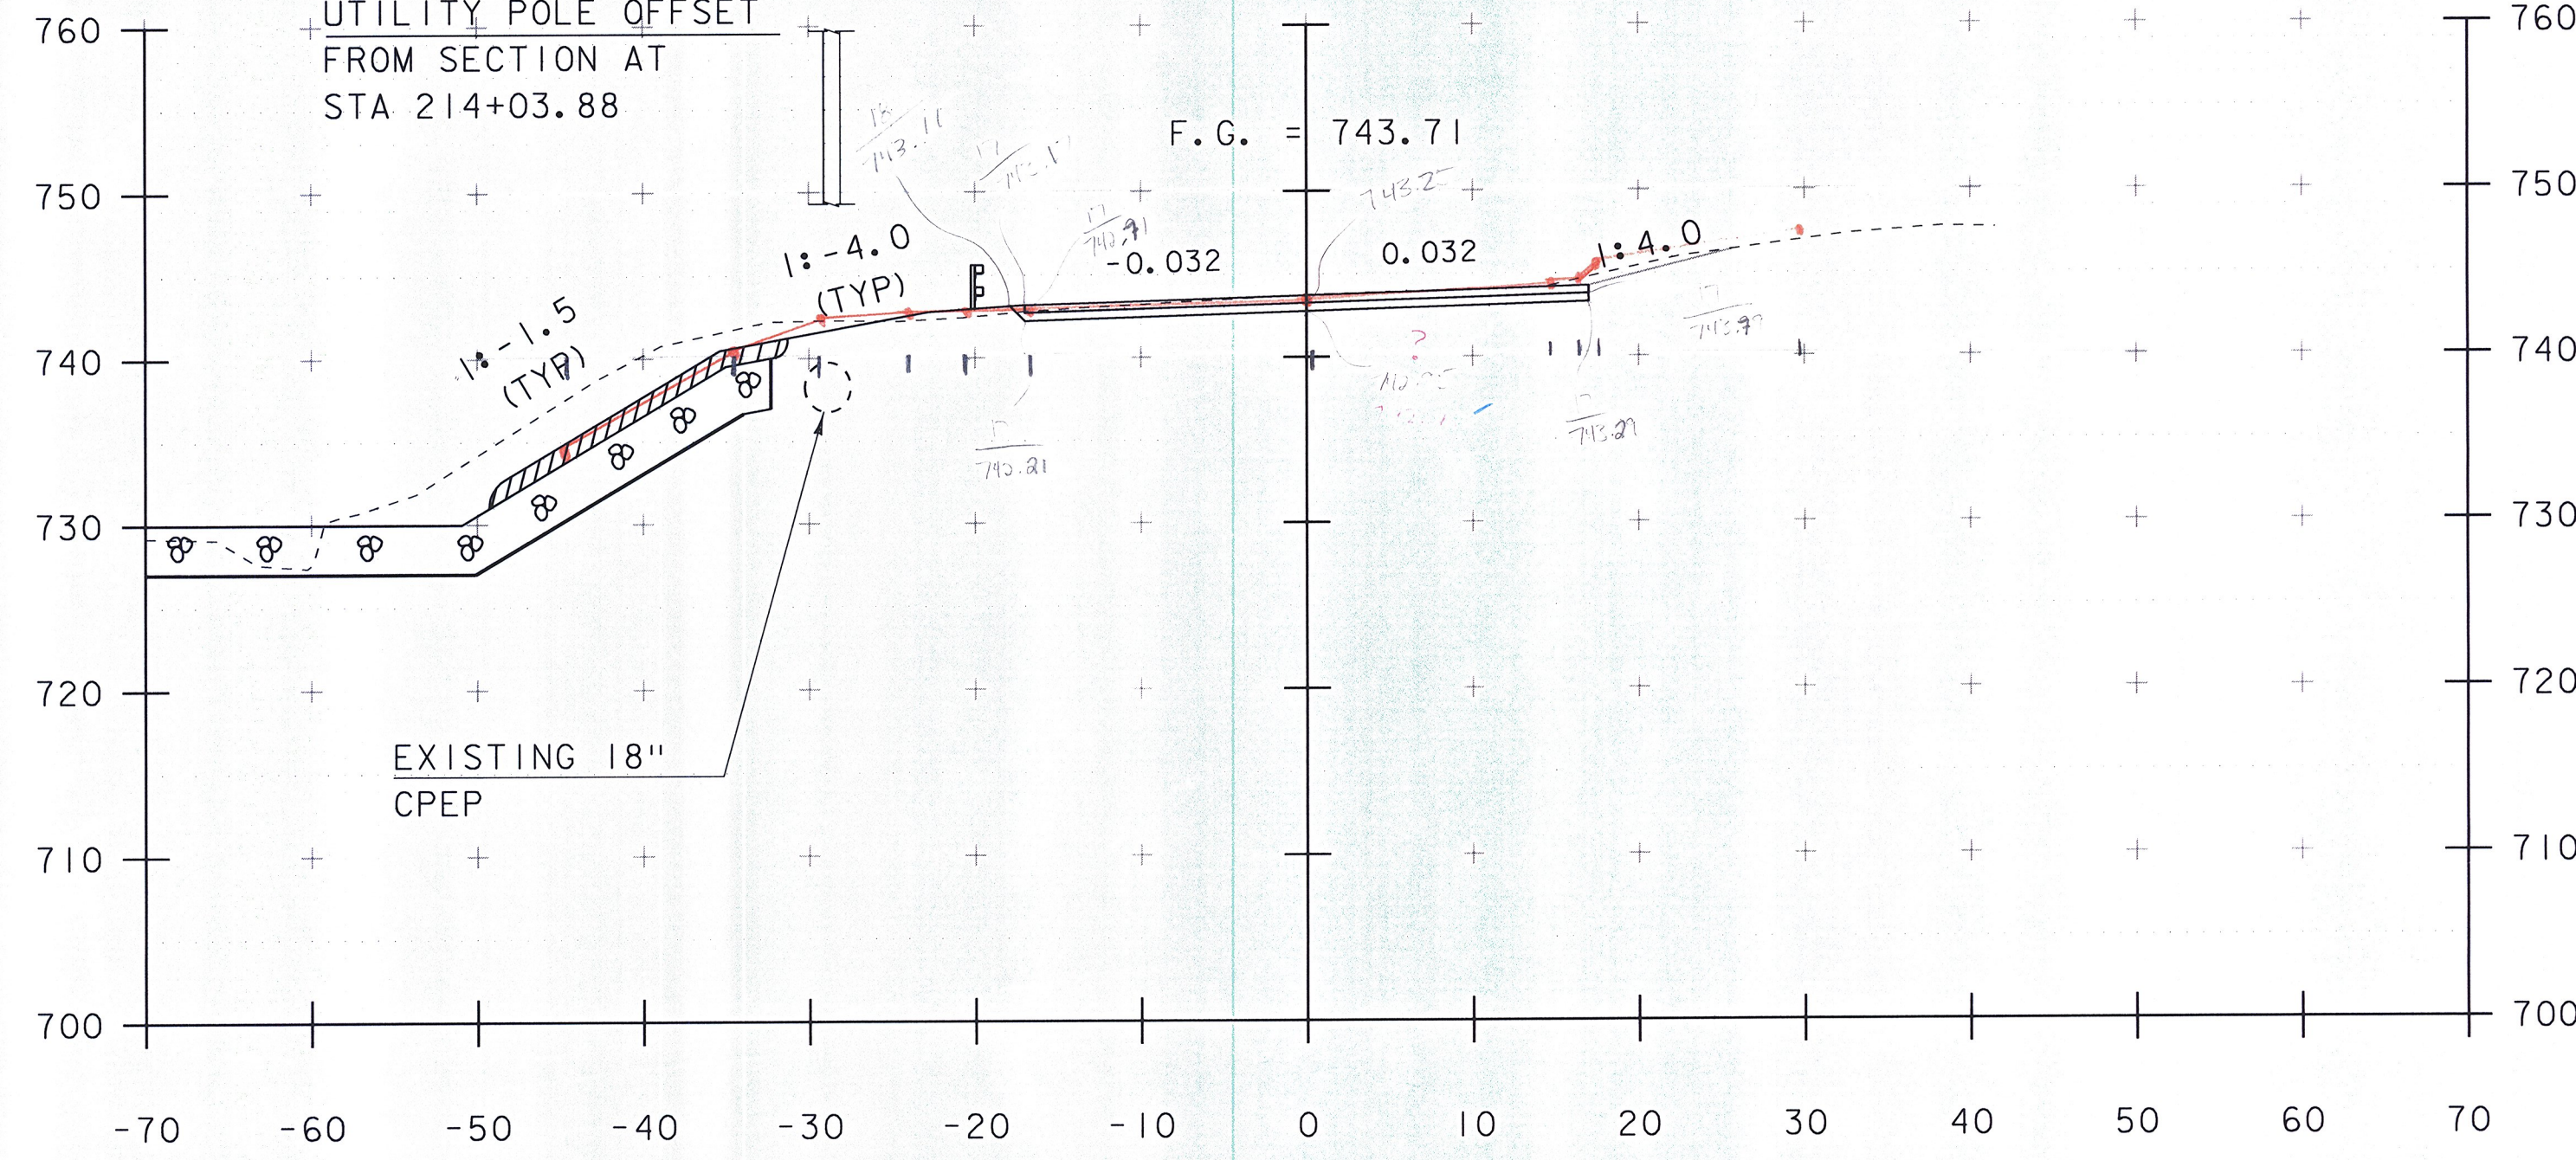

214+00

Common Exc
 .37
 .32
 .34
 1.07/3 = .3567 x 100 = 35.67 FT

SCALE 1" = 10'-0"
 10 0 10

STA. 213+50 TO STA. 214+25

PROJECT NAME: JAMAICA	
PROJECT NUMBER: ER-BRF 015-1(23)	
FILE NAME: s1b316.xs.dgn	PLOT DATE: 07-DEC-2012
PROJECT LEADER: K. HIGGINS	DRAWN BY: K. FRIEDLAND
DESIGNED BY: G. LAROCHE	CHECKED BY: G. LAROCHE
MAINLINE SECTIONS 5	SHEET 60 OF 82