



31+25
END WATER ST

Subbase + Curbs
16' x 0.5' = 8 SF

MFL
P/S/H
BRW
11/22/14

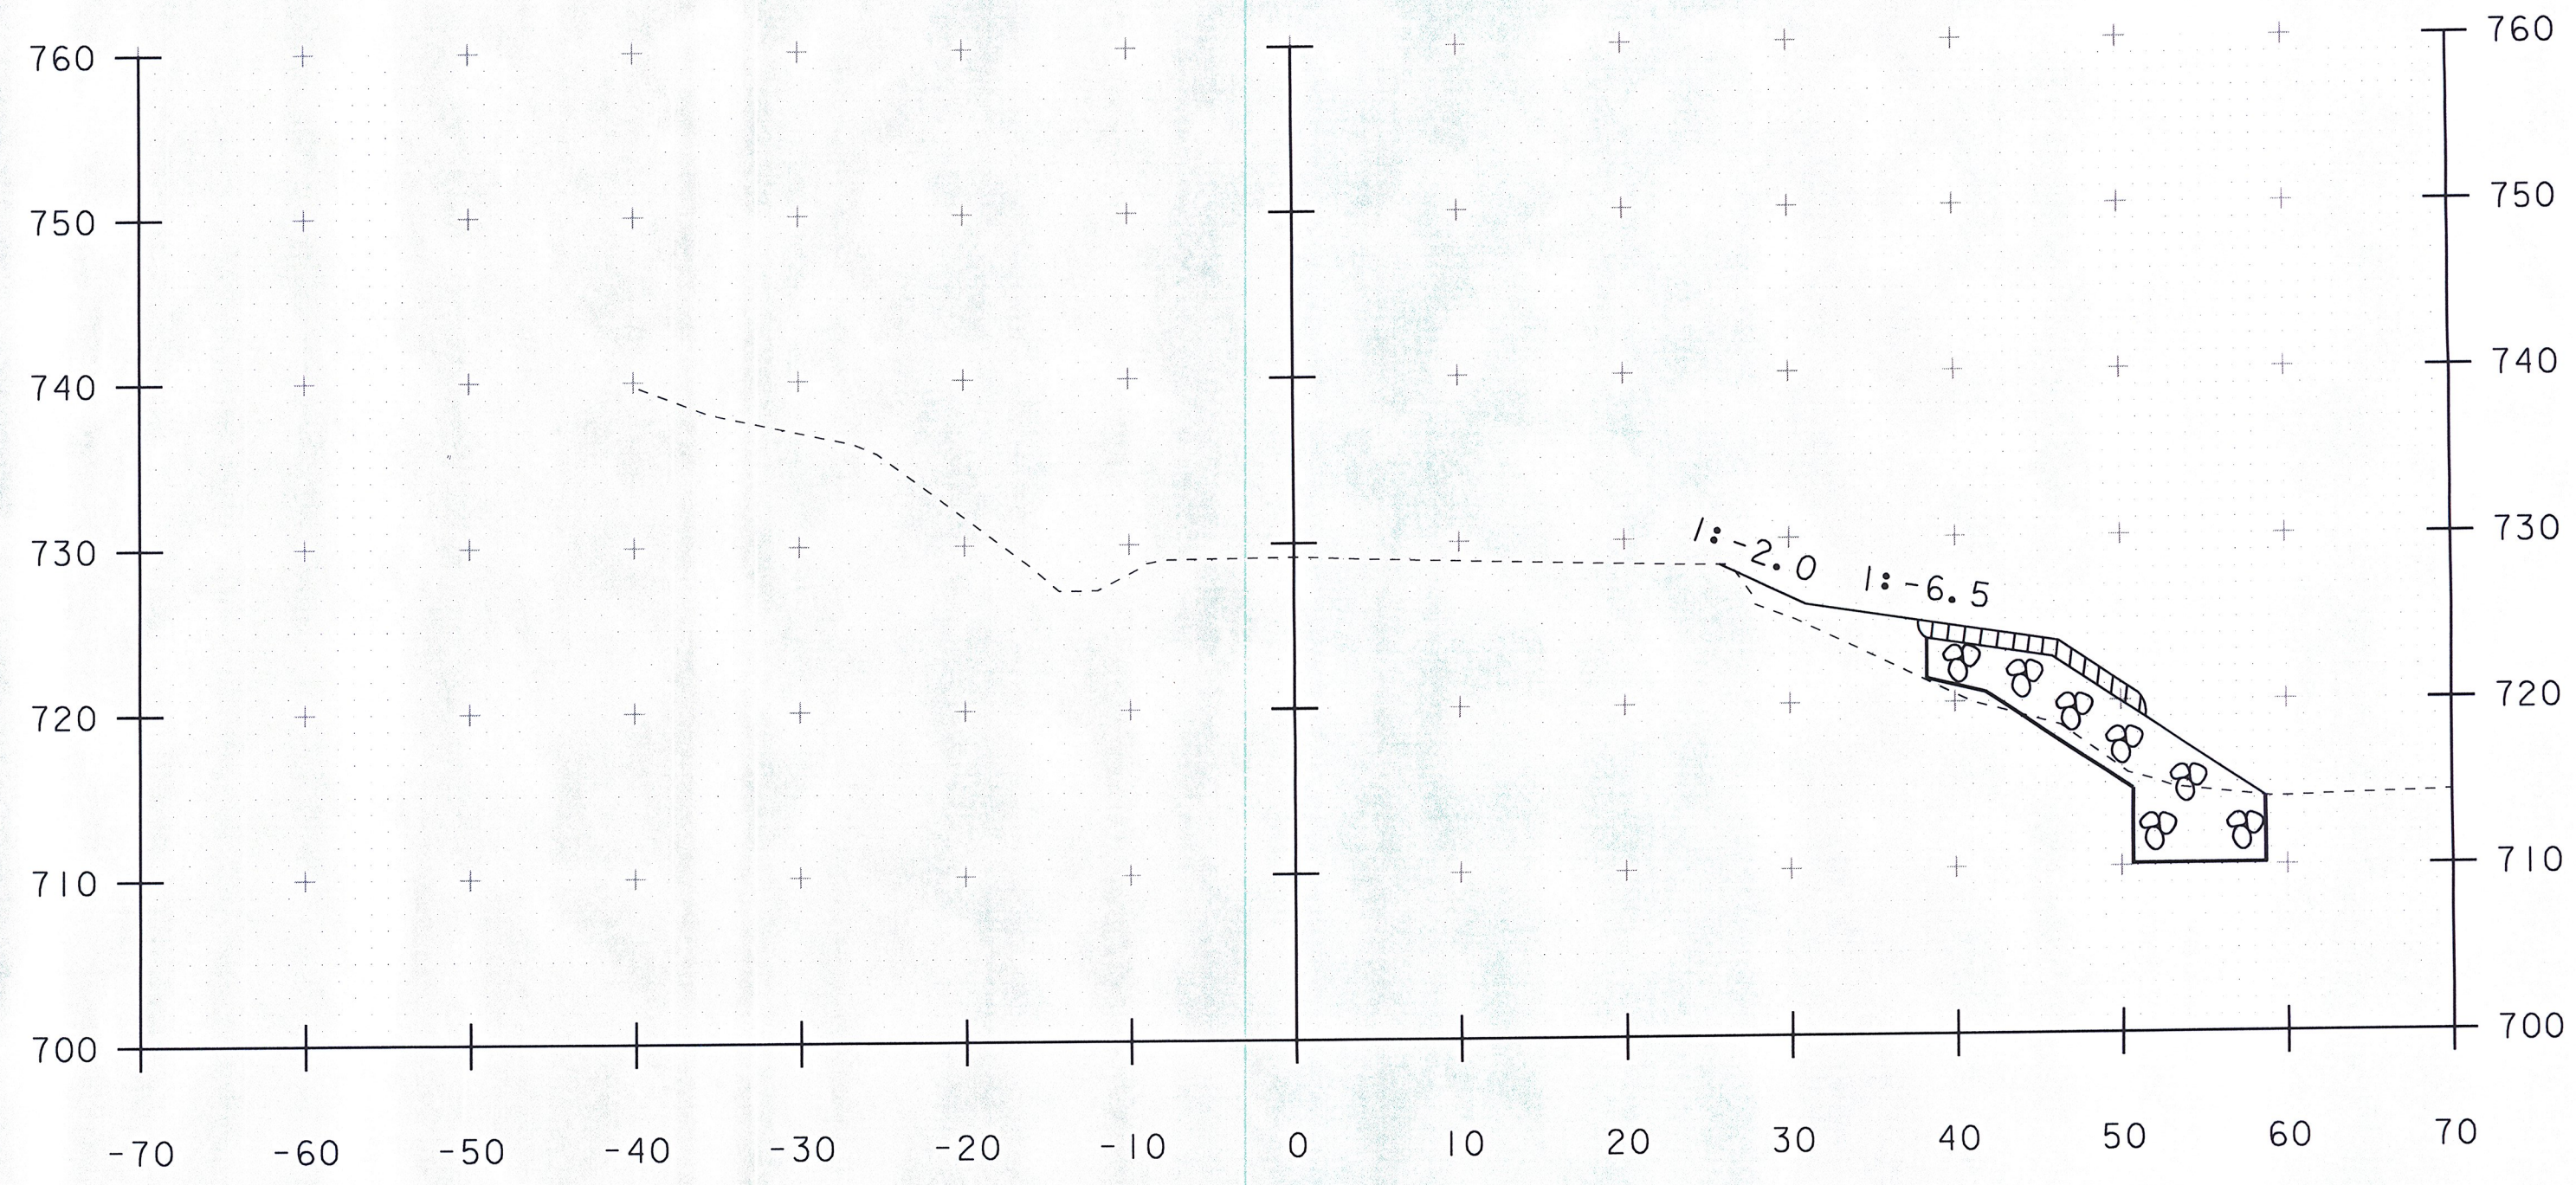


31+75

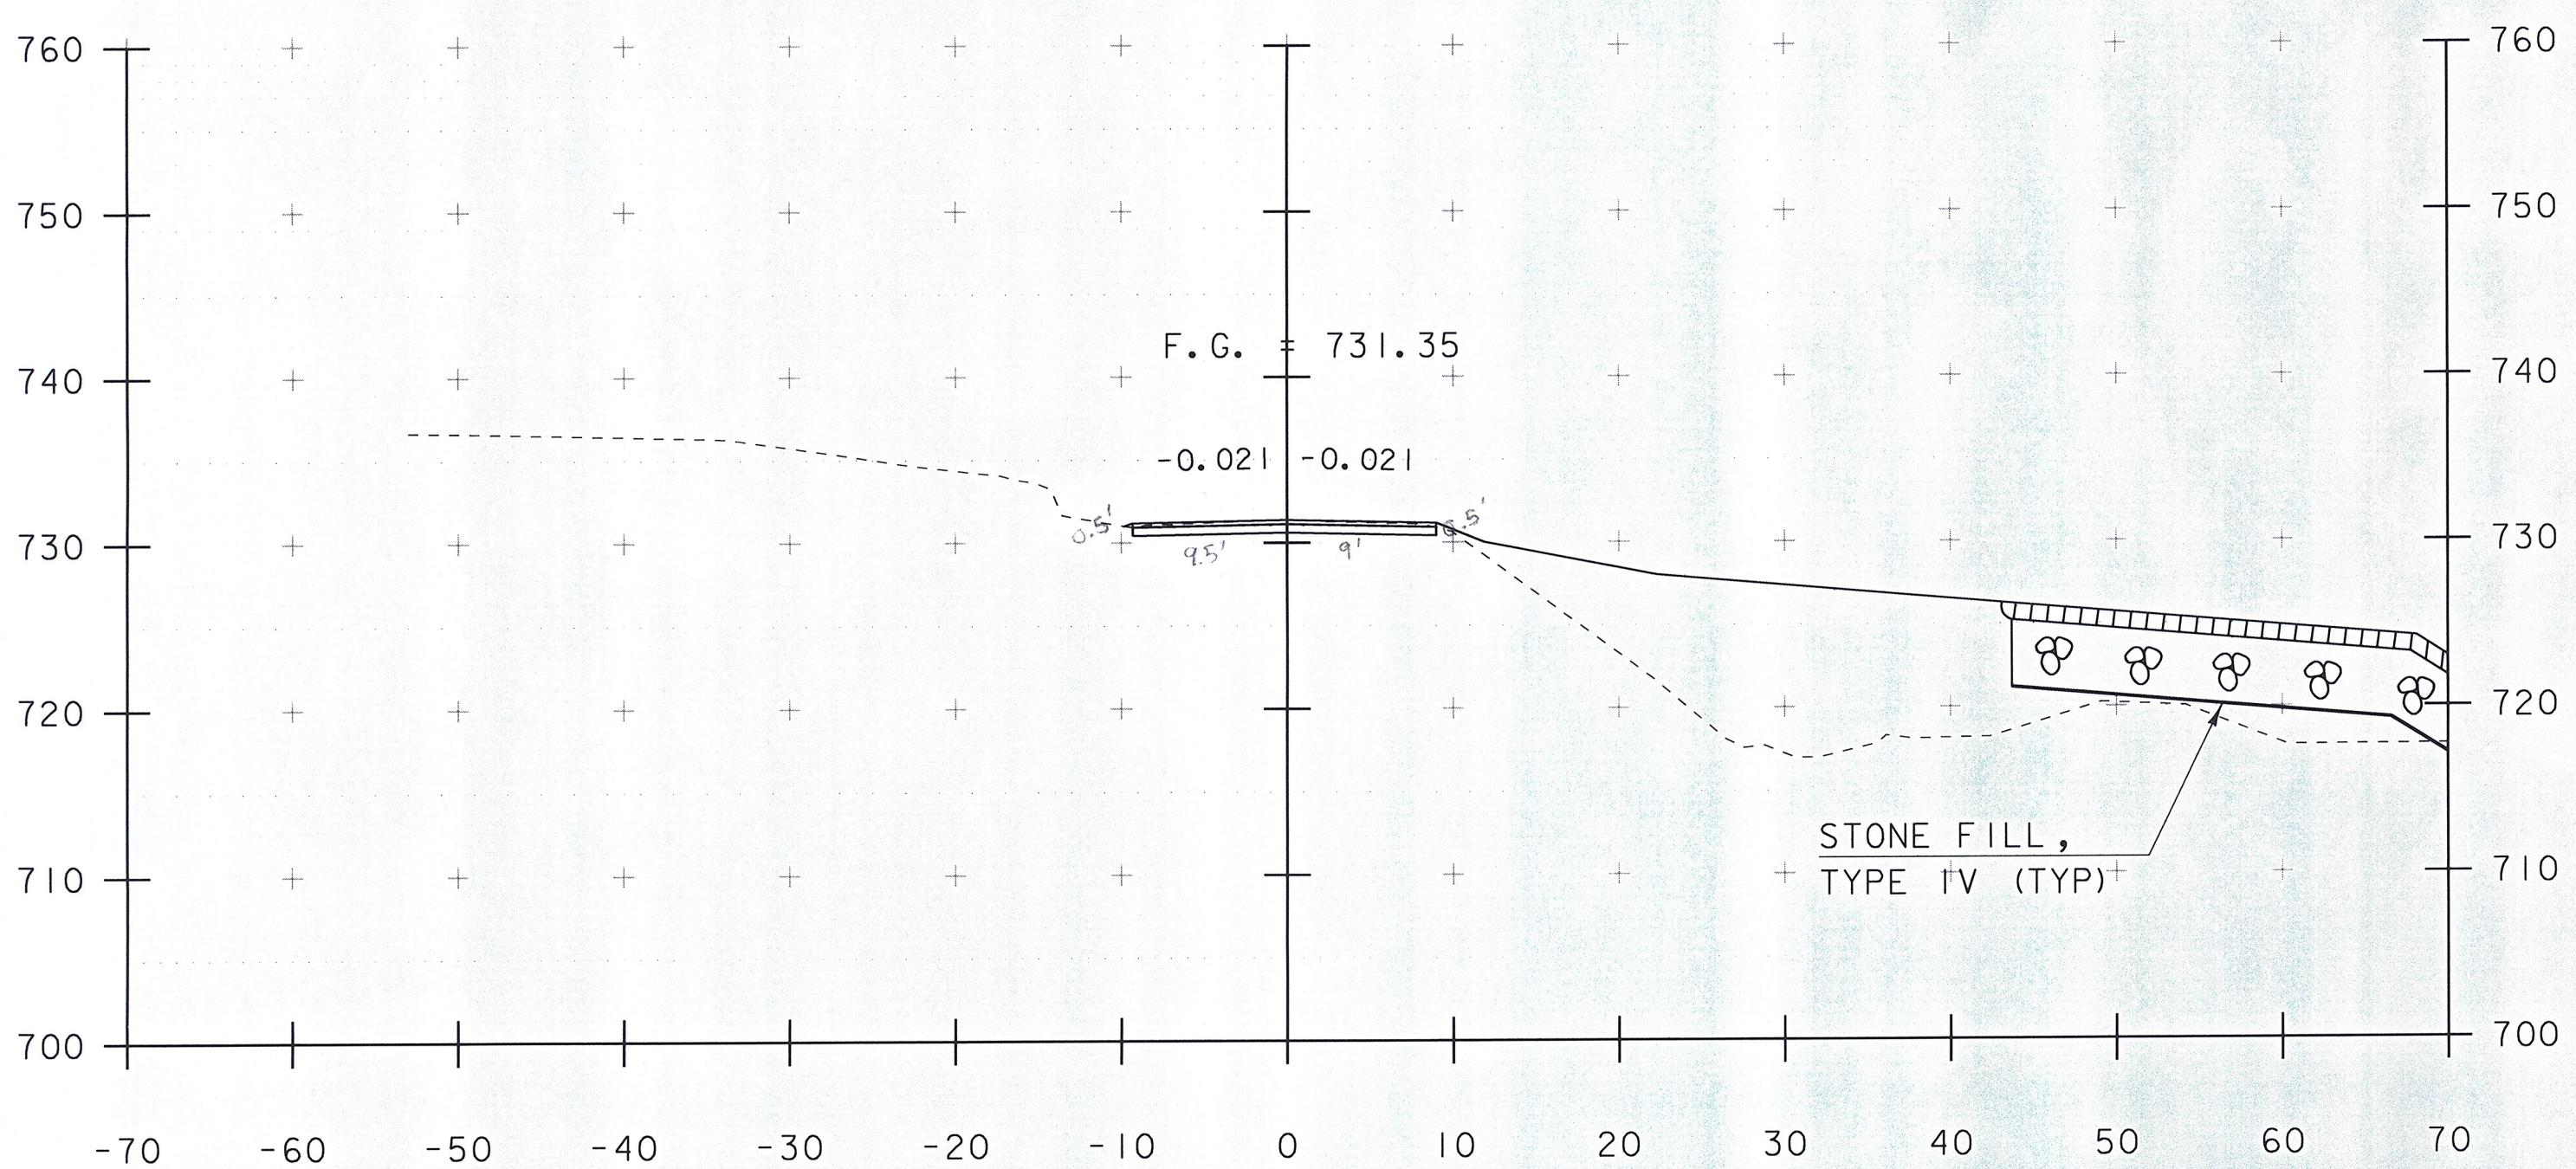

31+00

Subbase + Curbs
18.5' x 0.5' = 9.25 SF

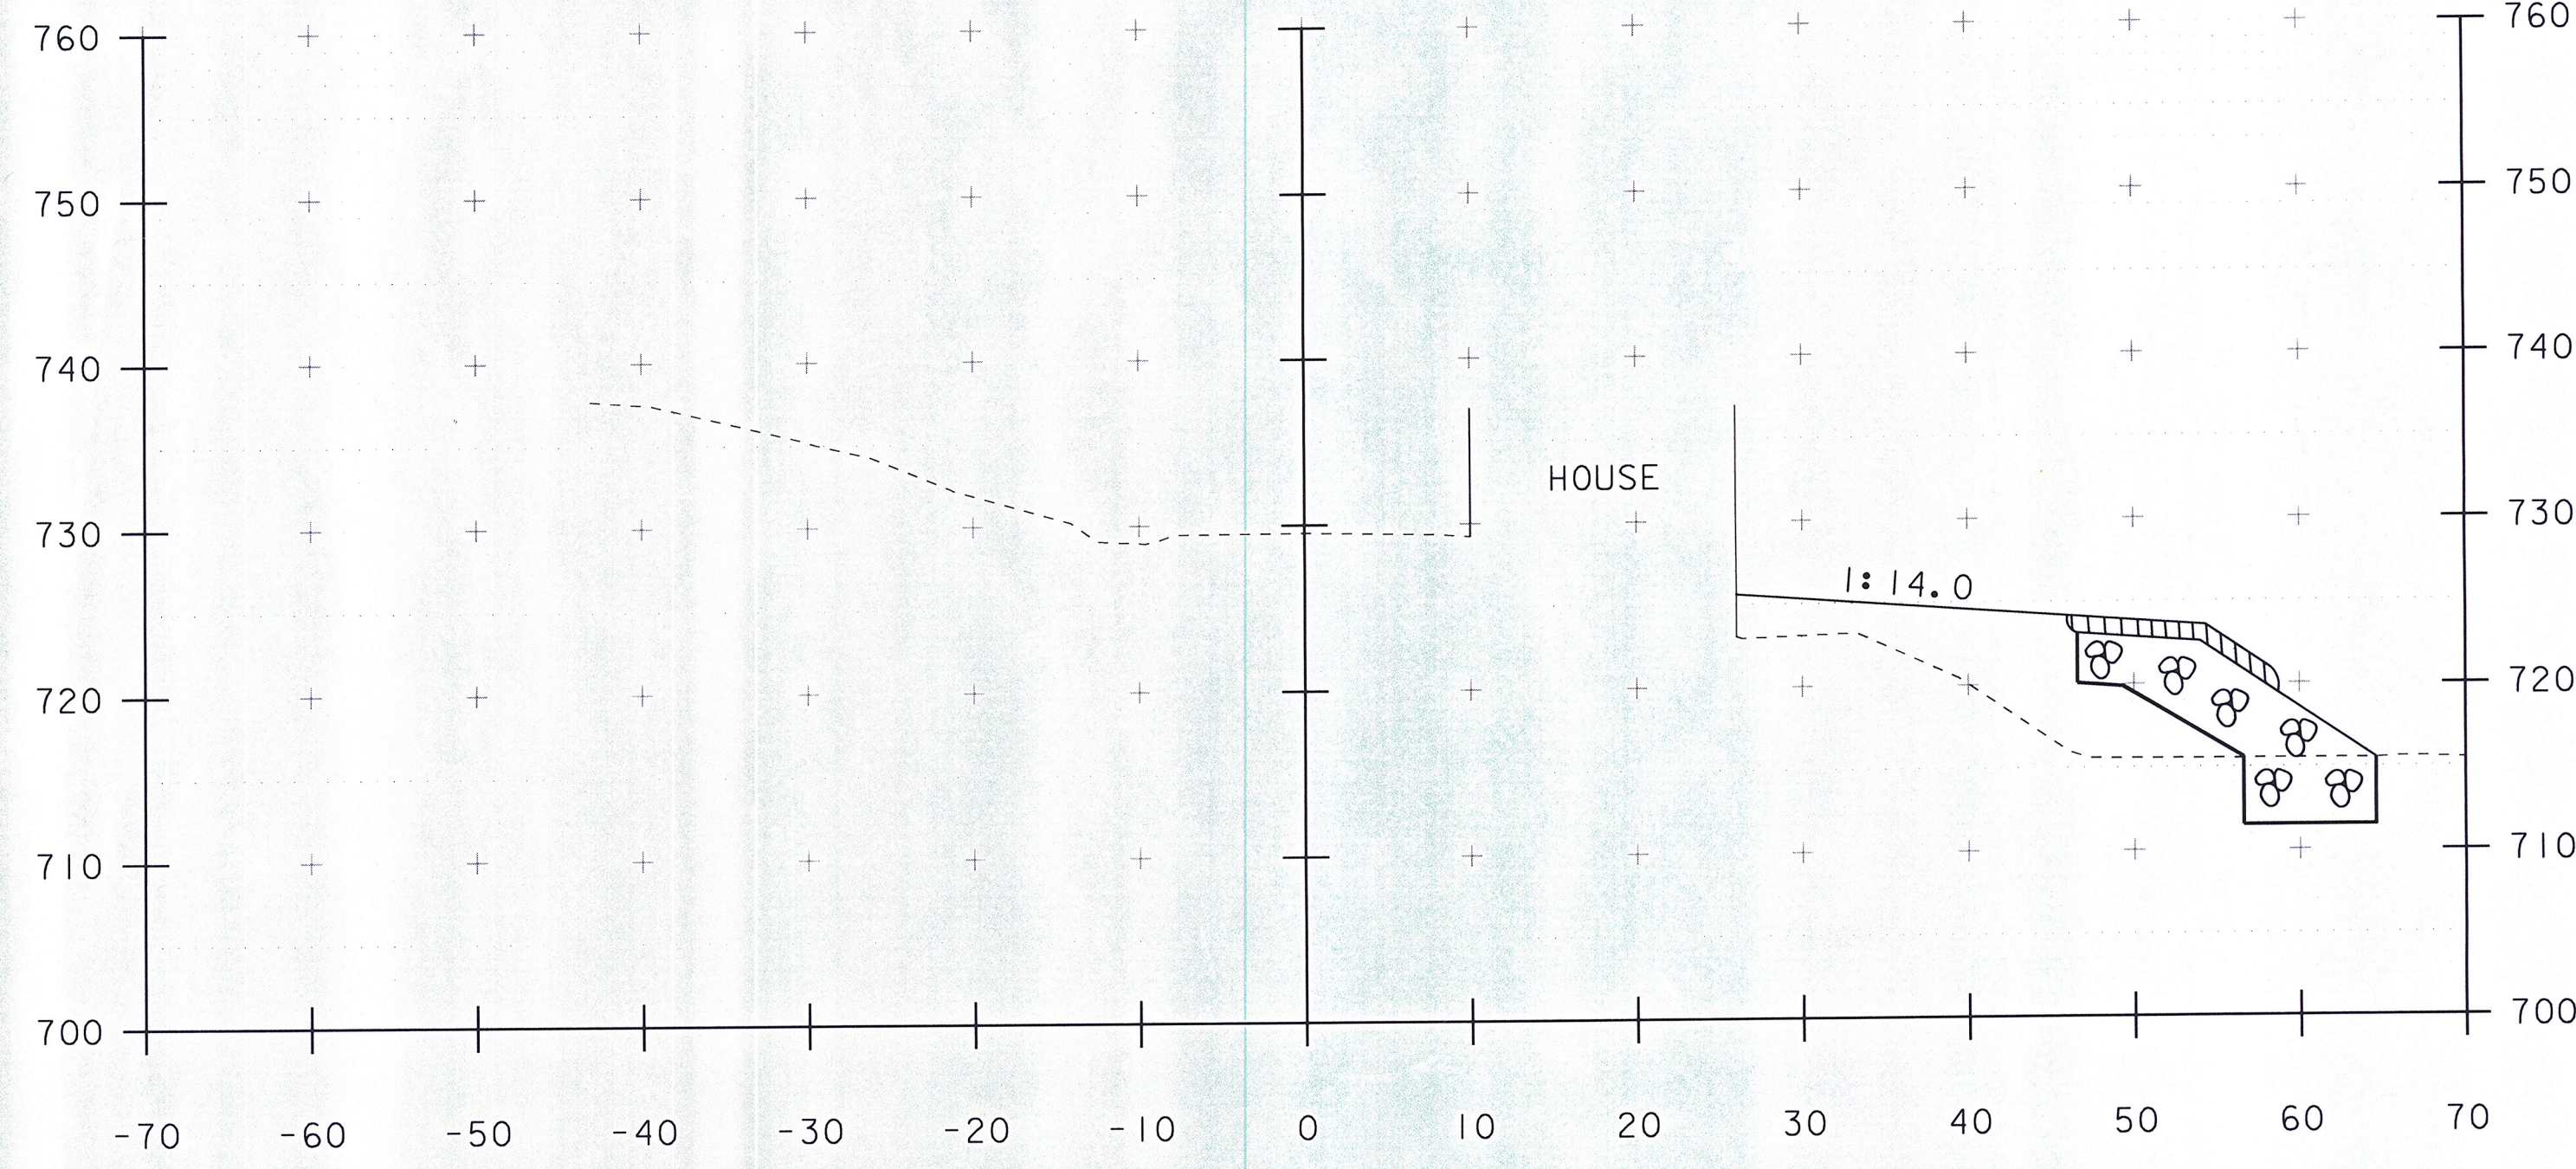

31+50

SCALE 1" = 10'-0"
10 0 10

PROJECT NAME: JAMAICA
PROJECT NUMBER: ER-BRF 015-1(23)

FILE NAME: s1b316.xs.dgn
PROJECT LEADER: K. HIGGINS
DESIGNED BY: G. LAROCHE
WATER STREET SECTIONS 2

PLOT DATE: 07-DEC-2012
DRAWN BY: K. FRIEDLAND
CHECKED BY: G. LAROCHE
SHEET 63 OF 82

STA. 31+00 TO STA. 31+75