



21+25

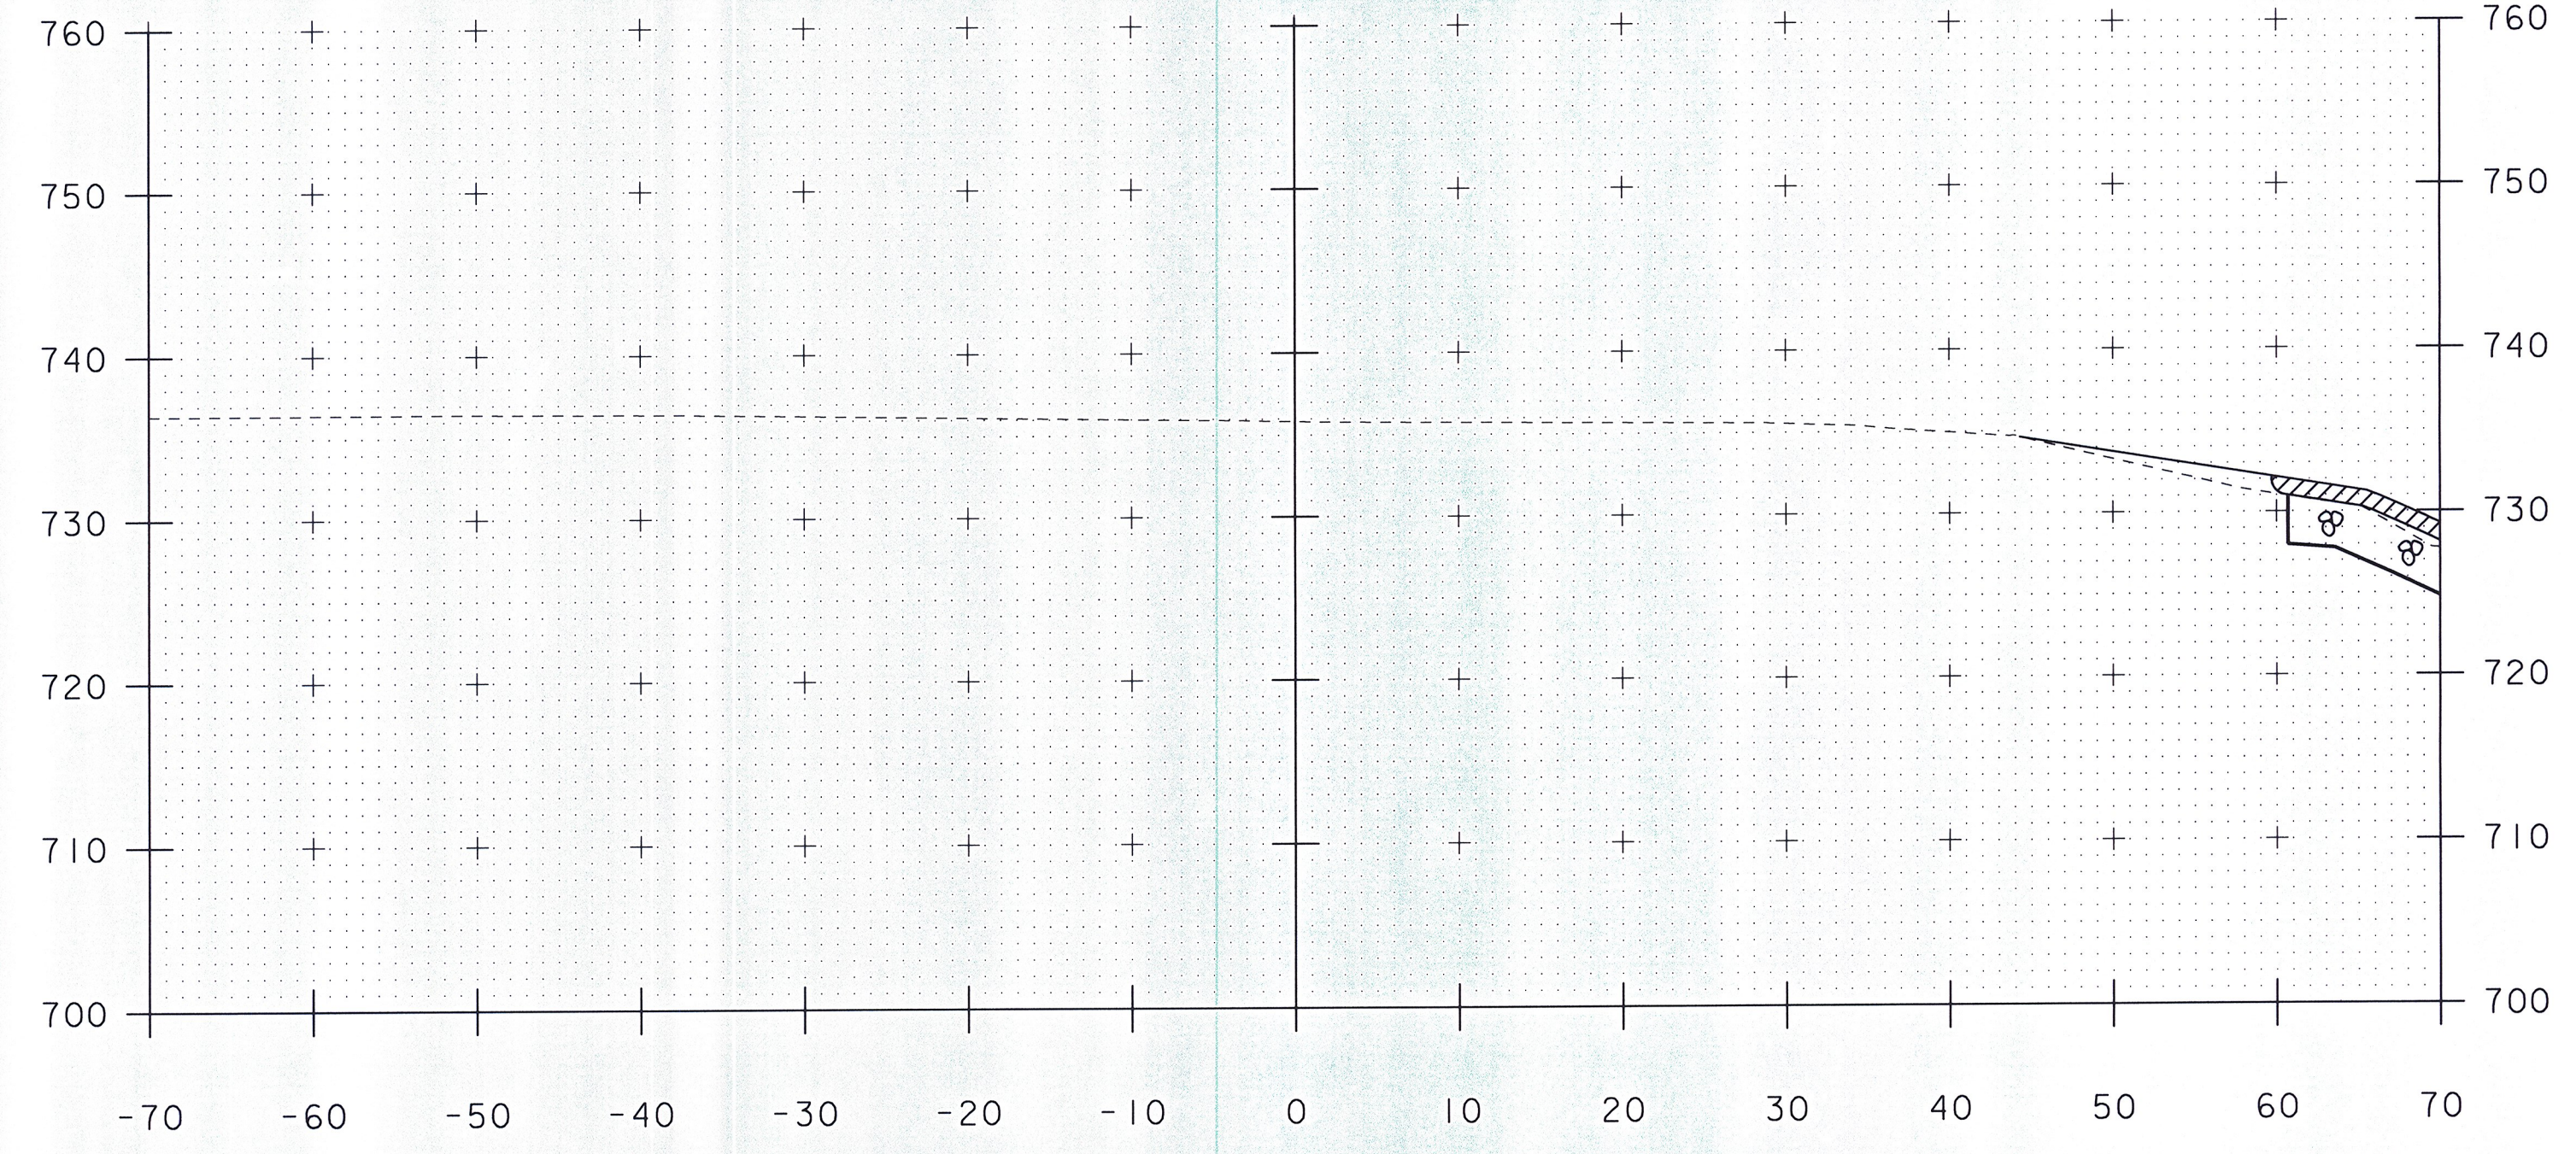


21+75

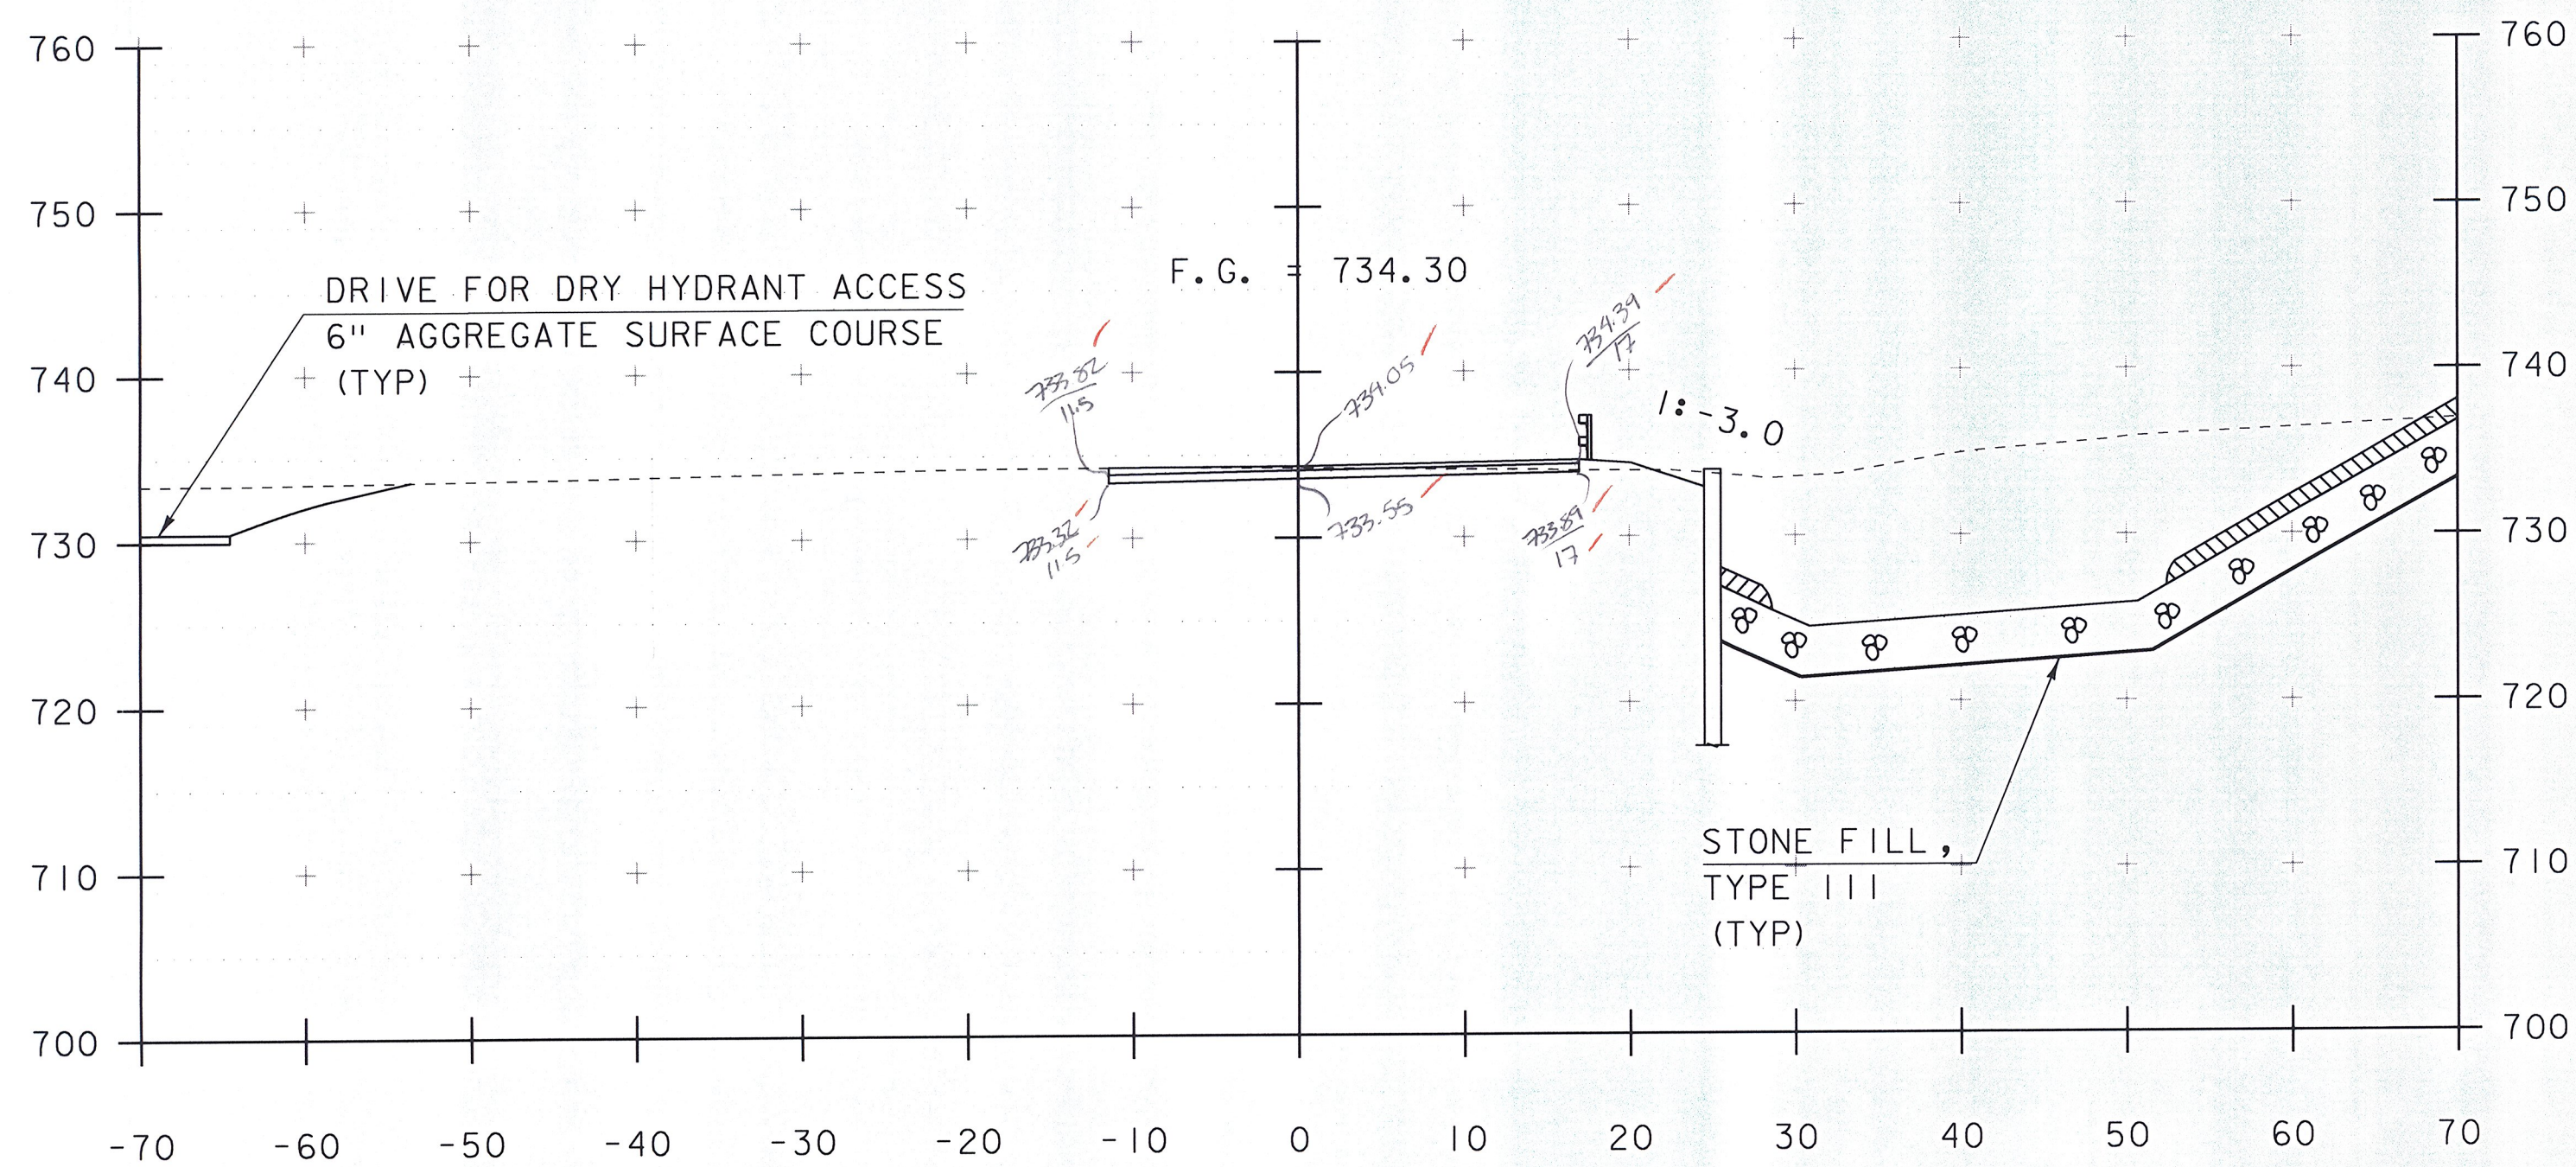

21+00


END FIRE DRIVE @ 21+08.77

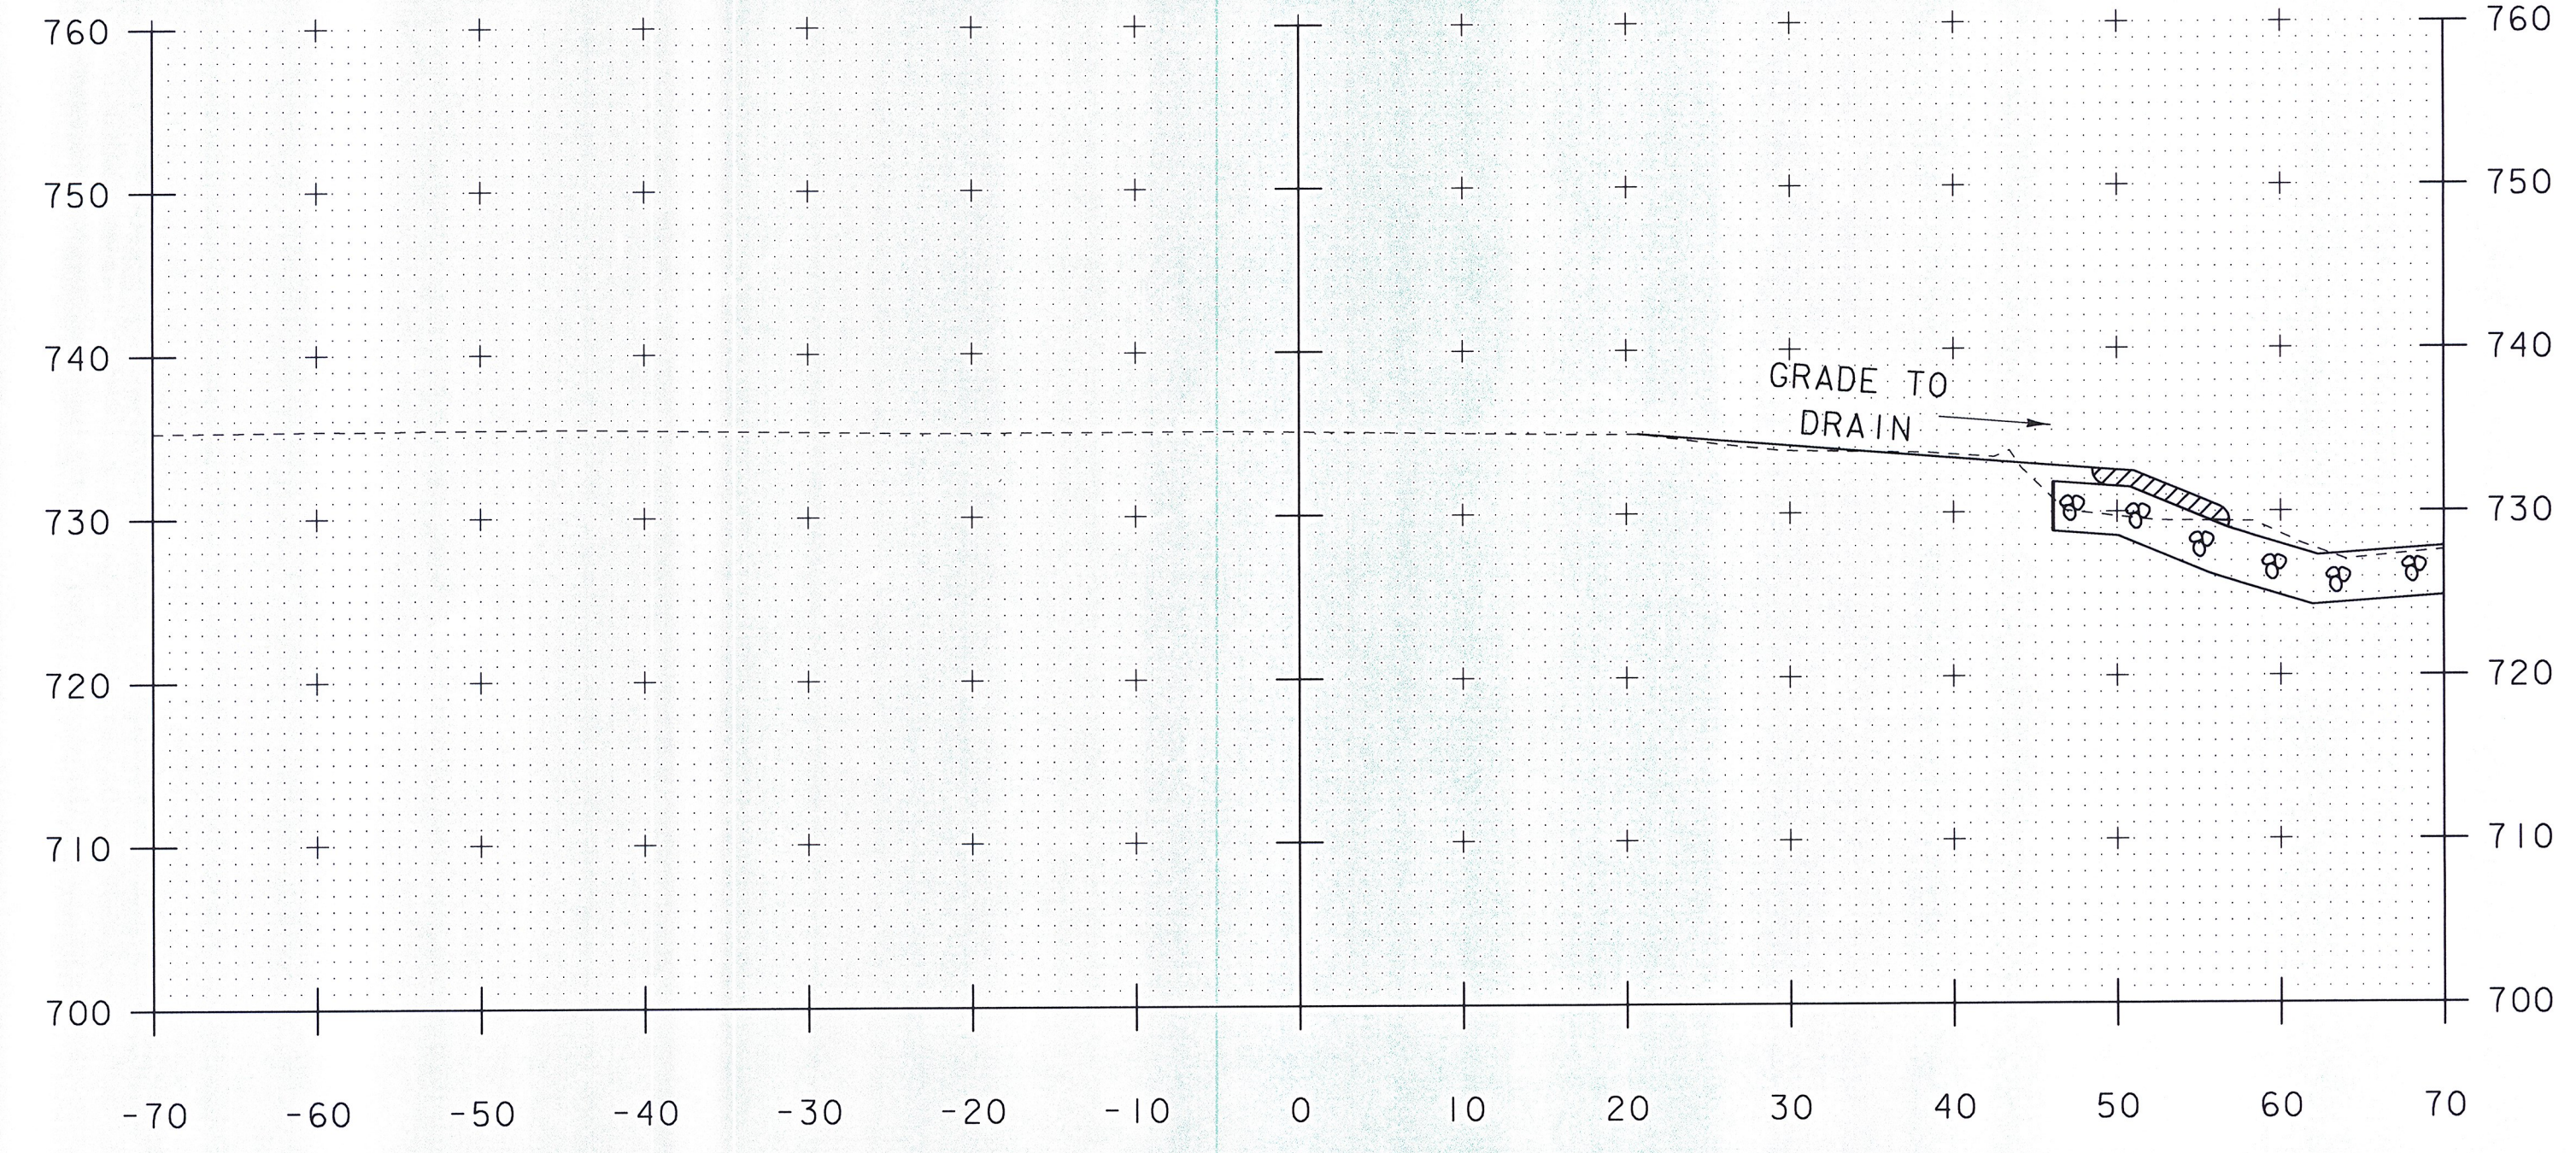

21+50

MTC 12/1/14
BANK 11/29/11

COMMON LINE
1/18
1/18
1/17
1/3/34, 1/30/34, 1/30/35

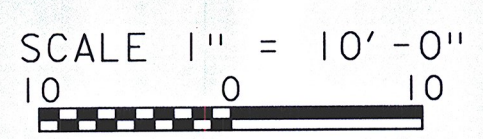

PROJECT NAME:	JAMAICA	PLOT DATE:	07-DEC-2012
PROJECT NUMBER:	ER-BRF 015-1(23)	DRAWN BY:	K. FRIEDLAND
FILE NAME:	s1b316.xs.dgn	CHECKED BY:	G. LAROCHE
PROJECT LEADER:	K. HIGGINS	SHEET	65 OF 82
DESIGNED BY:	G. LAROCHE		
FIRE DRIVE SECTIONS 2			

STA. 1+00 TO STA. 1+10