



50+25

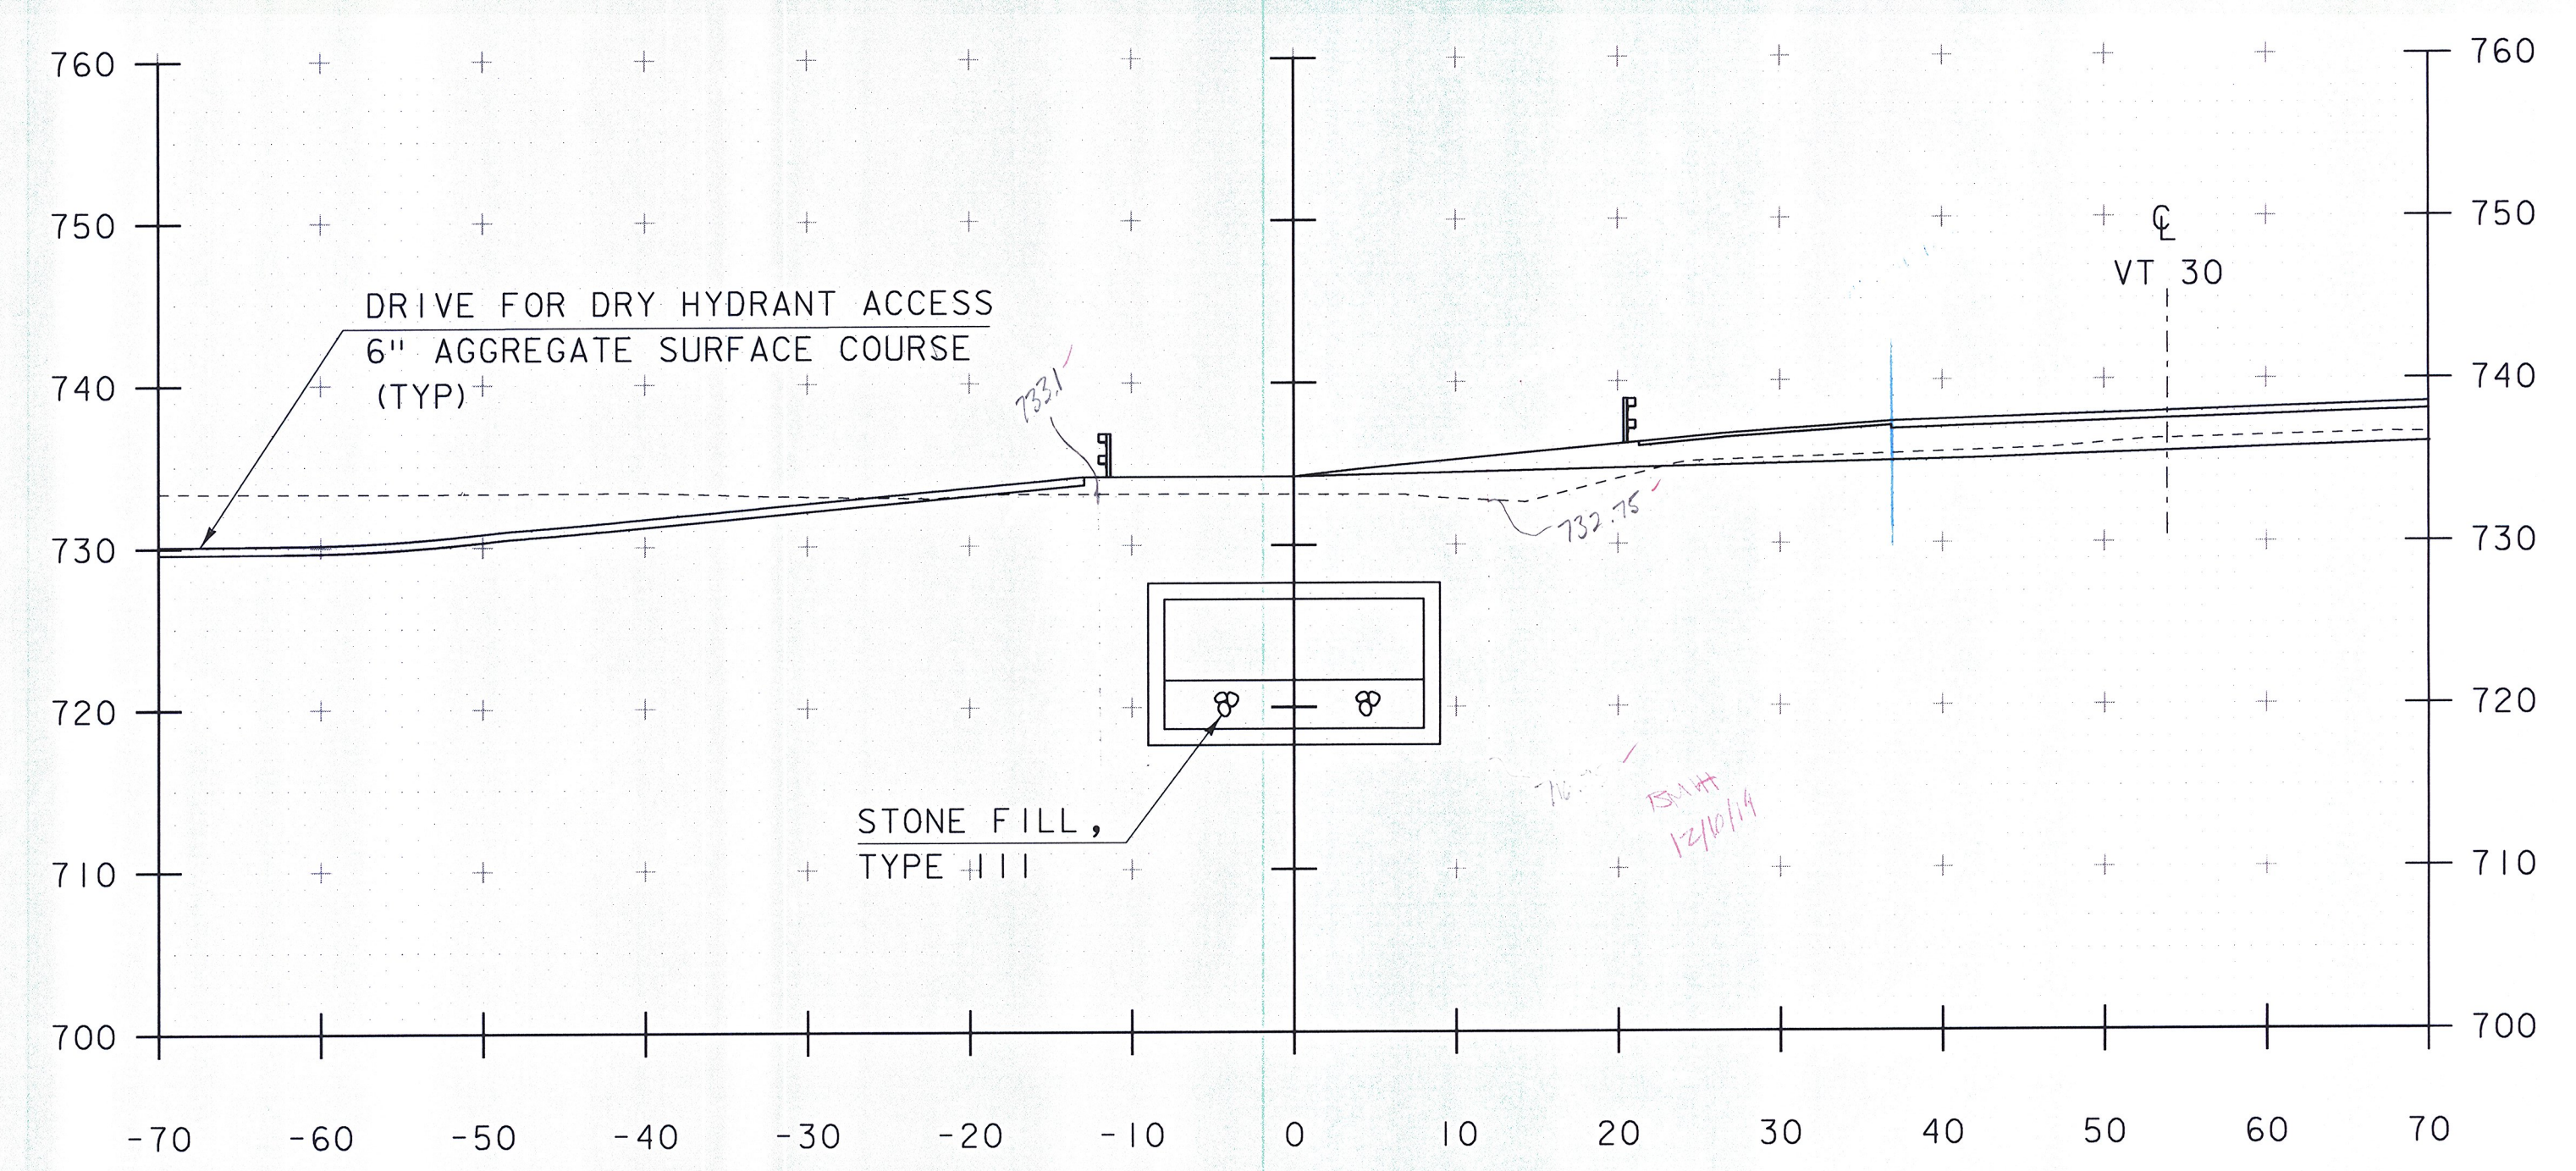


50+75

Box Culvert Outlet = 50+56
Inlet = 51+41

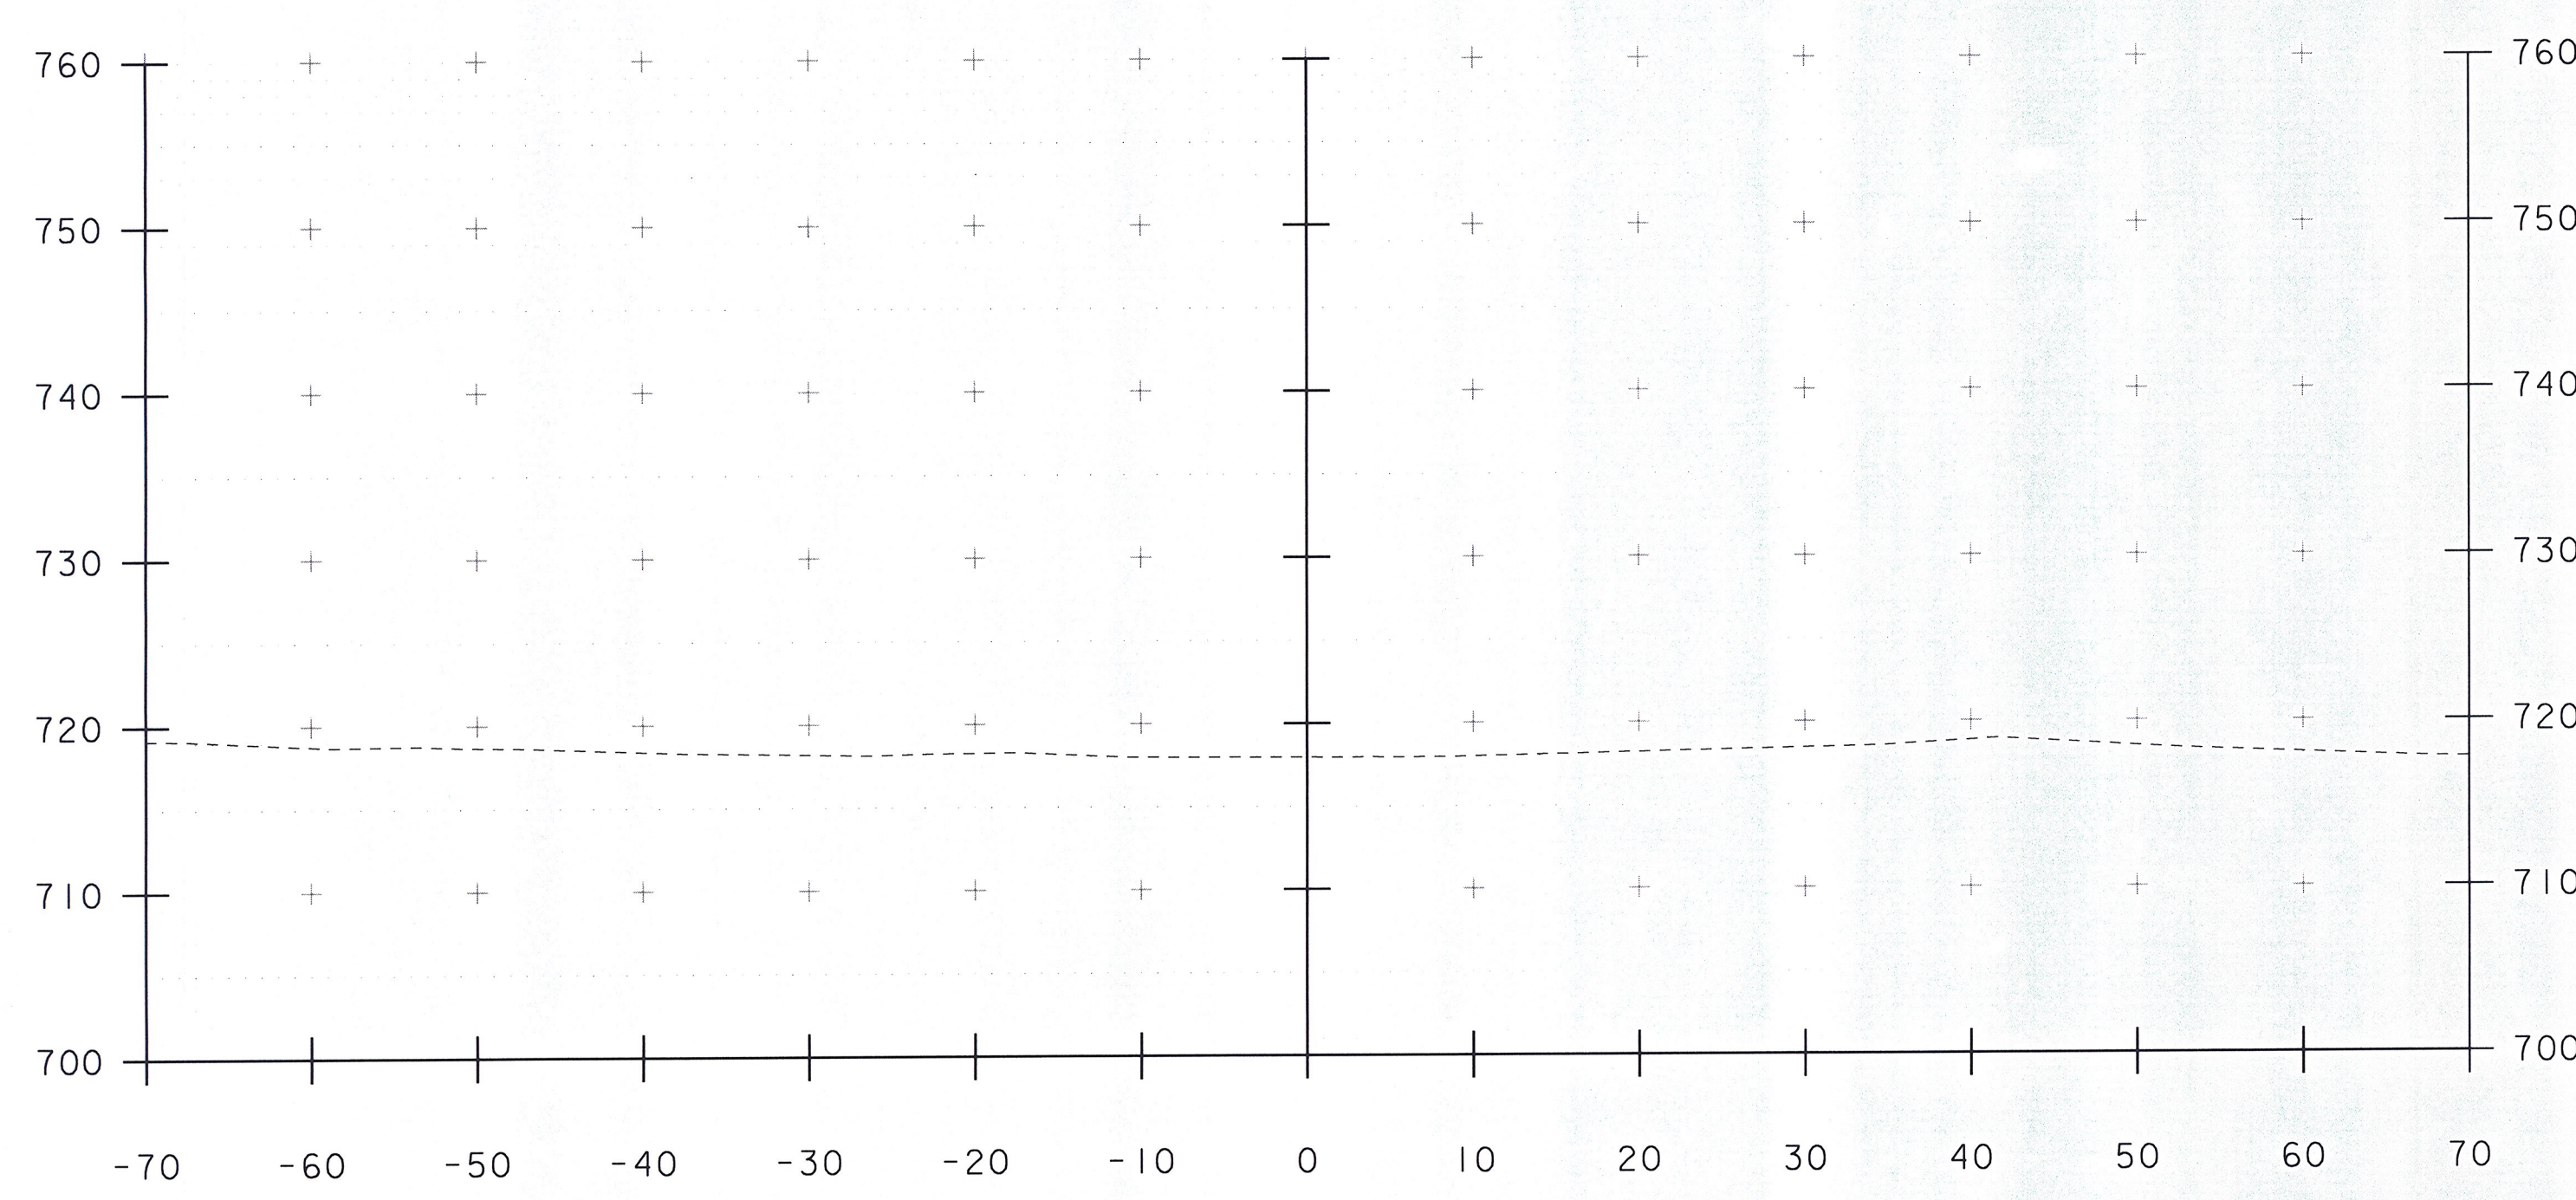

50+00

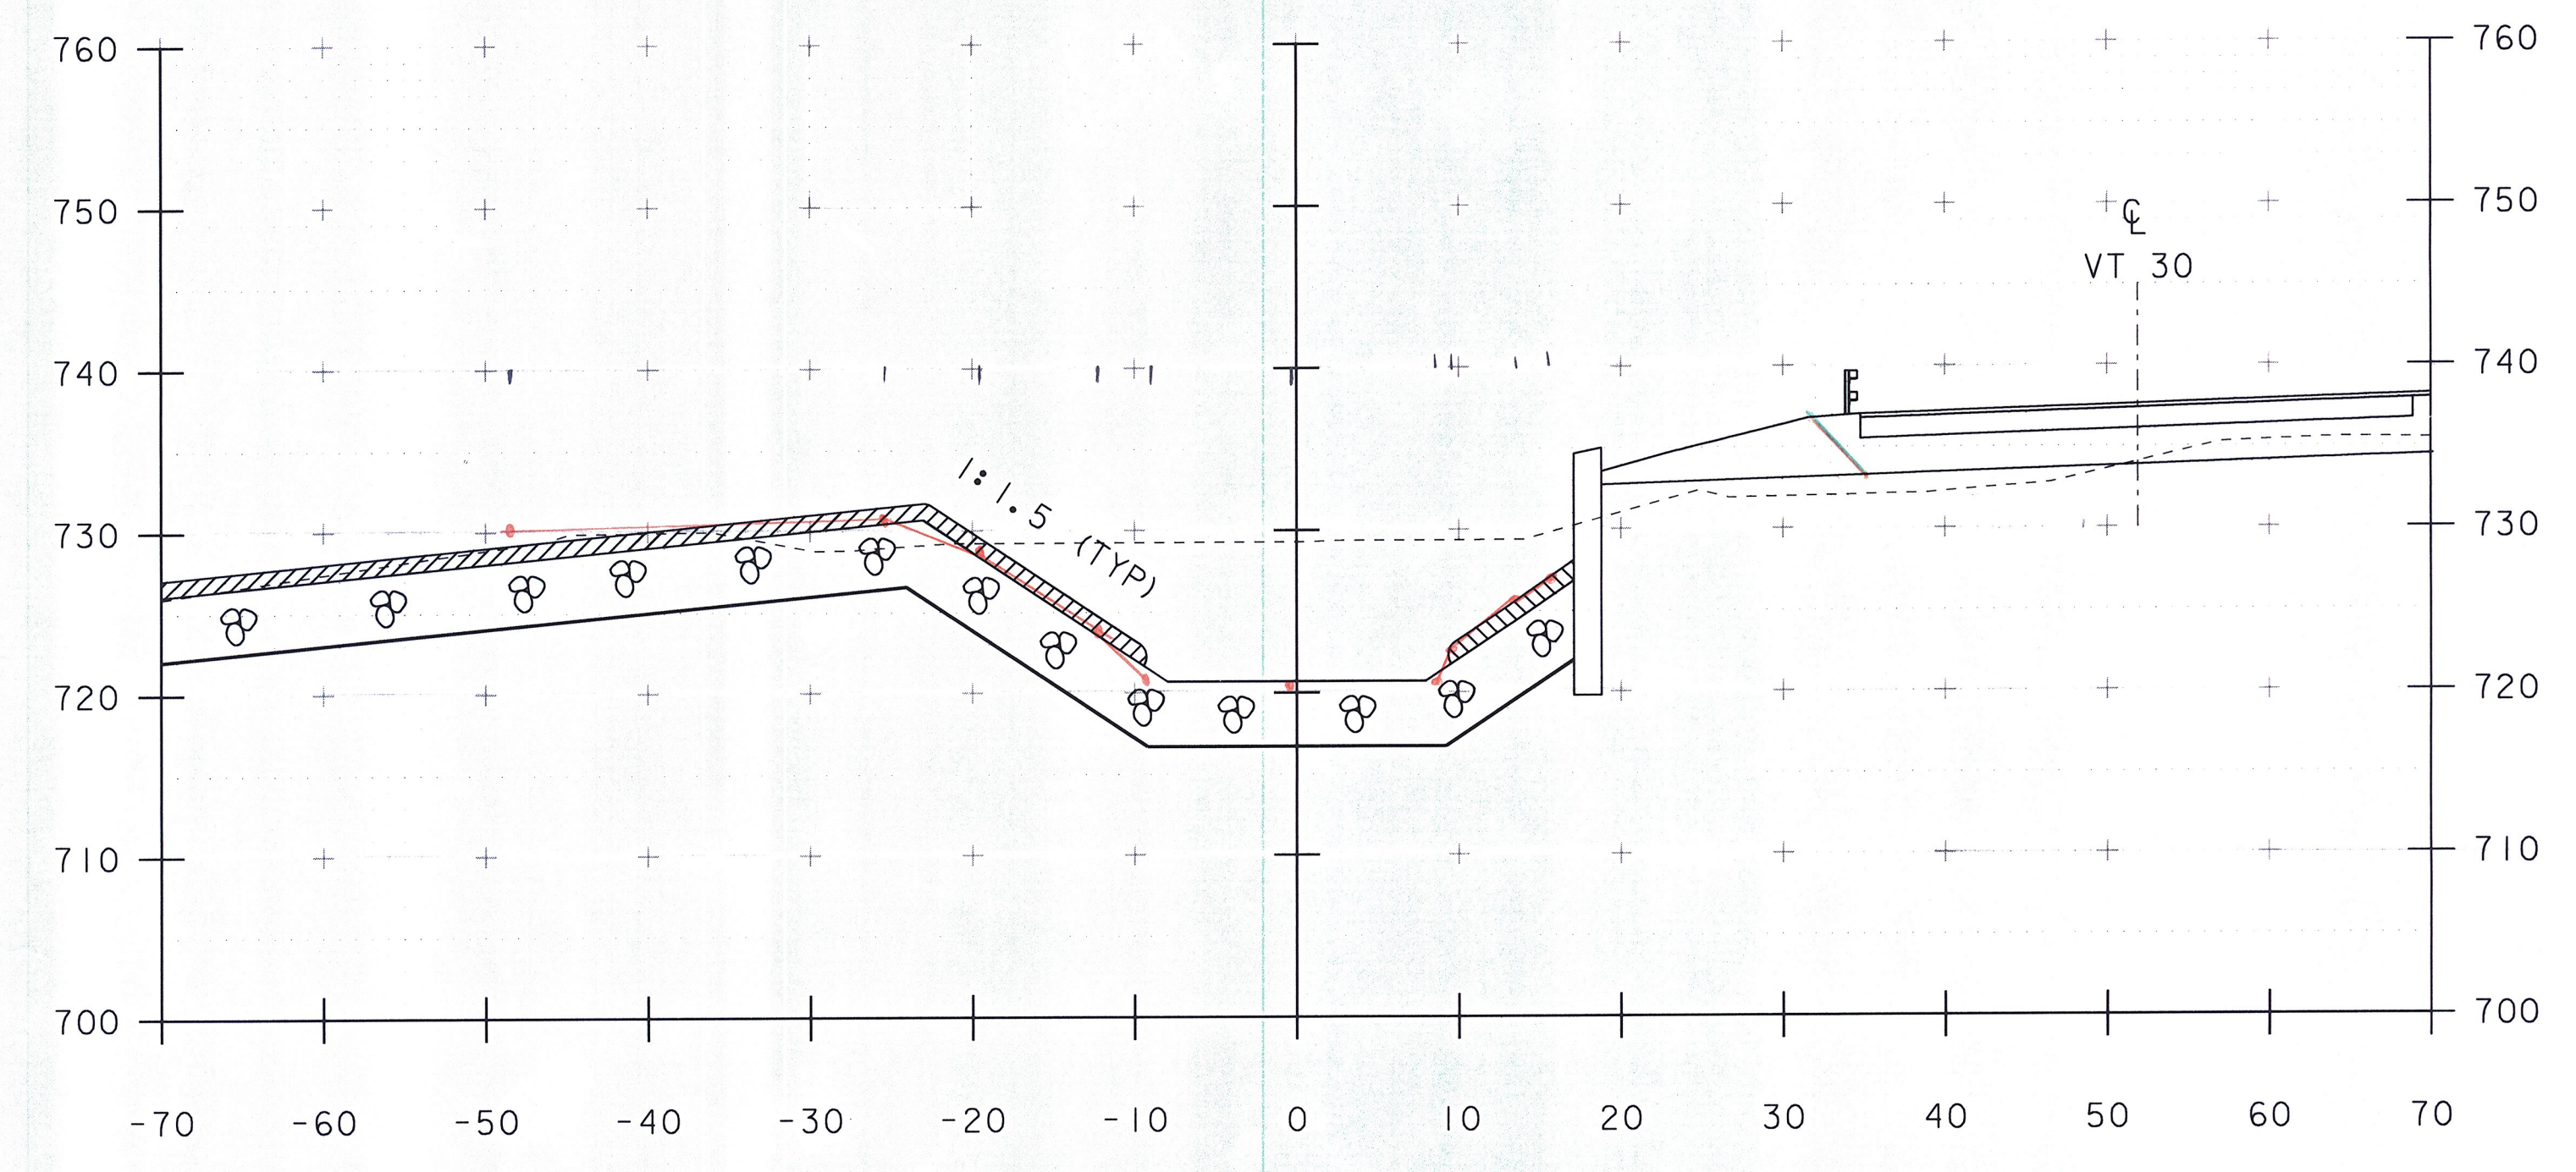

50+50

SCALE 1" = 10'-0"
10 0 10

STA. 50+00 TO STA. 50+75

PROJECT NAME:	JAMAICA	FILE NAME:	slb316.xs.dgn	PLOT DATE:	07-DEC-2012
PROJECT NUMBER:	ER-BRF 015-1 (23)	PROJECT LEADER:	K. HIGGINS	DRAWN BY:	K. FRIEDLAND
		DESIGNED BY:	G. LAROCHE	CHECKED BY:	G. LAROCHE
		BOX CULVERT SECTIONS I		SHEET	66 OF 82