




52+25

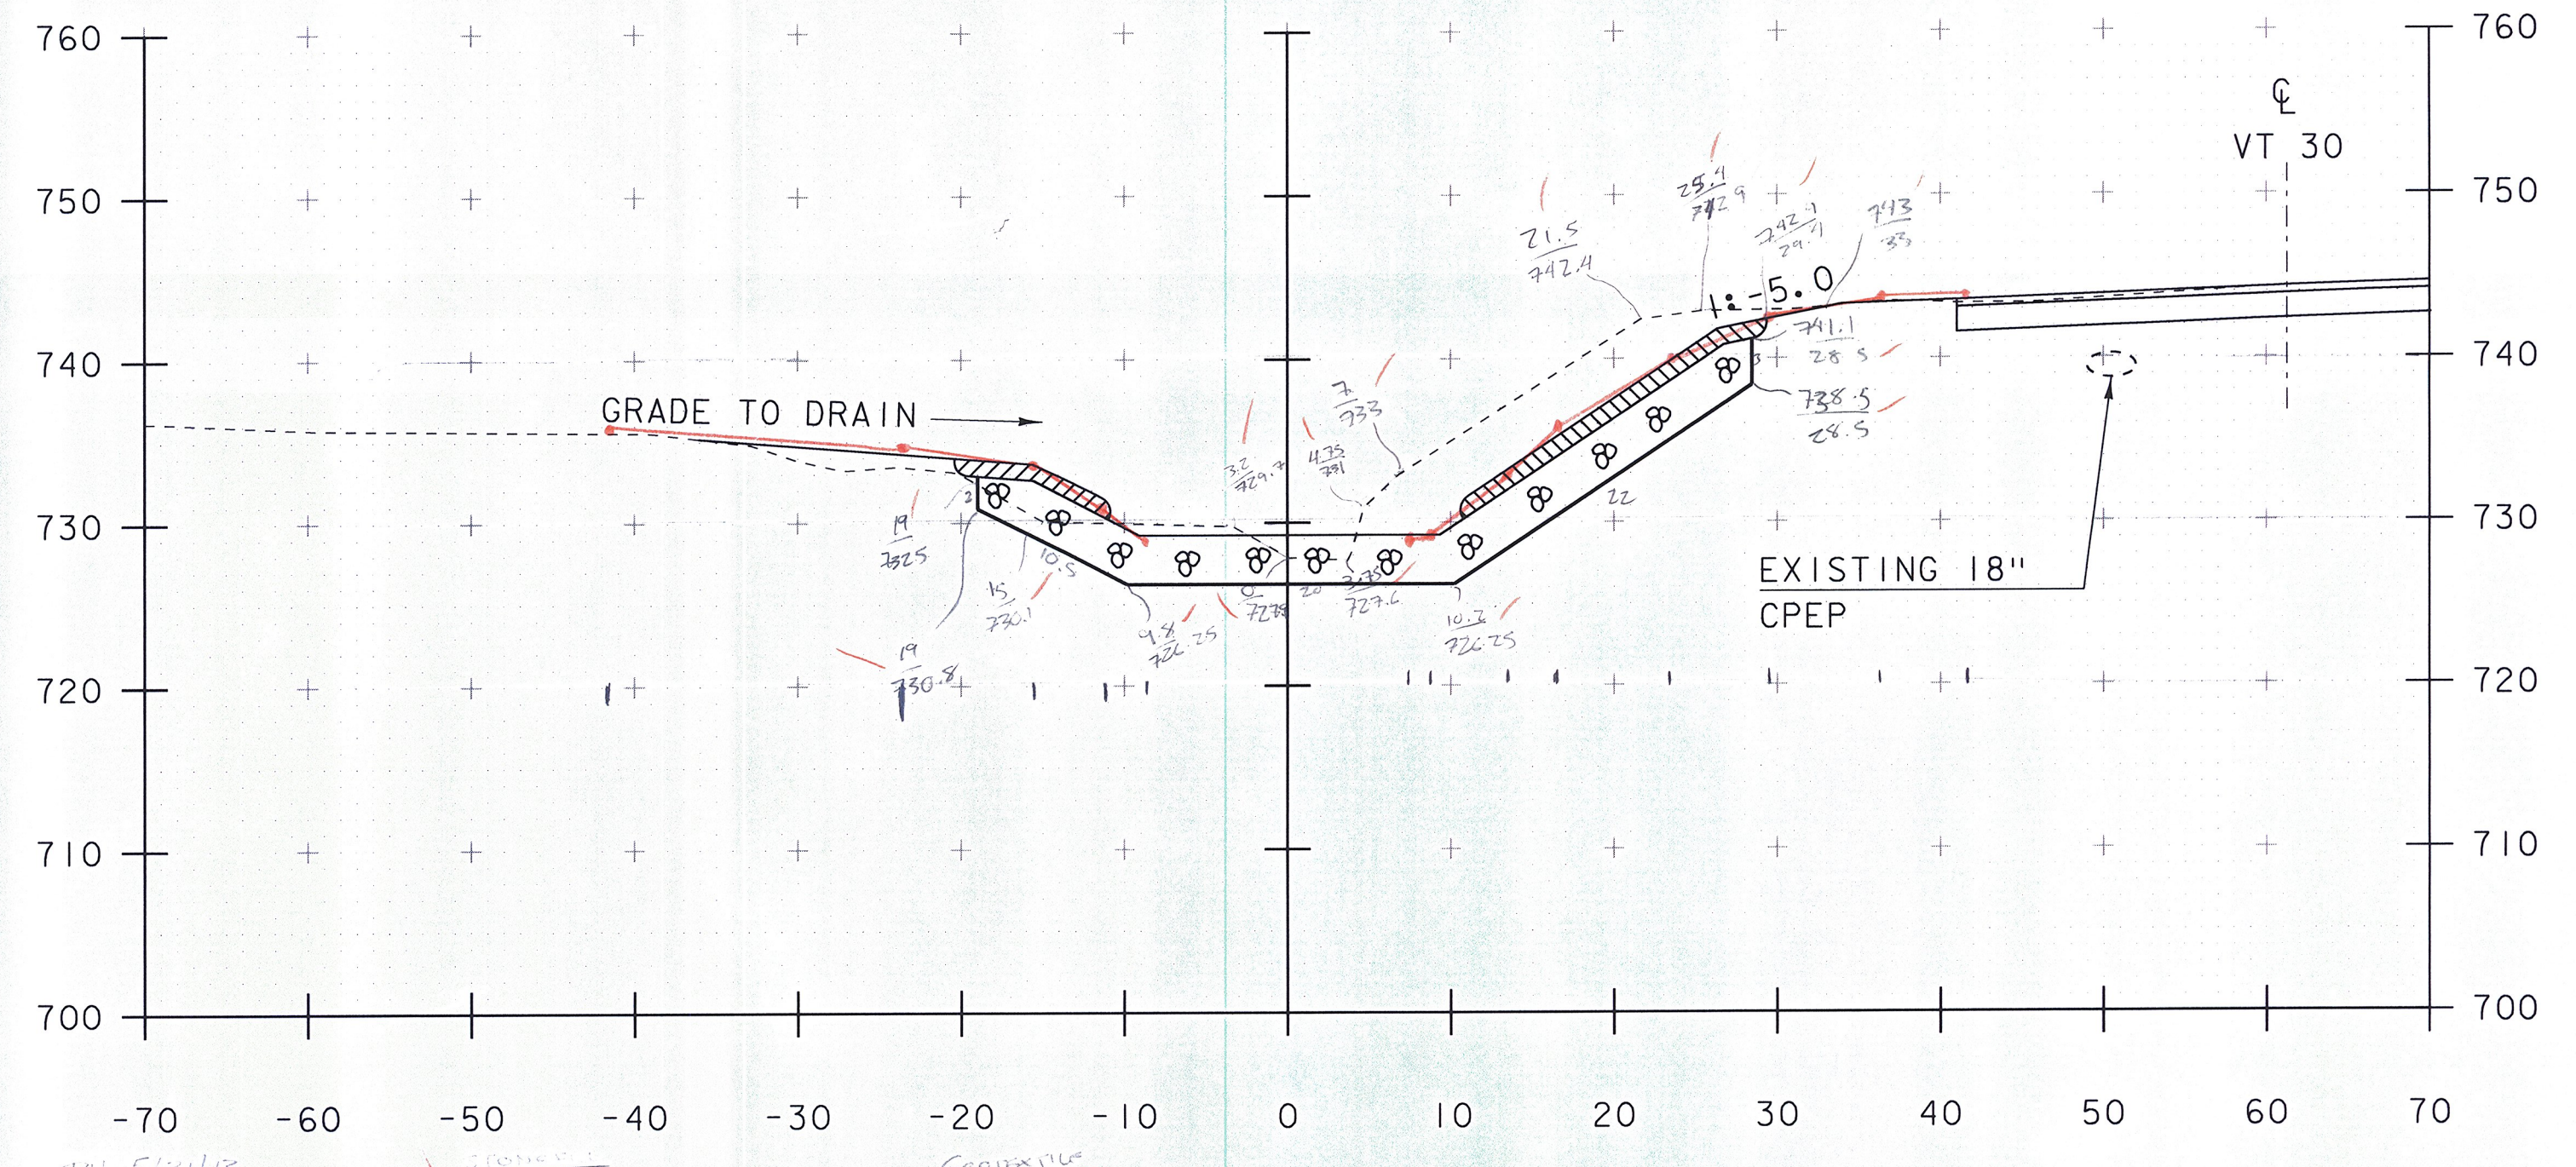

52+75

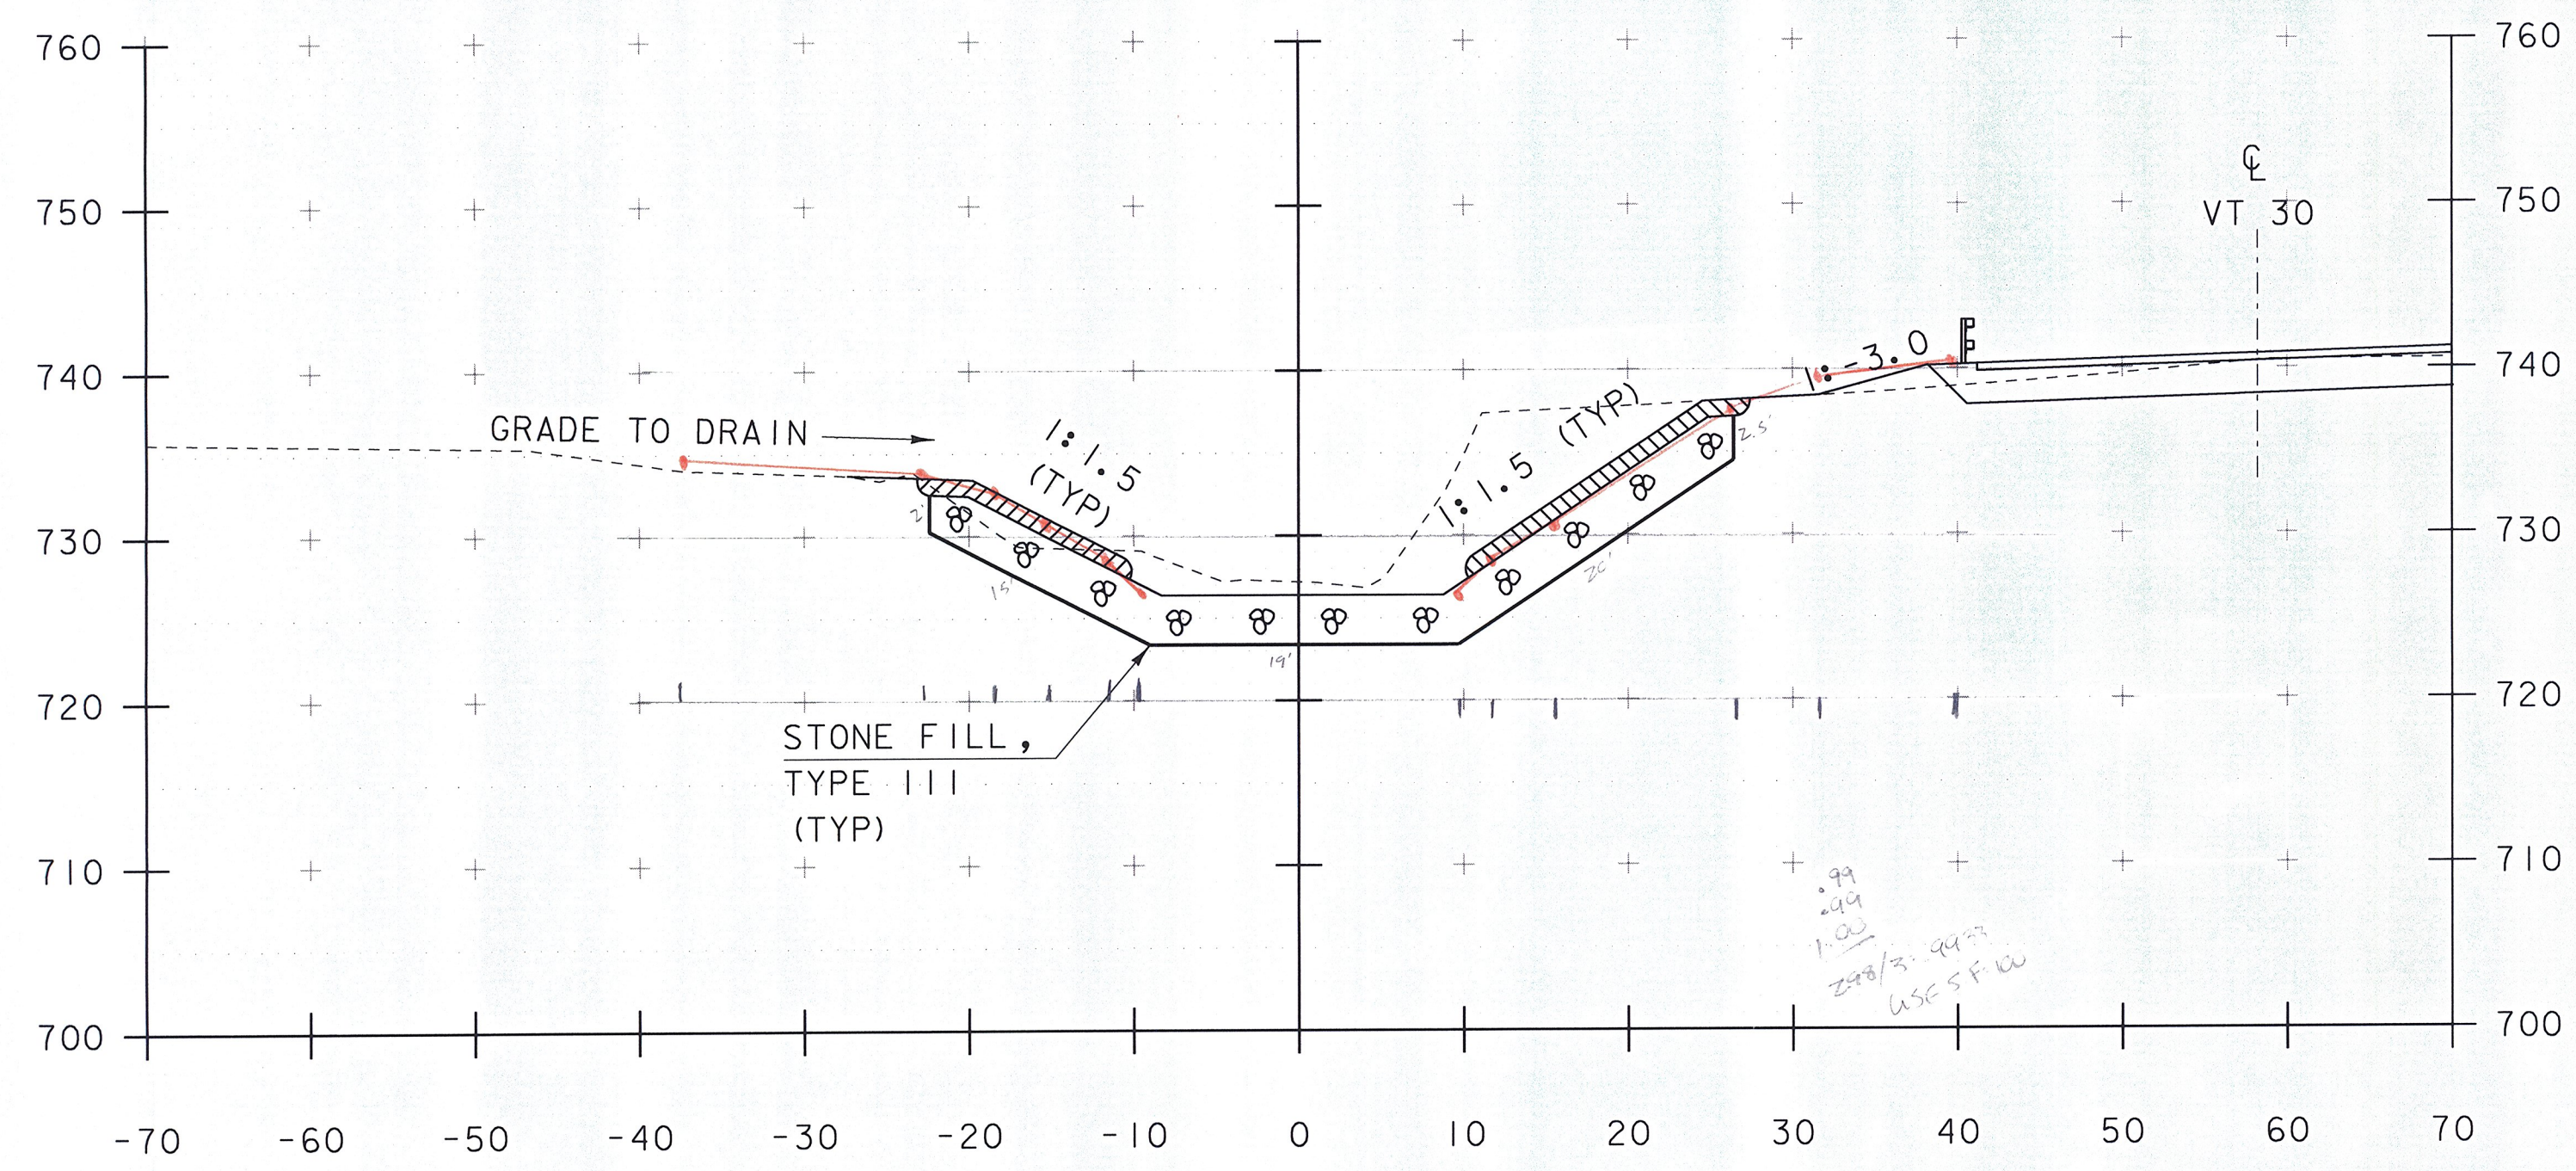

52+00

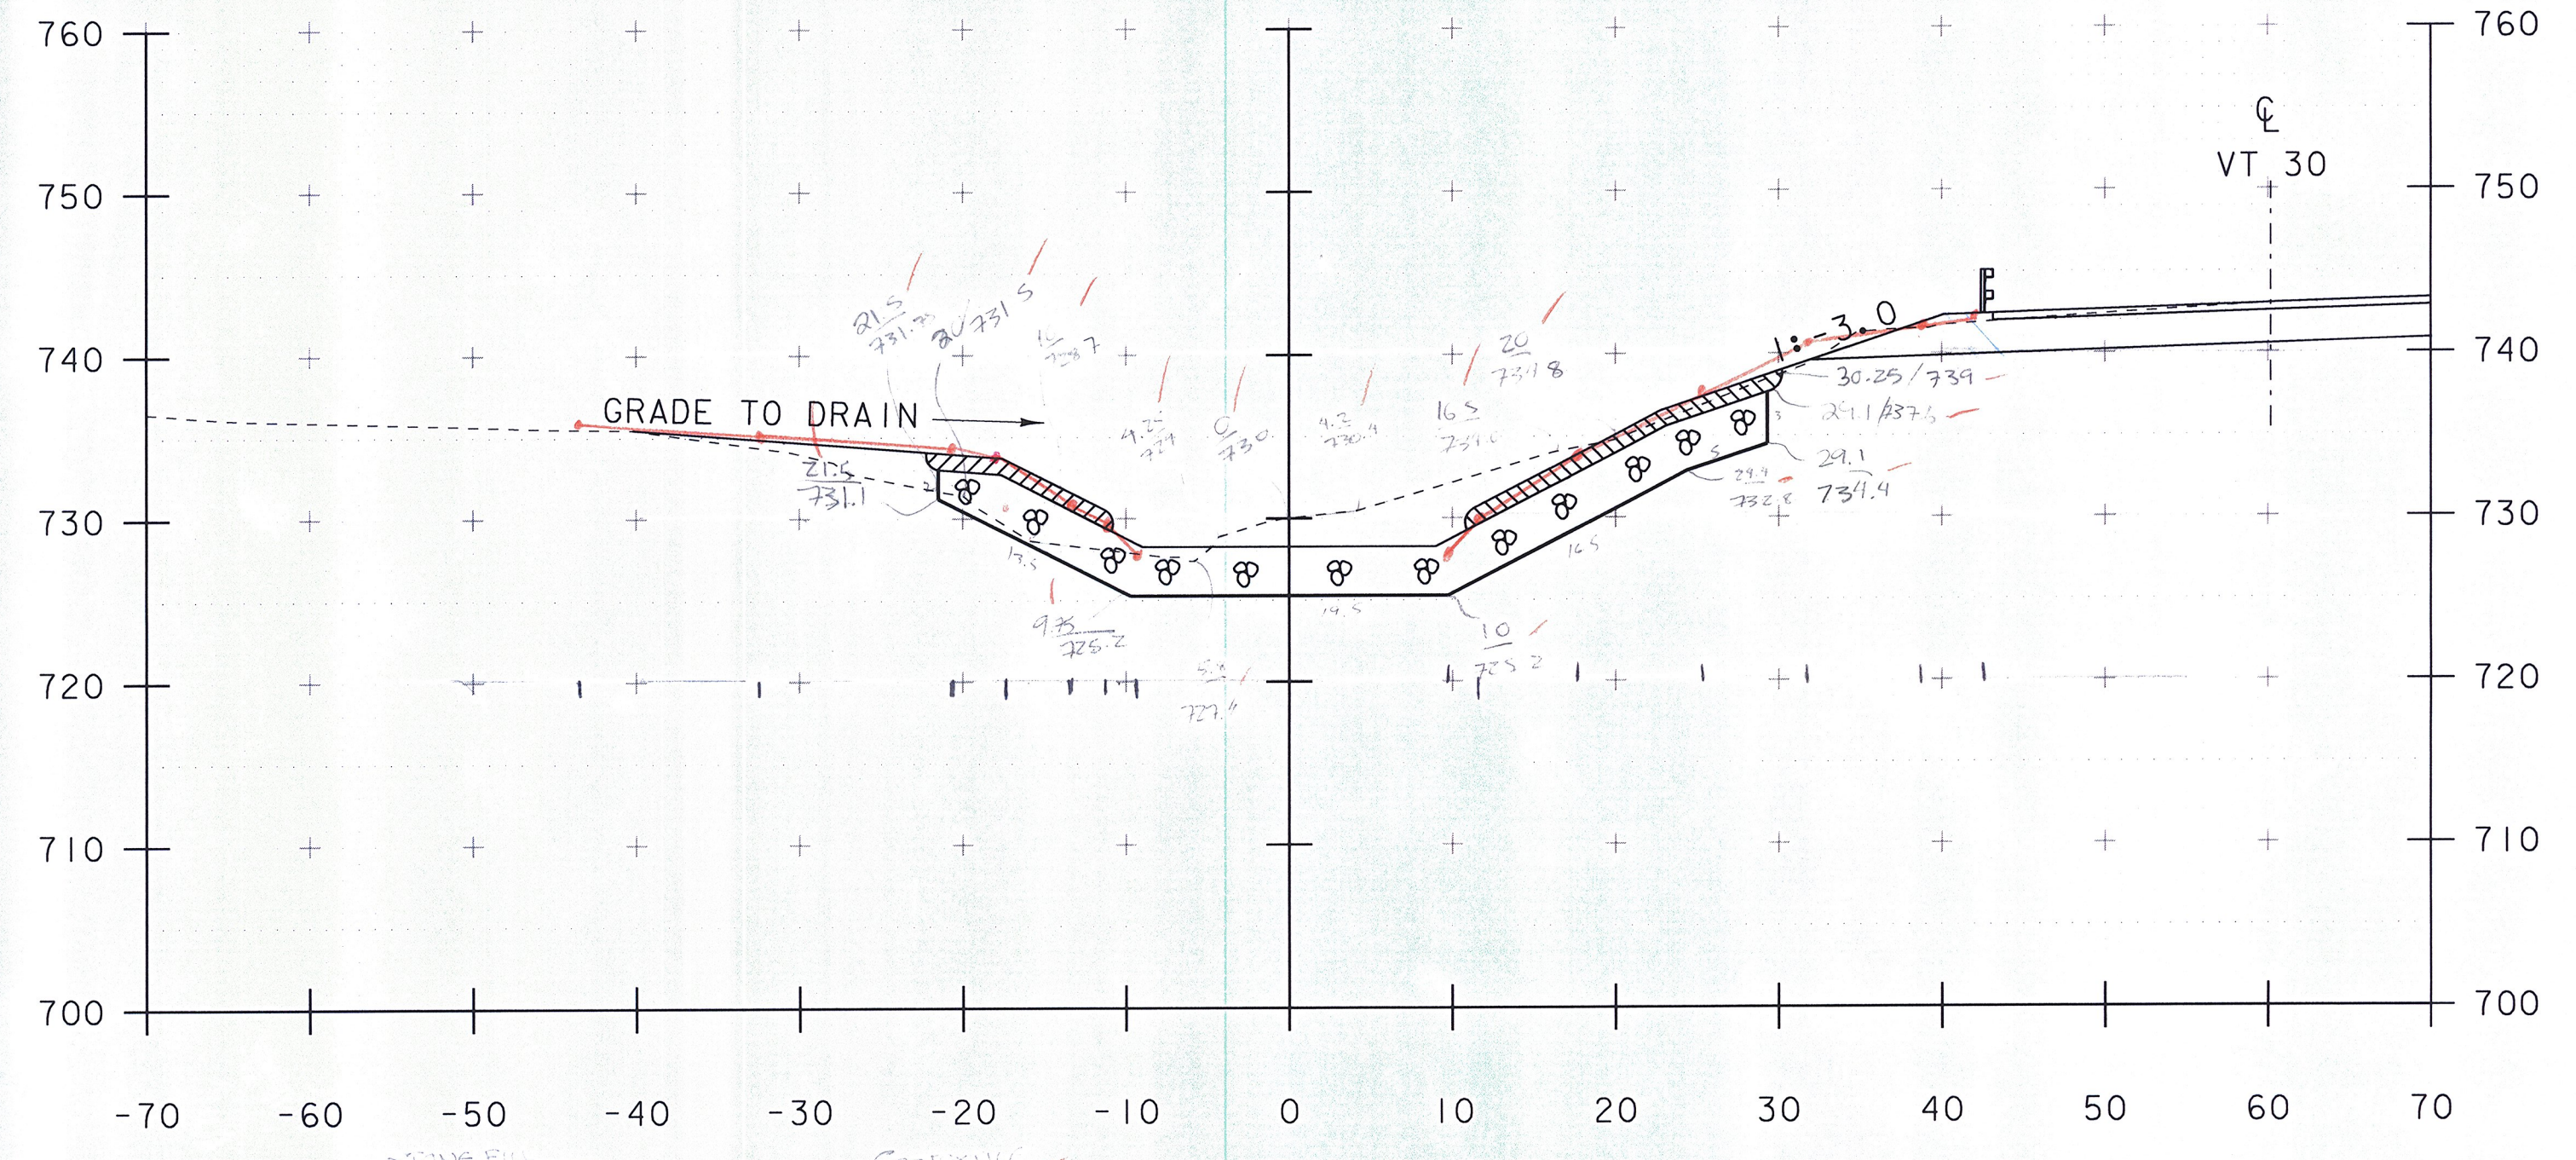

52+50

SCALE 1" = 10'-0"
 10 0 10

| | |
|-----------------------------------|------------------------|
| PROJECT NAME: JAMAICA | |
| PROJECT NUMBER: ER-BRF 015-1 (23) | |
| FILE NAME: slb316.xs.dgn | PLOT DATE: 07-DEC-2012 |
| PROJECT LEADER: K. HIGGINS | DRAWN BY: K. FRIEDLAND |
| DESIGNED BY: G. LAROCHE | CHECKED BY: G. LAROCHE |
| BOX CULVERT SECTIONS 3 | SHEET 68 OF 82 |

STA. 52+00 TO STA. 52+75