


9+25


SEE ADDITIONAL CHANNEL SECTIONS
SHEET 1 OF 7.

STA 9+00.00 RT
BEGIN UNCLASSIFIED CHANNEL EXCAVATION
BEGIN GEOTEXTILE UNDER STONE FILL
BEGIN STONE FILL, TYPE IV
BEGIN GRUBBING MATERIAL

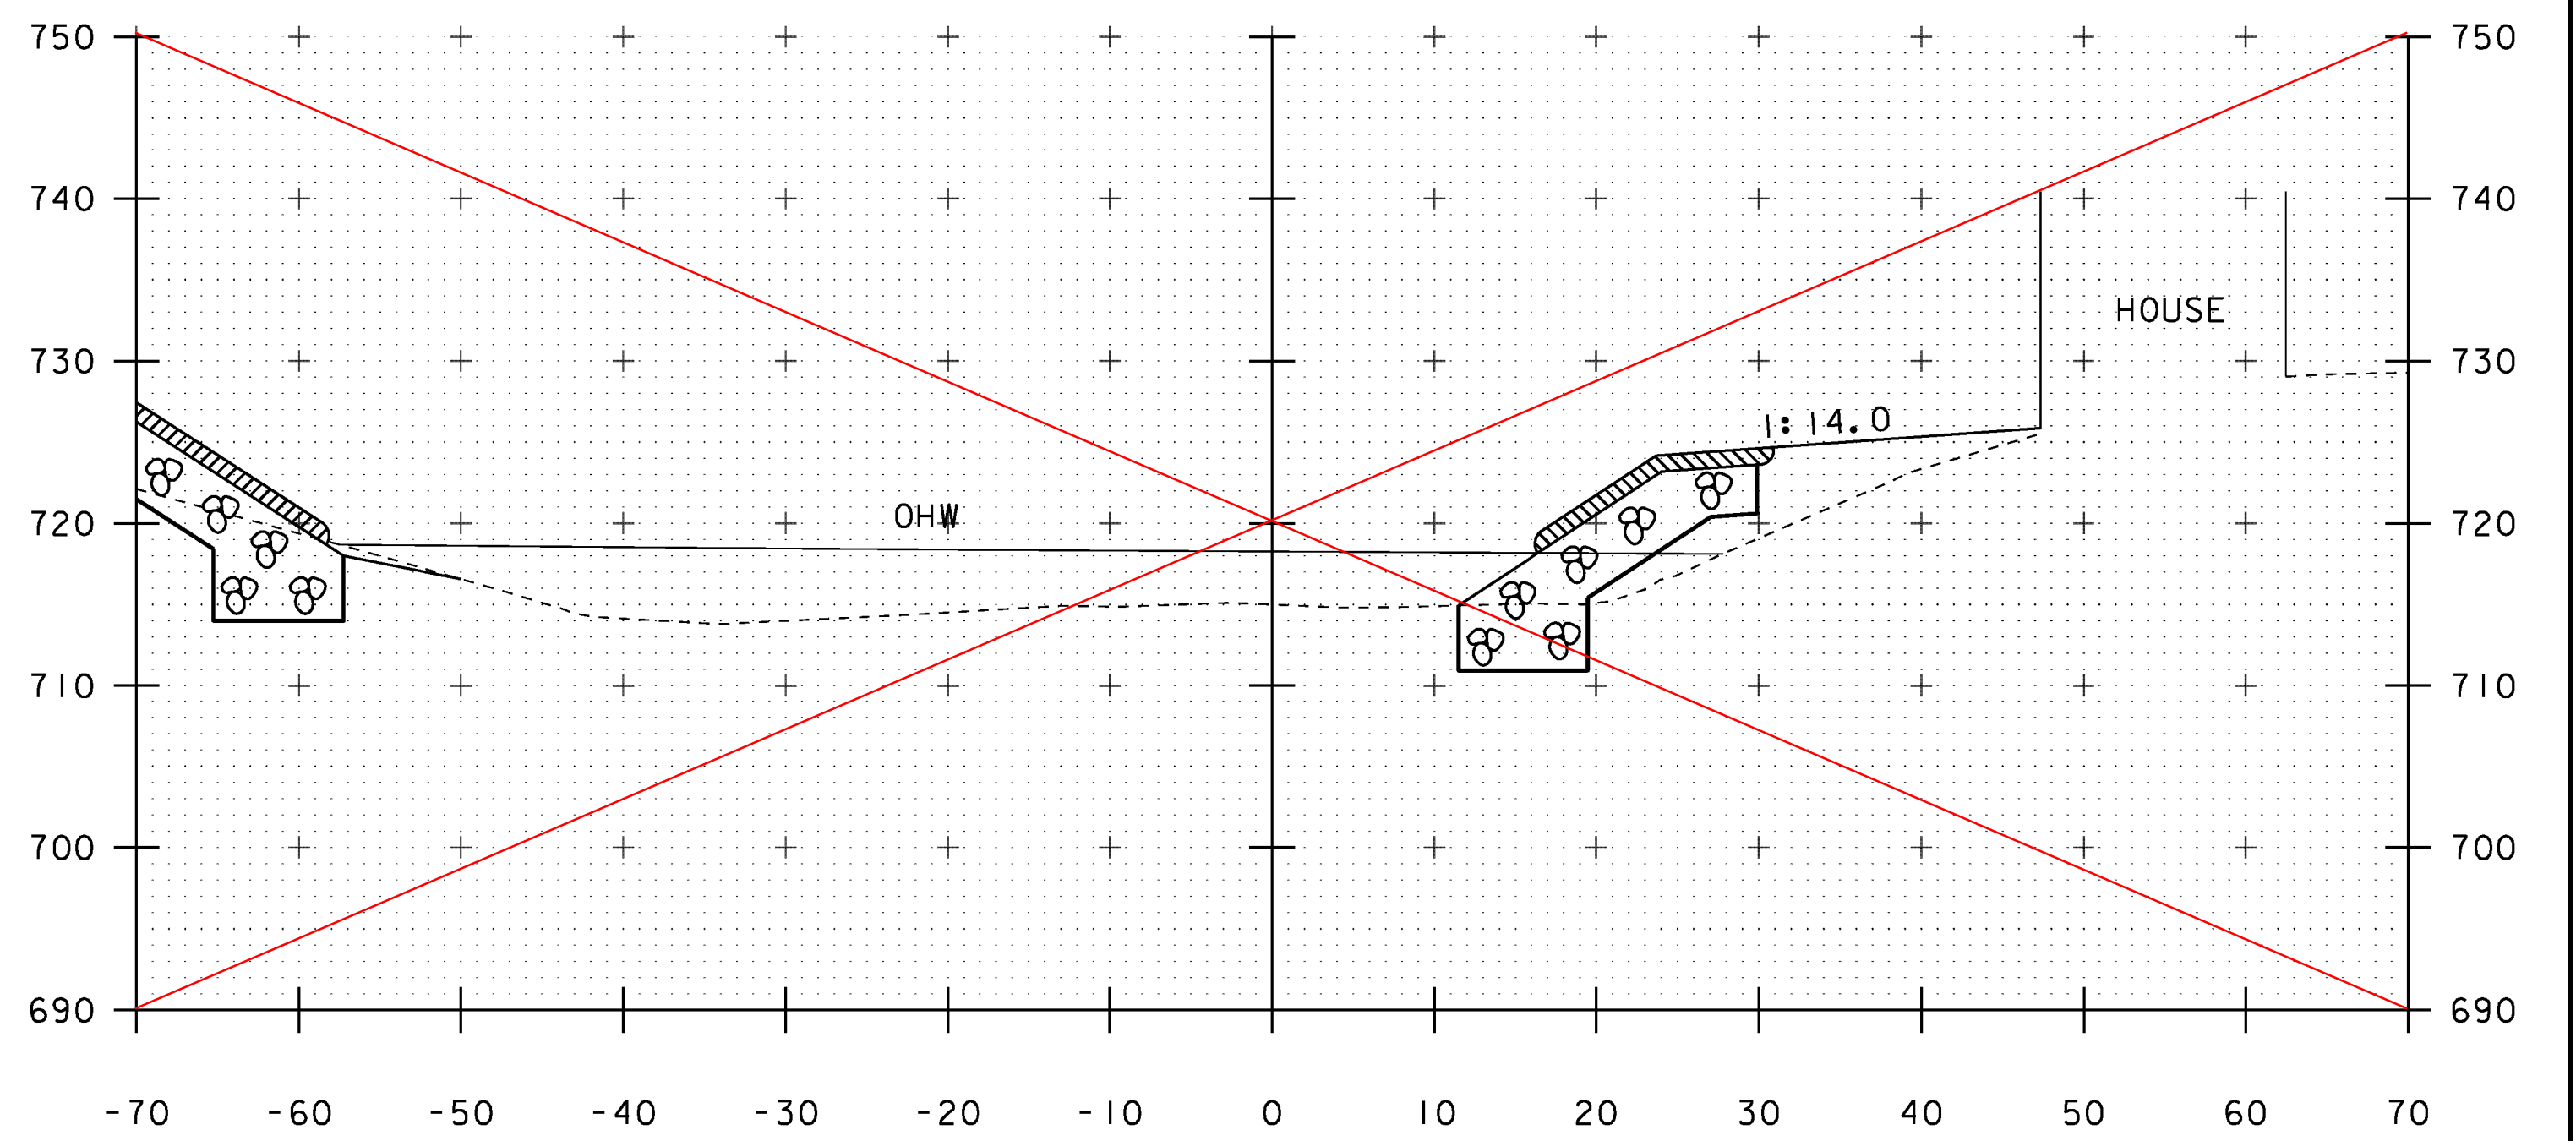


9+75

SEE ADDITIONAL CHANNEL SECTIONS
SHEET 2 OF 7.

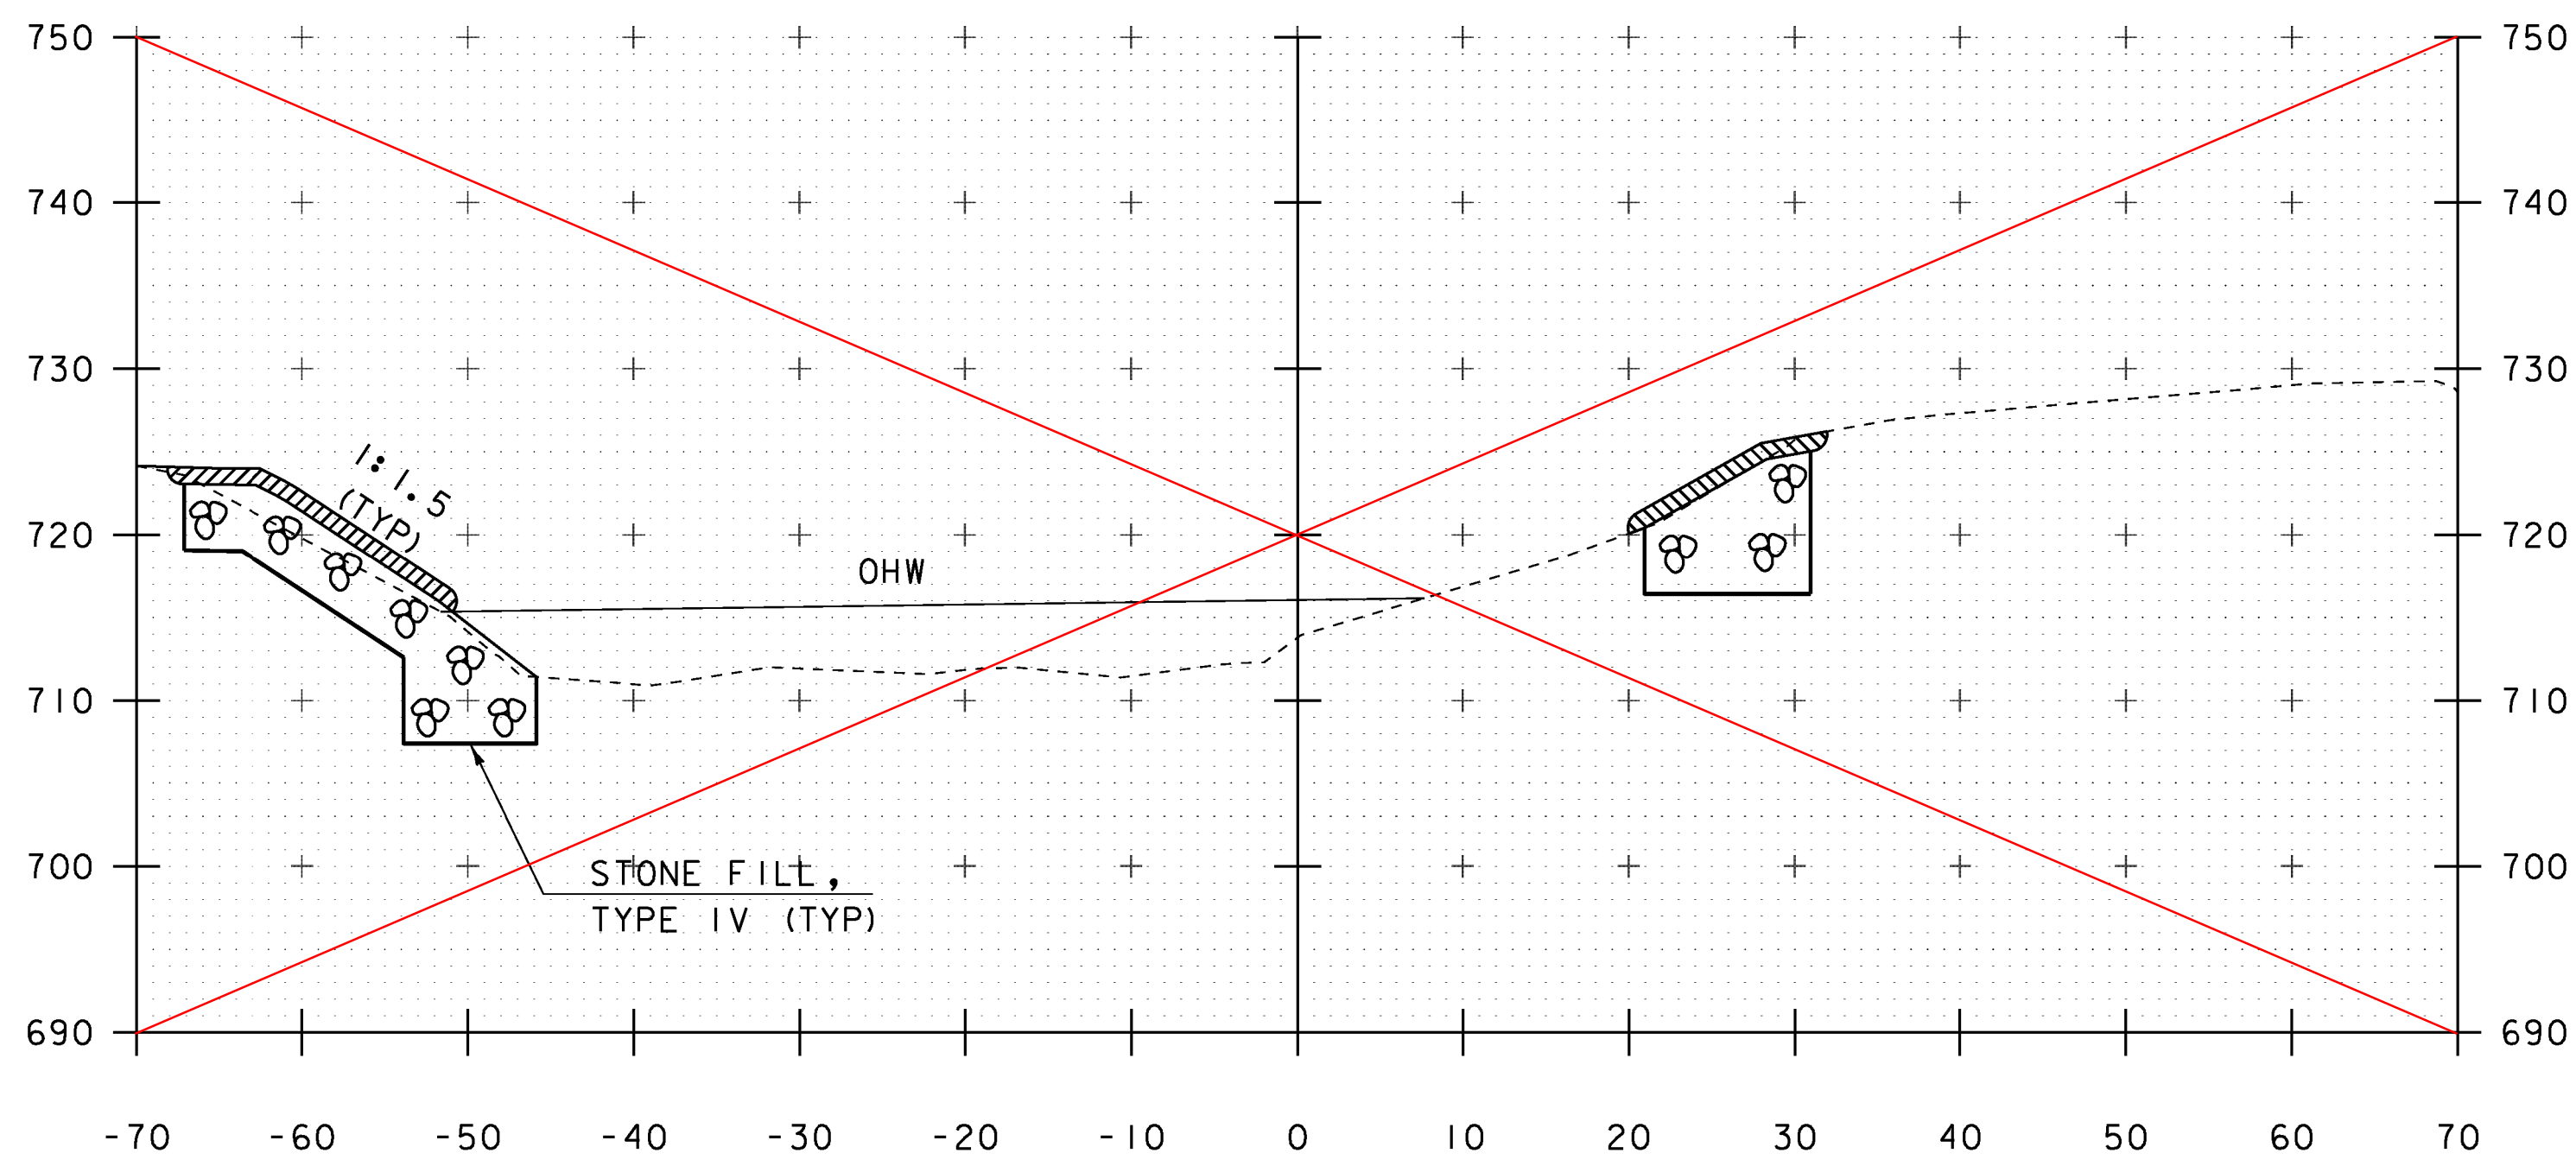

9+00

SEE ADDITIONAL CHANNEL SECTIONS
SHEET 1 OF 7.

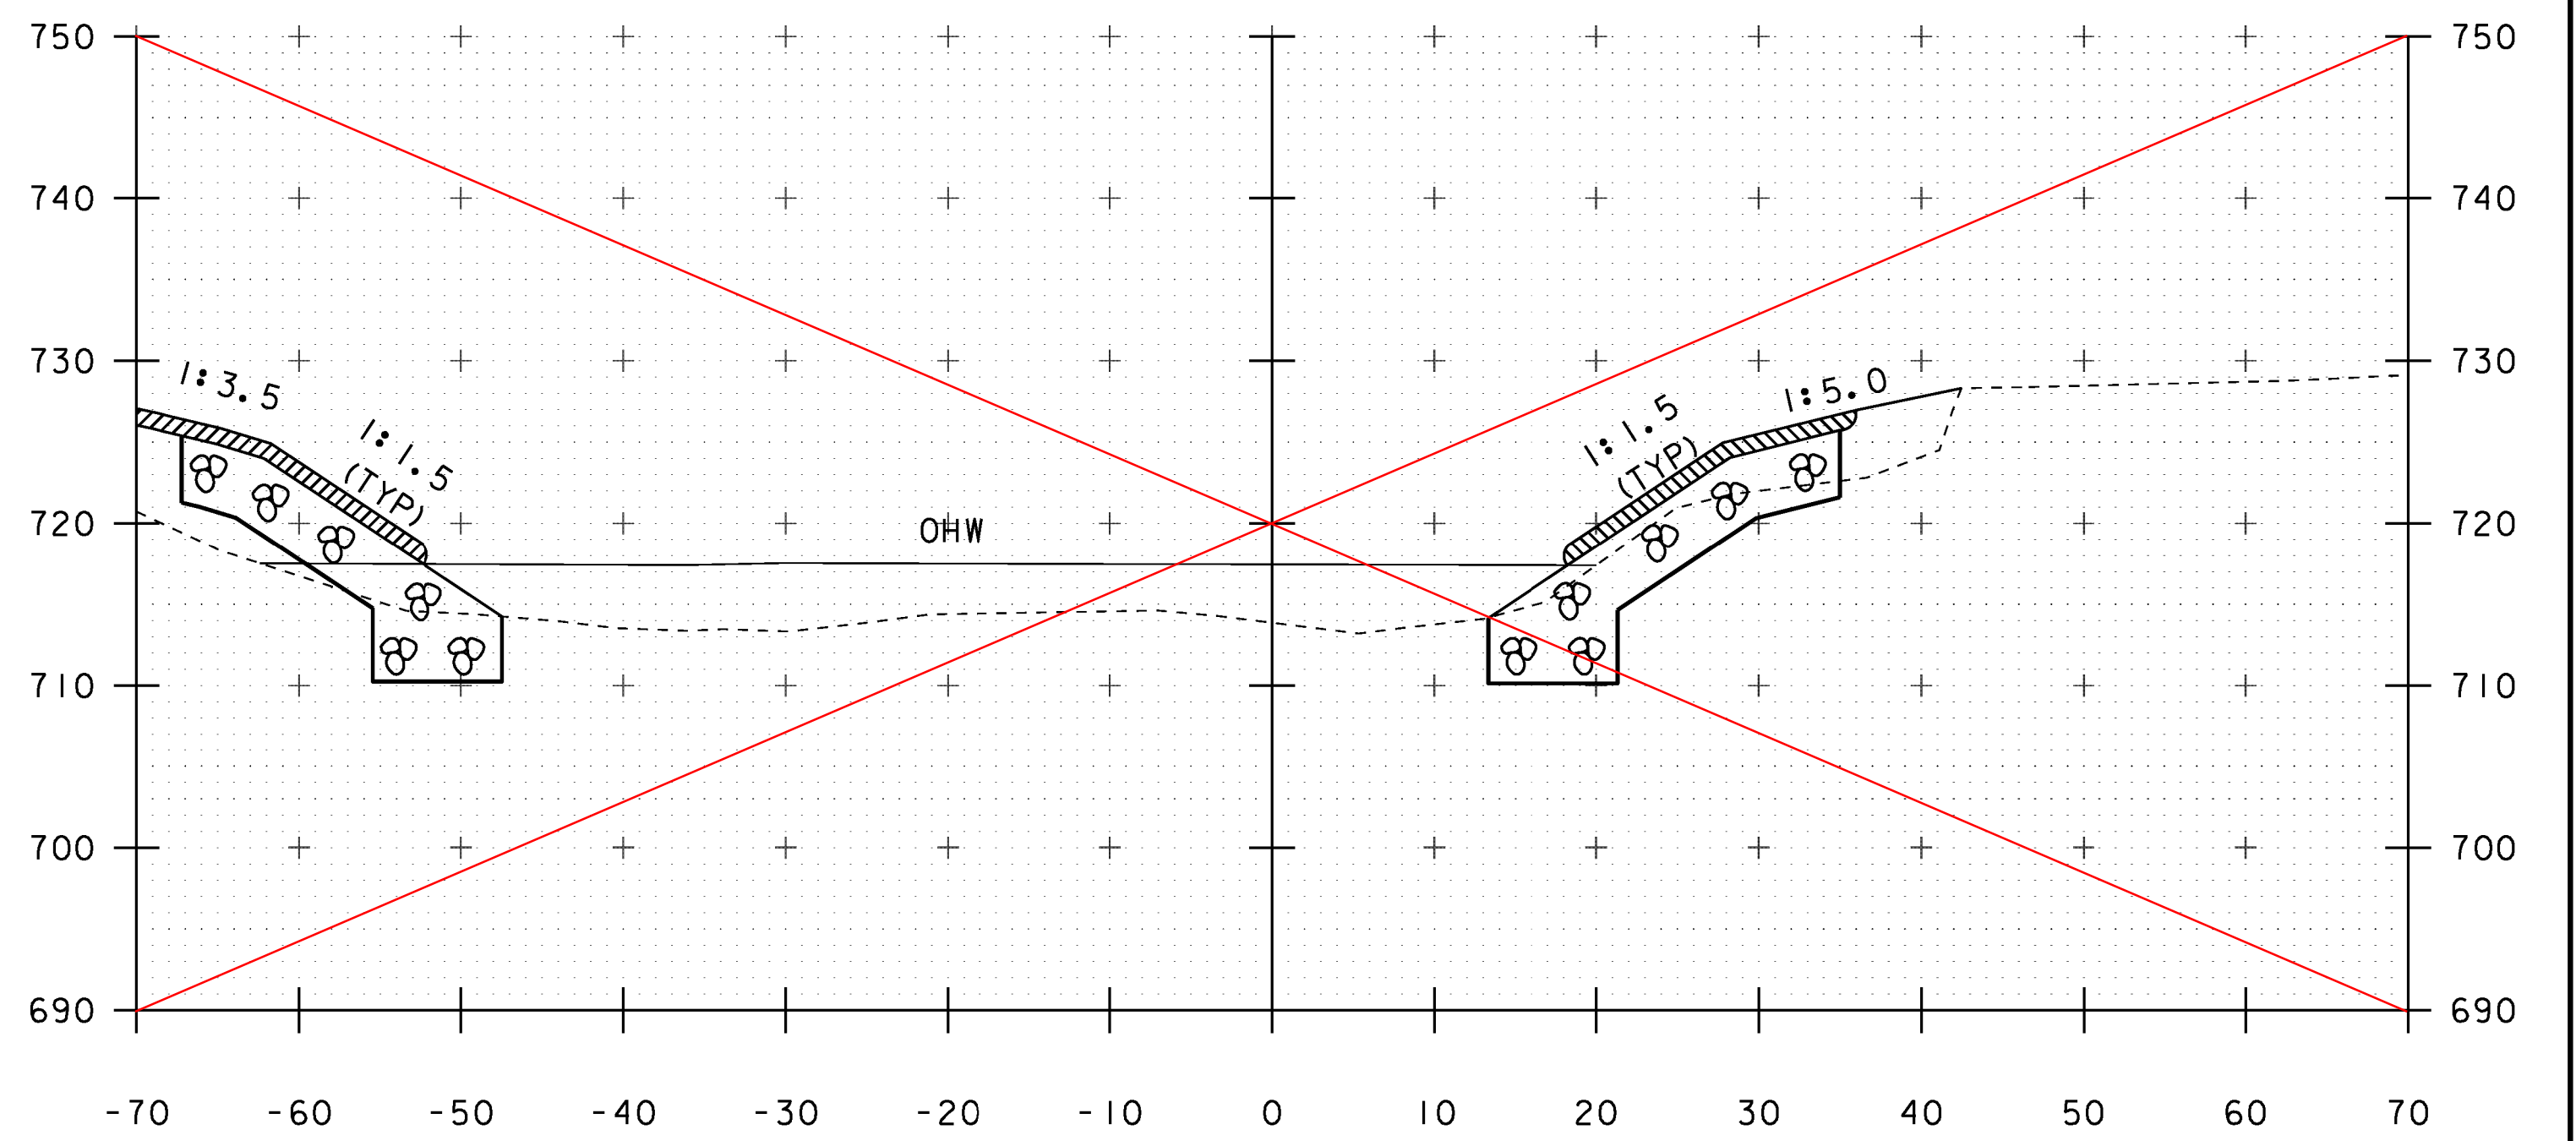

9+50

SEE ADDITIONAL CHANNEL SECTIONS
SHEET 2 OF 7.

SCALE 1" = 10'-0"
10 0 10

STA. 9+00 TO STA. 9+75

PROJECT NAME: JAMAICA
PROJECT NUMBER: ER-BRF 015-1(23)

FILE NAME: s1lb316.xsdgn
PROJECT LEADER: K. HIGGINS
DESIGNED BY: G. LAROCHE
CHANNEL SECTIONS 2

PLOT DATE: 07-DEC-2012
DRAWN BY: K. FRIEDLAND
CHECKED BY: G. LAROCHE
SHEET 71 OF 82