



10+25 SEE ADDITIONAL CHANNEL SECTIONS SHEET 4 OF 7.

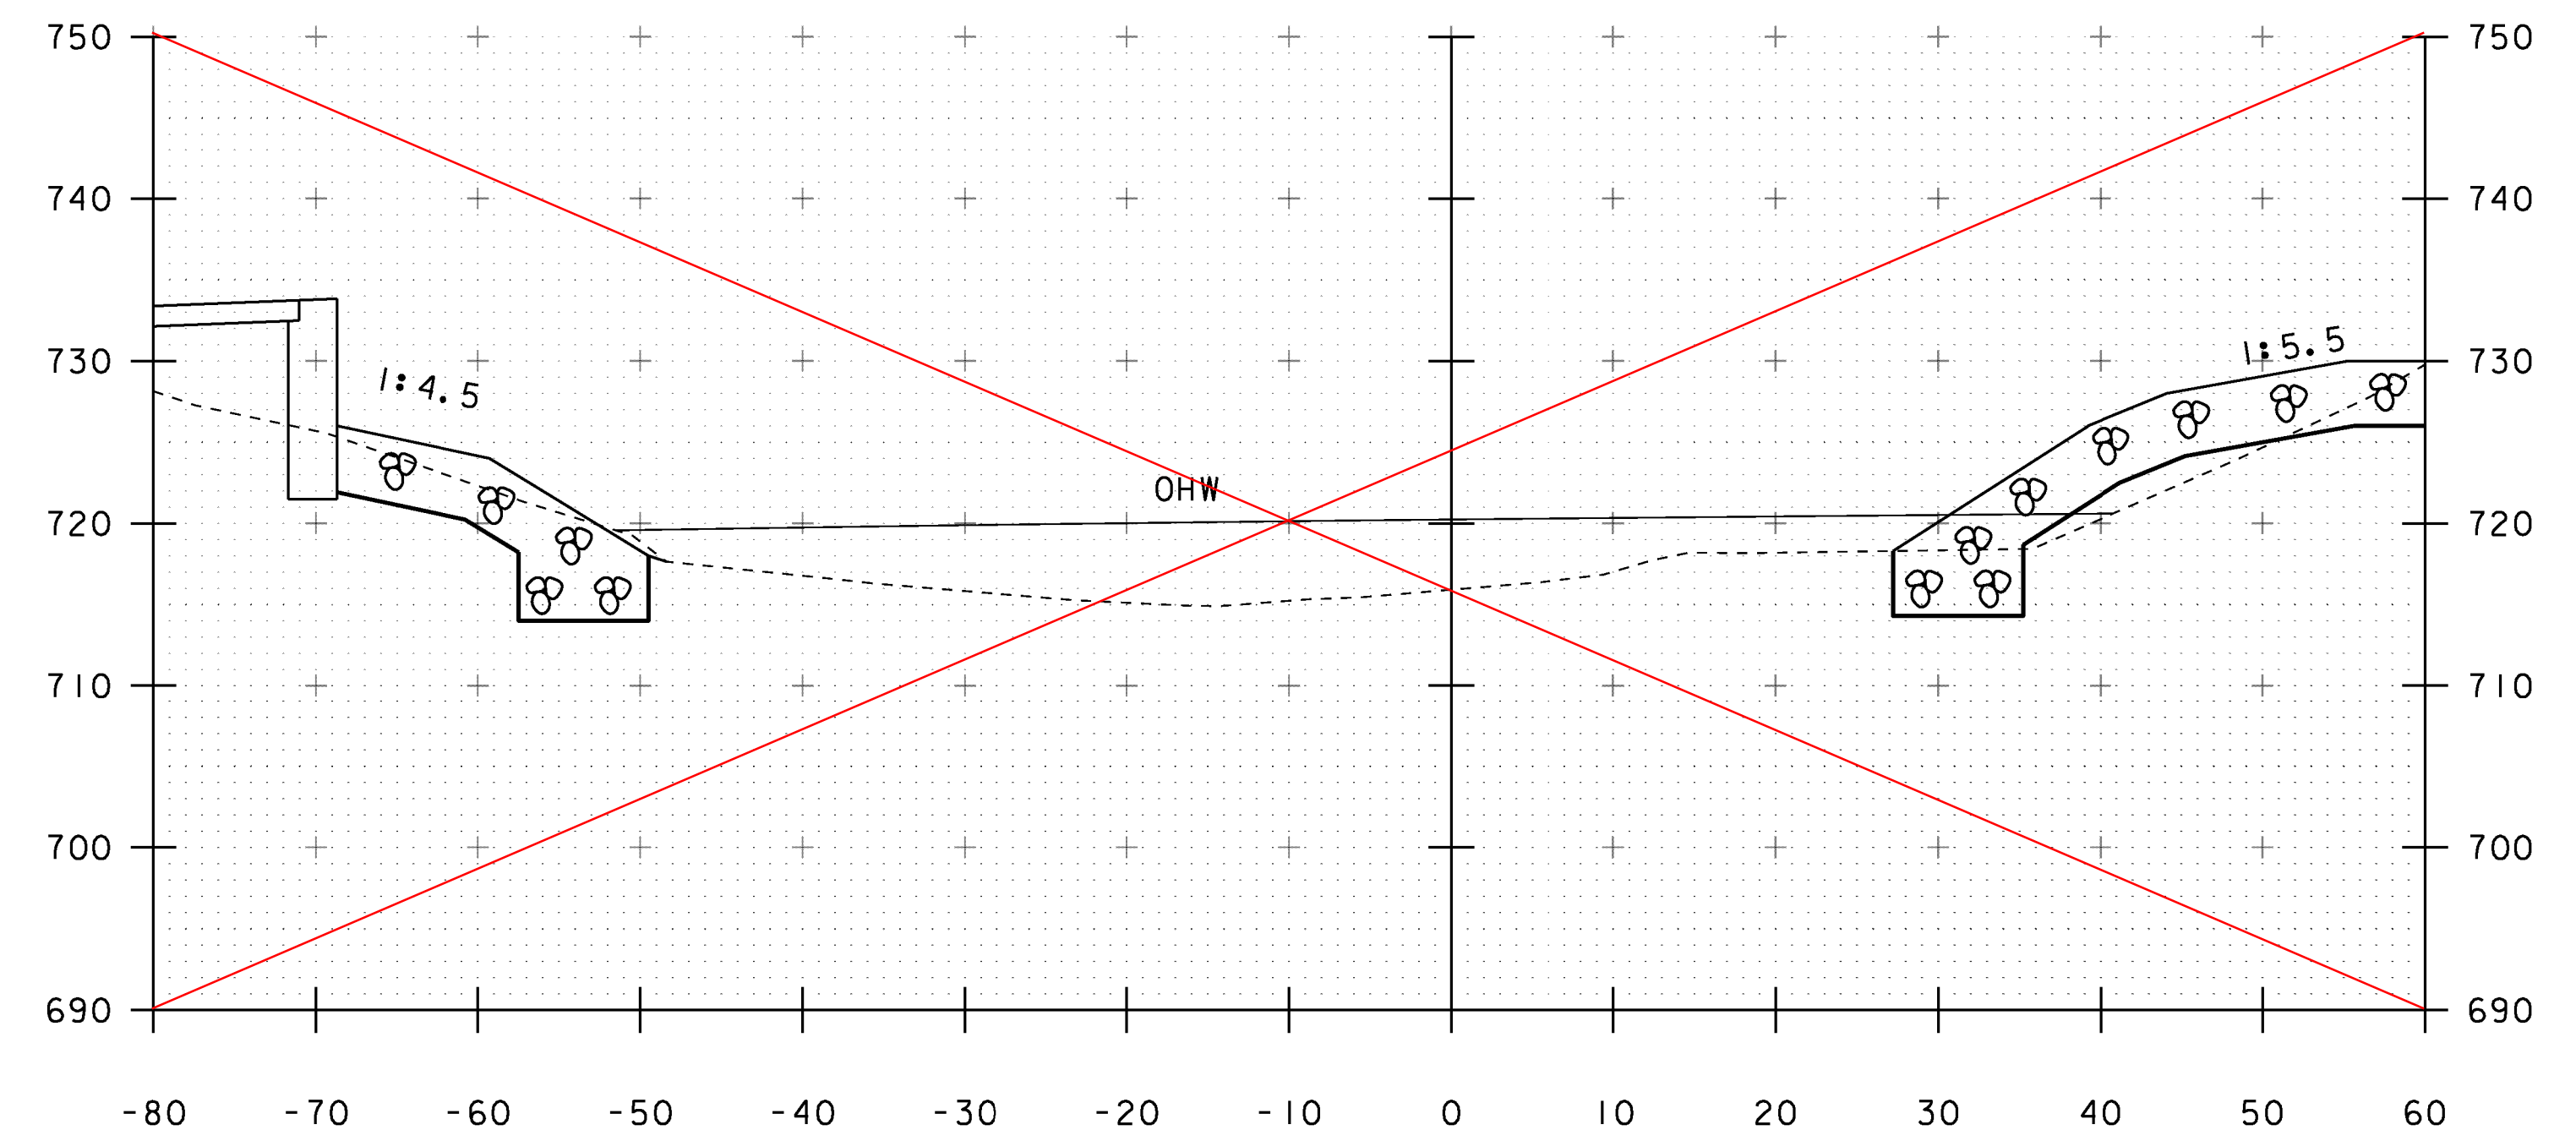


10+40 SEE ADDITIONAL CHANNEL SECTIONS SHEET 5 OF 7.

STA 10+31.50 LT  
END GRUBBING MATERIAL

STA 10+30.00 RT  
END GRUBBING MATERIAL

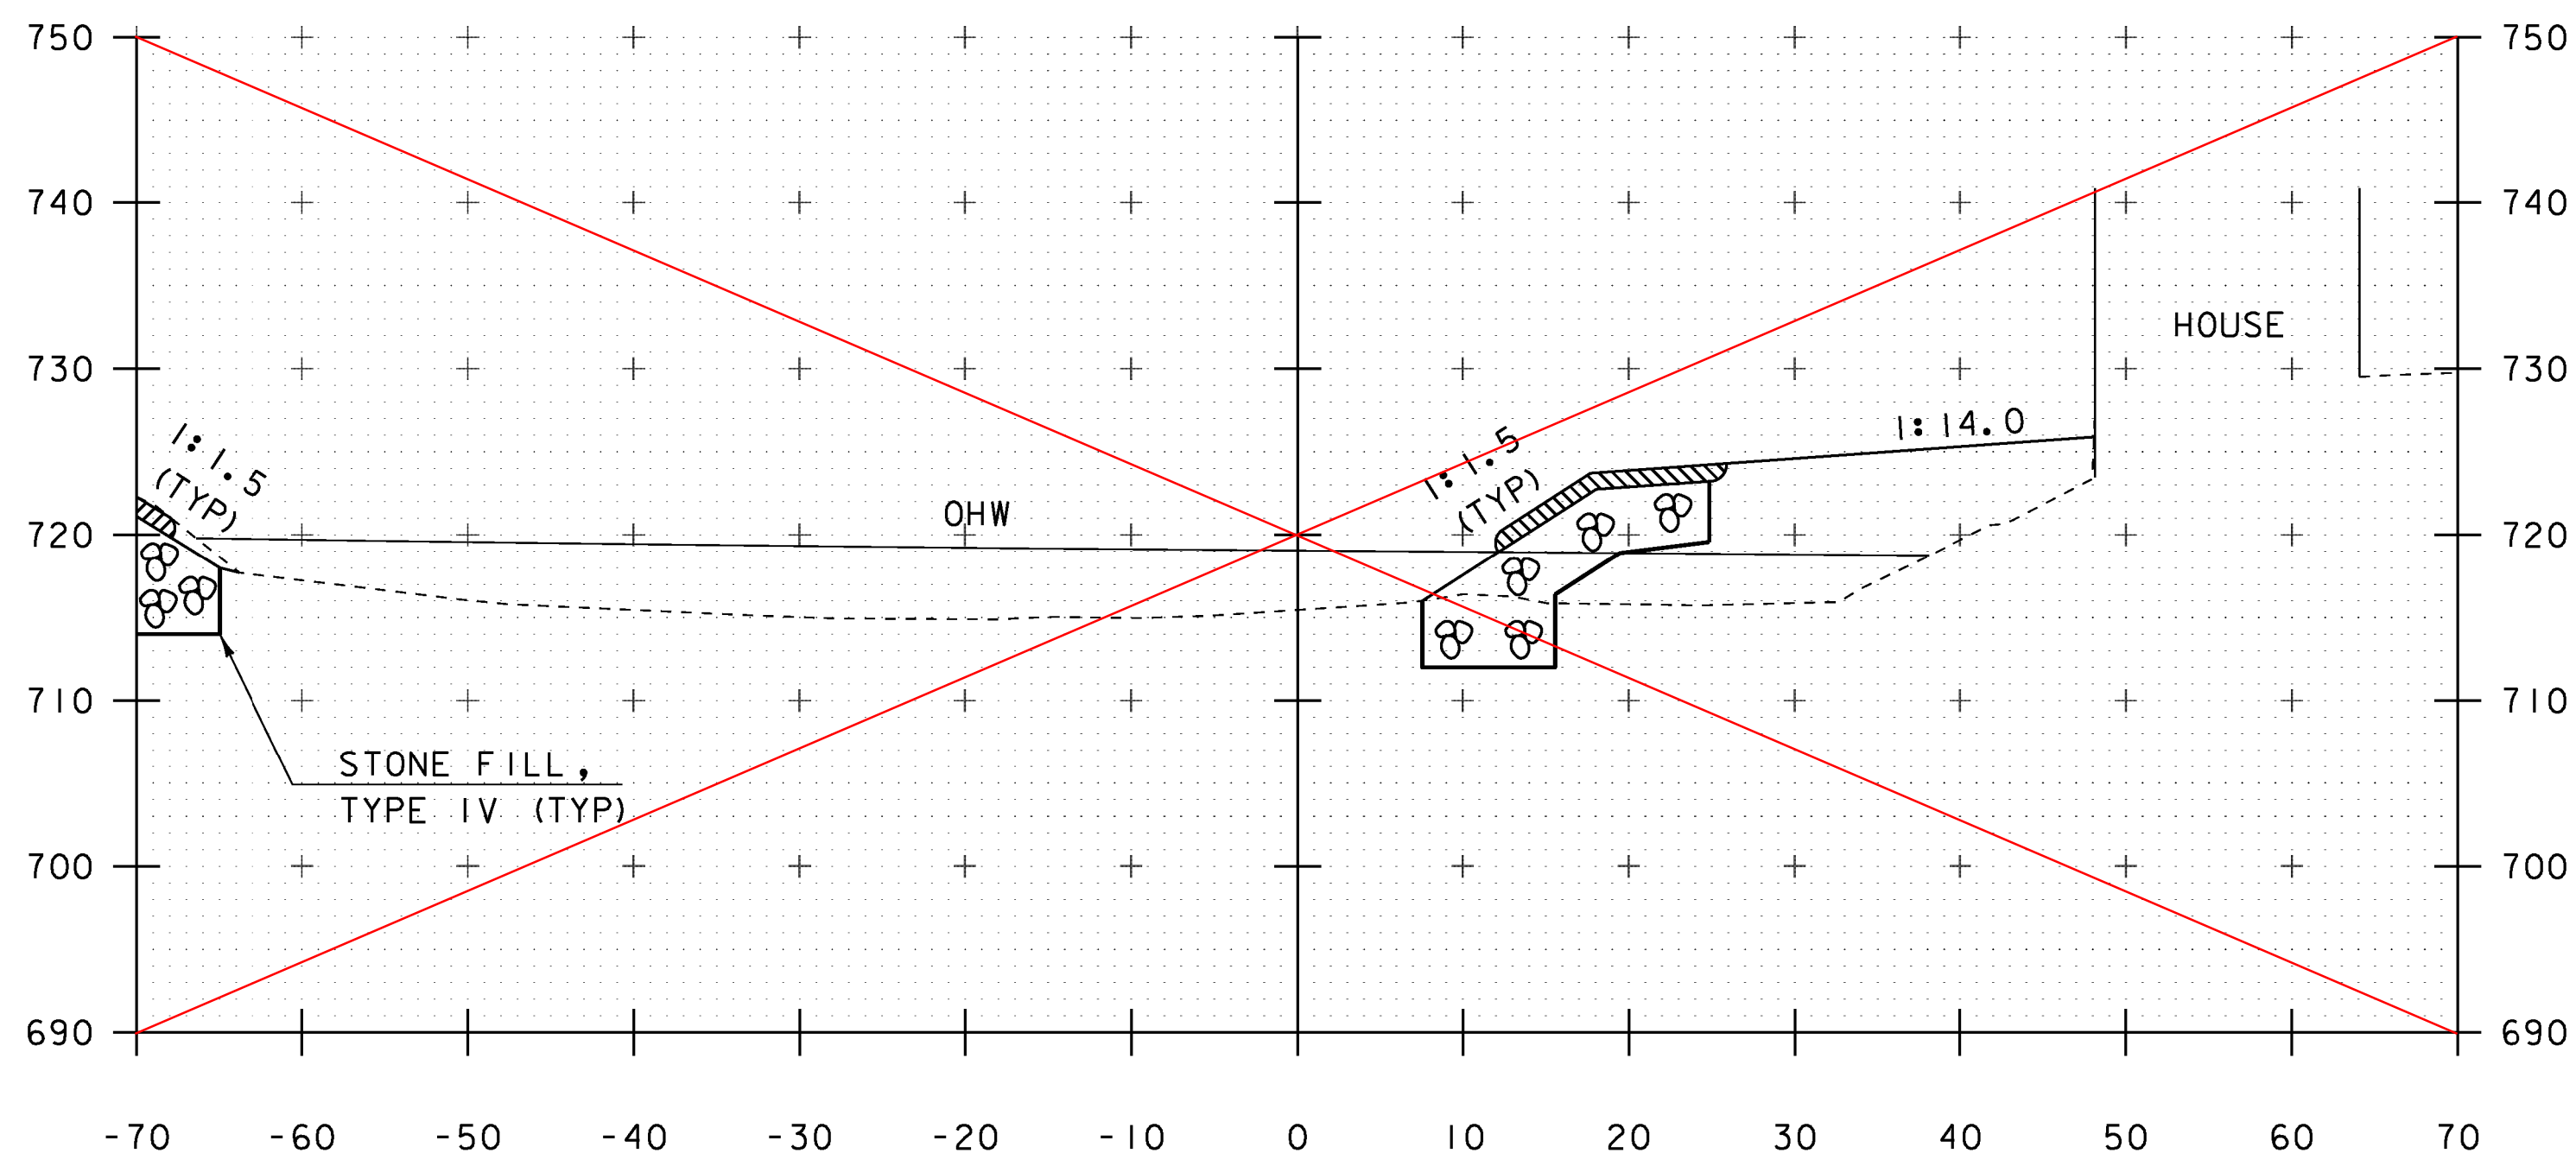

10+00 SEE ADDITIONAL CHANNEL SECTIONS SHEET 3 OF 7.

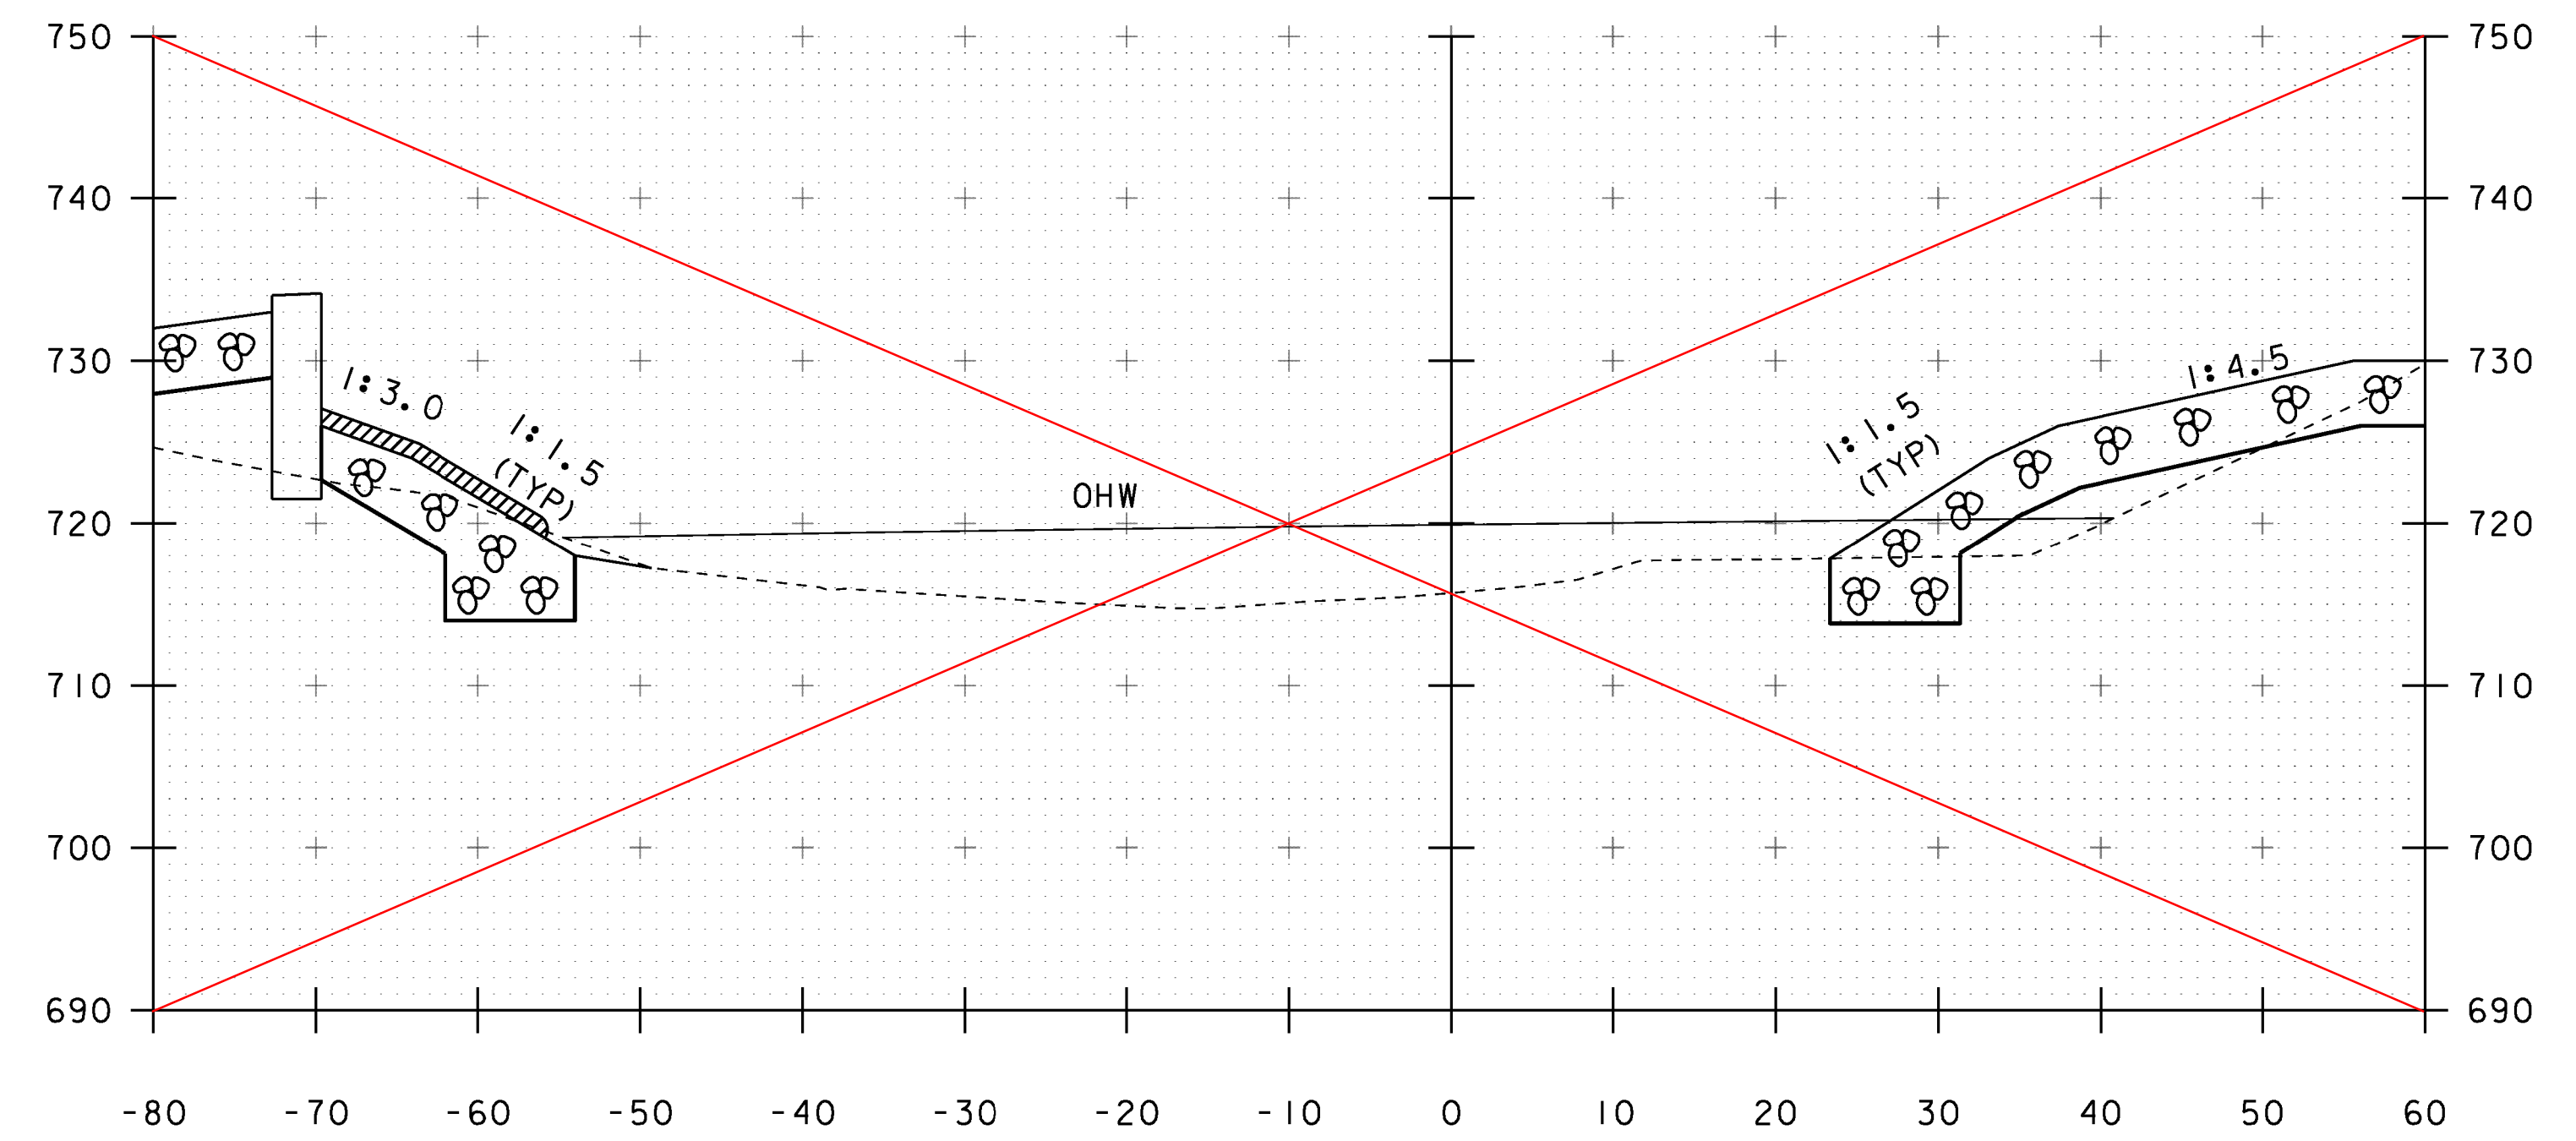

10+30 SEE ADDITIONAL CHANNEL SECTIONS SHEET 4 OF 7.

SCALE 1" = 10'-0"  
10 0 10

STA. 10+00 TO STA. 10+40

PROJECT NAME:	JAMAICA	FILE NAME:	s1lb316.xs.dgn	PLOT DATE:	07-DEC-2012
PROJECT NUMBER:	ER-BRF 015-1(23)	PROJECT LEADER:	K. HIGGINS	DRAWN BY:	K. FRIEDLAND
		DESIGNED BY:	G. LAROCHE	CHECKED BY:	G. LAROCHE
		CHANNEL SECTIONS 3		SHEET	72 OF 82