




10+60

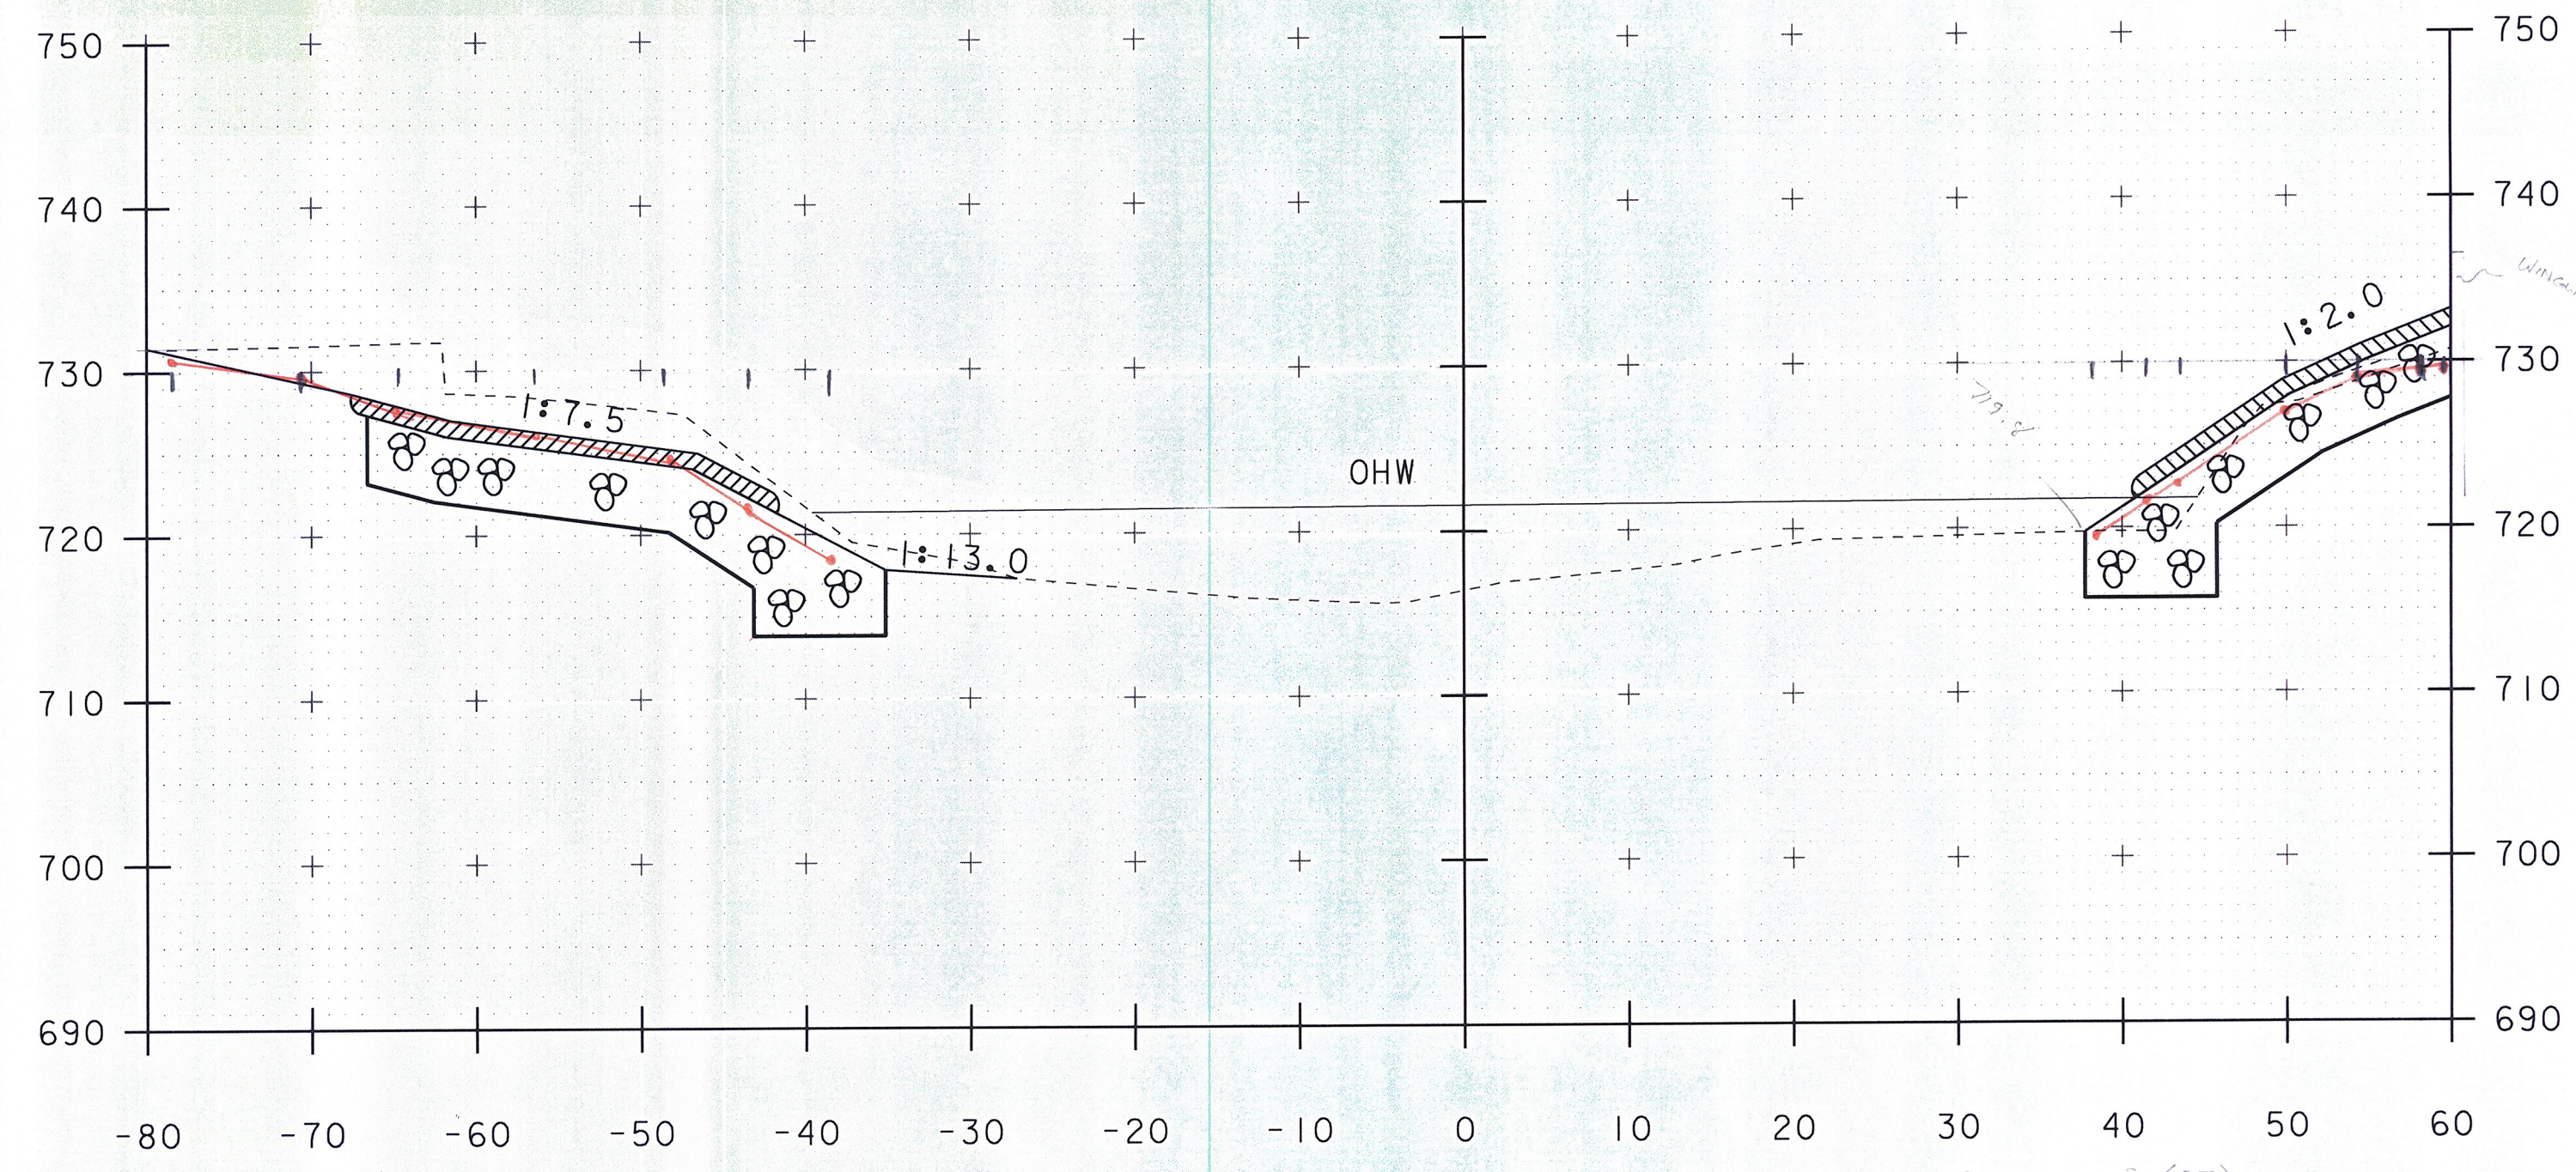

10+80

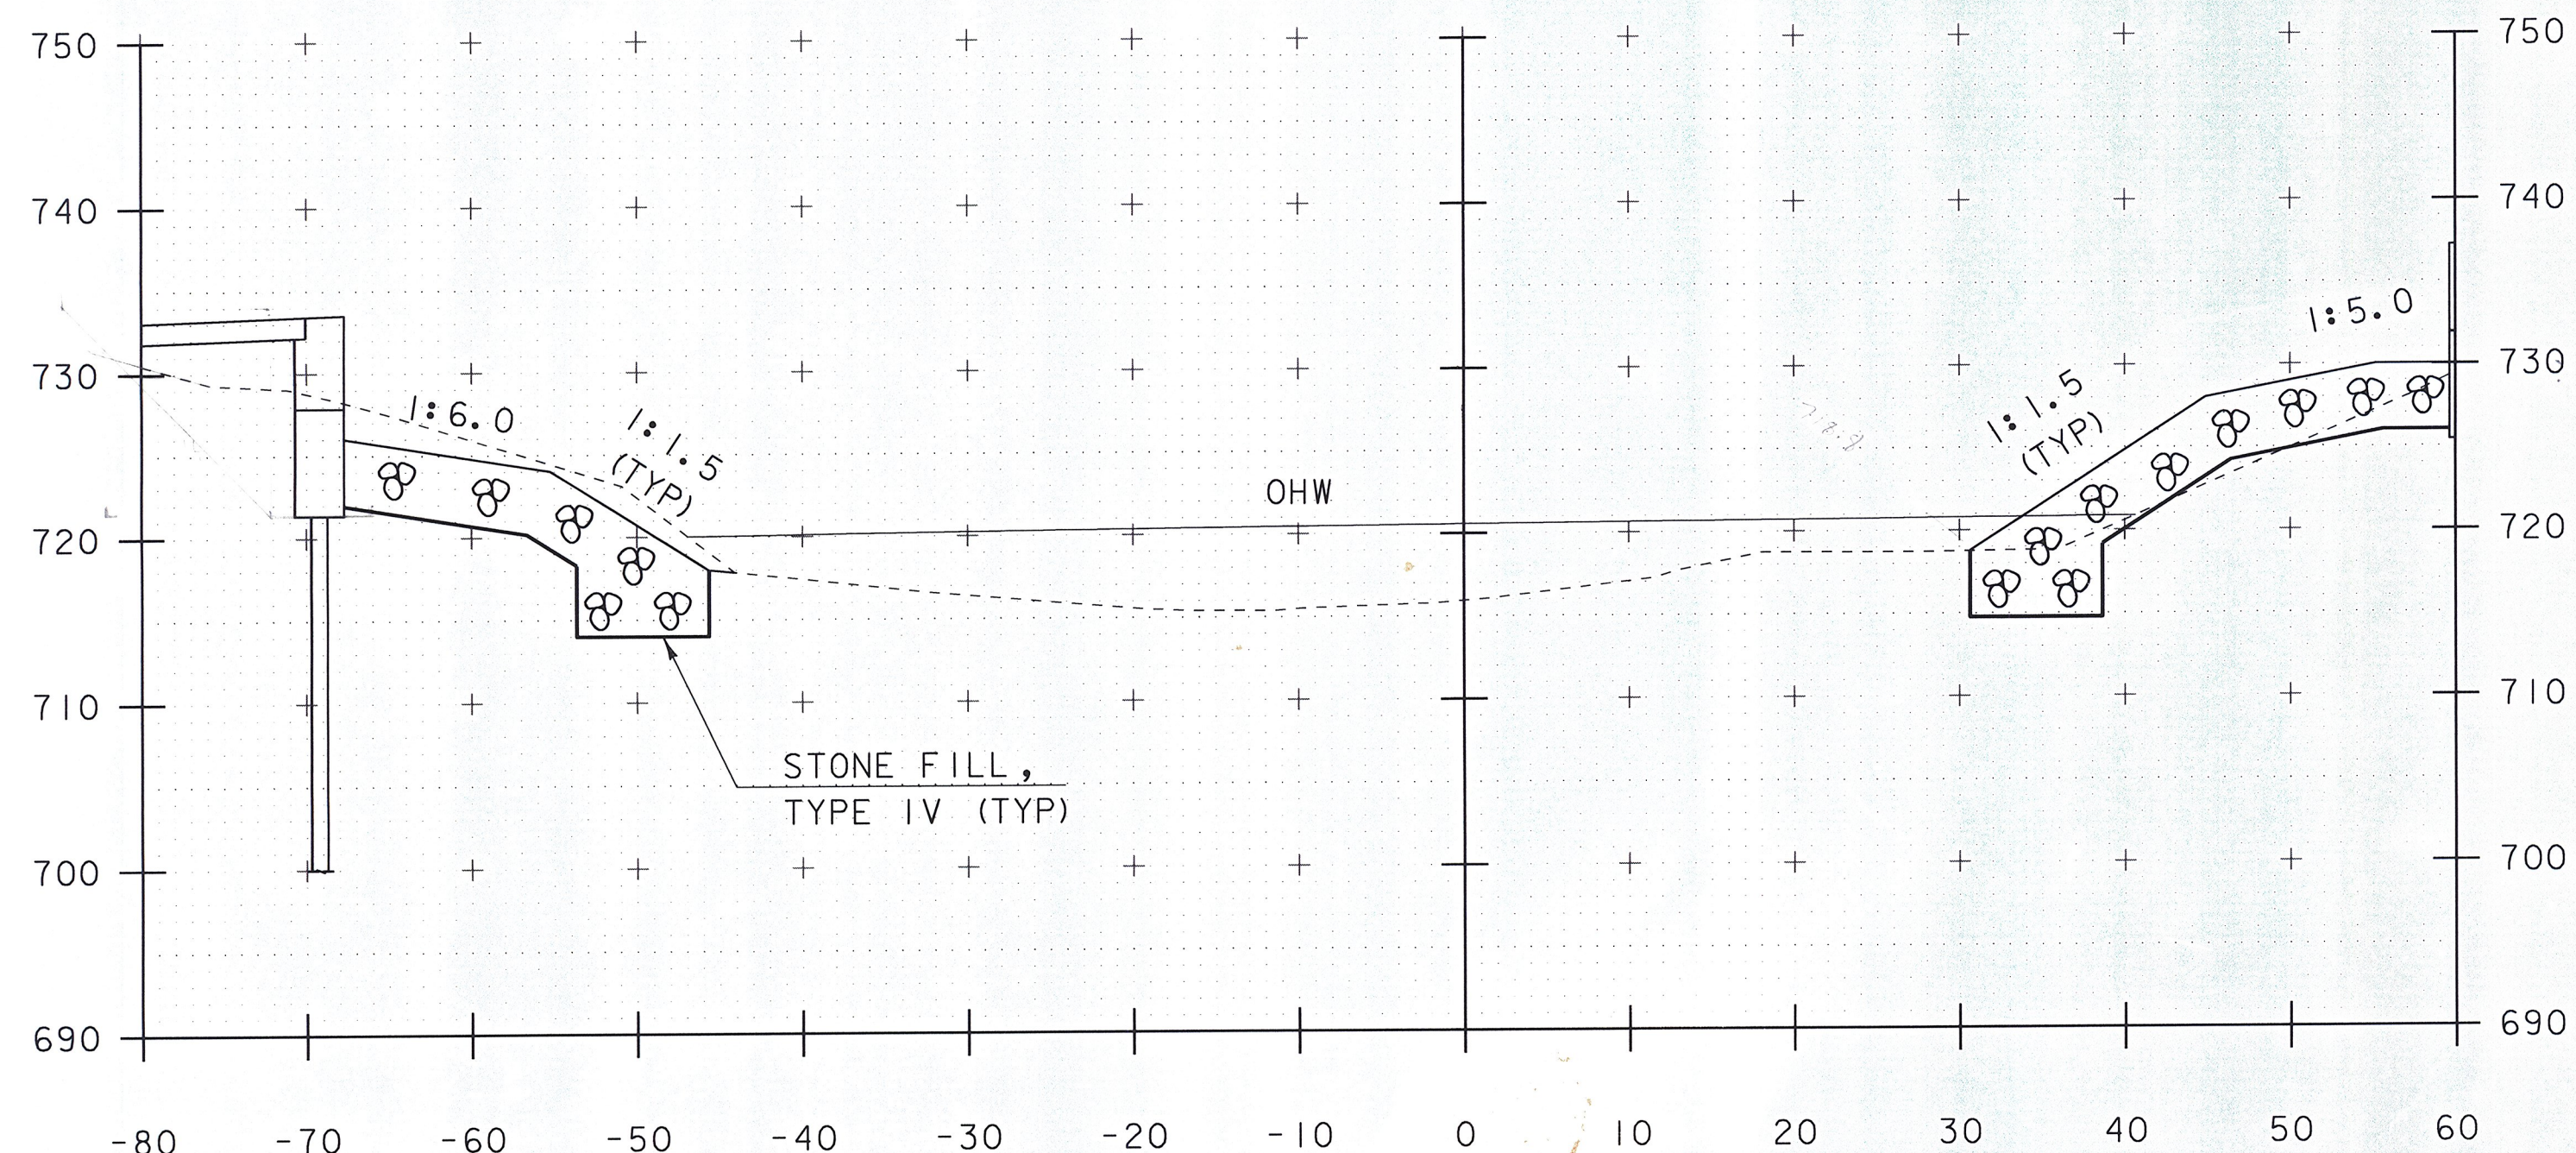

10+50

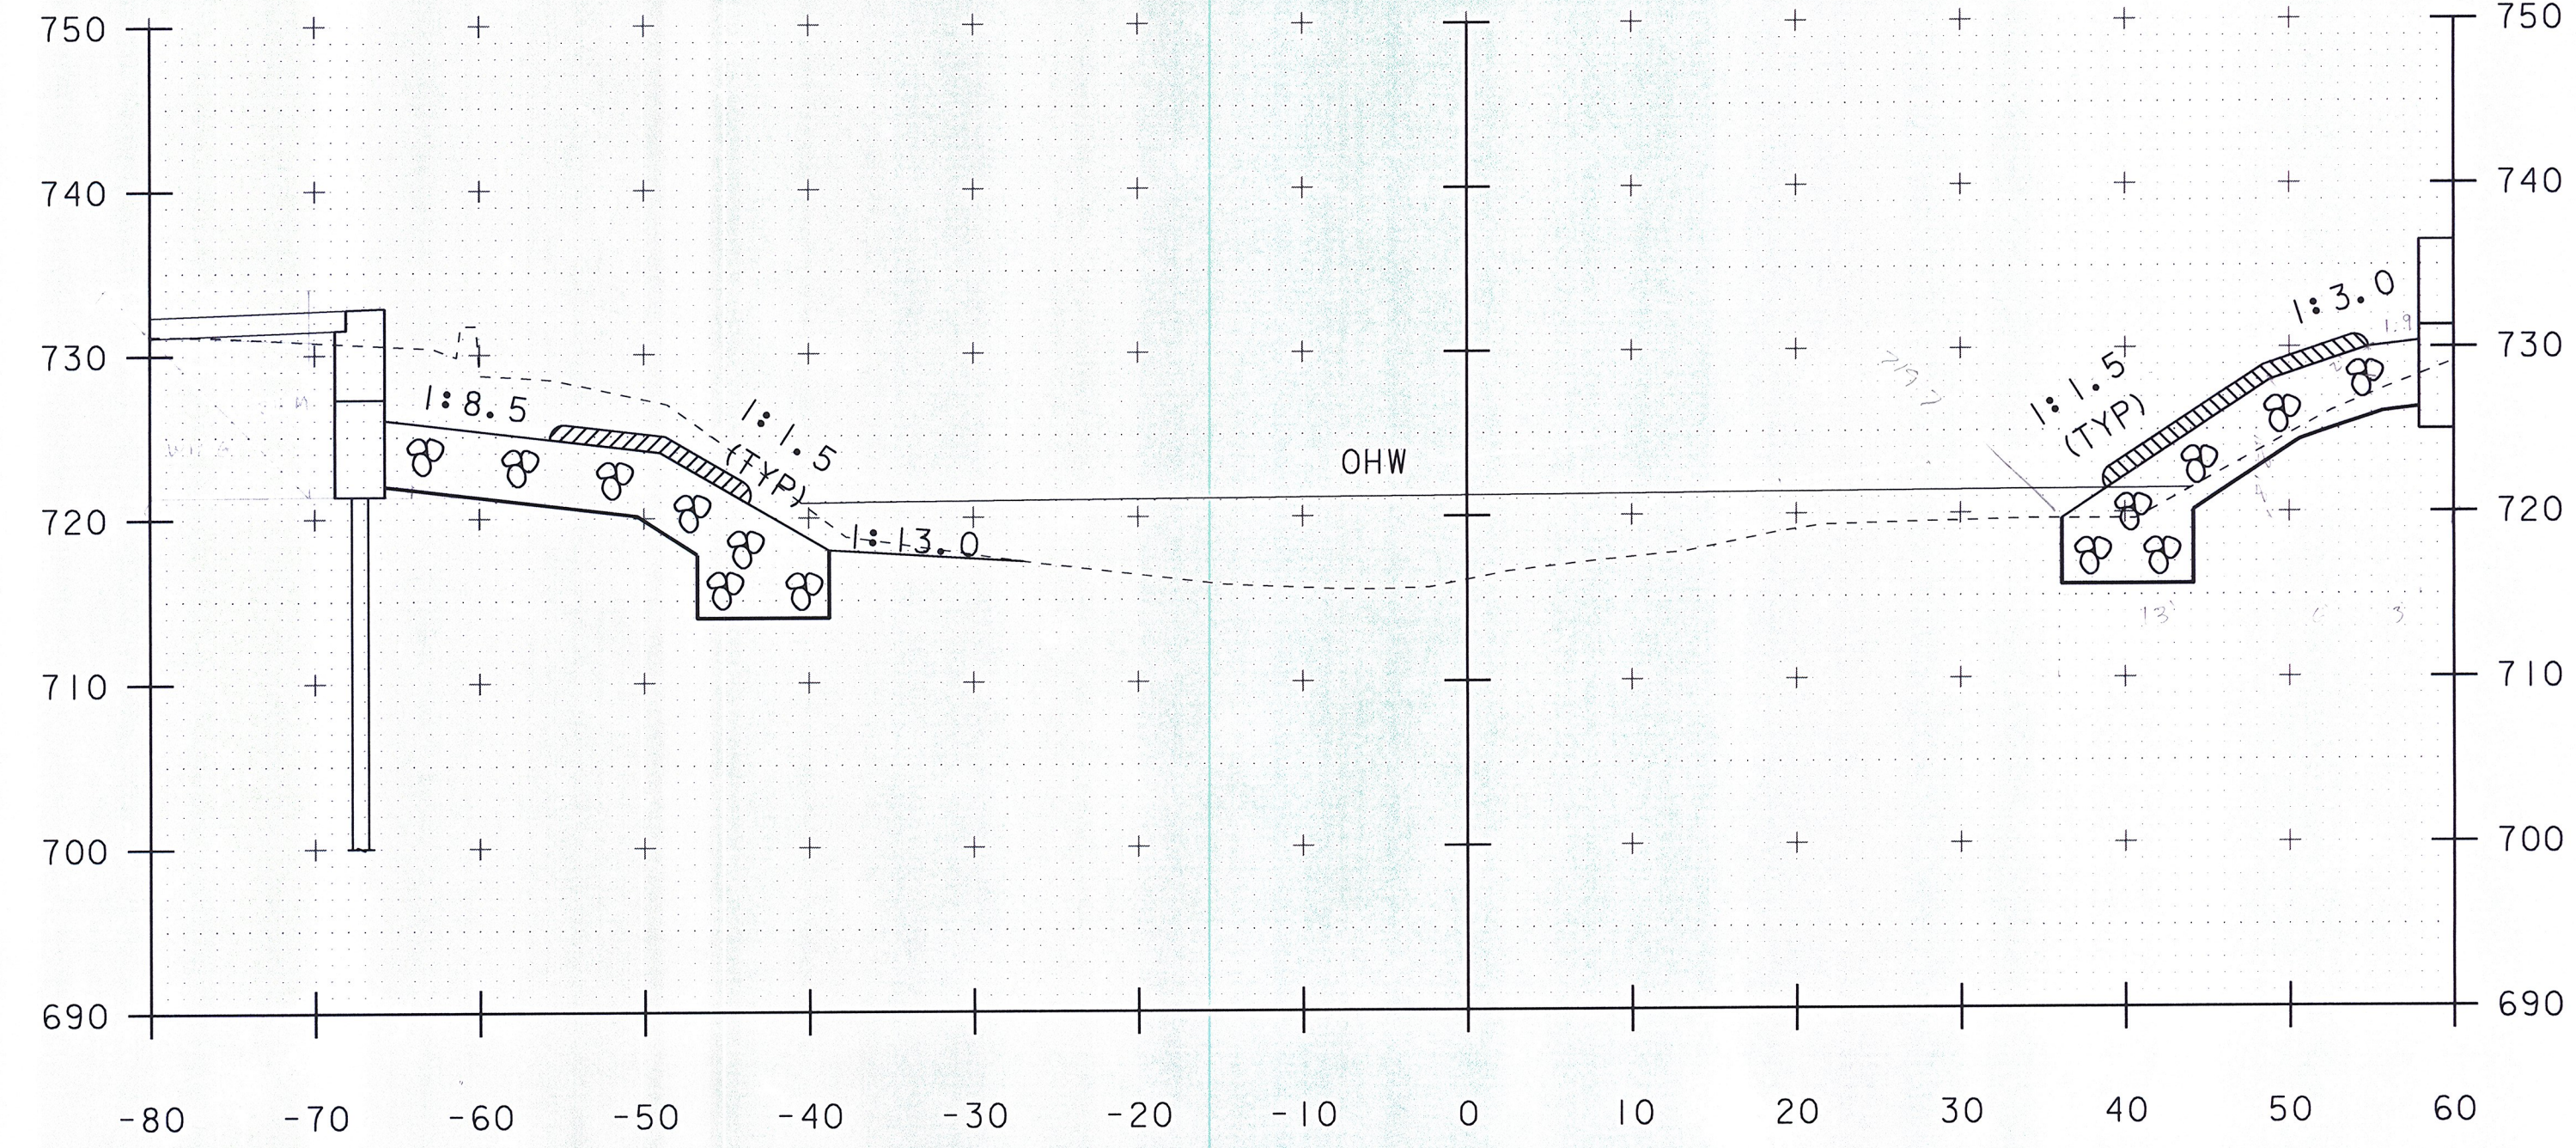

10+70

STA 10+69.00 LT
BEGIN GRUBBING MATERIAL

STA 10+69.00 RT
BEGIN GRUBBING MATERIAL

SCALE 1" = 10'-0"
10 0 10

PROJECT NAME: JAMAICA
PROJECT NUMBER: ER-BRF 015-1(23)

FILE NAME: sllb316.xs.dgn
PROJECT LEADER: K. HIGGINS
DESIGNED BY: G. LAROCHE
CHANNEL SECTIONS 4

PLOT DATE: 07-DEC-2012
DRAWN BY: K. FRIEDLAND
CHECKED BY: G. LAROCHE
SHEET 73 OF 82

STA. 10+50 TO STA. 10+80