


12+25


STA 12+25.00 RT
 END UNCLASSIFIED CHANNEL EXCAVATION
 END GEOTEXTILE UNDER STONE FILL
 END STONE FILL, TYPE IV
 END GRUBBING MATERIAL

CBE 3/28/14

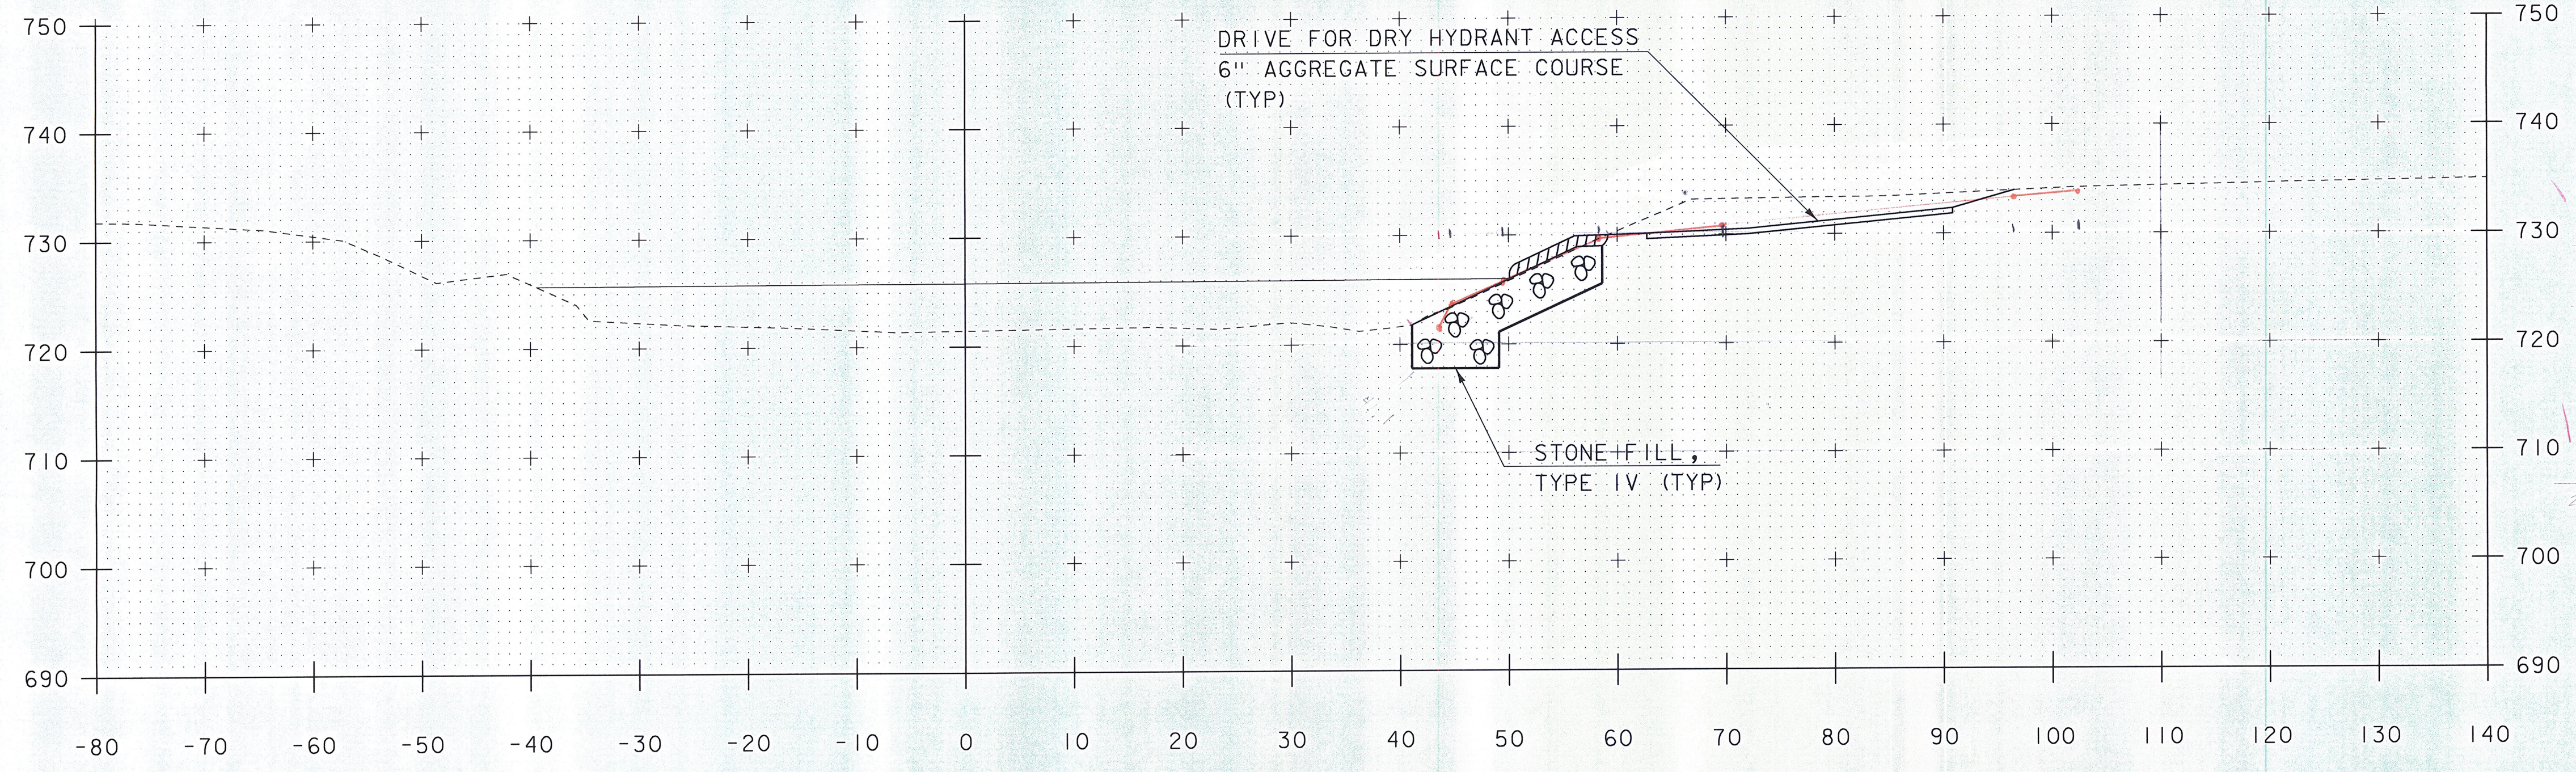

12+00

STONE FILL
 0.43
 3.90 ✓
 0.28
 5.71/10.00 = 57.1%
 Ancl...
 0.90 ✓
 1.21 ✓
 0.10 ✓
 1.22 ✓
 3.43 ✓
 5.71/10.00 = 57.1%
 GEOTEXTILE
 UNCLASSIFIED EXCAVATION
 5.77
 0.62
 0.80
 2.39/3 = 0.79/1.00 = 79.1%
 MFL 10/10/14

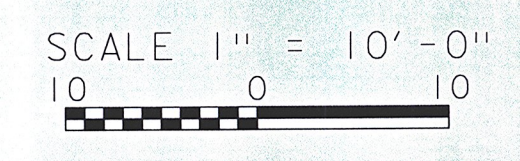

STA. 12+00 TO STA. 12+25

PROJECT NAME:	JAMAICA	PLOT DATE:	07-DEC-2012
PROJECT NUMBER:	ER-BRF 015-1 (23)	DRAWN BY:	K. FRIEDLAND
FILE NAME:	slib316.xs.dgn	CHECKED BY:	G. LAROCHE
PROJECT LEADER:	K. HIGGINS	CHANNEL SECTIONS	9
DESIGNED BY:	G. LAROCHE	SHEET	78 OF 82