



12+75

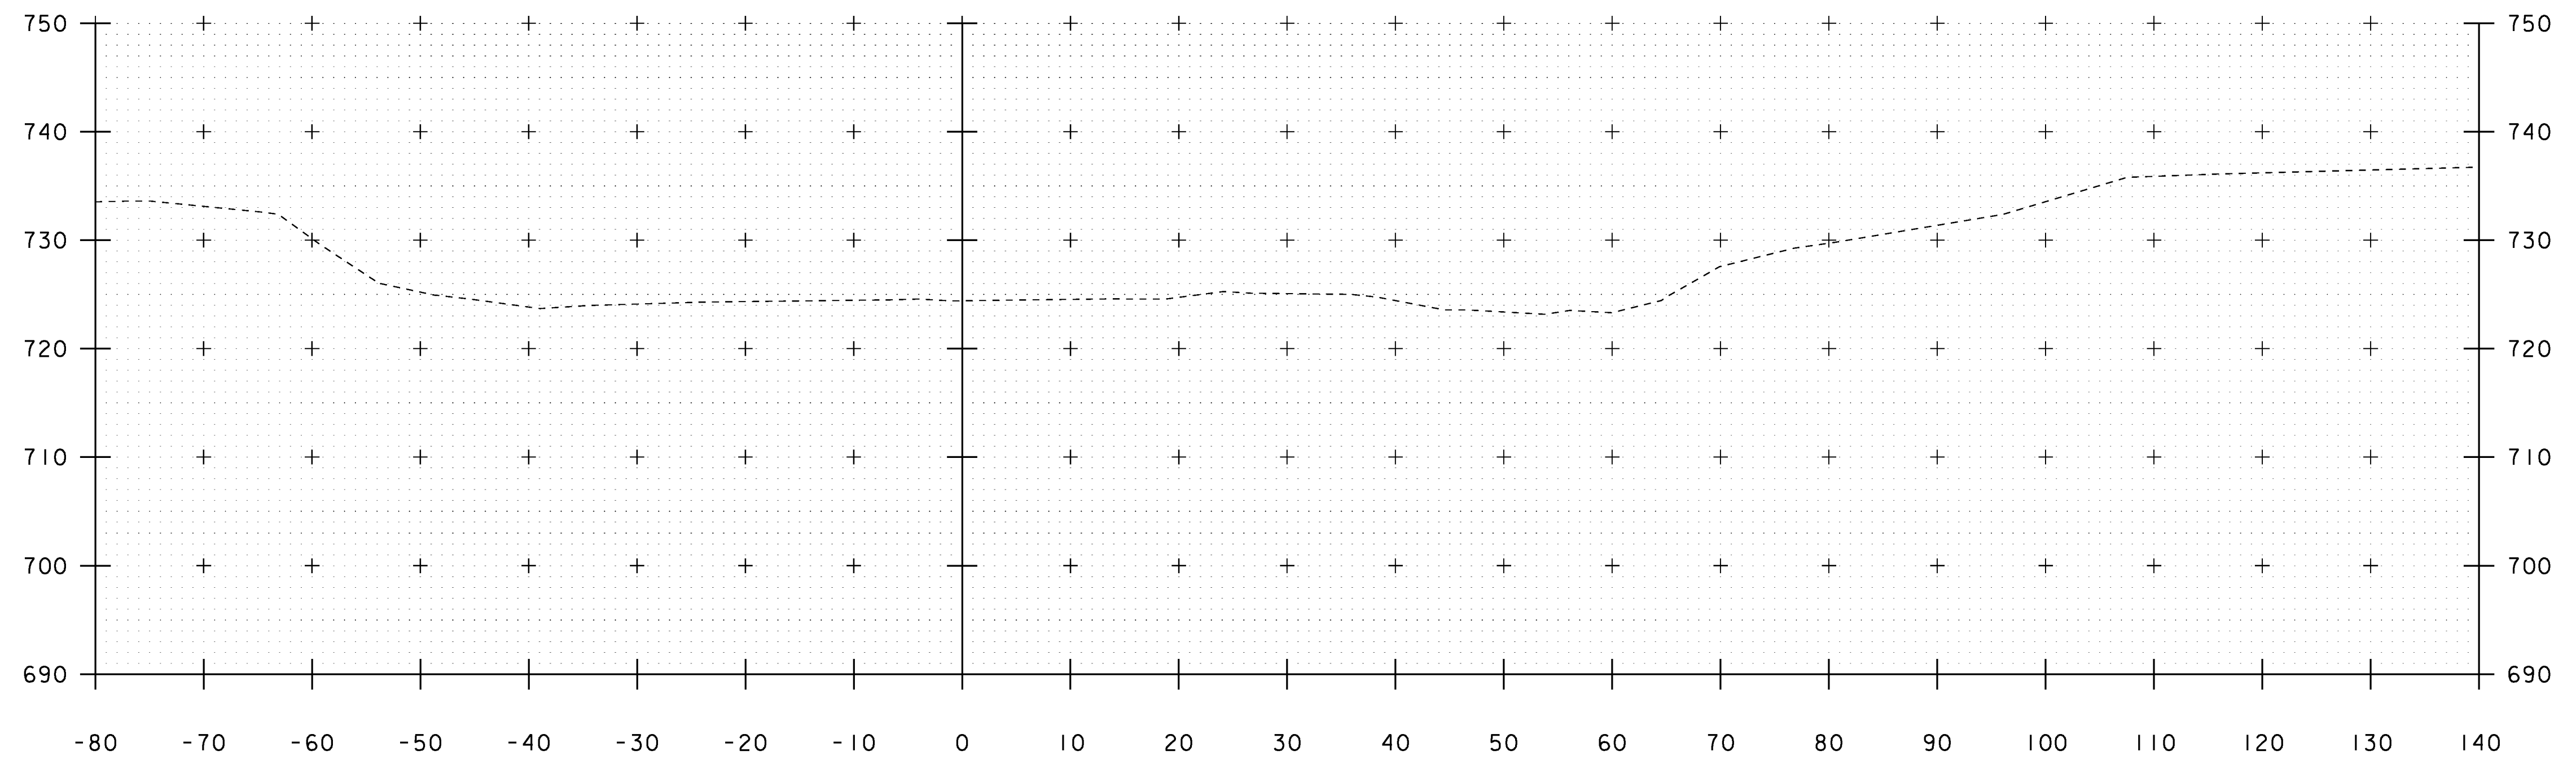

12+50

SCALE 1" = 10'-0"


STA. 12+50 TO STA. 12+75

| | | | |
|---------------------|------------------|--------------|--------------|
| PROJECT NAME: | JAMAICA | PLOT DATE: | 07-DEC-2012 |
| PROJECT NUMBER: | ER-BRF 015-1(23) | DRAWN BY: | K. FRIEDLAND |
| FILE NAME: | s11b316.xs.dgn | DESIGNED BY: | G. LAROCHE |
| PROJECT LEADER: | K. HIGGINS | CHECKED BY: | G. LAROCHE |
| CHANNEL SECTIONS 10 | | SHEET | 79 OF 82 |