

RIGHT - OF - WAY DETAIL SHEET


TABLE OF PROPERTY ACQUISITION

PARCEL NO.	PROPERTY OWNER	SHEET NO.	BEGINNING STATION	ENDING STATION	TAKE AREA±	REMAINDER AREA±	RIGHT			RECORDING DATA				REMARKS		
							TYPE	(T)/(P)	AREA ±	TITLE	DATE	TOWN / CITY	BOOK		PAGE	
1	BECKWITH, JOEL & ELAINE C.	3	208+96 LT	211+04 LT			UTILITY	(T)	0.11 A	GTR	09/17/12	JAMAICA	113	347-350	4,640 SF±, VALUE AS ER INCL. TEMP BRIDGE, CONCRETE WALL AND CHANNEL REPAIR WORK; 5,020 SF±, VALUE AS ER BF & EC INCL. EC W-1 MONITOR WELL S-1 MONITOR SEPTIC SYSTEM STONE FILL FOR STREAMBANK STABILIZATION	
			209+38 LT	211+03.03 LT			DETOUR	(T)	0.12 A							
			209+38 LT	210+86 LT			INSTALL	(T)	1,180 SF							
			209+42 LT	210+64 LT			SLOPE	(T)	2,900 SF							
			209+53 LT													
			209+96 LT	210+80 LT			INSTALL	(T)	1,450 SF							
			210+30 LT													
2	JAMAICA VOLUNTEER FIRE & RESCUE, INC. joined by THE JAMAICA TIMBER COMPANY	3, 4	210+76.85 LT	214+50.00 LT	0.39 A		DETOUR	(T)	0.26 A			JAMAICA			16,820 SF± INCL. TEMP BRIDGE, GUARDRAILS AND CHANNEL REPAIR WORK; 11,020 SF±, VALUE AS ER 8,240 SF±, VALUE AS ER BF & EC STONE FILL FOR STREAMBANK STABILIZATION INCL. EC 20' DRIVE FOR DRY HYDRANT ACCESS 45' PAVED, MM 0404 GUARDRAIL BF	
			210+77 LT	213+61 LT												
			210+87 LT	214+18 LT			UTILITY	(T)	0.19 A							
			211+37 LT	212+37 LT			INSTALL	(T)	475 SF							
			211+43 LT	211+95 LT			INSTALL	(T)	1,510 SF							
			211+60 LT	212+17 LT			SLOPE	(T)	530 SF							
			211+68 LT	212+36 LT			DRIVE	(T)	2,020 SF							
			211+92 LT	212+32 LT			SLOPE	(T)	1,150 SF							
			212+13 LT	212+82 LT			DRIVE	(T)	570 SF							
			212+77 LT	214+37 LT			SLOPE	(T)	1,490 SF							
			212+78 LT	212+92 LT			INSTALL & MAINT	(P)								
	213+18 LT	214+42 LT		INSTALL	(T)	640 SF										
3A	TOWN OF JAMAICA	4	213+78 LT	214+81 LT			APPROACH	(T)		GTR	11/05/12	JAMAICA	113	540-541	INCL. REPLACING GUARDRAIL, INSTALLING STONE FILL, EC & BF, GRADING AND PAVING CASTLE HILL ROAD TH51	
3B		3	211+43 RT	212+12 RT			APPROACH	(T)							INCL. INSTALLING PDF & EC, GRADING AND PAVING WATER STREET TH18	
			210+62 RT	211+13 RT			INSTALL	(T)	320 SF						BF & EC	
4	RYBOLT, RICHARD E. & ANITA L.	3	210+49 RT	211+11 RT			INSTALL	(T)	630 SF	CONDEM	10/09/12	JAMAICA	113	465-478	EC	
			210+53 RT	211+37 RT			INSTALL	(T)	2,400 SF							STONE FILL FOR STREAMBANK STABILIZATION
			210+64 RT	211+57.25 RT			SLOPE	(T)	1,840 SF	GTR	10/17/12	JAMAICA	113	510-511		
5	BLUMING, JOEL W.	3	208+83 RT	209+63 RT			INSTALL	(T)	60 SF						BF	
			209+43 RT	210+44 RT			INSTALL	(T)	1,450 SF							BF & EC
			209+47 RT	210+39 RT			INSTALL	(T)	2,430 SF							STONE FILL FOR STREAMBANK STABILIZATION
			209+75 RT	209+85 RT			SLOPE	(T)	55 SF							
			209+77 RT	209+84 RT			SLOPE REMOVE	(T)								GUARDRAIL

TABLE OF REVISIONS

REVISION NO.	SHEET NO.	DESCRIPTION	DATE
1	2	PARCEL 5 BLUMING - SLOPE (T) STA 209+75 RT - 209+85 RT 55 SF ADDED TO DETAIL SHEET, LAYOUT SHEET OKAY. COMPLETED BY: MT C.O. #9773 APPROVED BY: HP	07/17/12
2	2, 3	PARCEL 2, JAMAICA VOLUNTEER FIRE & RESCUE - ADDED 20' DRIVE FOR DRY HYDRANT ACCESS. COMPLETED BY: MT C.O. #9777 APPROVED BY: HP	08/28/12

PLAN LEGEND

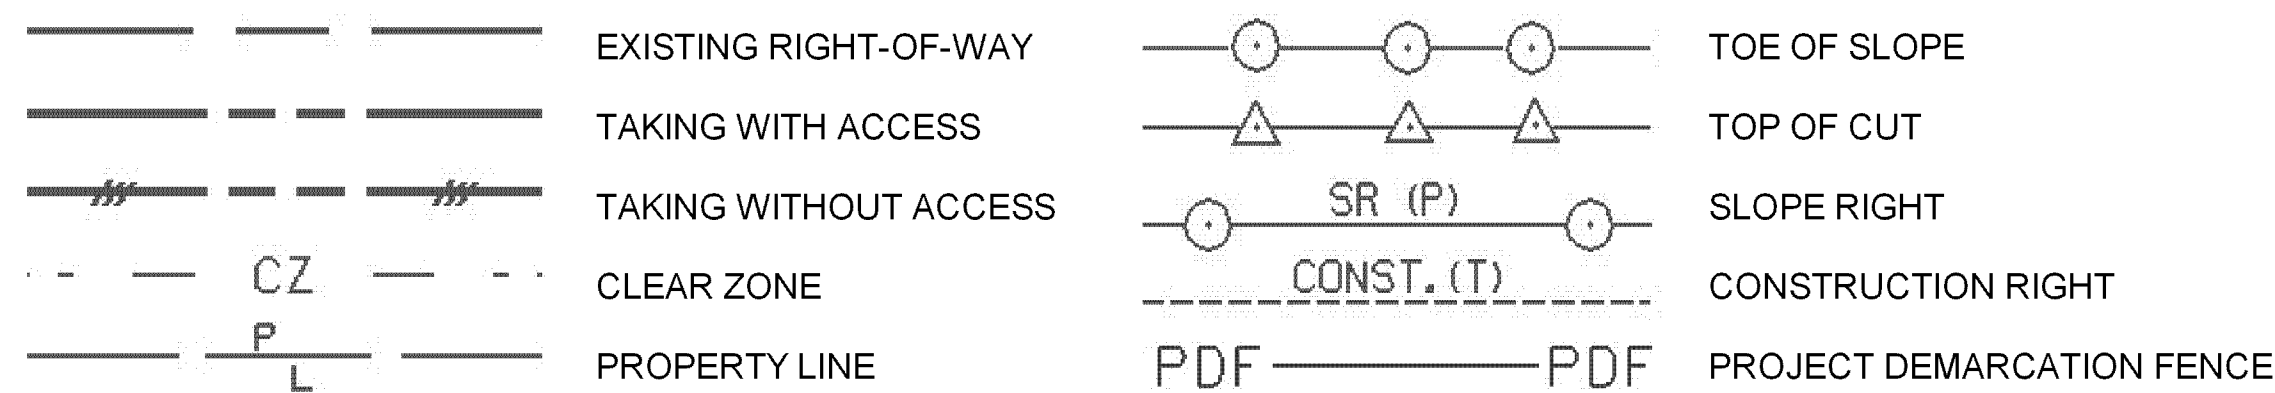

- EC - EROSION CONTROL
- (P) - PERMANENT
- (T) - TEMPORARY
- DR. - DRAINAGE RIGHT
- DIT. - DITCHING RIGHT
- CH. - CHANNEL RIGHT
- DRIVE - DRIVE RIGHT
- CUL. - CULVERT RIGHT
- BND - BOUND (PROPERTY MARKER)
- SR - SLOPE RIGHT
- UE - UTILITY EASEMENT

APPROVED: HARRY PETROVS, DATE: 07-05-12
CHIEF, PLANS & TITLES

PROJECT NAME:	JAMAICA		
PROJECT NUMBER:	ER-BRF 015-1(23)		
FILE NAME:	r11b316DetailSheet.xls	PLOT DATE:	07-DEC-2012
PROJECT LEADER:	K. HIGGINS	DRAWN BY:	M. TROTTIER
DESIGNED BY:	G. LAROCHE	CHECKED BY:	E. PIERCE
R.O.W. DETAIL SHEET #1		SHEET	80 OF 82