



9+25

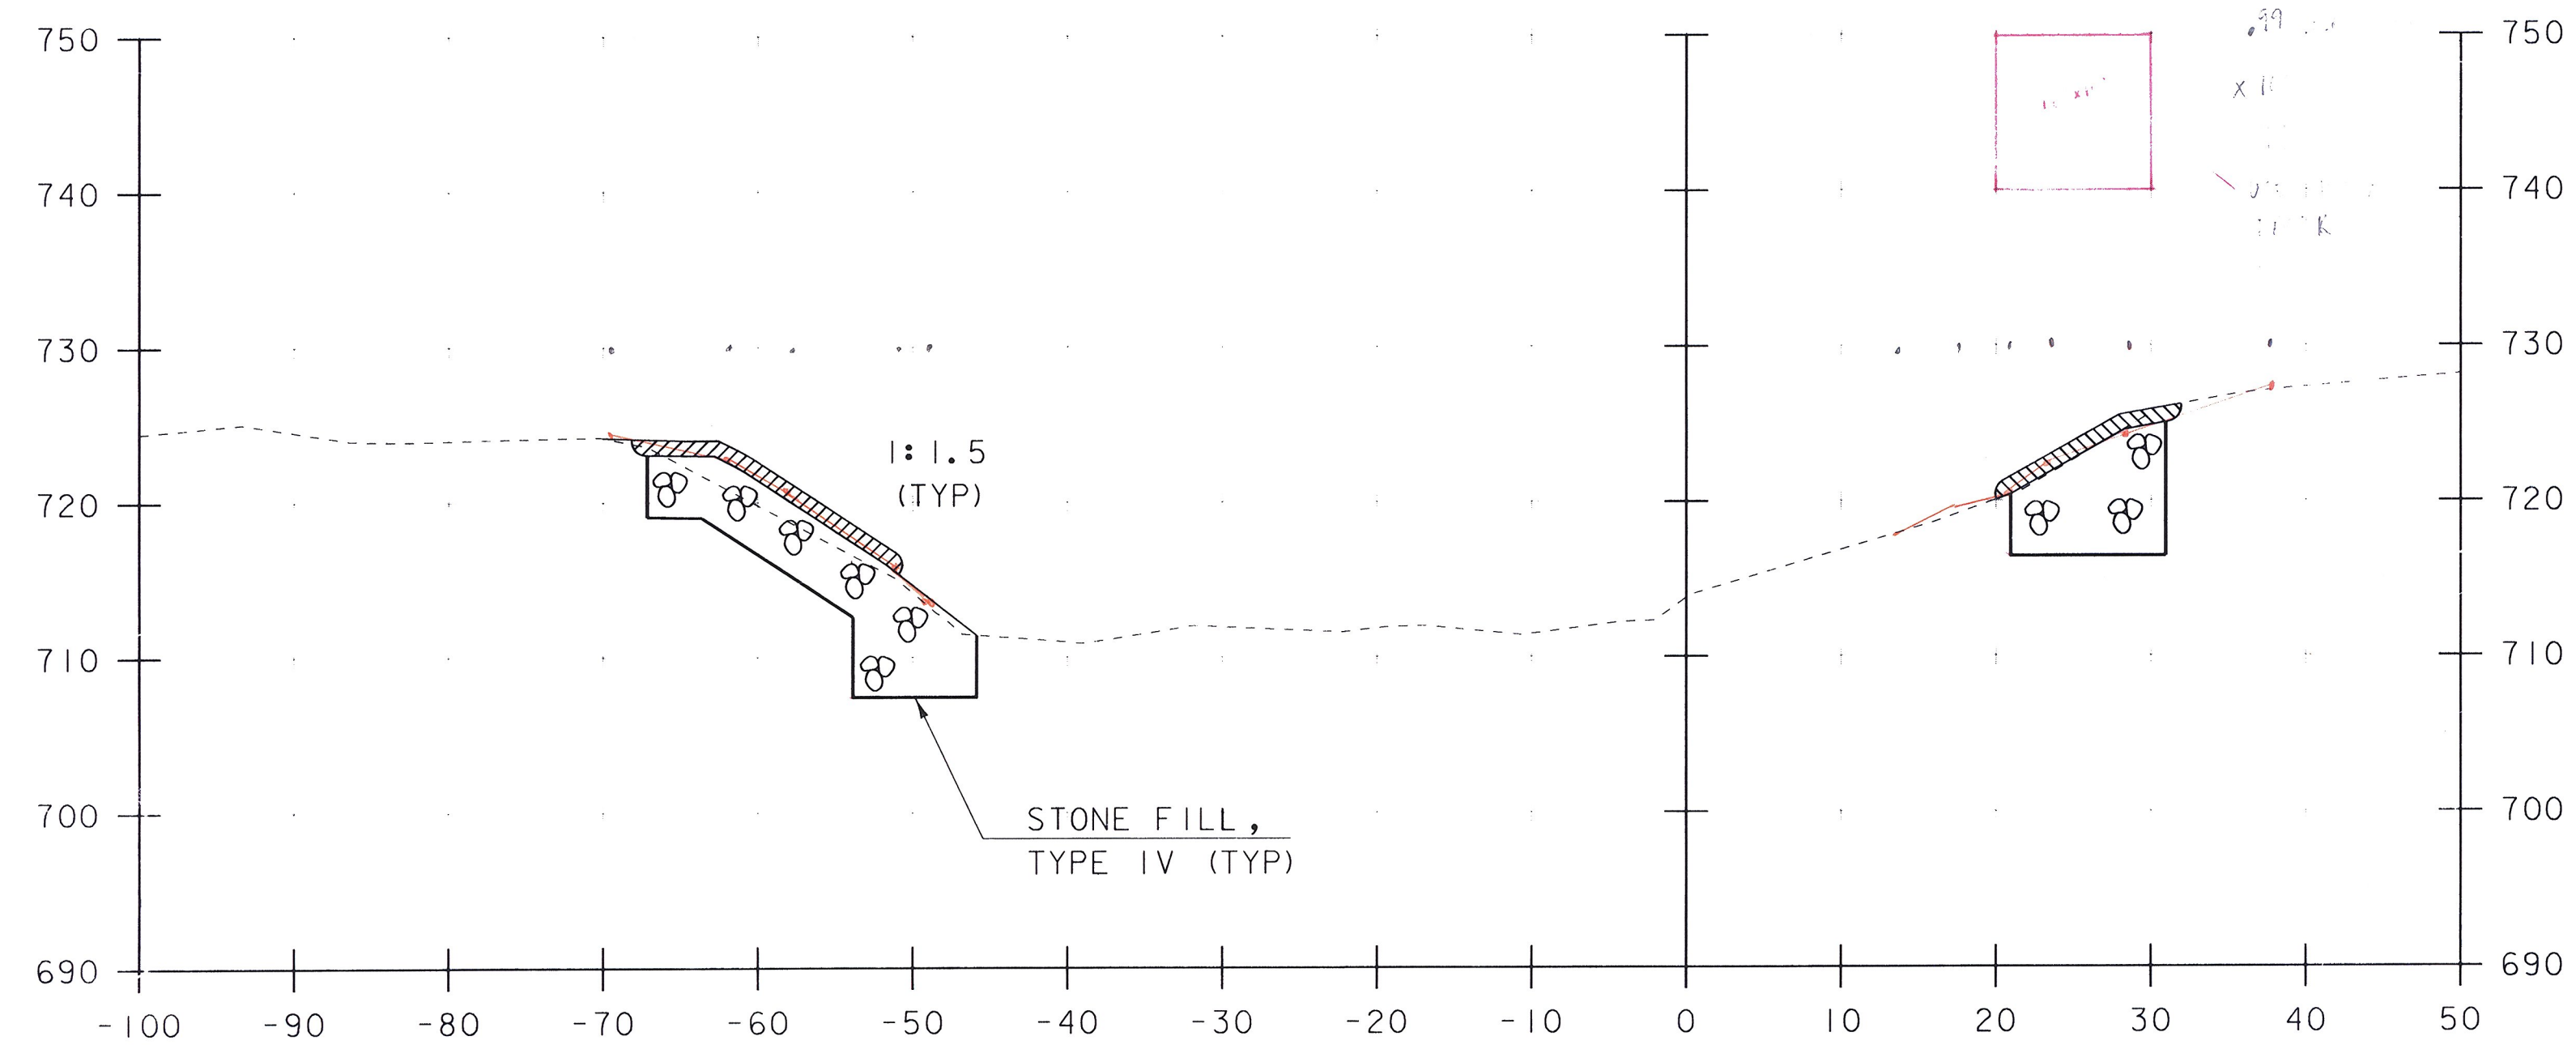

9+00

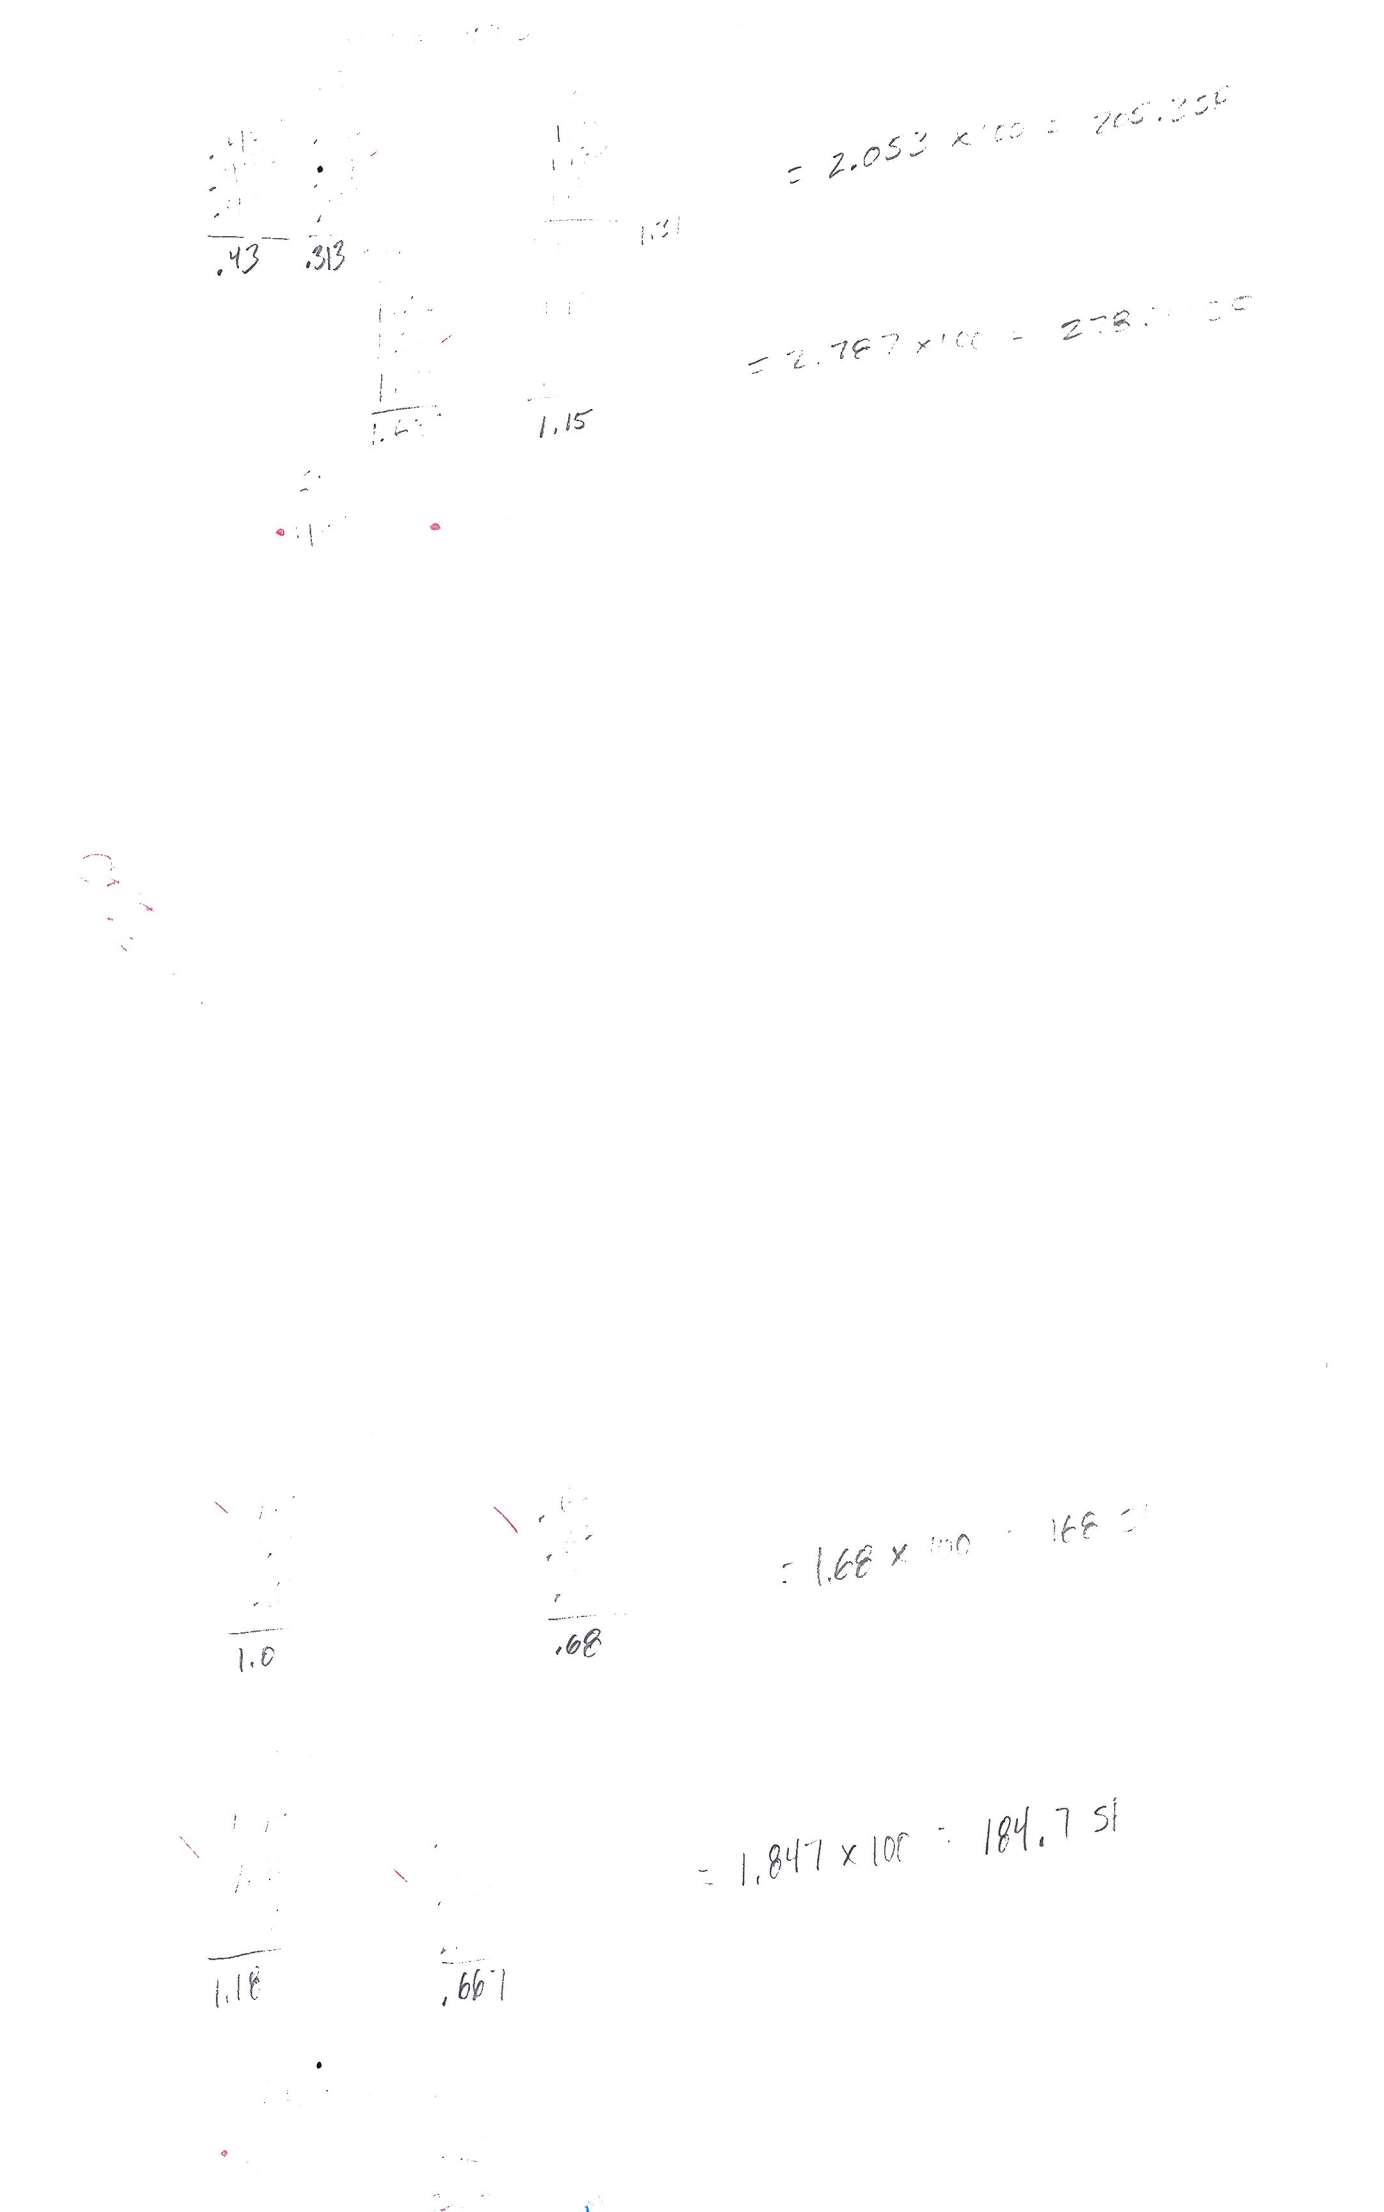

STA. 9+00 TO STA. 9+25

PROJECT NAME: JAMAICA		PLOT DATE: 13-AUG-2013	
PROJECT NUMBER: ER-BRF 015-1(23)		DRAWN BY: J. SALVATORI	
FILE NAME: s1b316.xsdgn	DESIGNED BY: -----	CHECKED BY: -----	SHEET 1 OF 7
ADDITIONAL CHANNEL SECTIONS			