


9+75

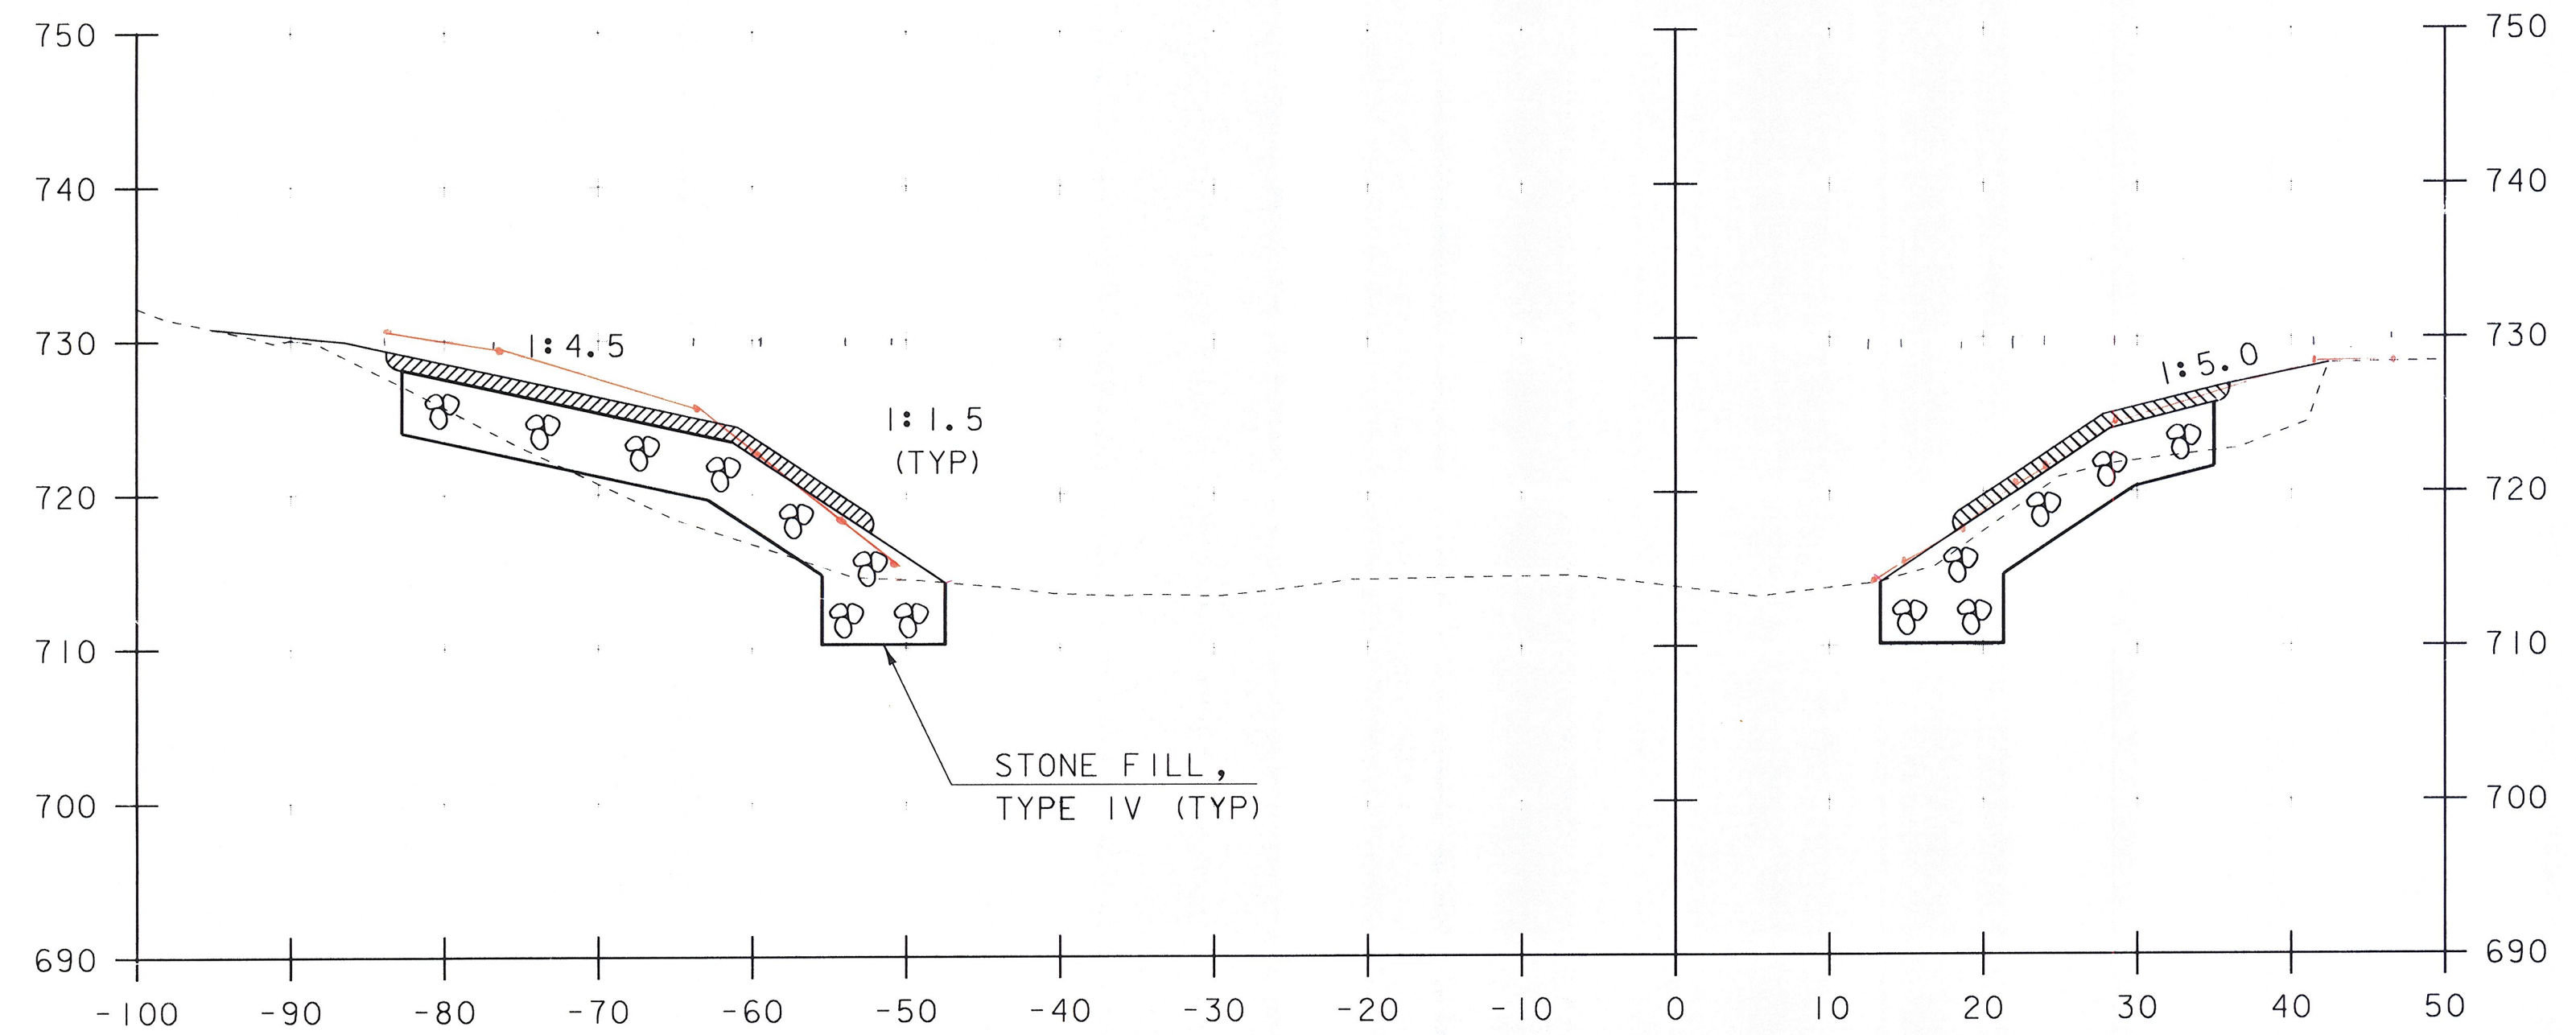

9+50

Handwritten calculations:
 $1.8 \times 100 = 180 \text{ SF}$
 $.846 \times 100 = 84.6 \text{ CF}$

Handwritten calculations:
 $2.873 \times 100 = 287.3 \text{ SF}$
 $1.32 \times 100 = 132 \text{ SF}$

STA. 9+50 TO STA. 9+75

PROJECT NAME: JAMAICA	
PROJECT NUMBER: ER-BRF 015-1(23)	
FILE NAME: slib316.xs.dgn	PLOT DATE: 13-AUG-2013
PROJECT LEADER: K. HIGGINS	DRAWN BY: J. SALVATORI
DESIGNED BY: -----	CHECKED BY: -----
ADDITIONAL CHANNEL SECTIONS	SHEET 2 OF 7