


10+30

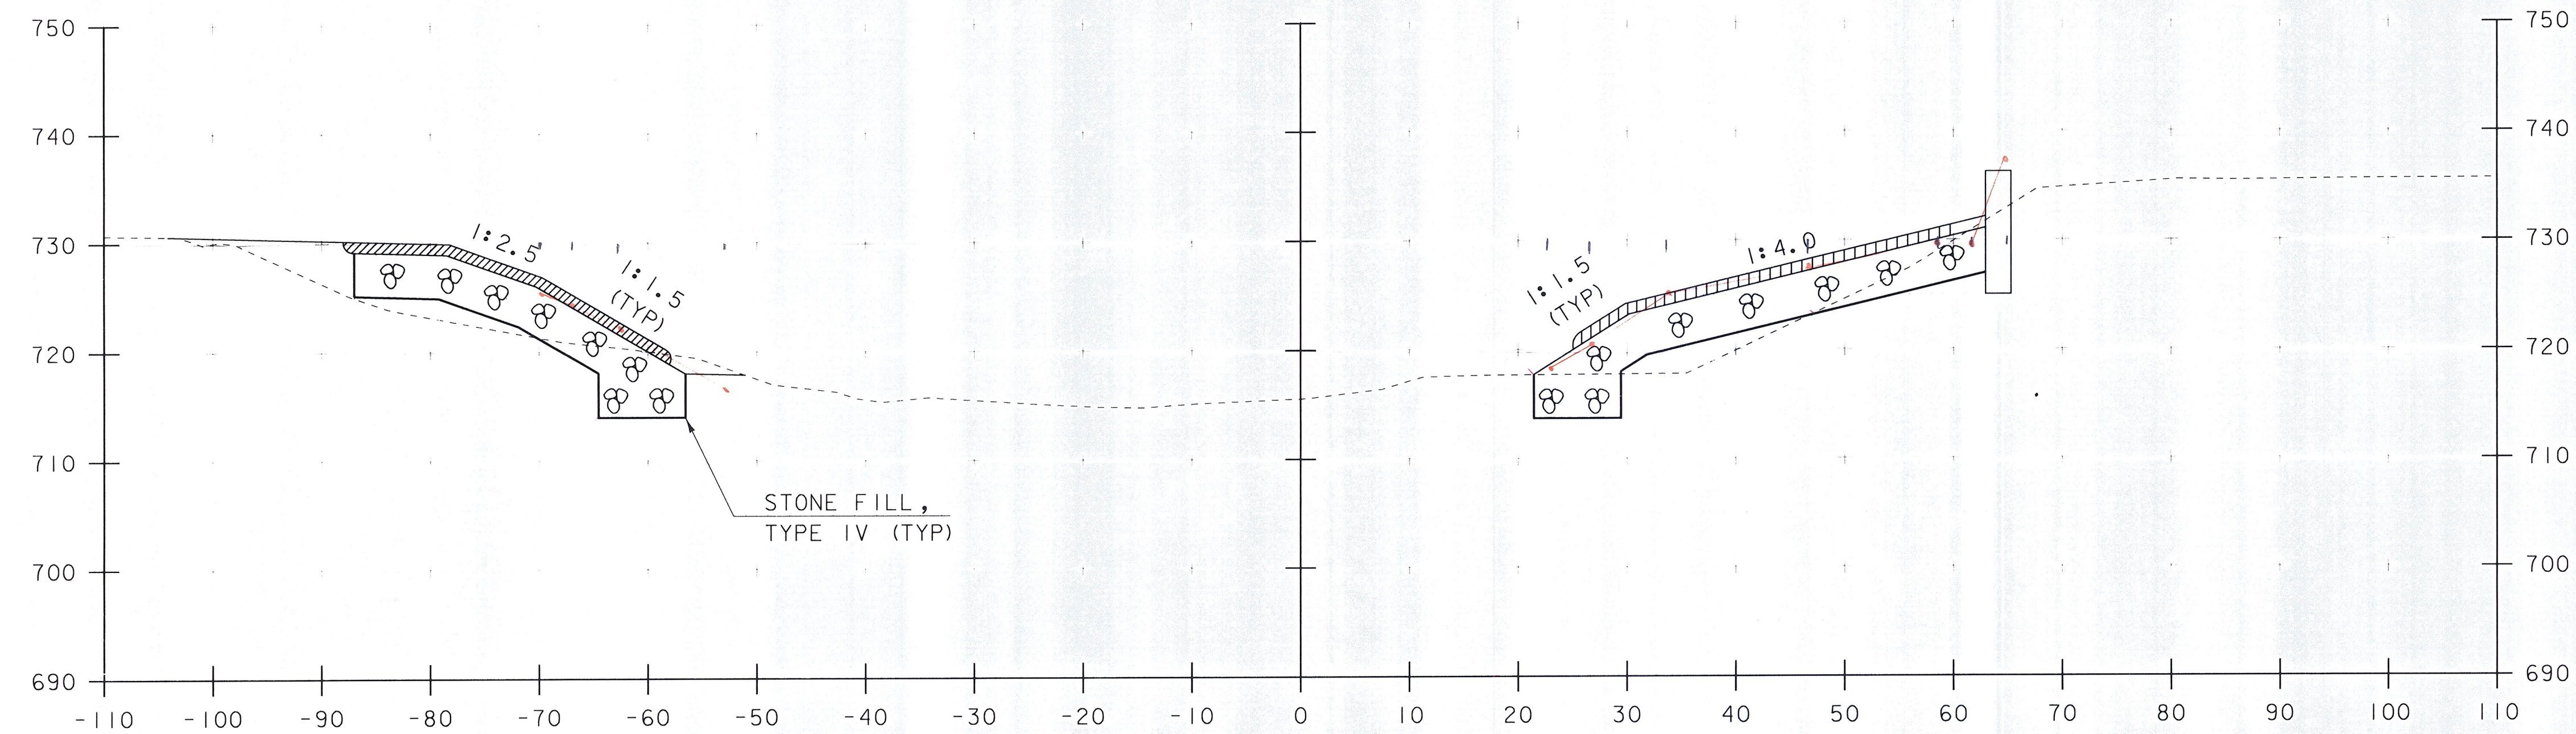

10+25

Handwritten calculations:

$2.55 \times 100 = 255 \text{ SF}$

$1.18 \times 100 = 118 \text{ SF}$

Handwritten calculations:

$1.26 \times 100 = 126 \text{ SF}$

$3.34 \times 100 = 334$

STA. 10+25 TO STA. 10+30

PROJECT NAME:	JAMAICA	PLOT DATE:	13-AUG-2013
PROJECT NUMBER:	ER-BRF 015-1(23)	DRAWN BY:	K. FRIEDLAND
FILE NAME:	s1b316.xs.dgn	DESIGNED BY:	-----
PROJECT LEADER:	K. HIGGINS	ADDITIONAL CHANNEL SECTIONS	CHECKED BY: -----
			SHEET 4 OF 7