

10+50


Handwritten calculations:

$1.37 \times 100 = 137.0 \text{ SF}$

$1.00 \times 100 = 100.0 \text{ SF}$

$1.87 \times 100 = 187.0 \text{ SF}$

$2.51 \times 100 = 251.0 \text{ SF}$

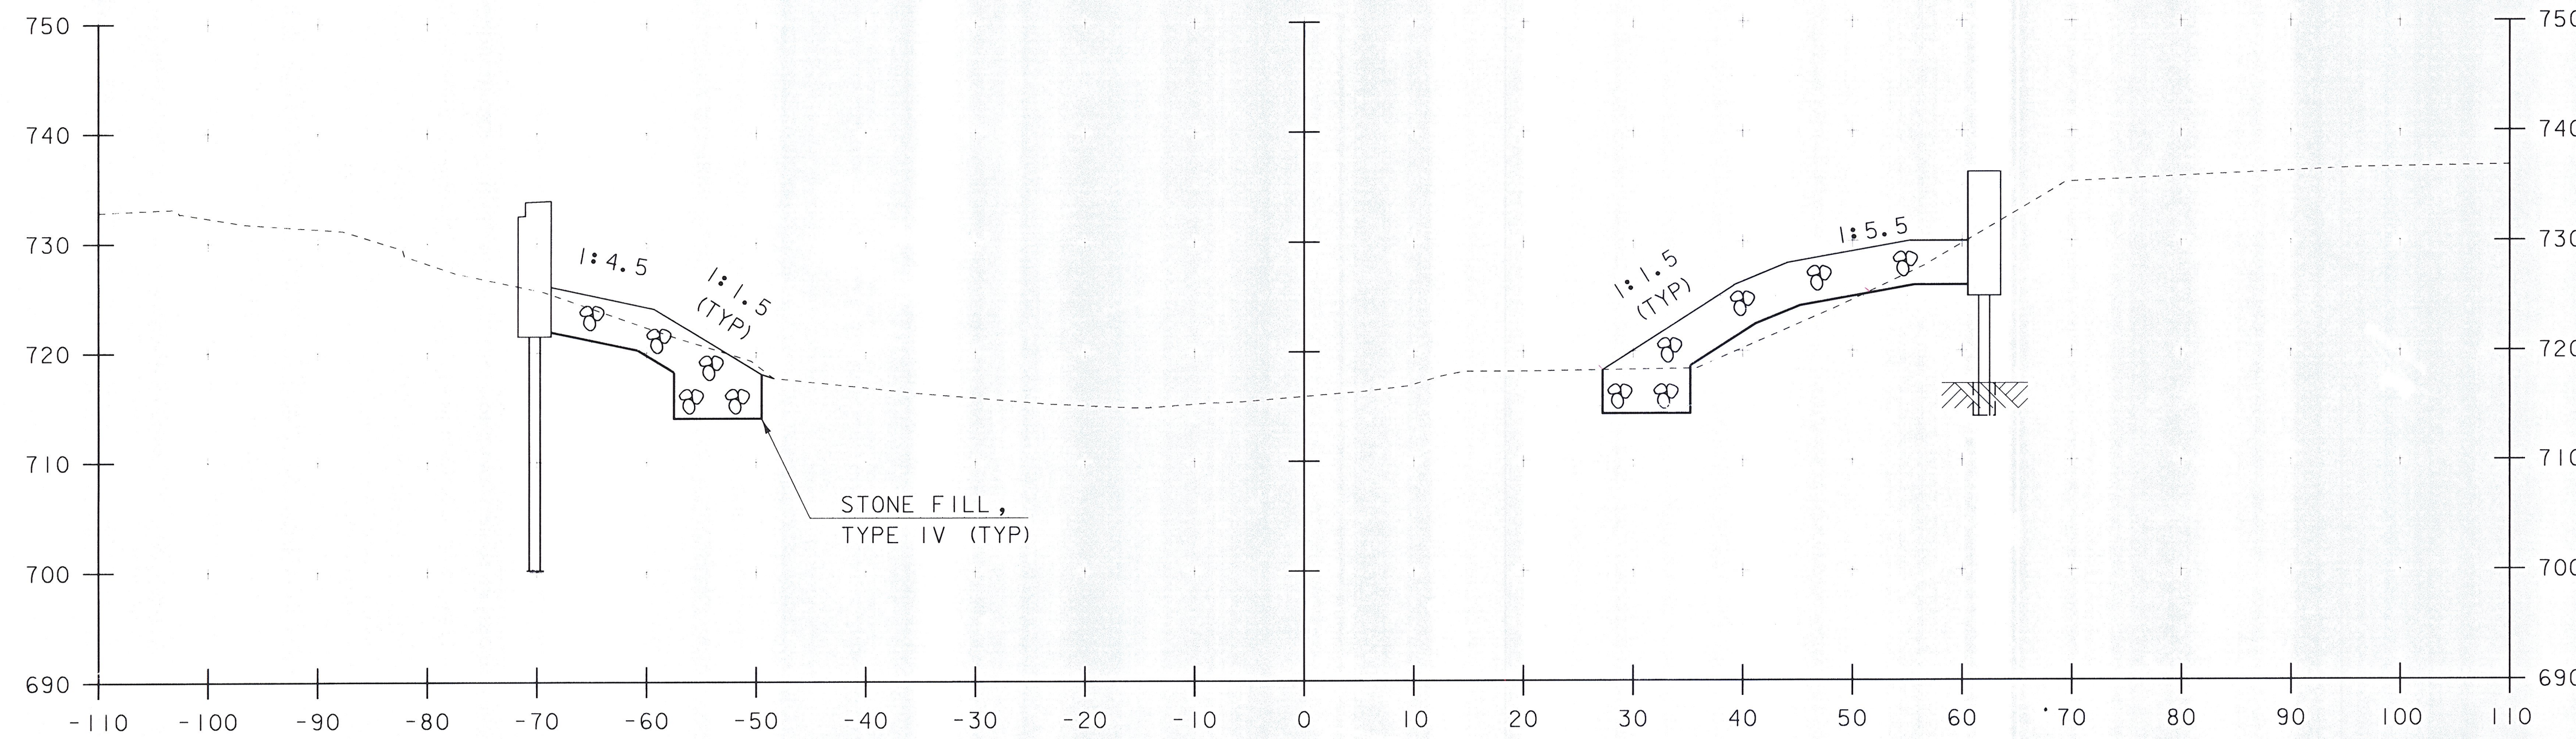

10+40

Handwritten calculations:

$2.58 \times 100 = 258.0 \text{ SF}$

$1.86 \times 100 = 186.0 \text{ SF}$

STA. 10+40 TO STA. 10+50

PROJECT NAME: JAMAICA	PLOT DATE: 13-AUG-2013
PROJECT NUMBER: ER-BRF 015-1(23)	DRAWN BY: K. FRIEDLAND
FILE NAME: slib316.xsdgn	DESIGNED BY: -----
PROJECT LEADER: K. HIGGINS	CHECKED BY: -----
ADDITIONAL CHANNEL SECTIONS	SHEET 5 OF 7