


10+70

$2.80 \times 100 = 280 \text{ SF}$
 $= 2.45 \times 100 = 245 \text{ SF}$

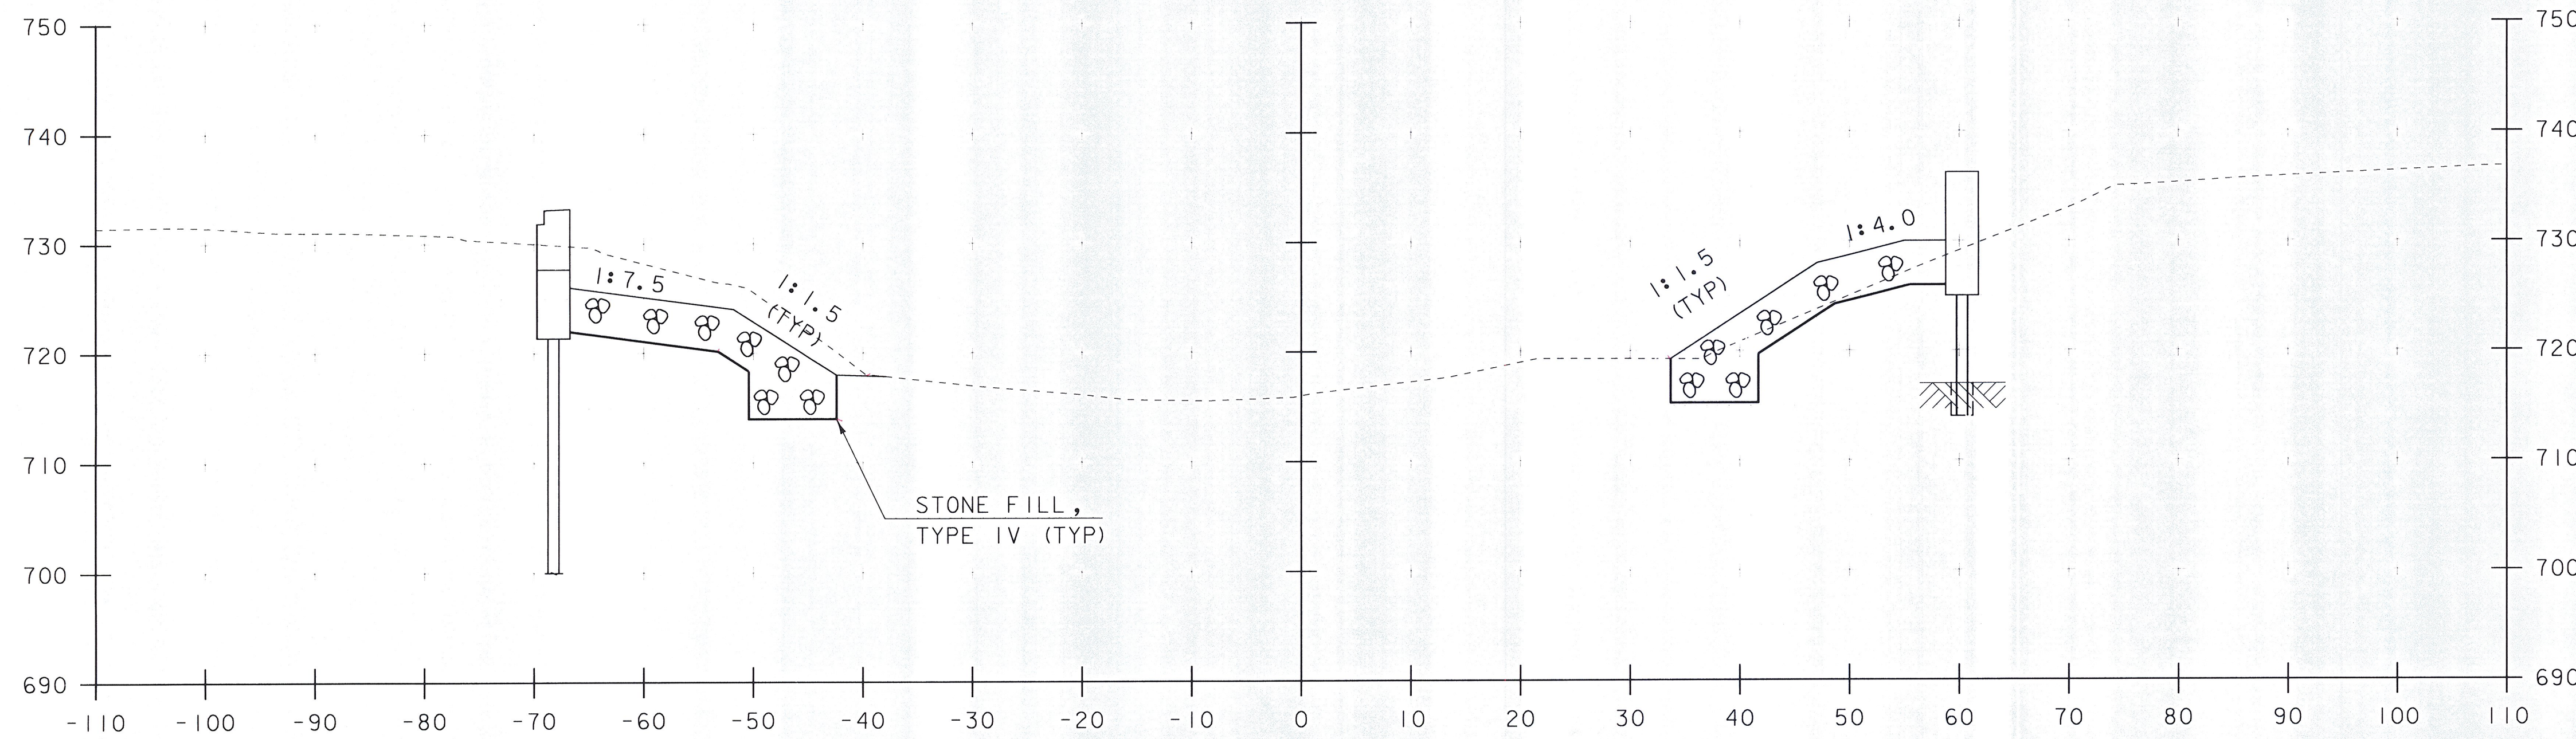

10+60

$2.47 \times 100 = 247 \text{ SF}$
 $2.46 \times 100 = 246 \text{ SF}$

STA. 10+60 TO STA. 10+70

PROJECT NAME: JAMAICA	PLOT DATE: 13-AUG-2013
PROJECT NUMBER: ER-BRF 015-1(23)	DRAWN BY: K. FRIEDLAND
FILE NAME: s11b316.xsdgn	DESIGNED BY: -----
PROJECT LEADER: K. HIGGINS	CHECKED BY: -----
ADDITIONAL CHANNEL SECTIONS	SHEET 6 OF 7